

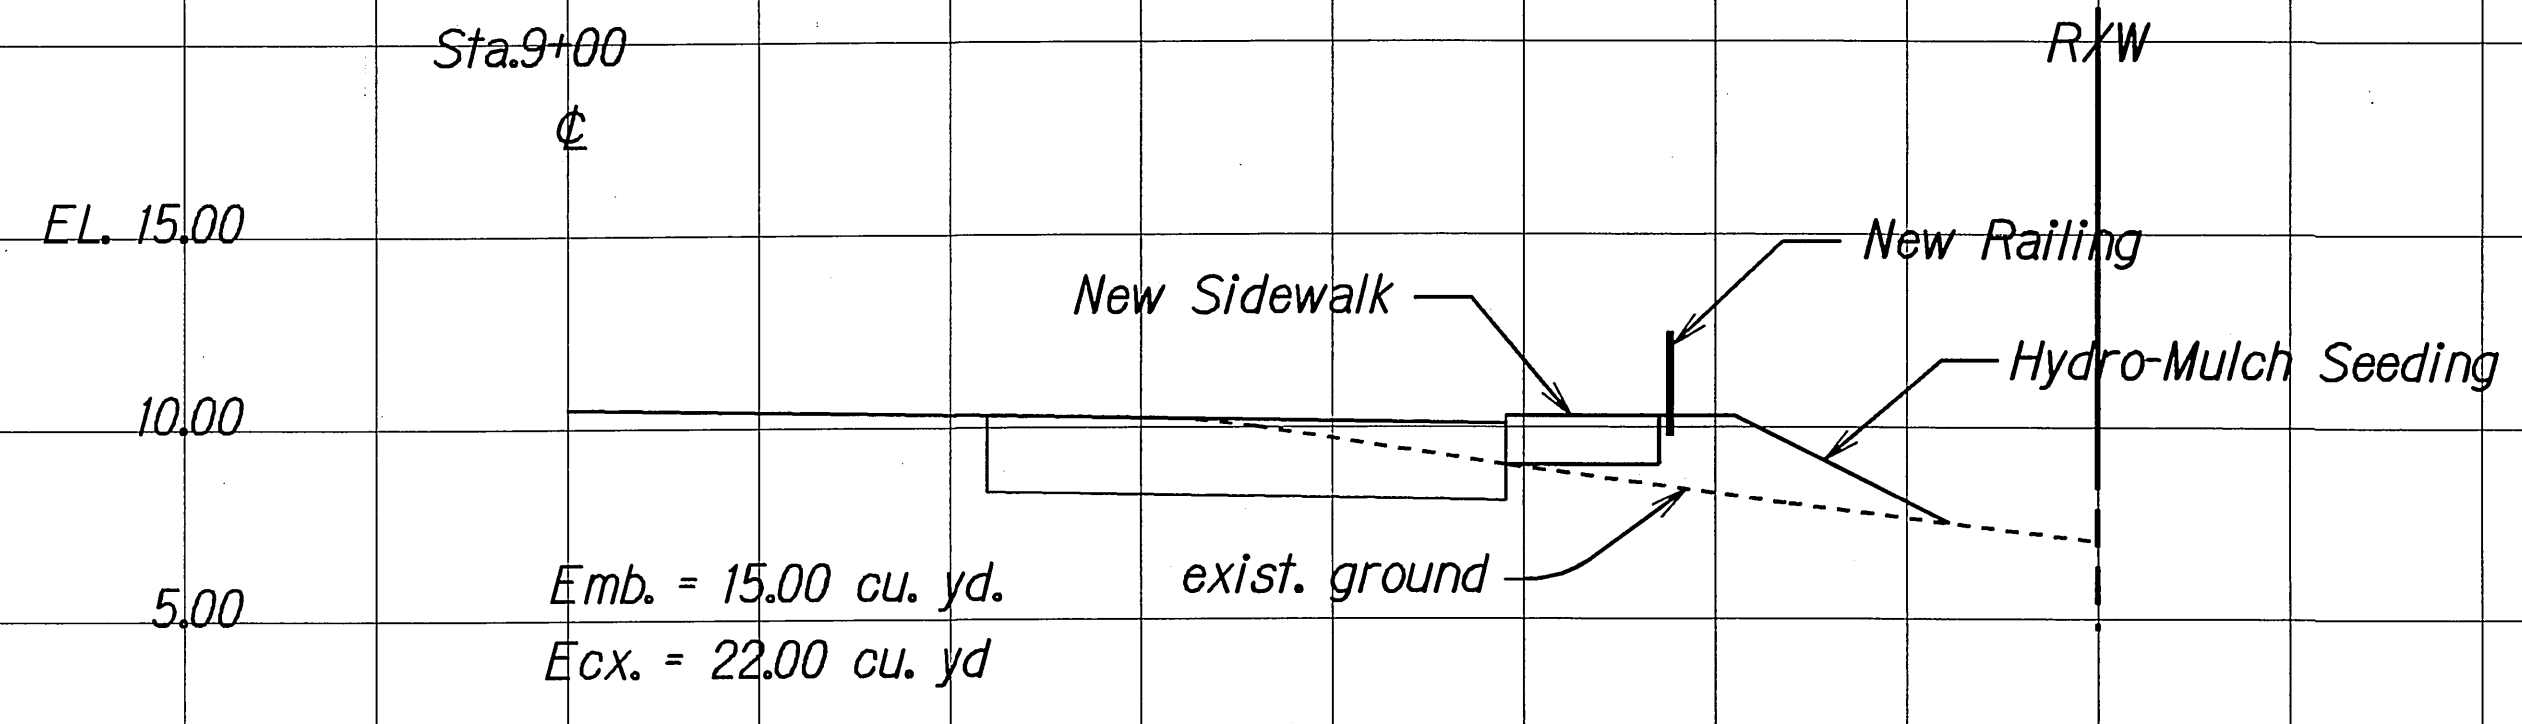
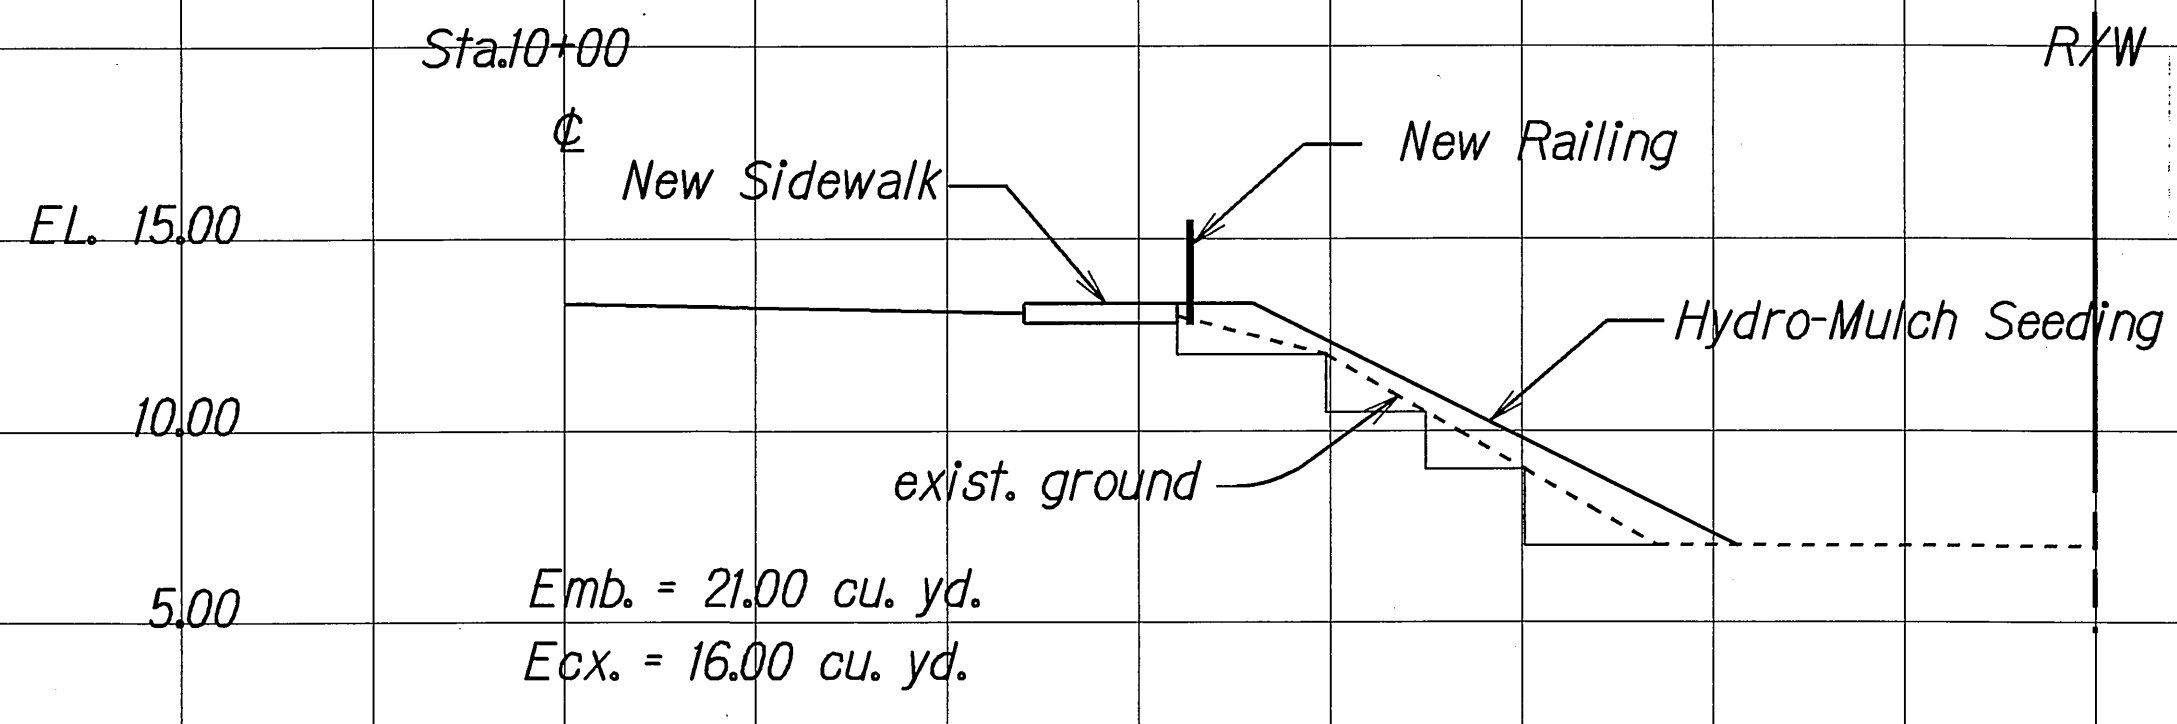
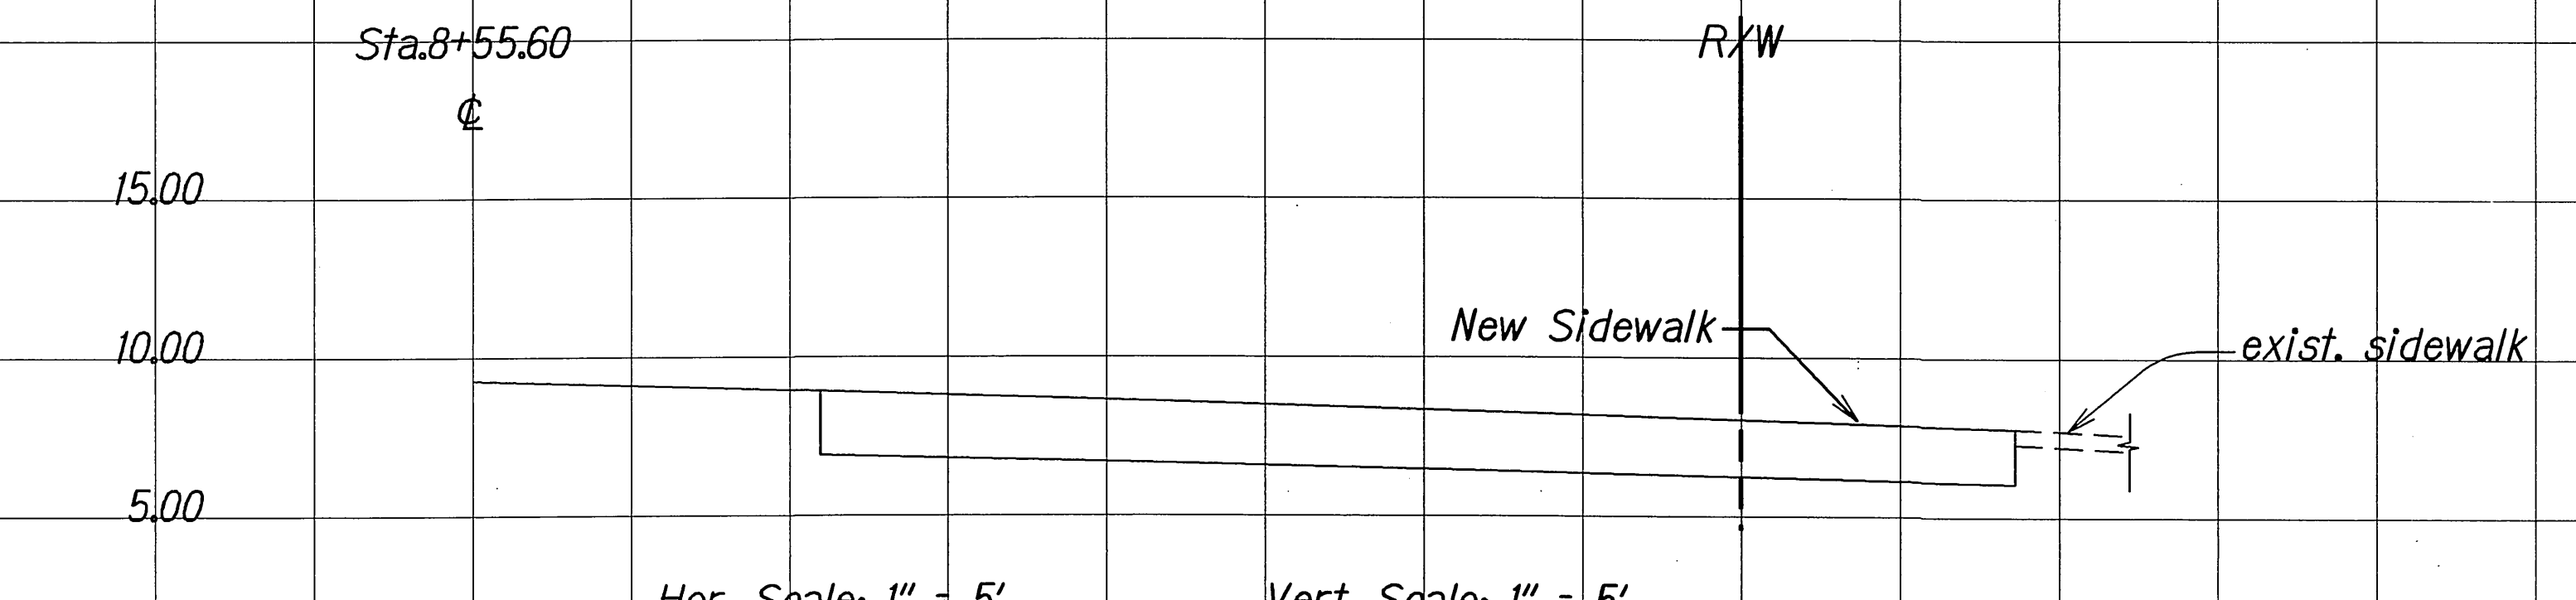
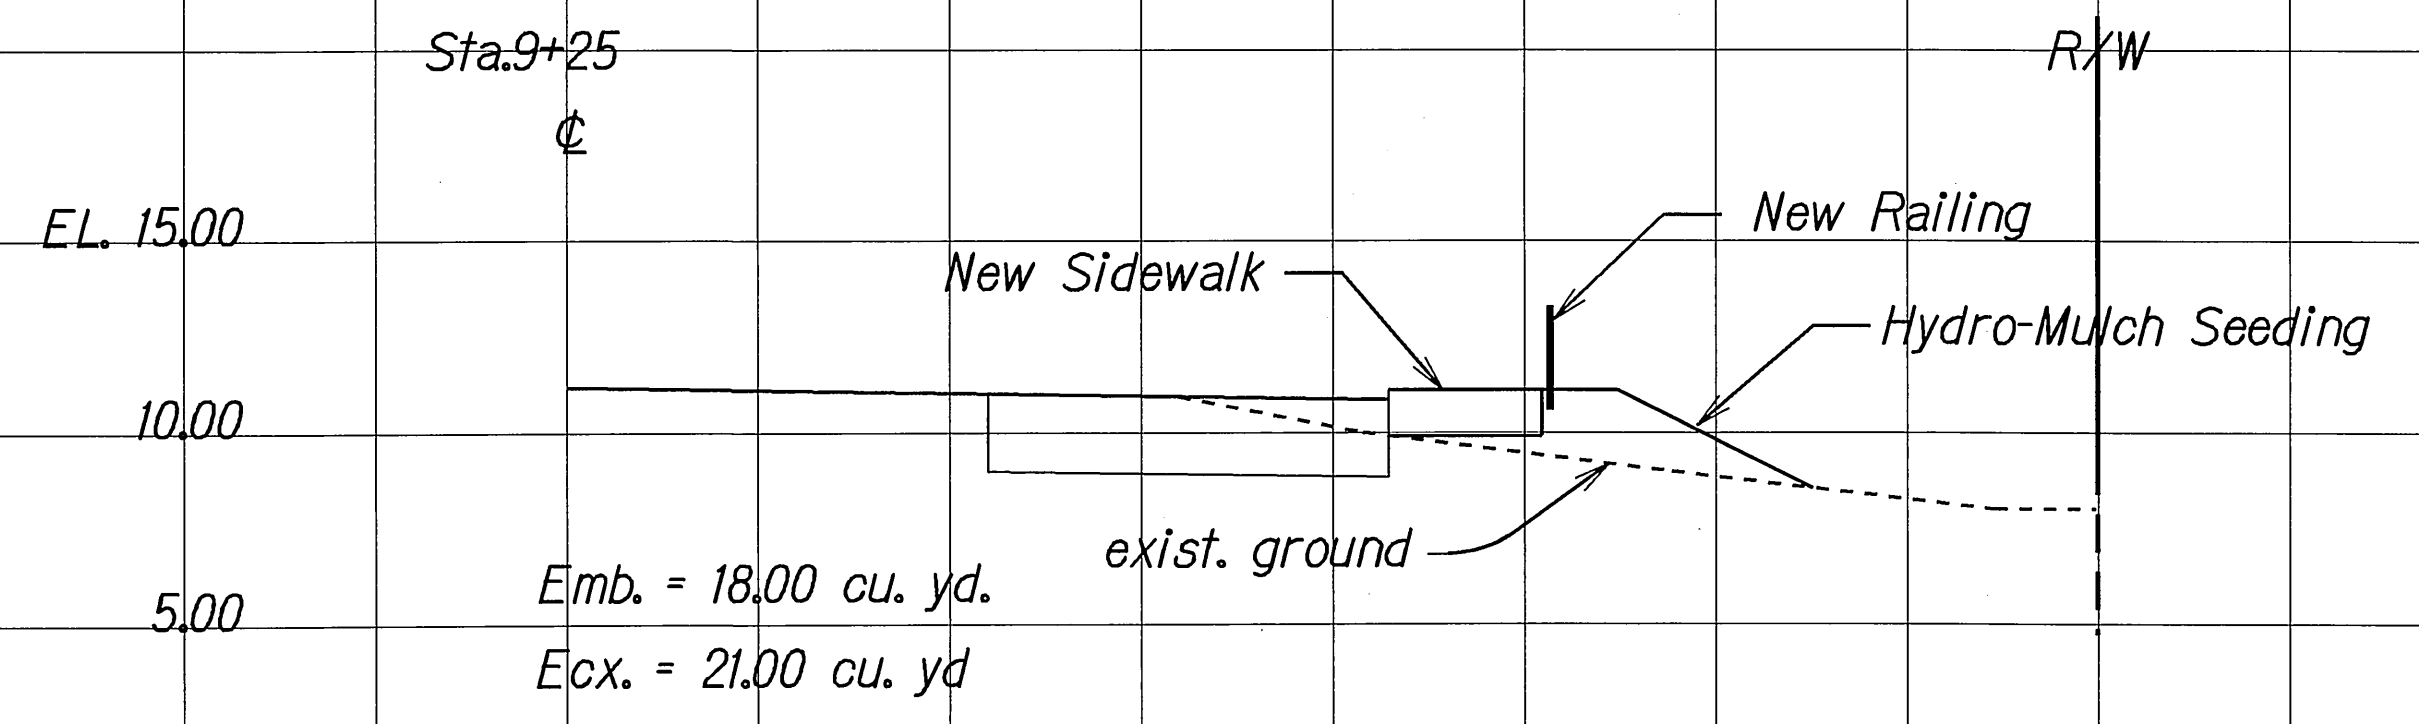
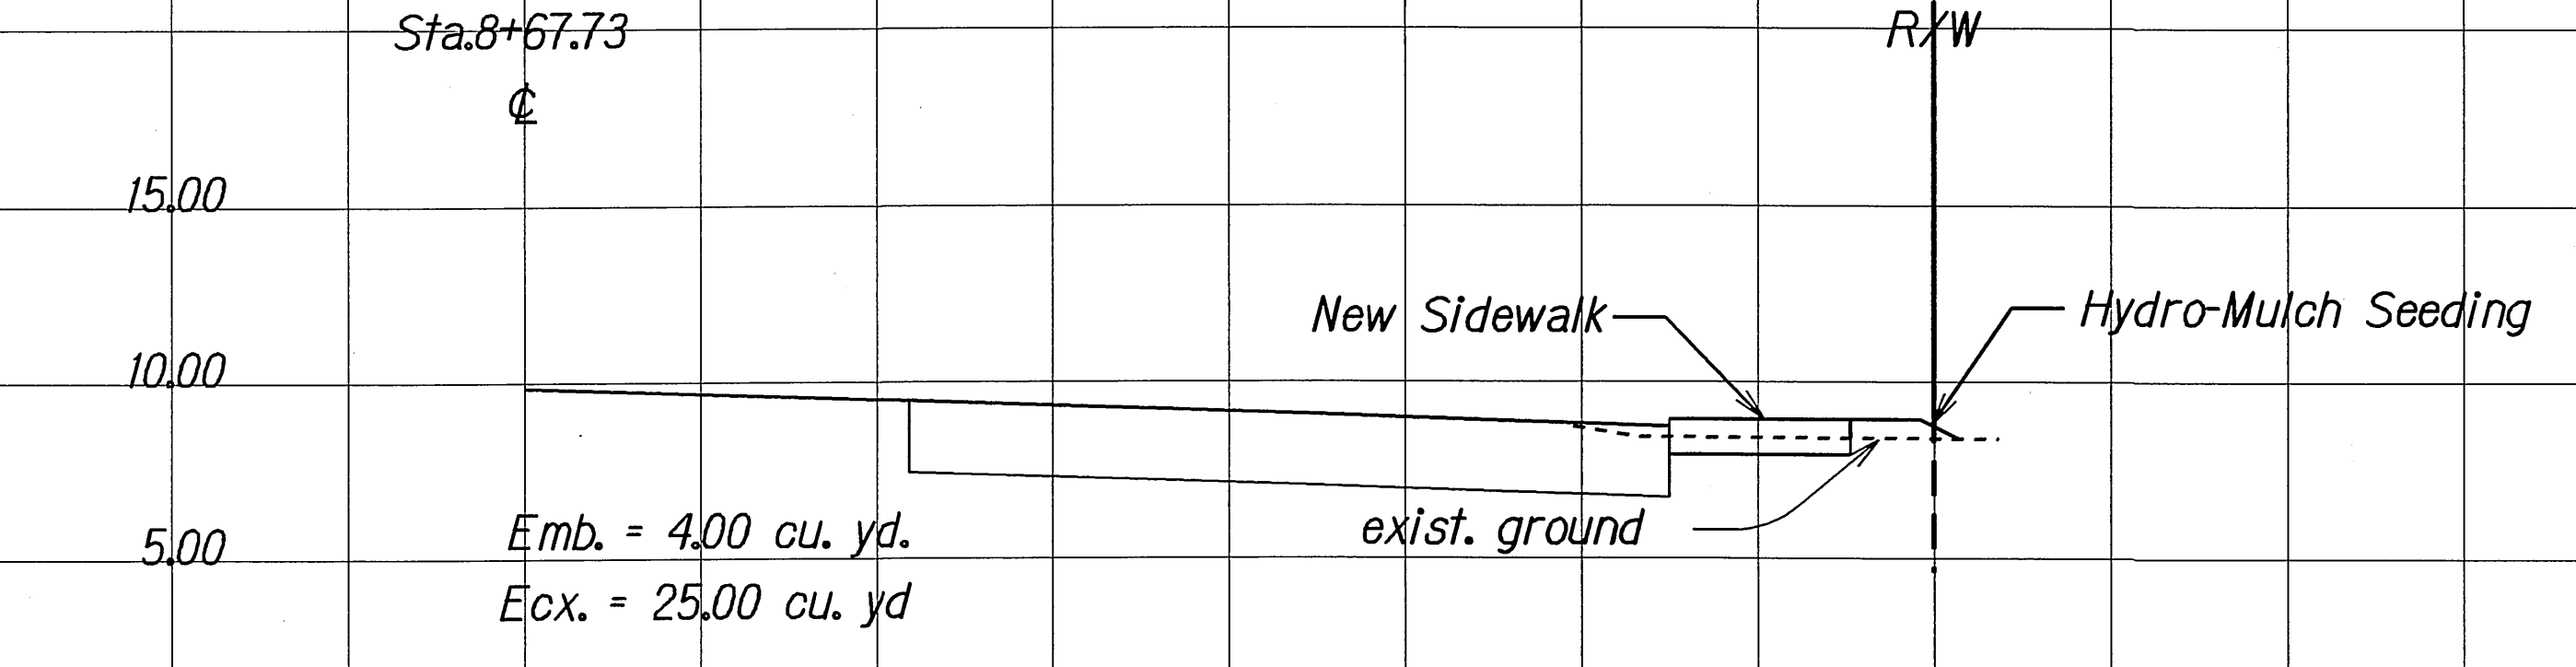
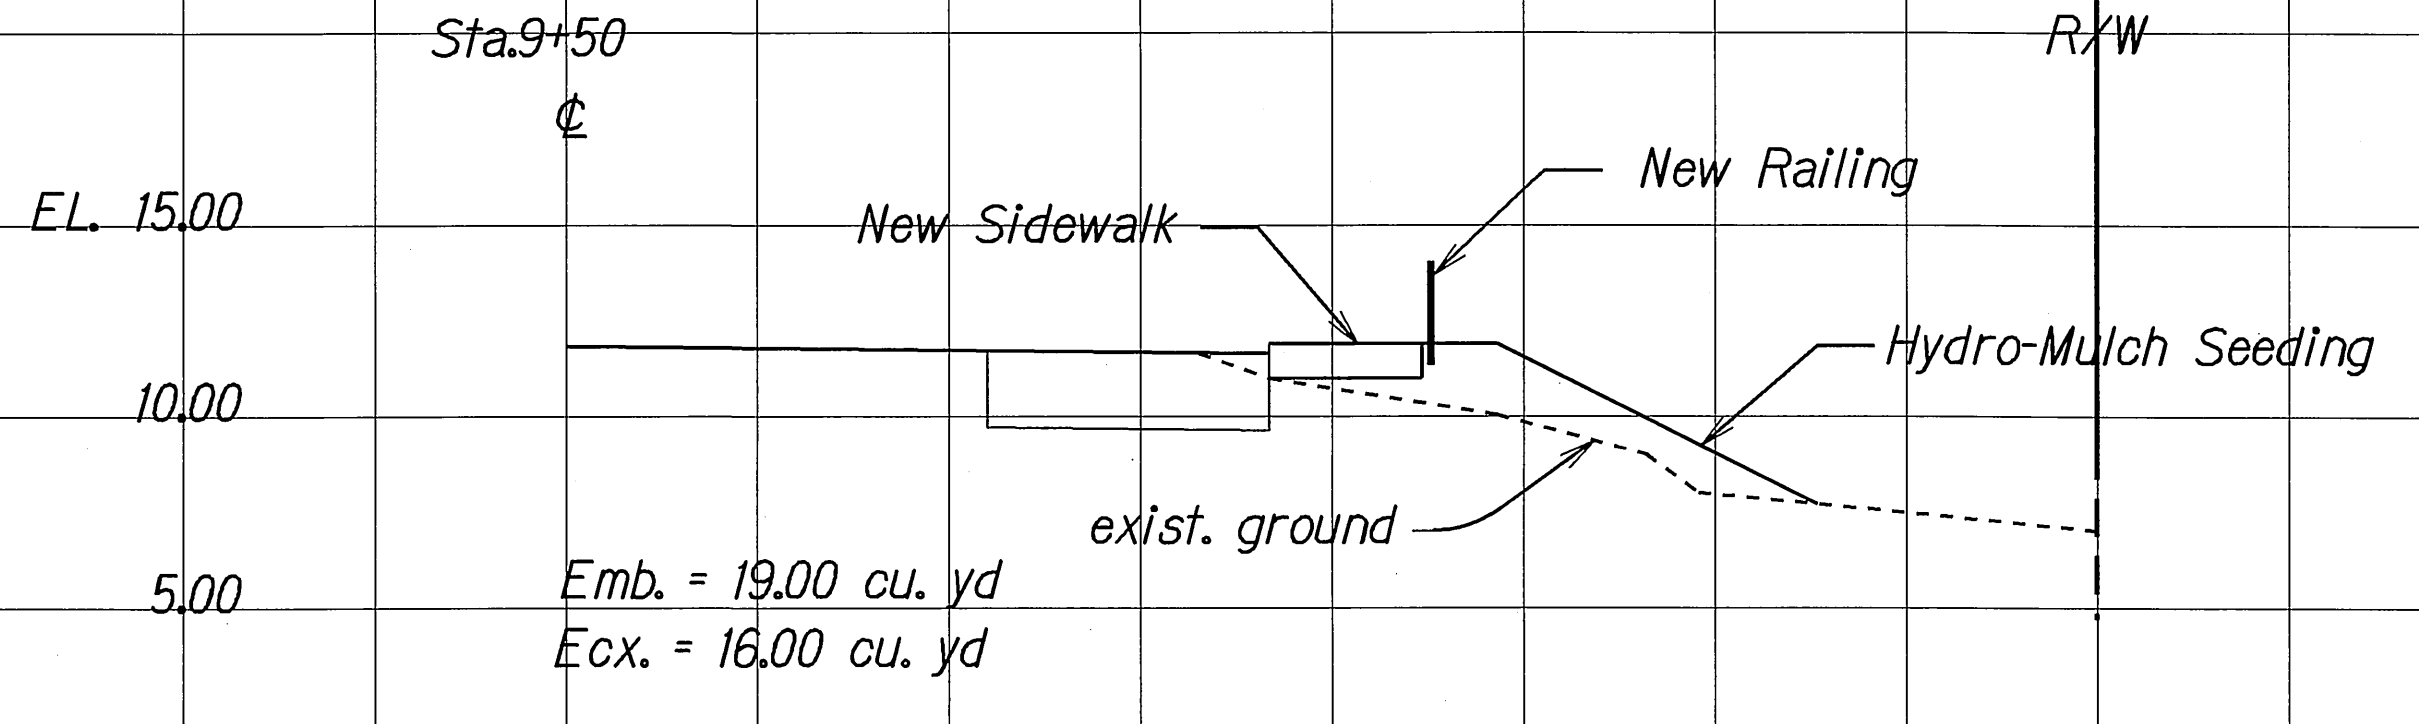


FED. ROAD DIST. NO.	STATE	PROJ. NO.	FISCAL YEAR	SHEET NO.	TOTAL SHEETS
HAWAII	HAW.	50B-01-09	2009	19	19

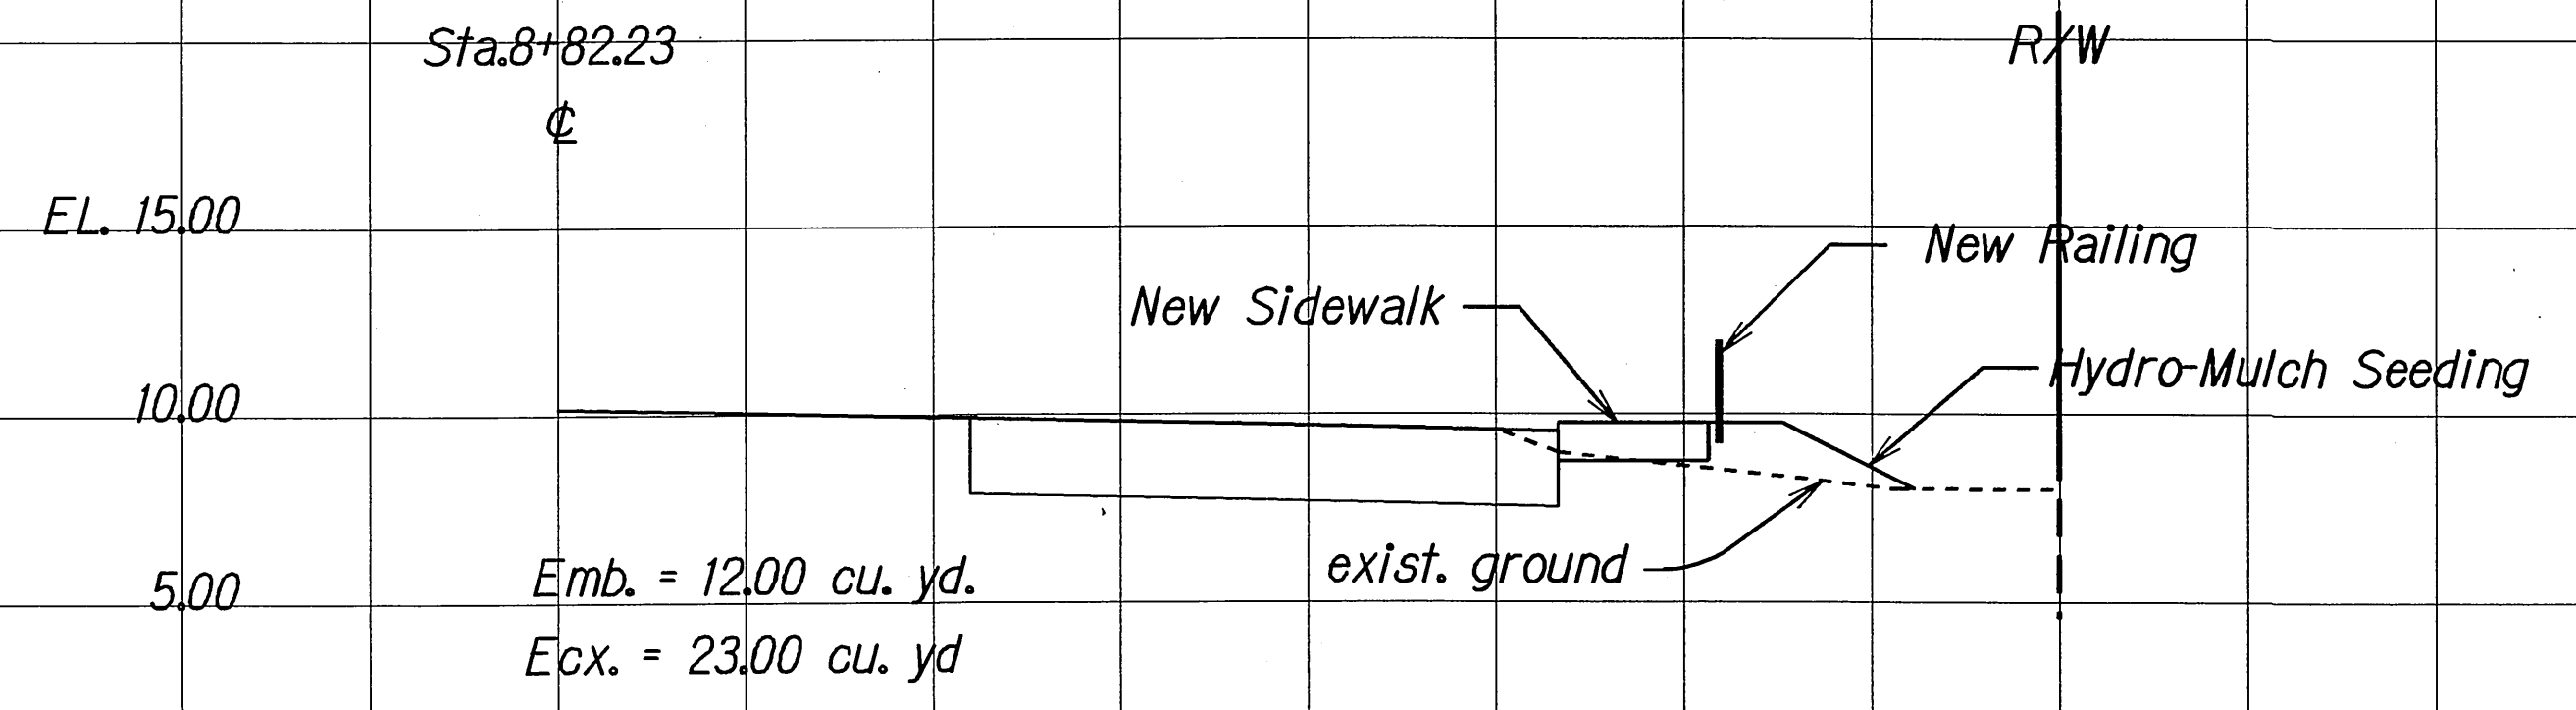

Total Volume
 Emb. = 110.00 cu. yd.
 Exc. = 140.00 cu. yd.

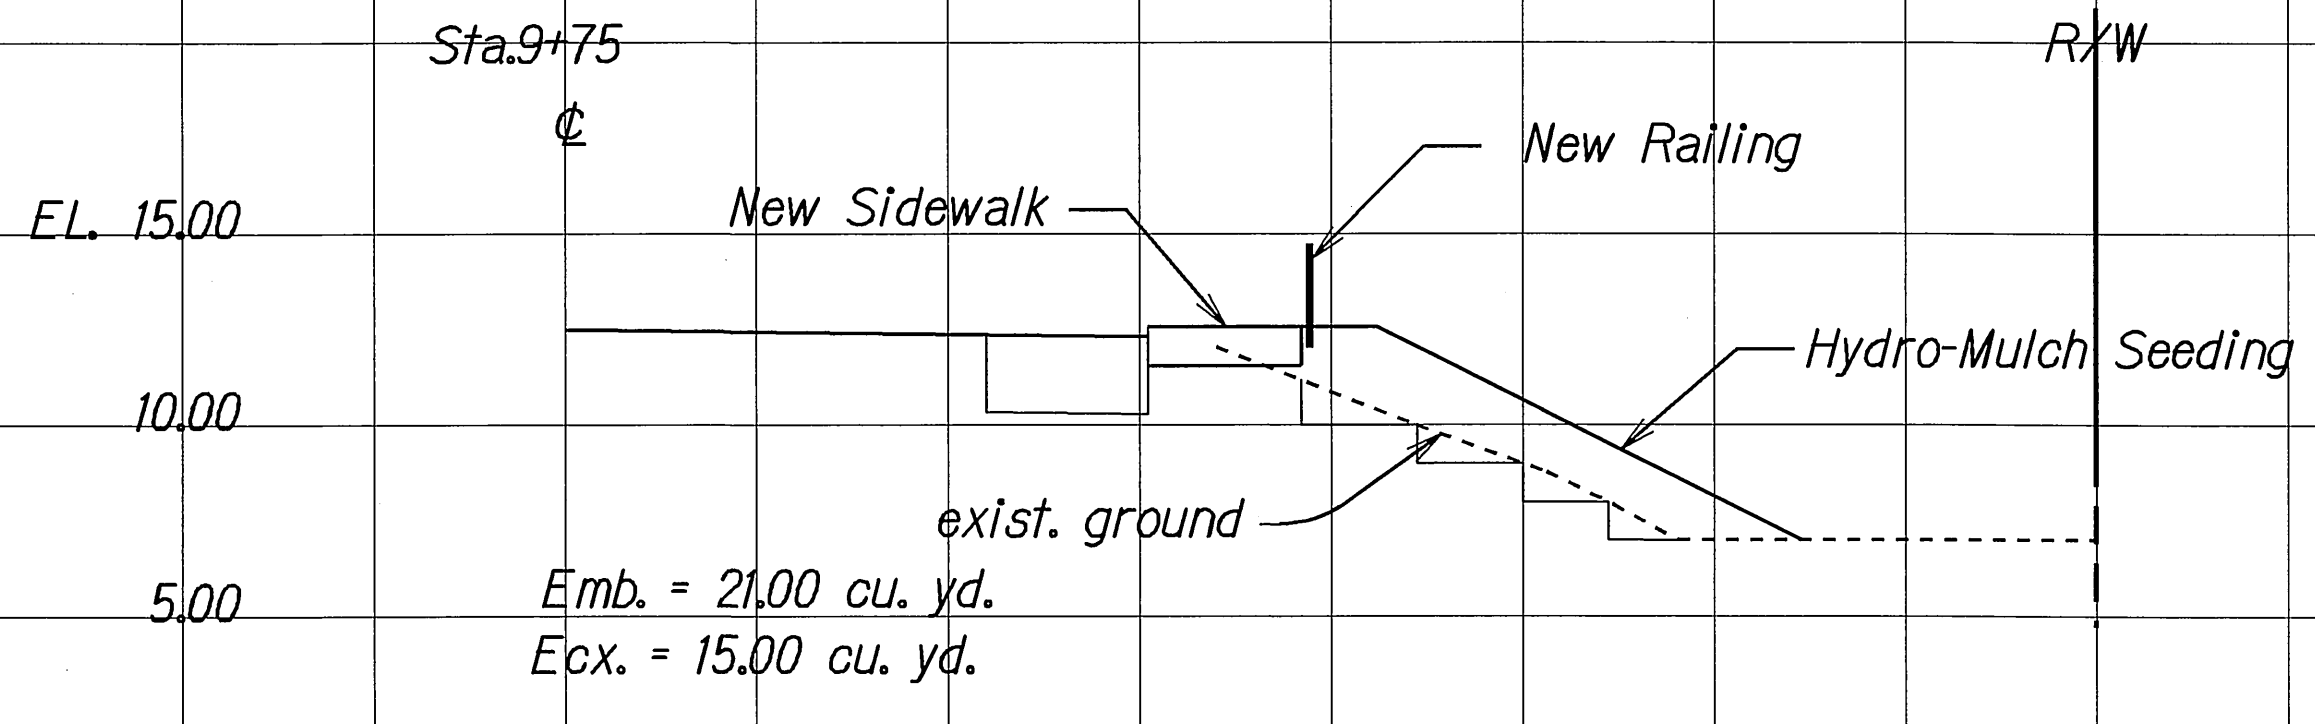

Hor. Scale: 1" = 5'
 Vert. Scale: 1" = 5'

SURVEY PLOTTED BY: DATE: 3/09
 DRAWN BY: X
 DESIGNED BY: X
 QUANTITIES BY: X
 CHECKED BY: X
 ORIGINAL PLAN
 NOTE BOOK
 No. 61843000