



FED. ROAD DIST. NO.	STATE	PROJ. NO.	SHEET NO.	TOTAL SHEETS
HAWAII	HAW.	50D-10-10M	2010	ADD.6

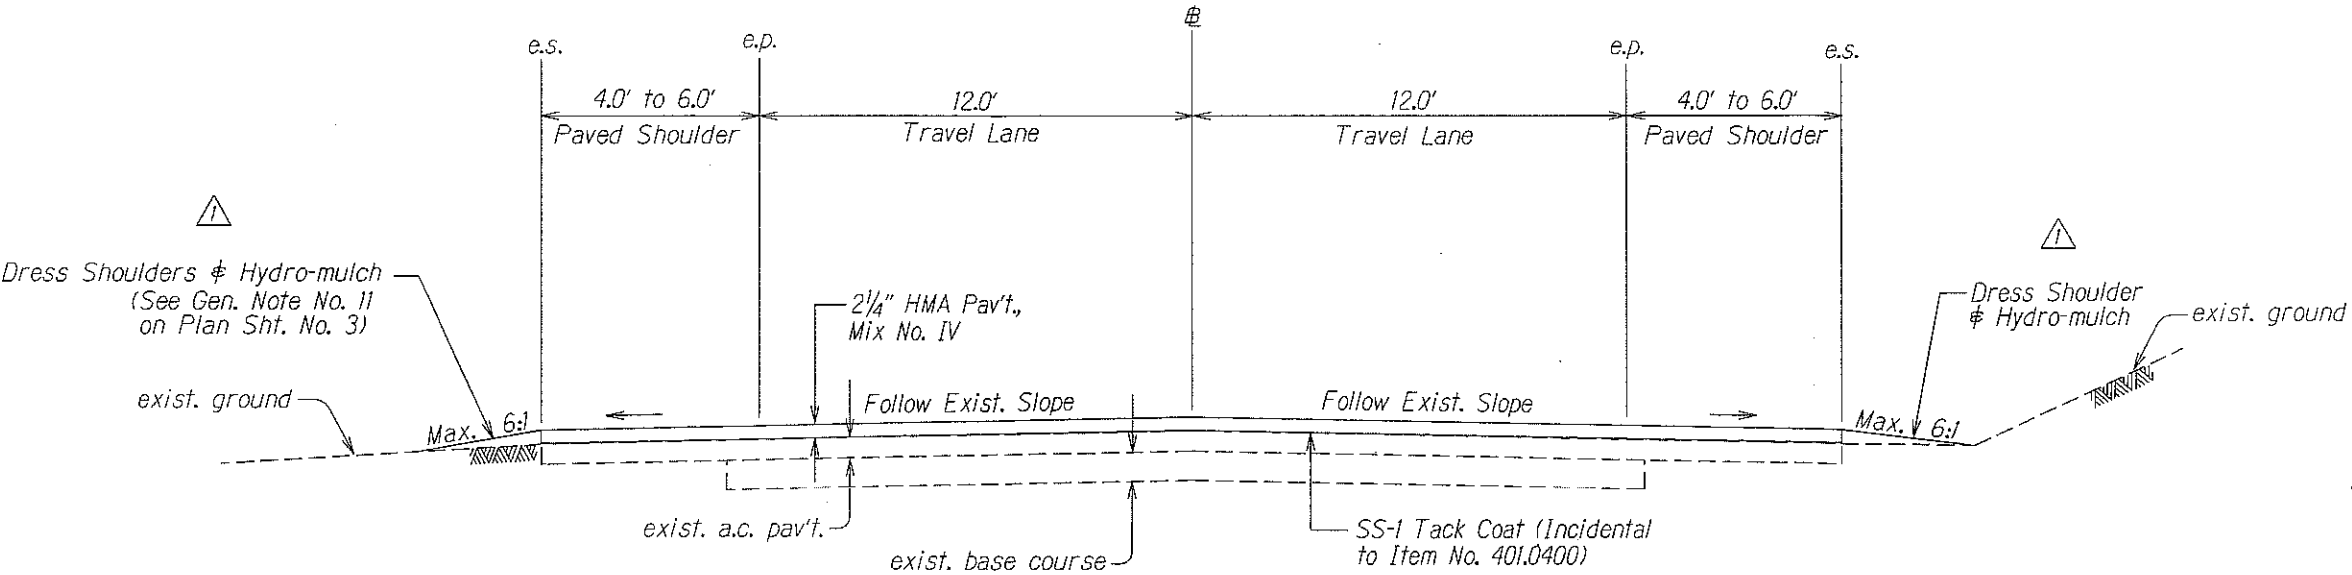

TYPICAL TANGENT SECTION

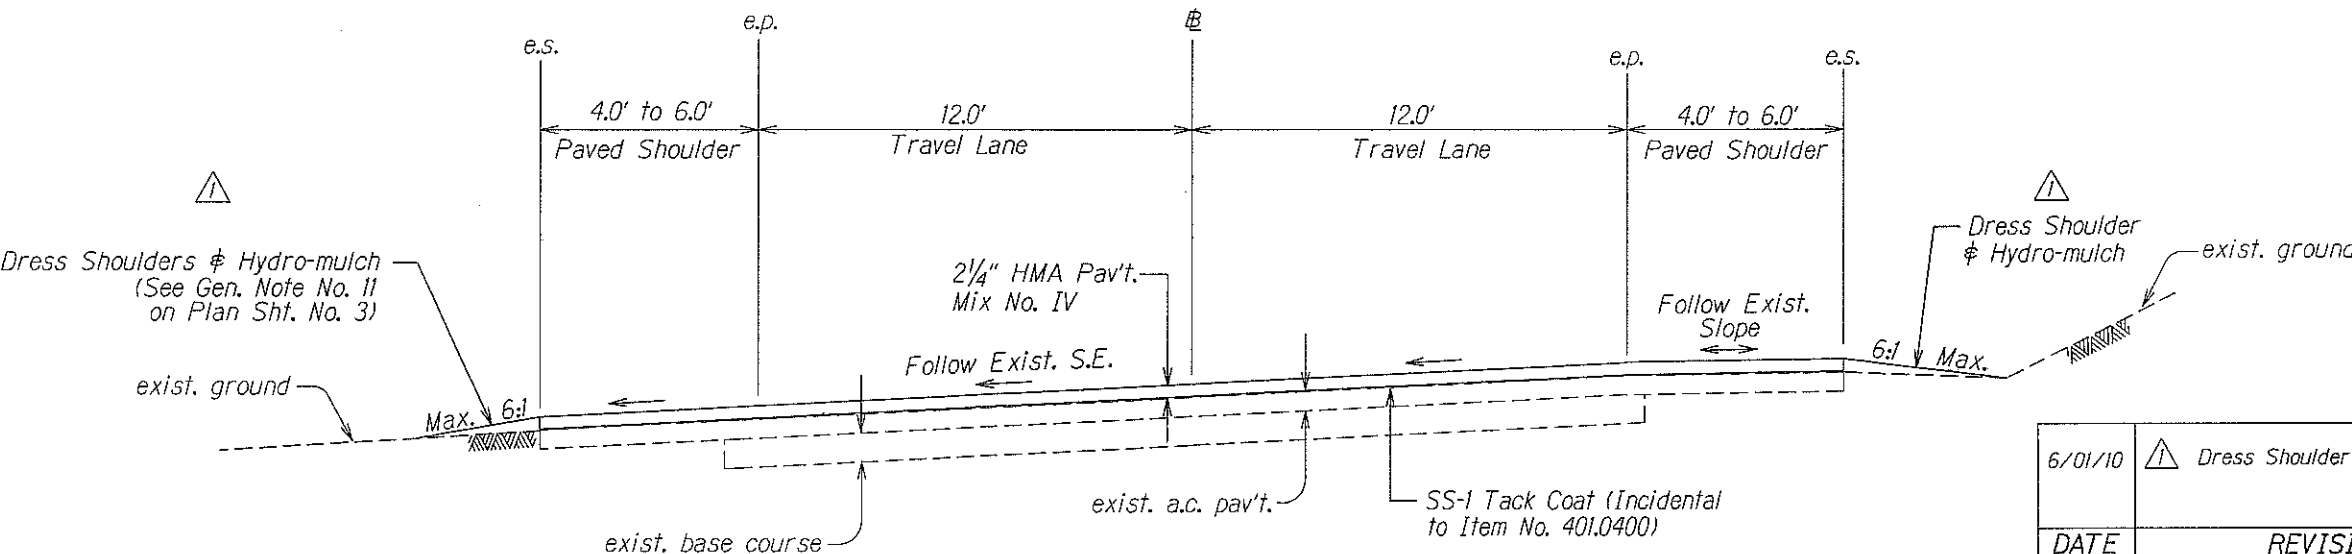


TYPICAL SECTION ON SUPER ELEVATION

6/01/10	△ Dress Shoulder & Hydro-mulch
DATE	REVISION
STATE OF HAWAII DEPARTMENT OF TRANSPORTATION HIGHWAYS DIVISION TYPICAL SECTIONS KAUMUALII HIGHWAY RESURFACING Vicinity of Kipu Road to Anonui Street Project No. 50D-01-10M Not to Scale Date: June 2010	
SHEET No. 1 OF 3 SHEETS	


ORIGINAL PLAN	SURVEY PLATTED BY	DATE
NOTES	DRAWN BY	6/10
DESIGNED BY	DESIGNED BY	
QUANTITIES BY	QUANTITIES BY	
CHECKED BY	CHECKED BY	

FED. ROAD DIST. NO.	STATE	PROJ. NO.	FISCAL YEAR	SHEET NO.	TOTAL SHEETS
HAWAII	HAW.	50D-01-10M	2010	7	19

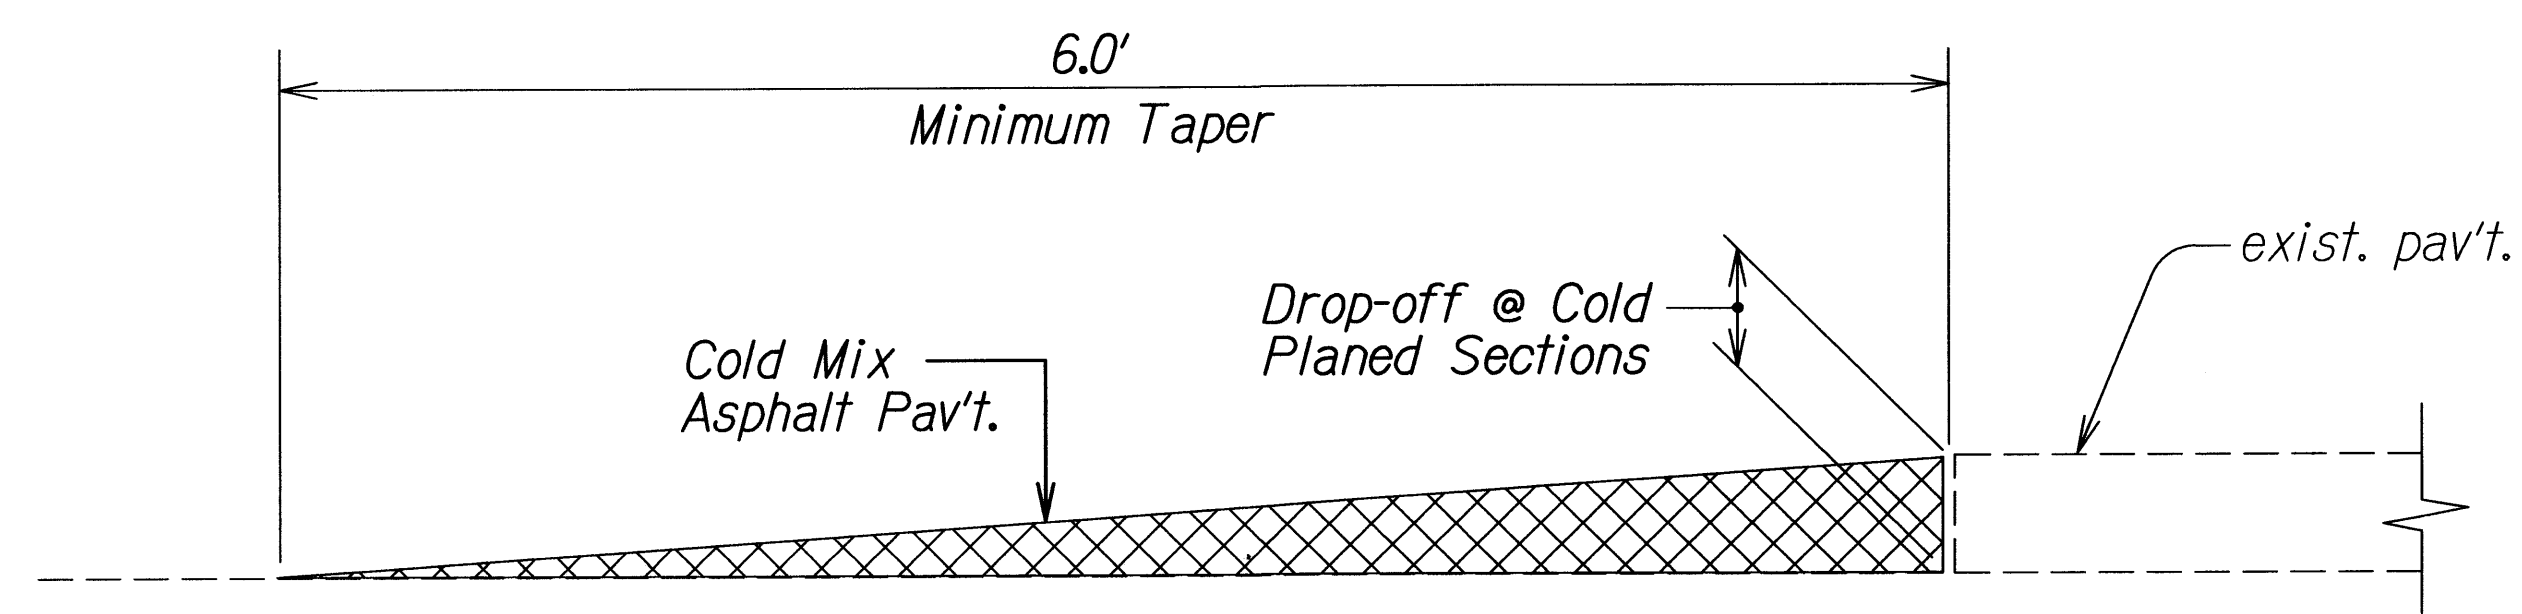


TEMPORARY TRANSITION AT COLD PLANED AREAS
Not to Scale


Note: Contractor shall construct temporary pavement taper to prevent sharp pavement drop-offs at all cold planed sections. Prior to final Hot Mix Asphalt Pavement, Mix No. IV placement, temporary pavement taper shall be removed.

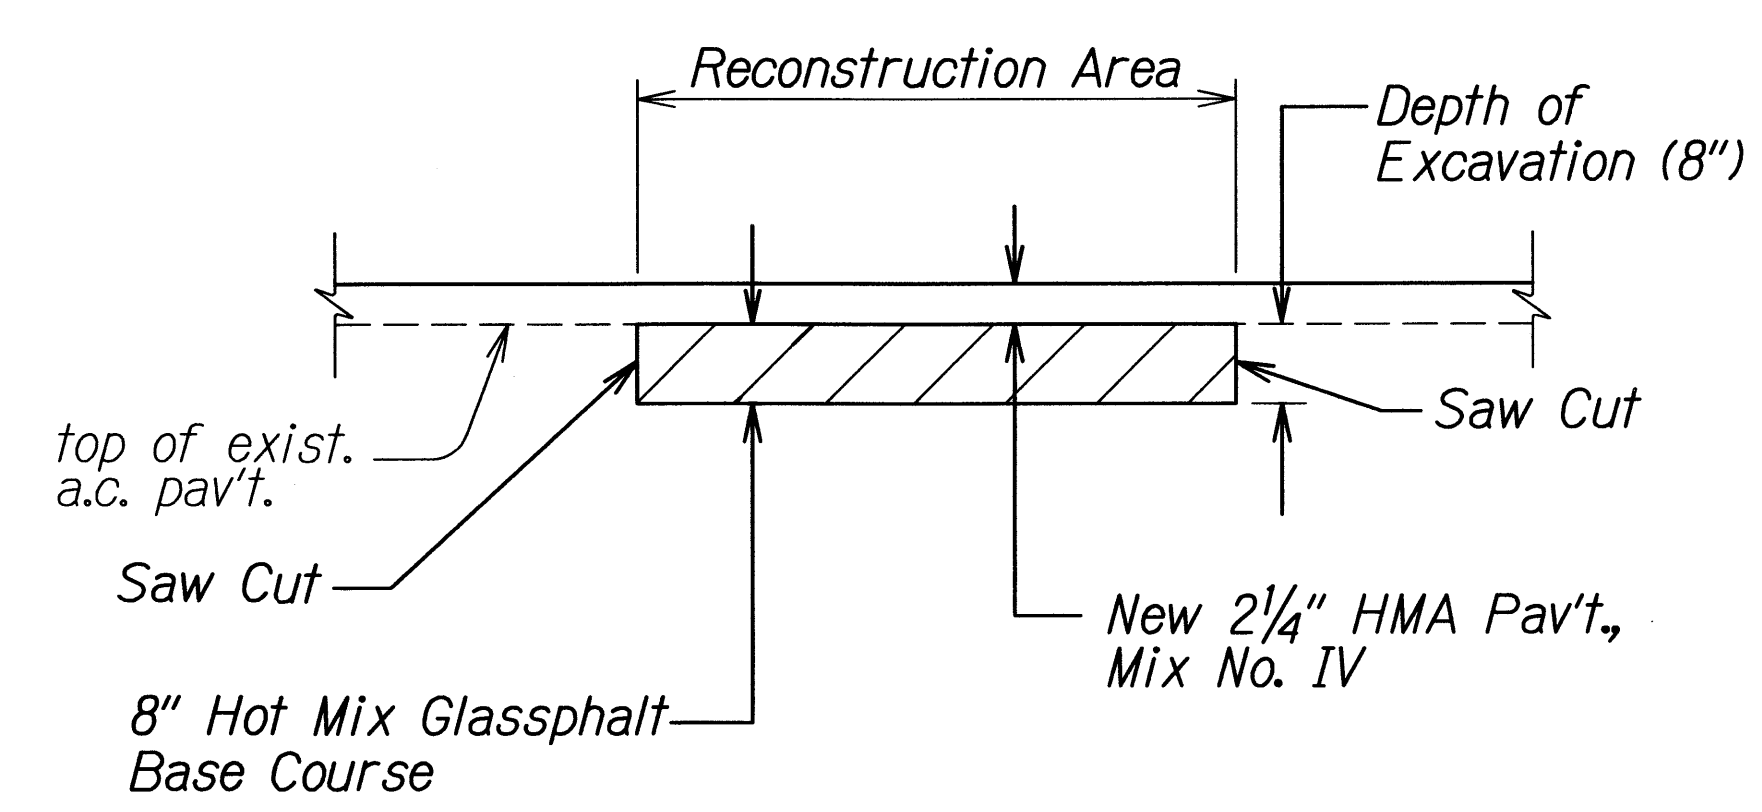

A.C. PAVEMENT RECONSTRUCTION DETAIL
Not to Scale

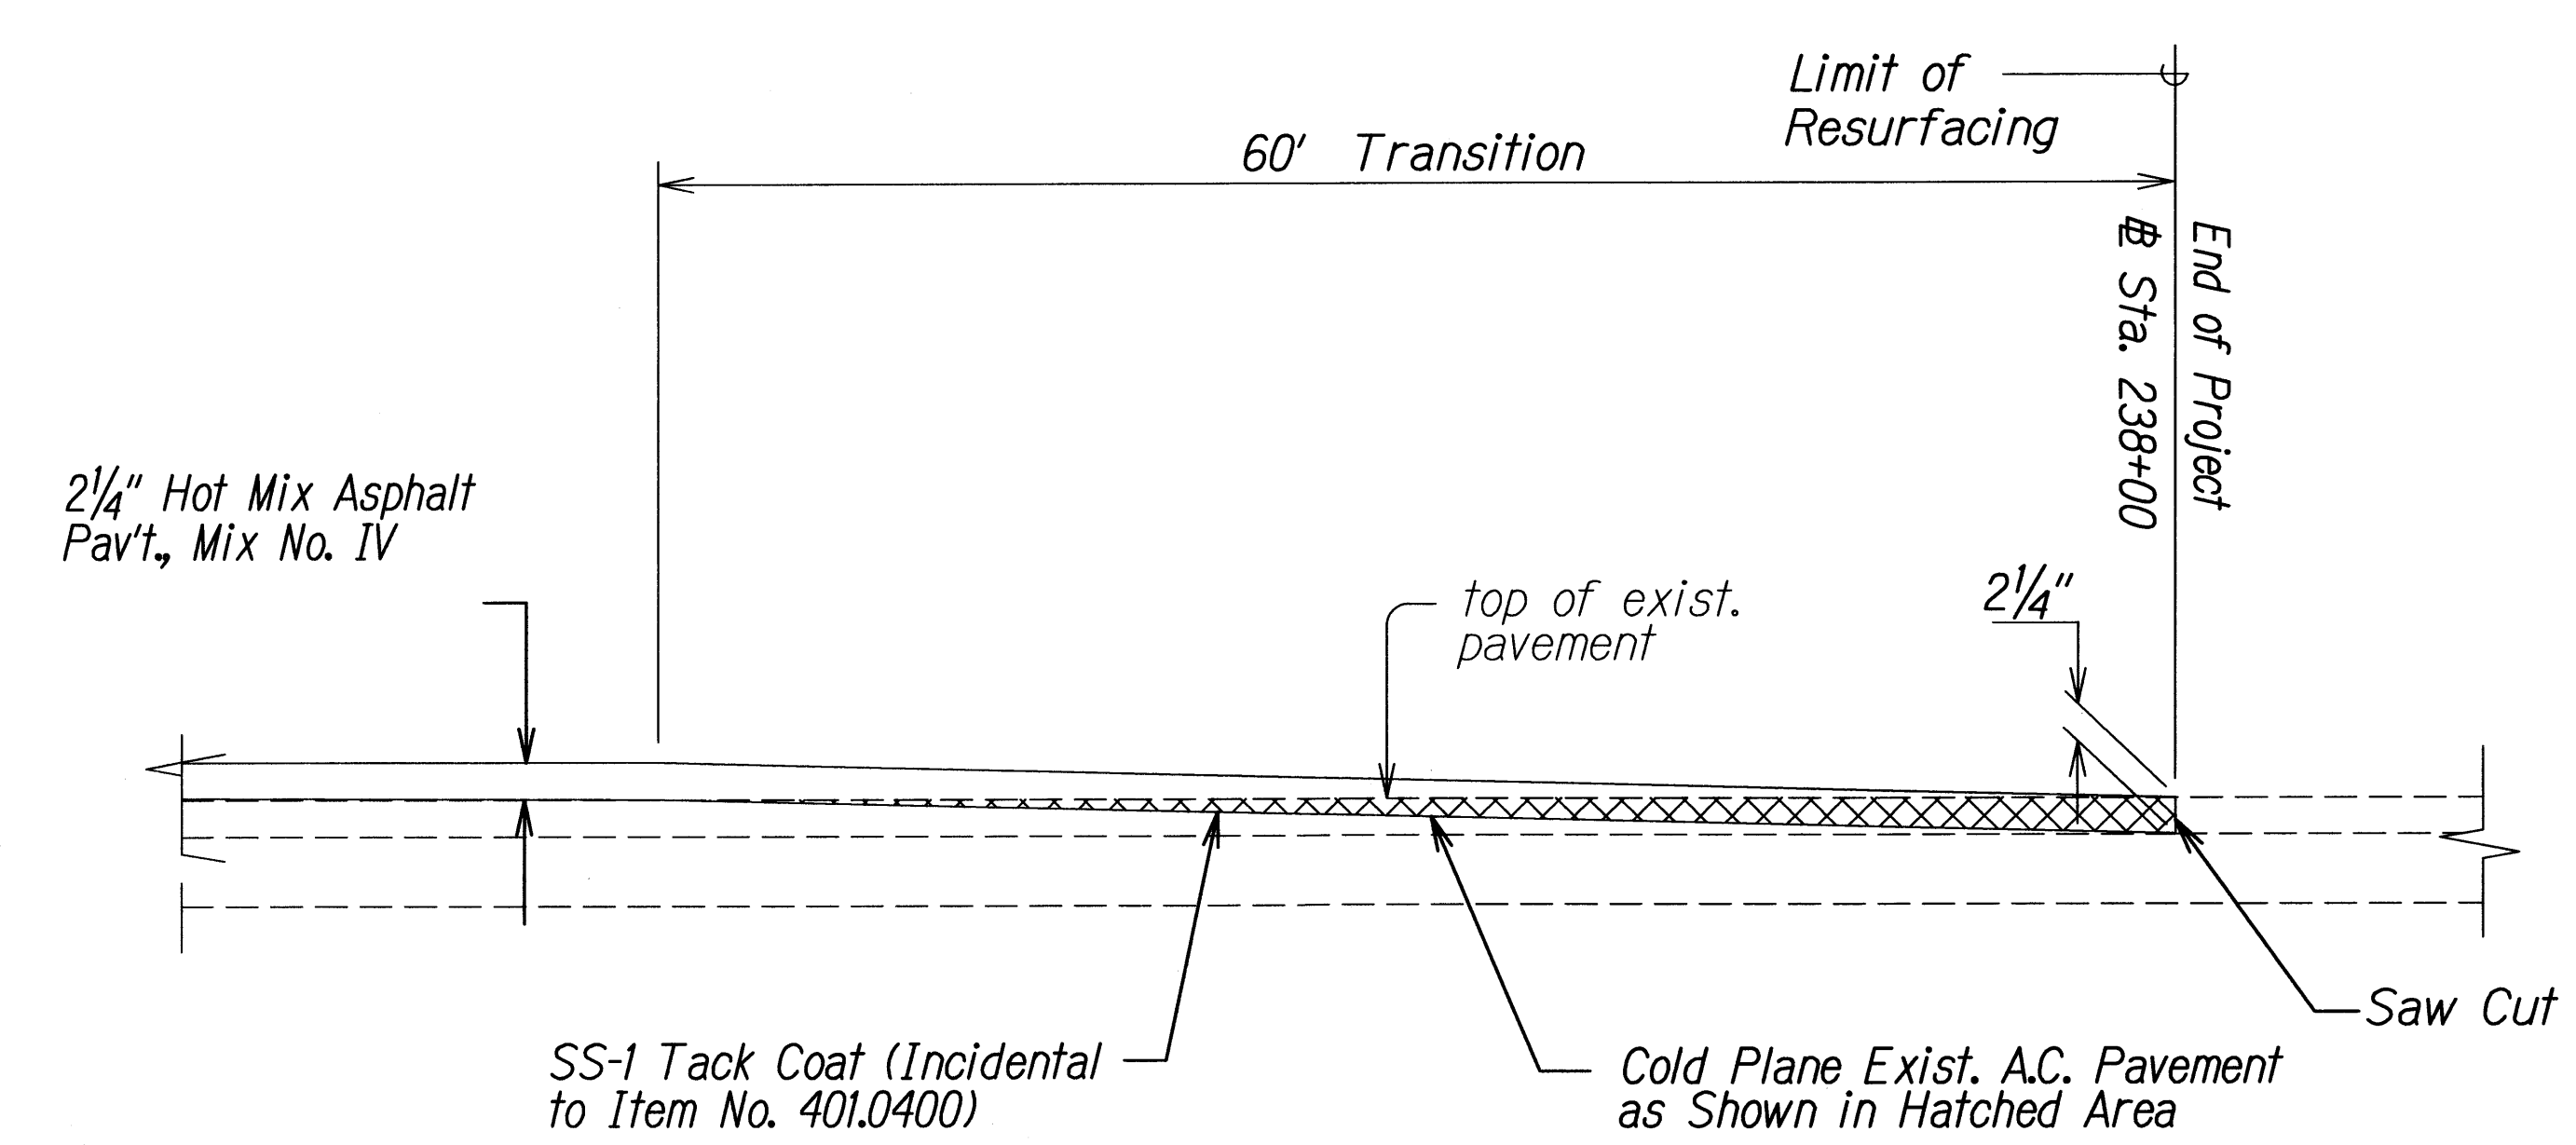

COLD PLANED TRANSITION TO EXISTING A.C. PAVEMENT AT END OF PROJECT
Not to Scale

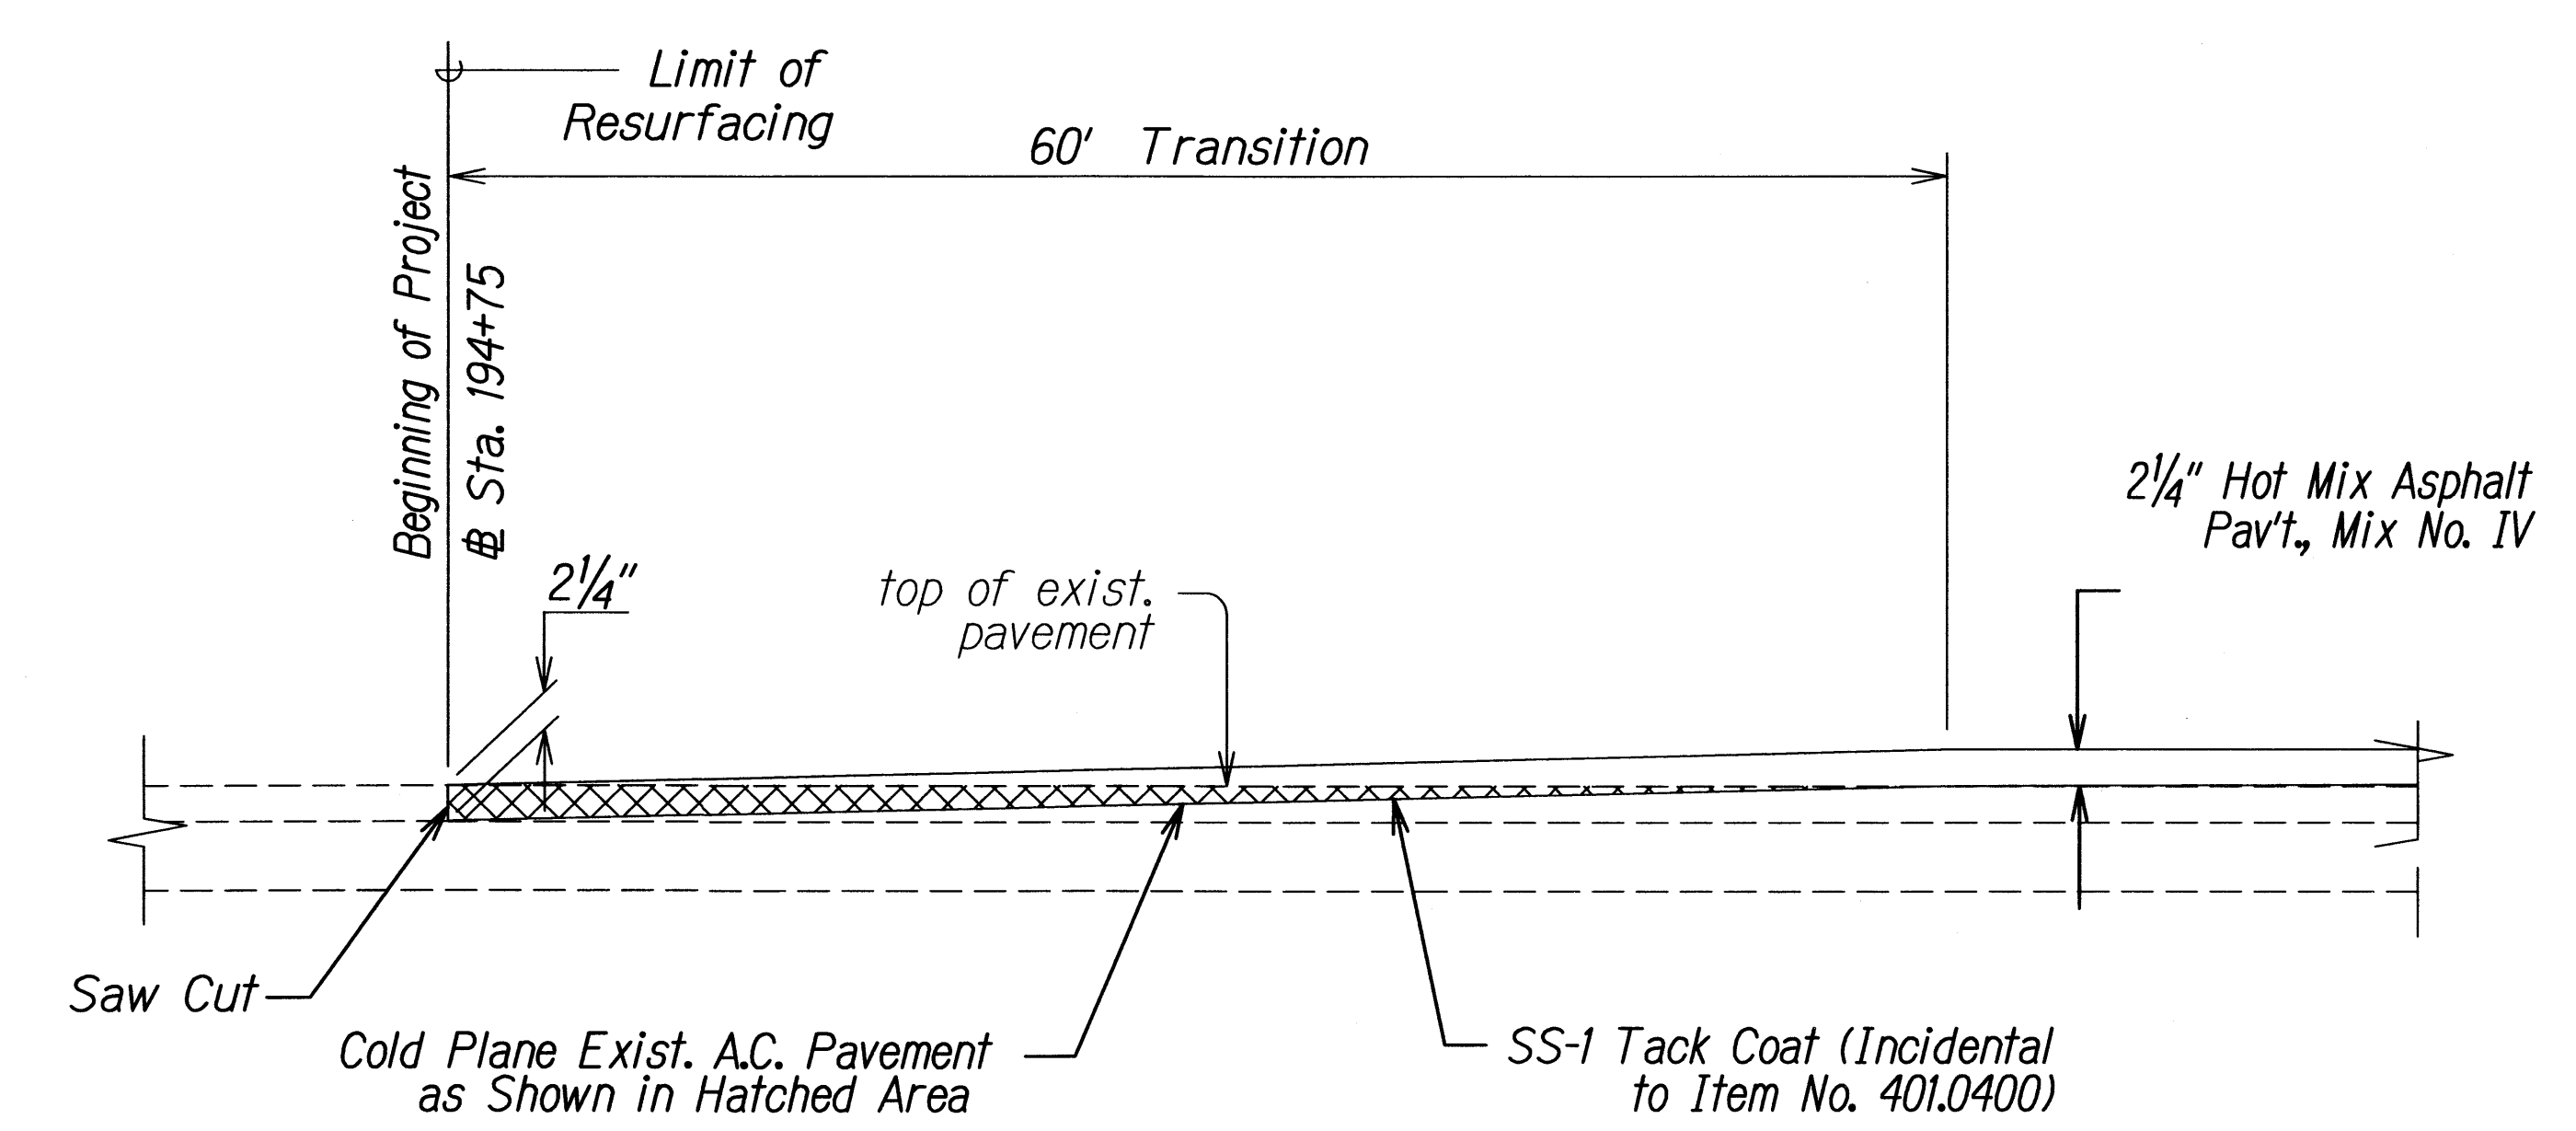

COLD PLANED TRANSITION TO EXISTING A.C. PAVEMENT AT BEGINNING OF PROJECT
Not to Scale

DATE	3/09
SURVEY PLOTTED BY	
DESIGNED BY	
QUANTITIES BY	
CHECKED BY	
ORIGINAL PLAN	
NOTE BOOK	
FILE	

STATE OF HAWAII
DEPARTMENT OF TRANSPORTATION
HIGHWAYS DIVISION

TYPICAL SECTIONS


KAUMUALII HIGHWAY RESURFACING
Vicinity of Kipu Road to Anonui Street

Project No. 50D-01-10M


Not to Scale Date: Feb. 2010

SHEET No. 2 OF 3 SHEETS


FED. ROAD DIST. NO.	STATE	PROJ. NO.	FISCAL YEAR	SHEET NO.	TOTAL SHEETS
HAWAII	HAW.	50D-01-10M	2010	8	19

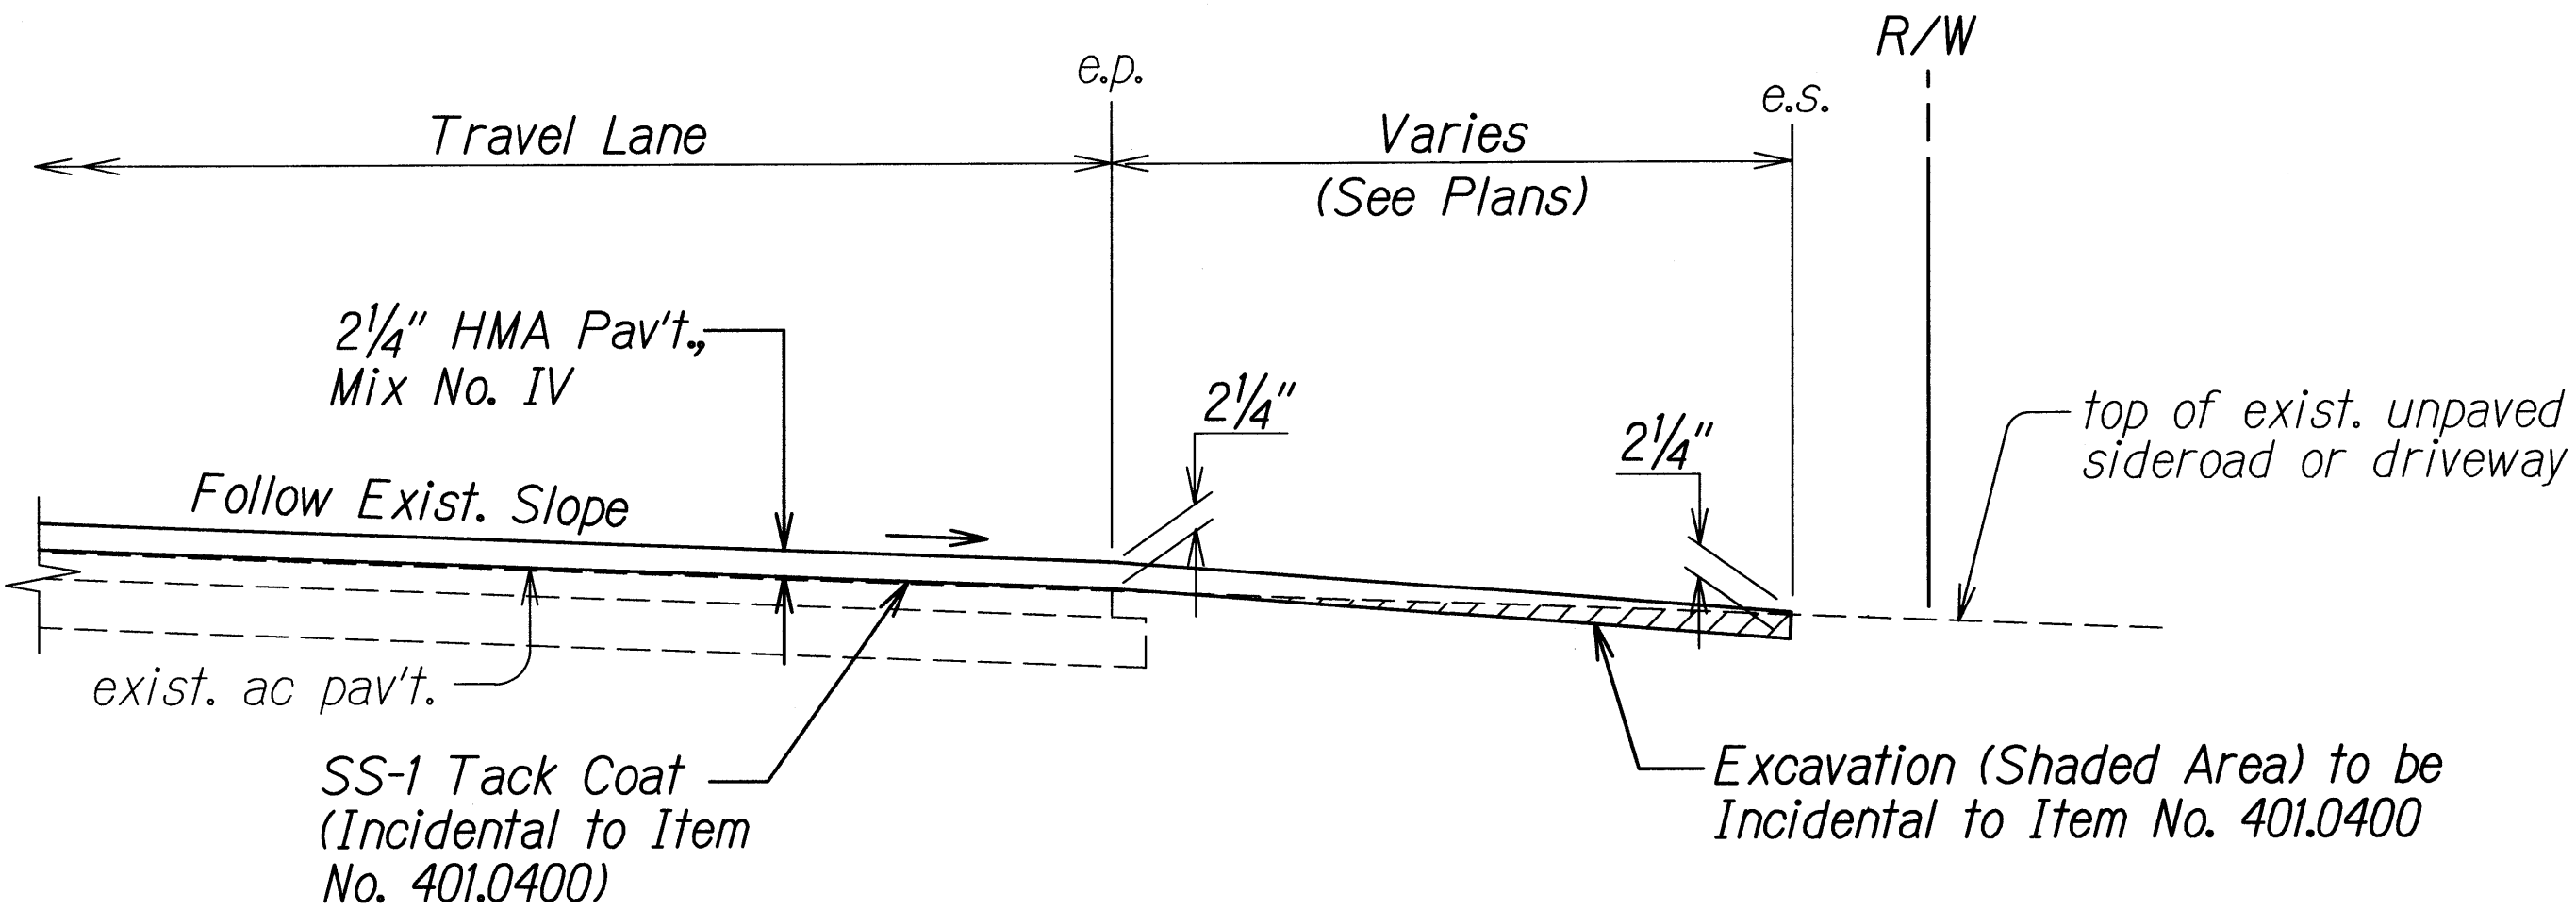


RESURFACING AT UNPAVED SIDEROADS & DRIVEWAYS
Not to Scale

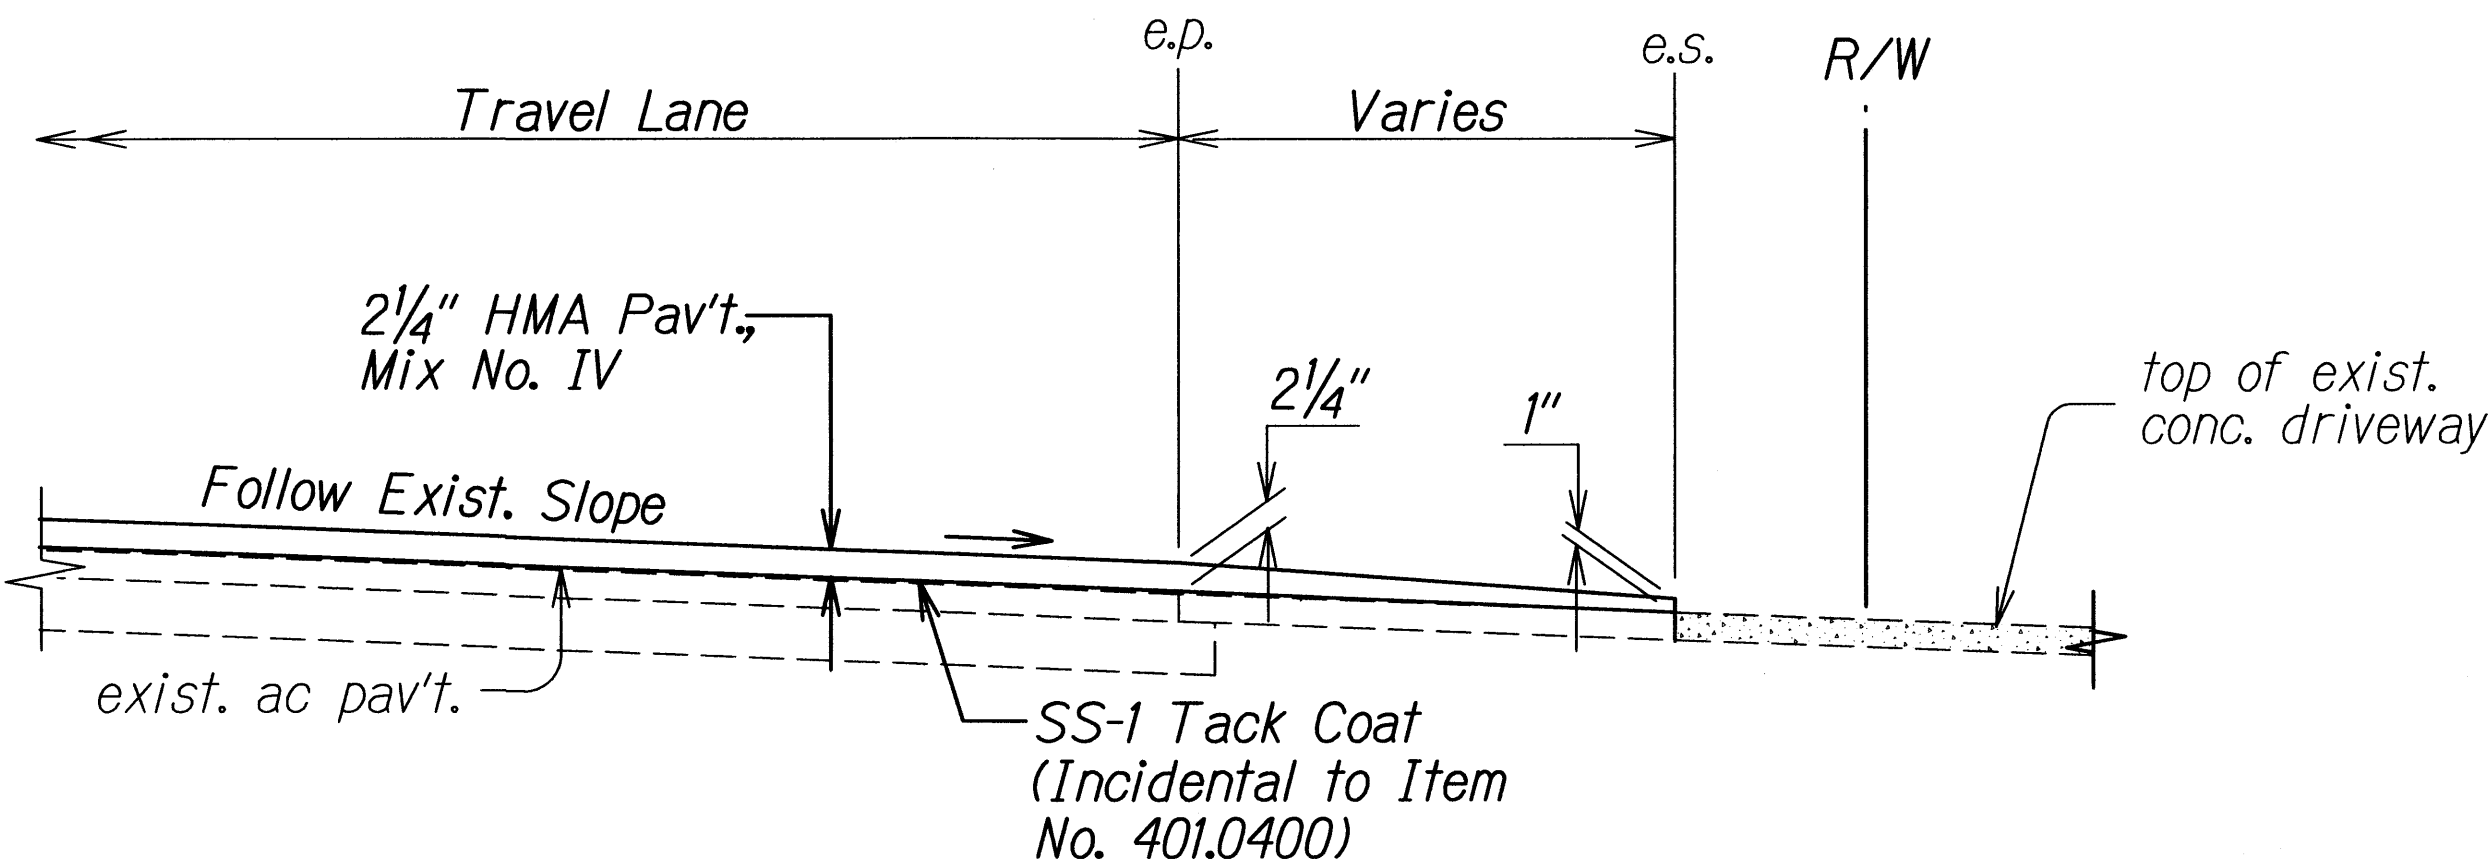

RESURFACING AT CONCRETE DRIVEWAYS
Not to Scale

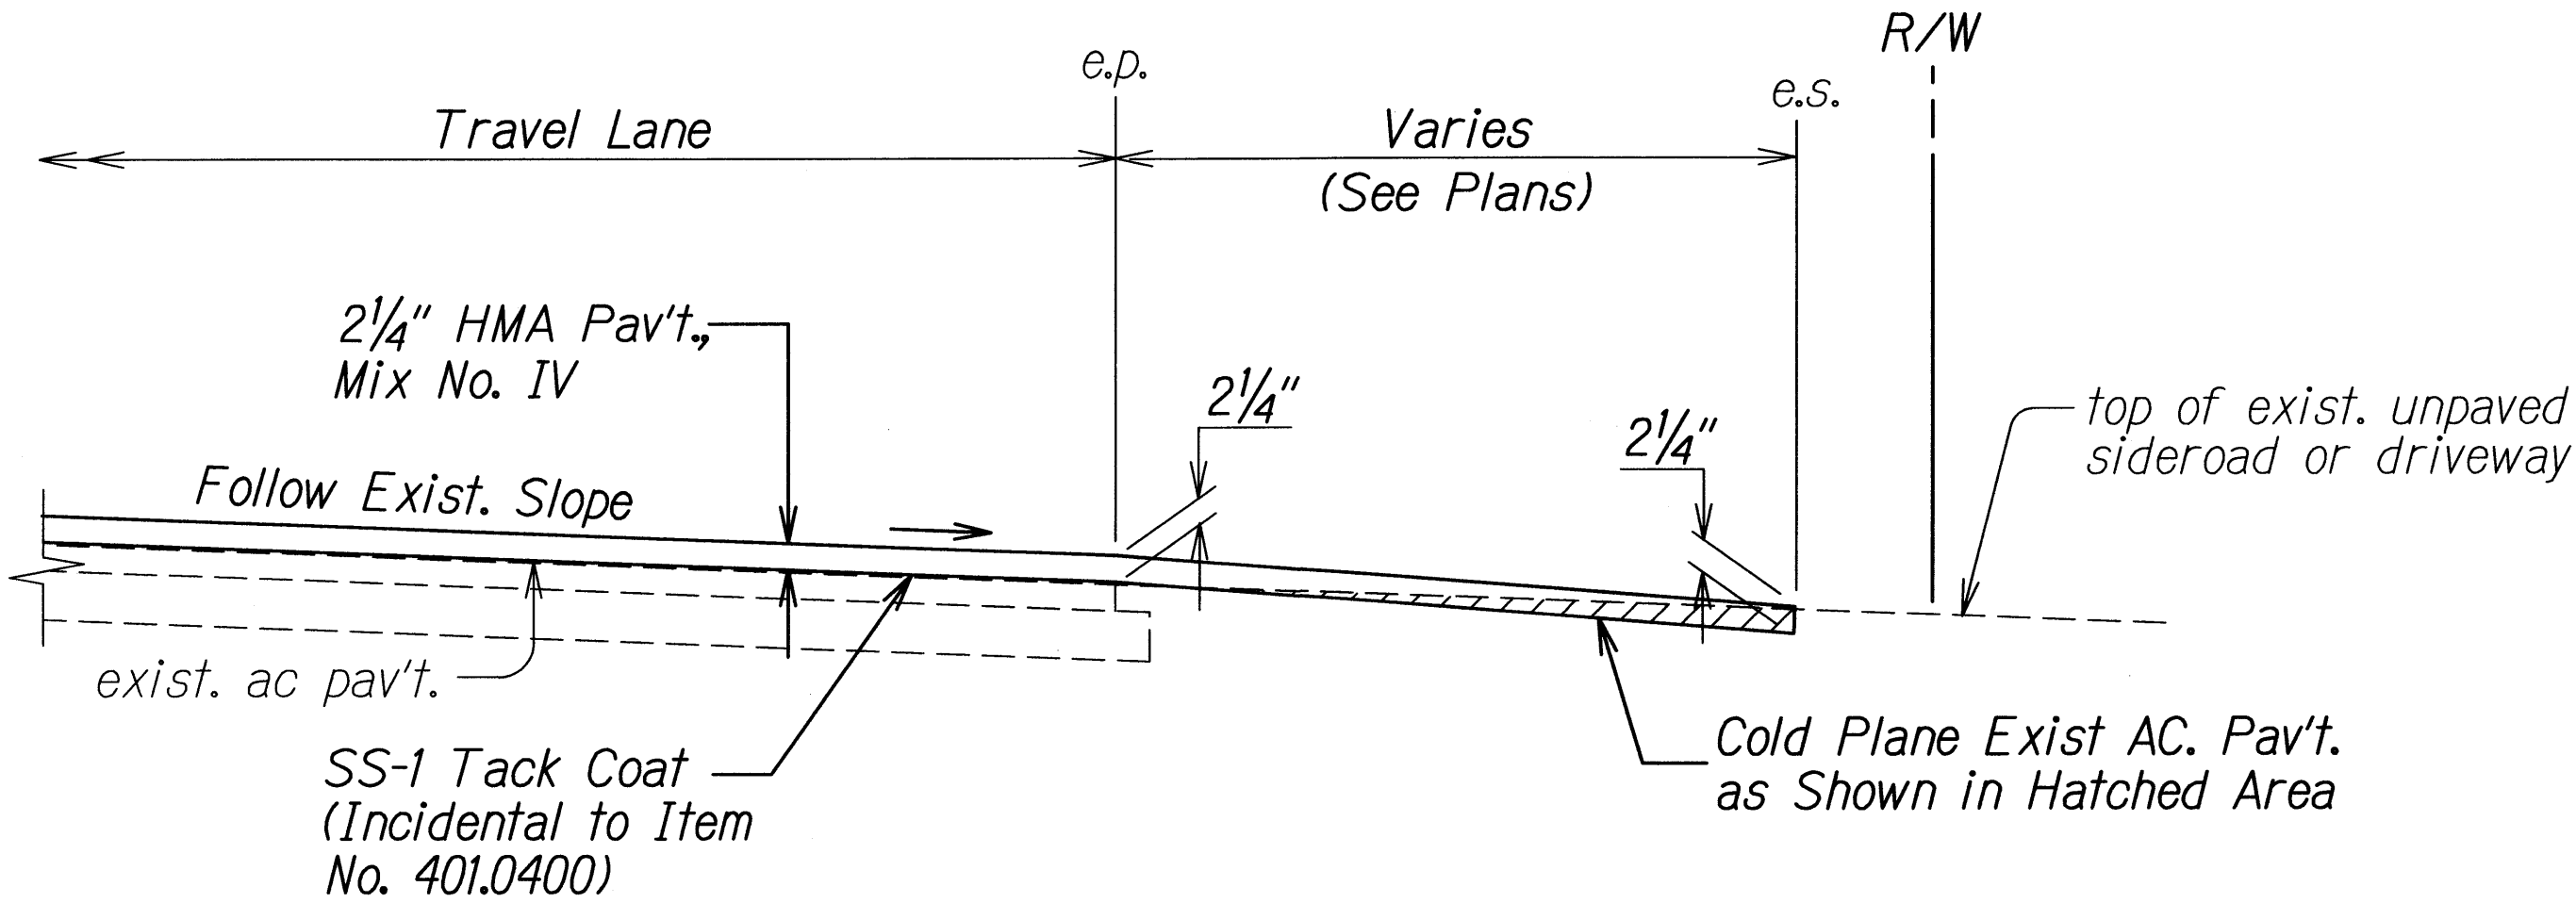

RESURFACING AT PAVED SIDEROADS & DRIVEWAYS
Not to Scale

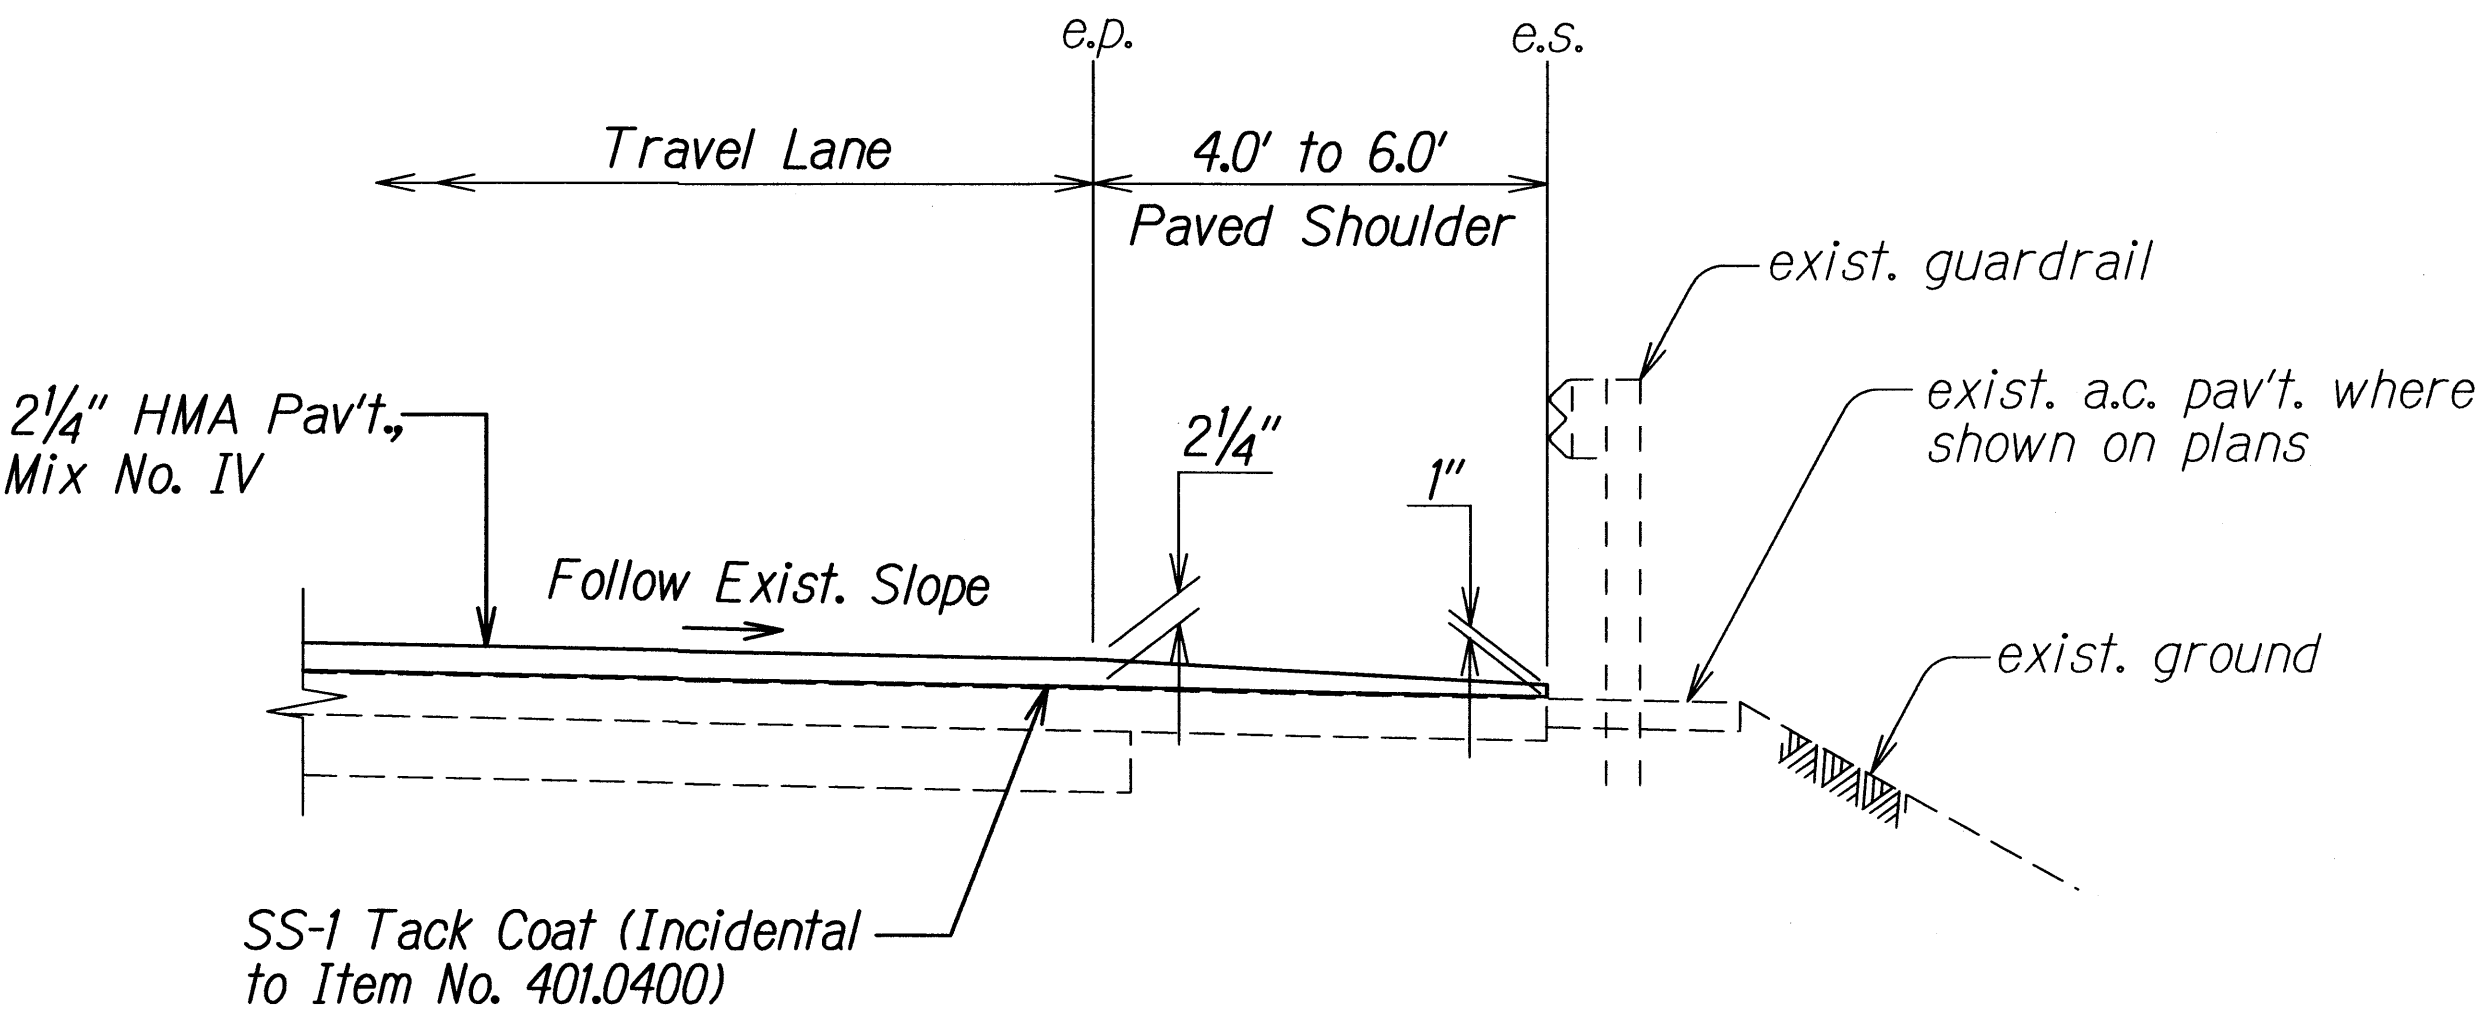

RESURFACING AT GUARDRAIL LOCATIONS
Not to Scale

ORIGINAL PLAN	DATE	2/09
NOTED BY	DESIGNED BY	
QUANTITIES BY	CHECKED BY	

STATE OF HAWAII
DEPARTMENT OF TRANSPORTATION
HIGHWAYS DIVISION

TYPICAL SECTIONS
KAUMUALII HIGHWAY RESURFACING
Vicinity of Kipu Road to Anonui Street
Project No. 50D-01-10M
Not to Scale

Date: Feb. 2010
SHEET No. 3 OF 3 SHEETS