




FED. ROAD DIST. NO.	STATE	PROJ. NO.	FISCAL YEAR	SHEET NO.	TOTAL SHEETS
HAWAII	HAW.	50D-01-IIMR	2014	12	32

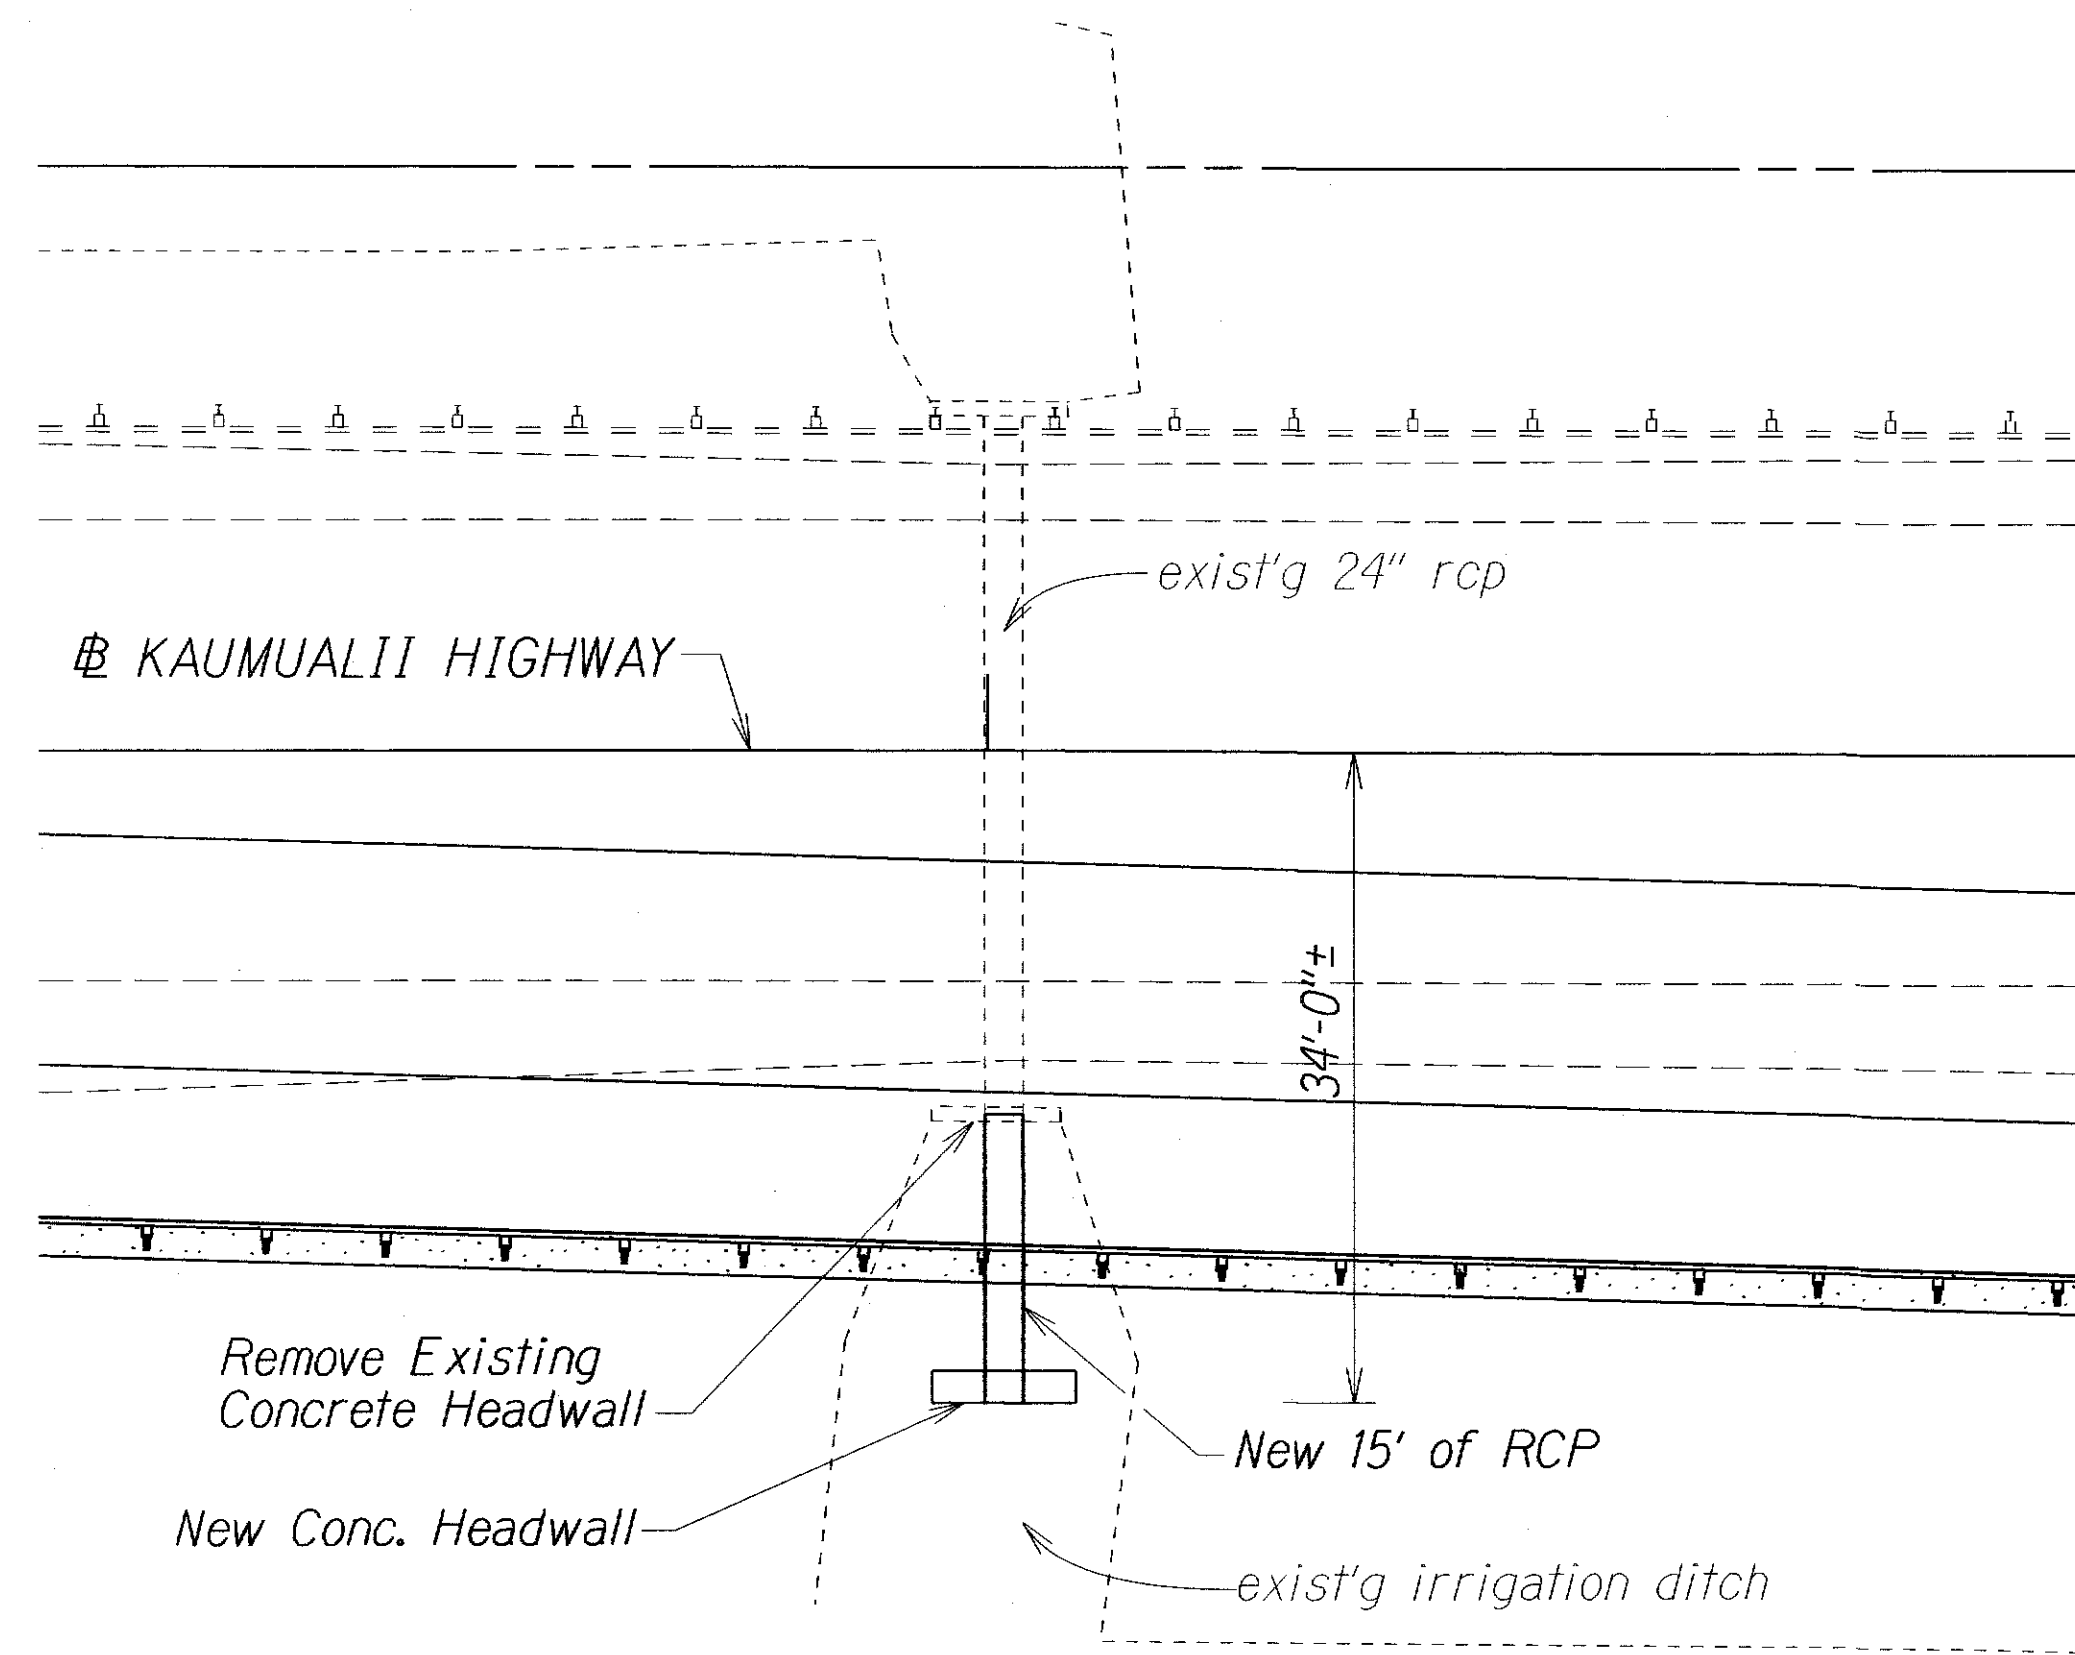


CULVERT PLAN AT STA. 167+00.83±
Scale: 1"=10'

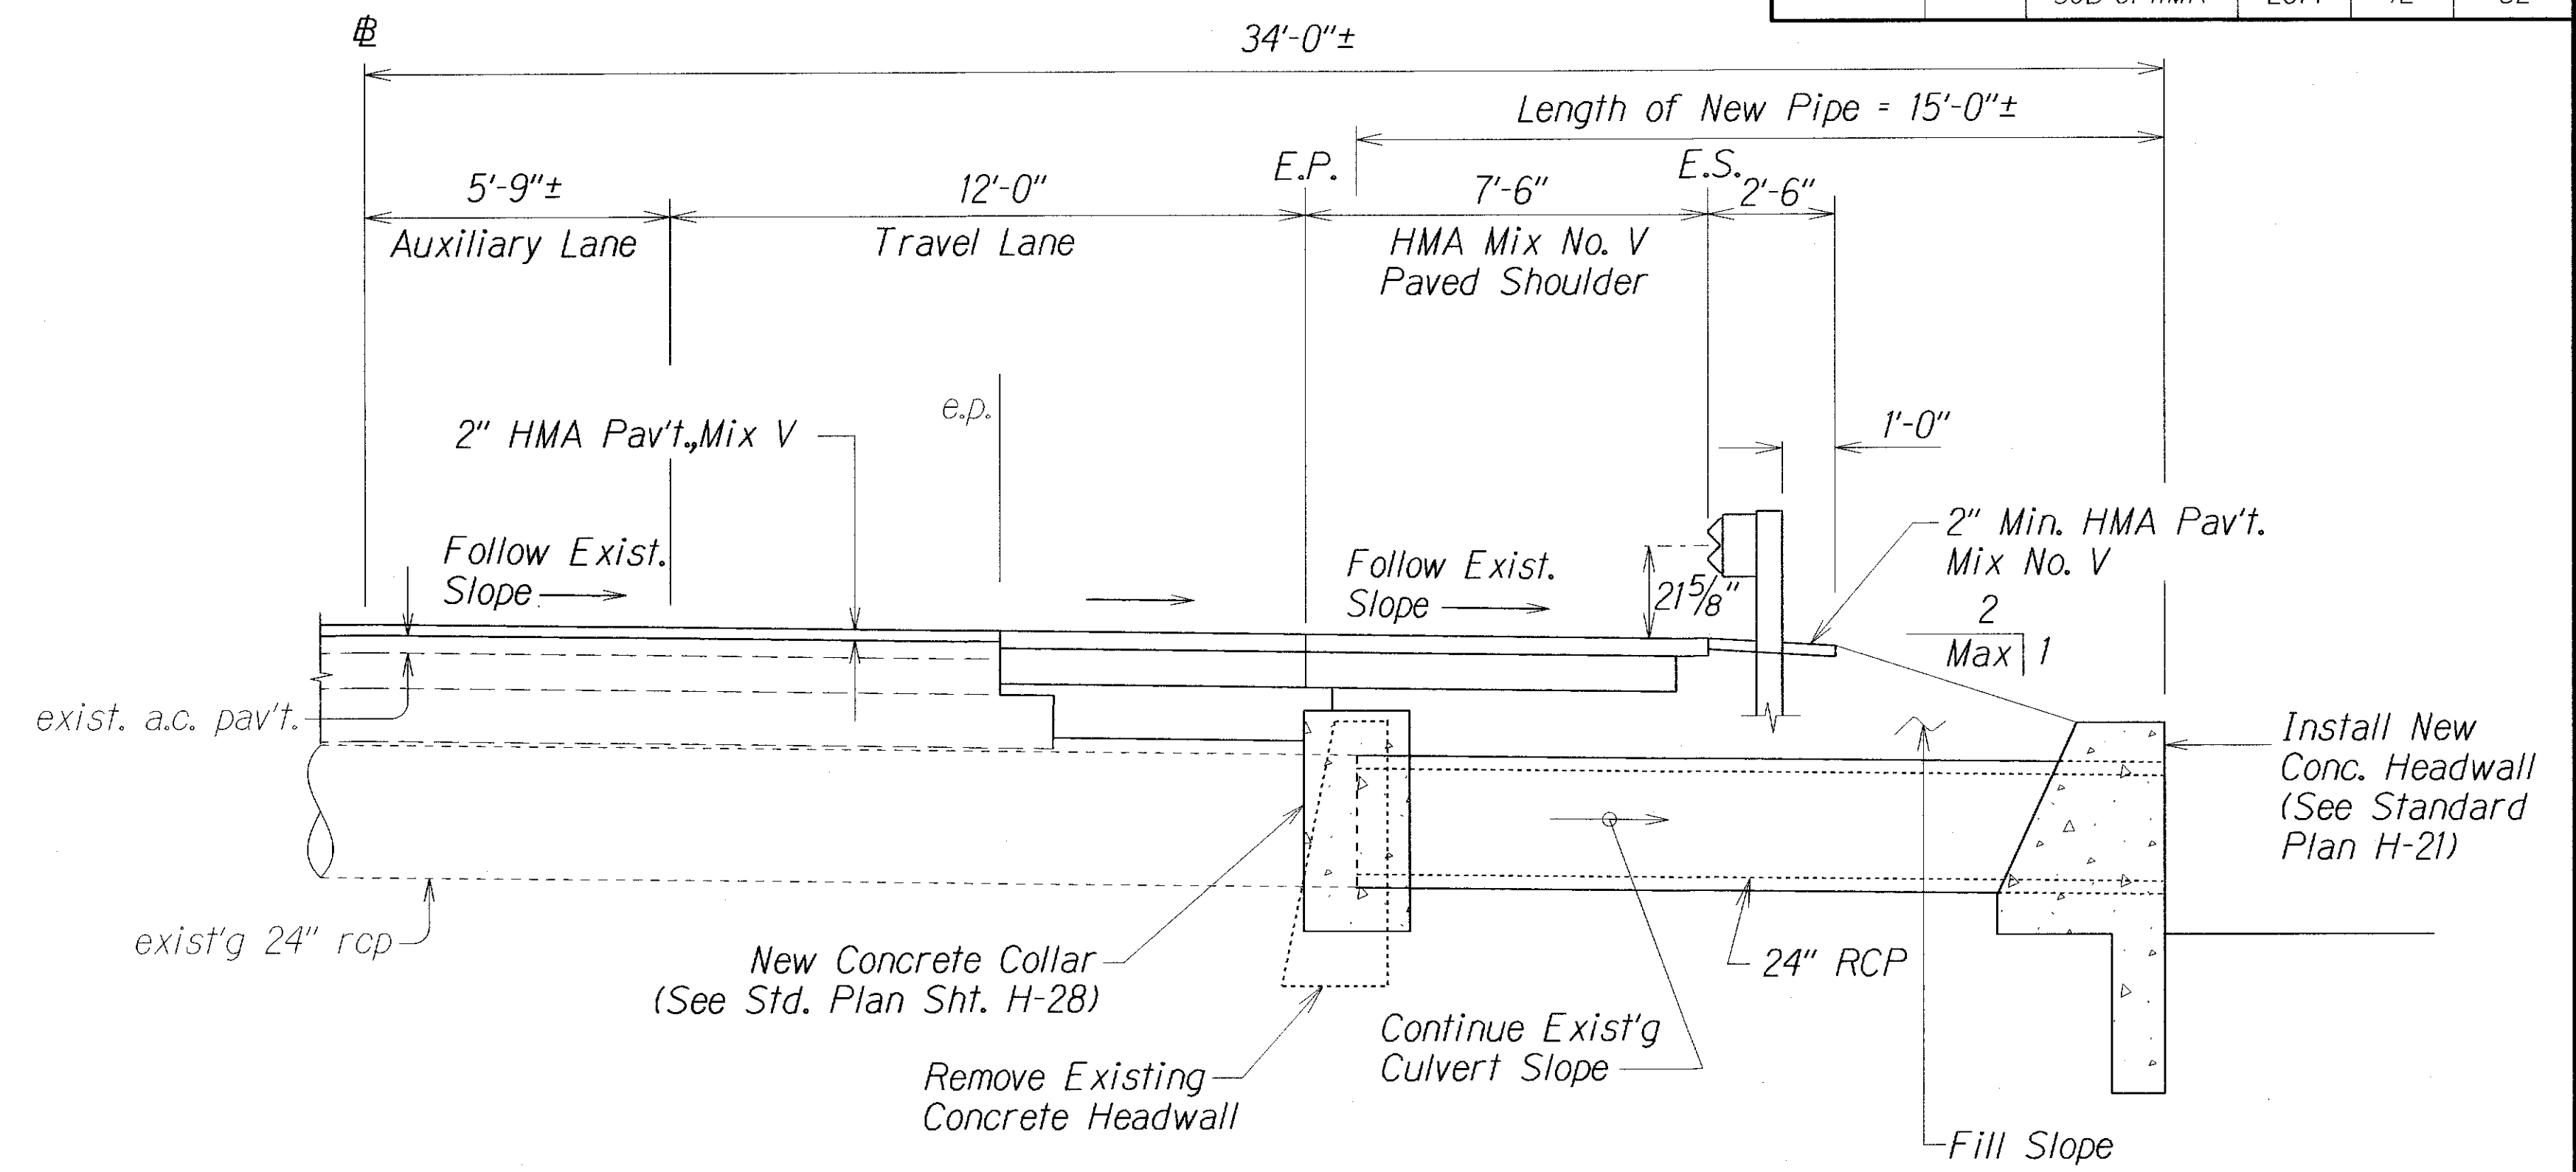

CULVERT ELEVATION AT STA. 167+00.83±
Scale: 3/8"=1'-0'

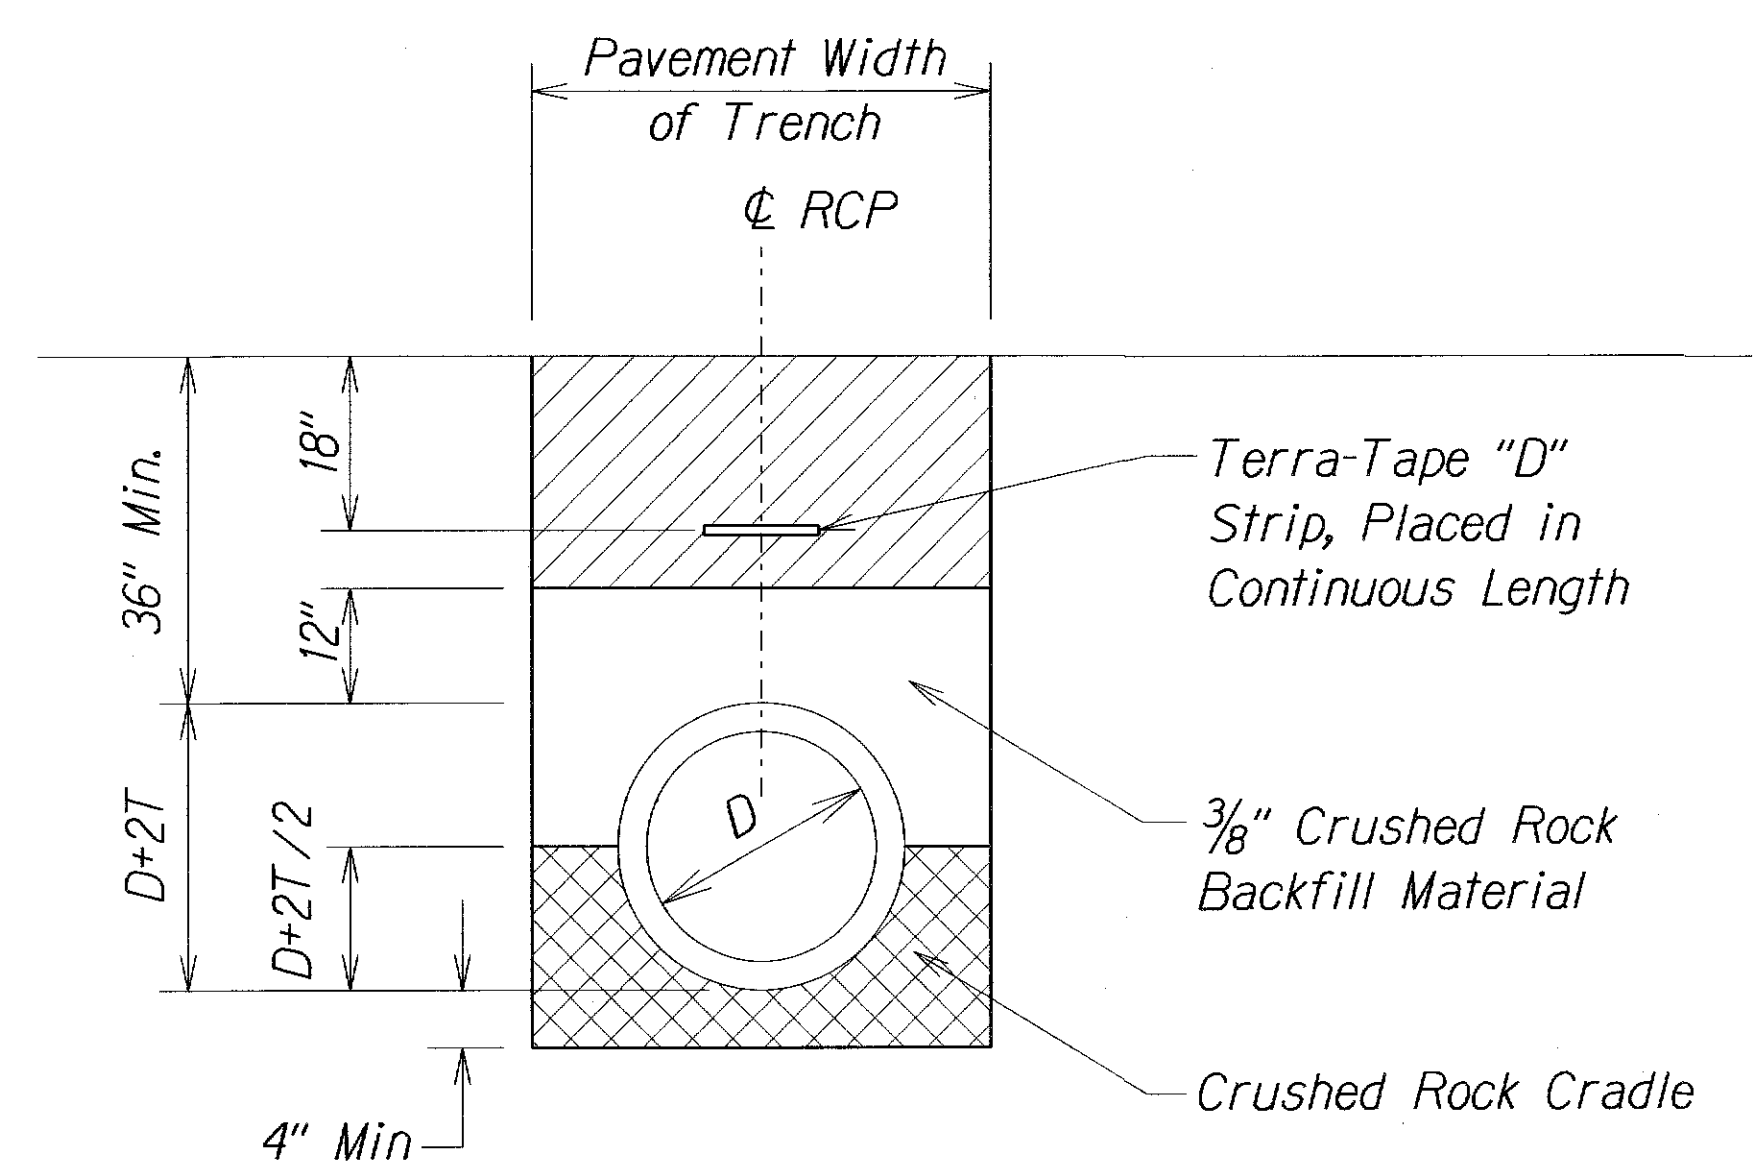

TRENCH RESTORATION - UNPAVED AREA
Not to Scale

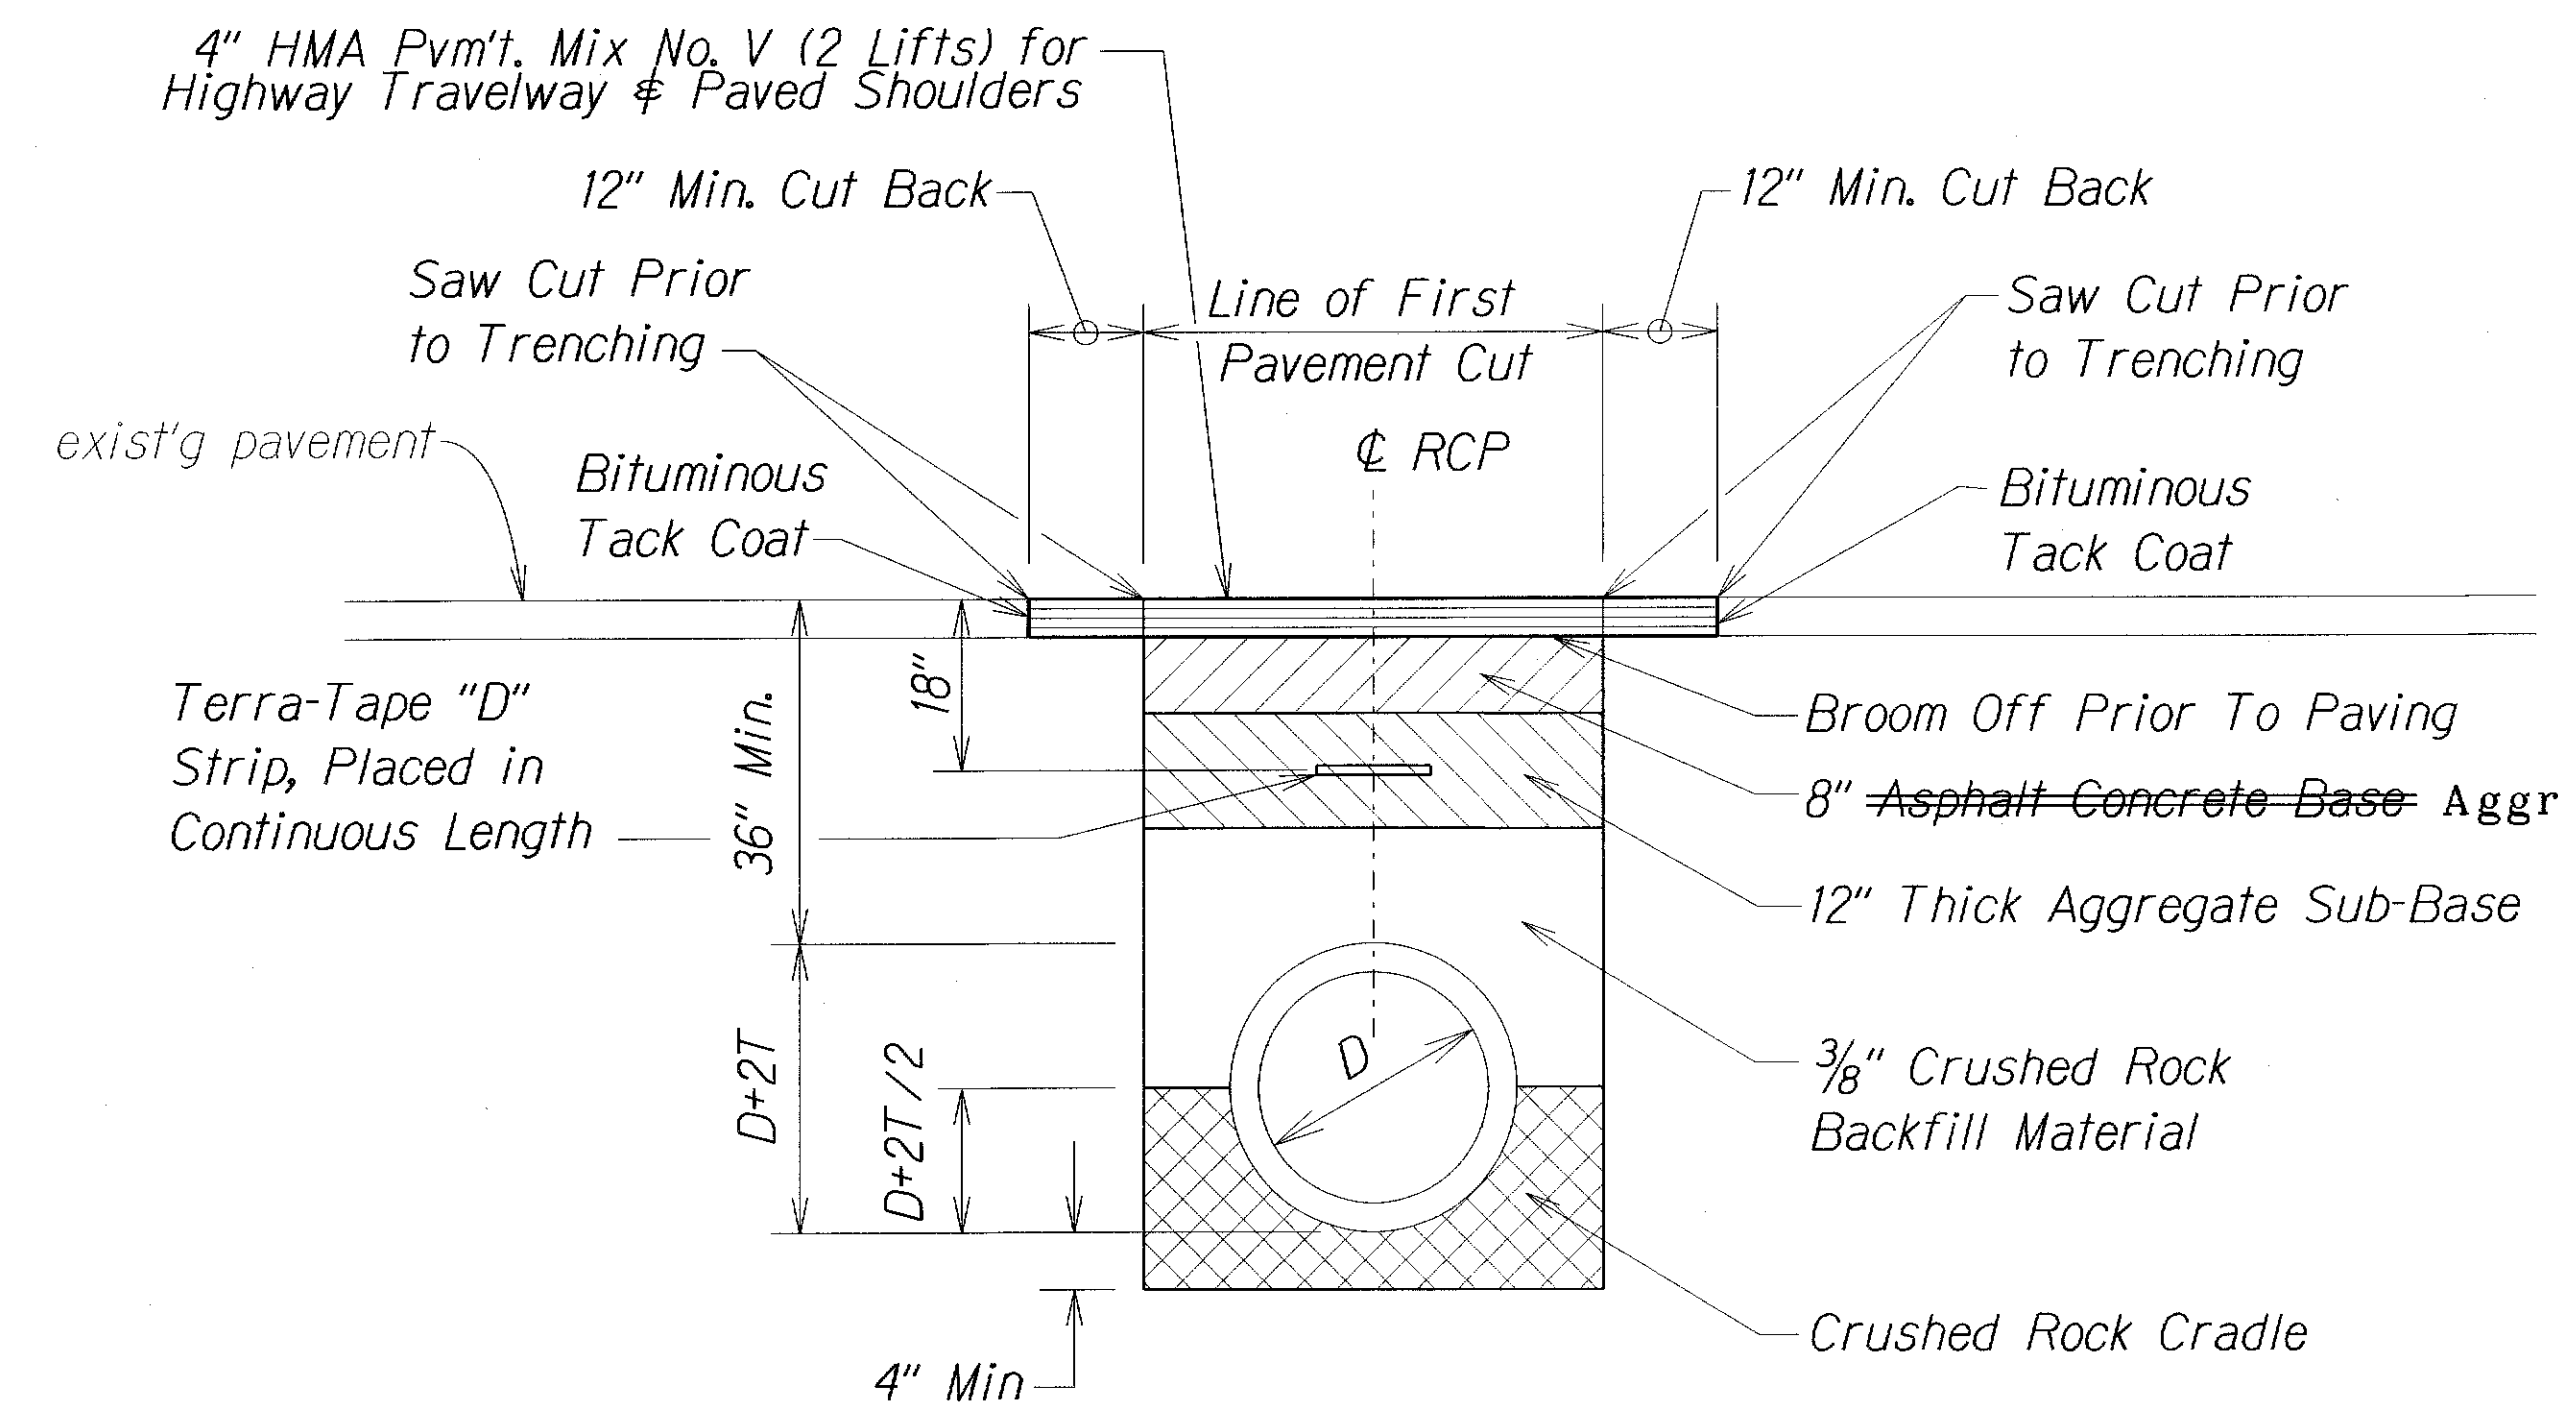

TRENCH RESTORATION - PAVED AREA
Not to Scale

LEGEND FOR AS-BUILT POSTINGS	
	Squiggly line for as-built deletion
	Double line for as-built deletion
Roadway	Text for as-built posting

STATE OF HAWAII

DEPARTMENT OF TRANSPORTATION

HIGHWAYS DIVISION

CULVERT DETAILS

KAUMUALII HIGHWAY RESURFACING

Kipu Road to Huleia Bridge

Proj. No. 50D-01-IIMR

Scale: As Shown

Date: Oct. 2013

SHEET No. 1 OF 1 SHEETS

ORIGINAL PLAN	DATE
NOTED BY	DESIGNED BY
QUANTITIES BY	CHECKED BY

"AS-BUILT"