


FED. ROAD DIST. NO.	STATE	PROJ. NO.	FISCAL YEAR	SHEET NO.	TOTAL SHEETS
HAWAII	HAW.	50D-01-11M	2012	31	31

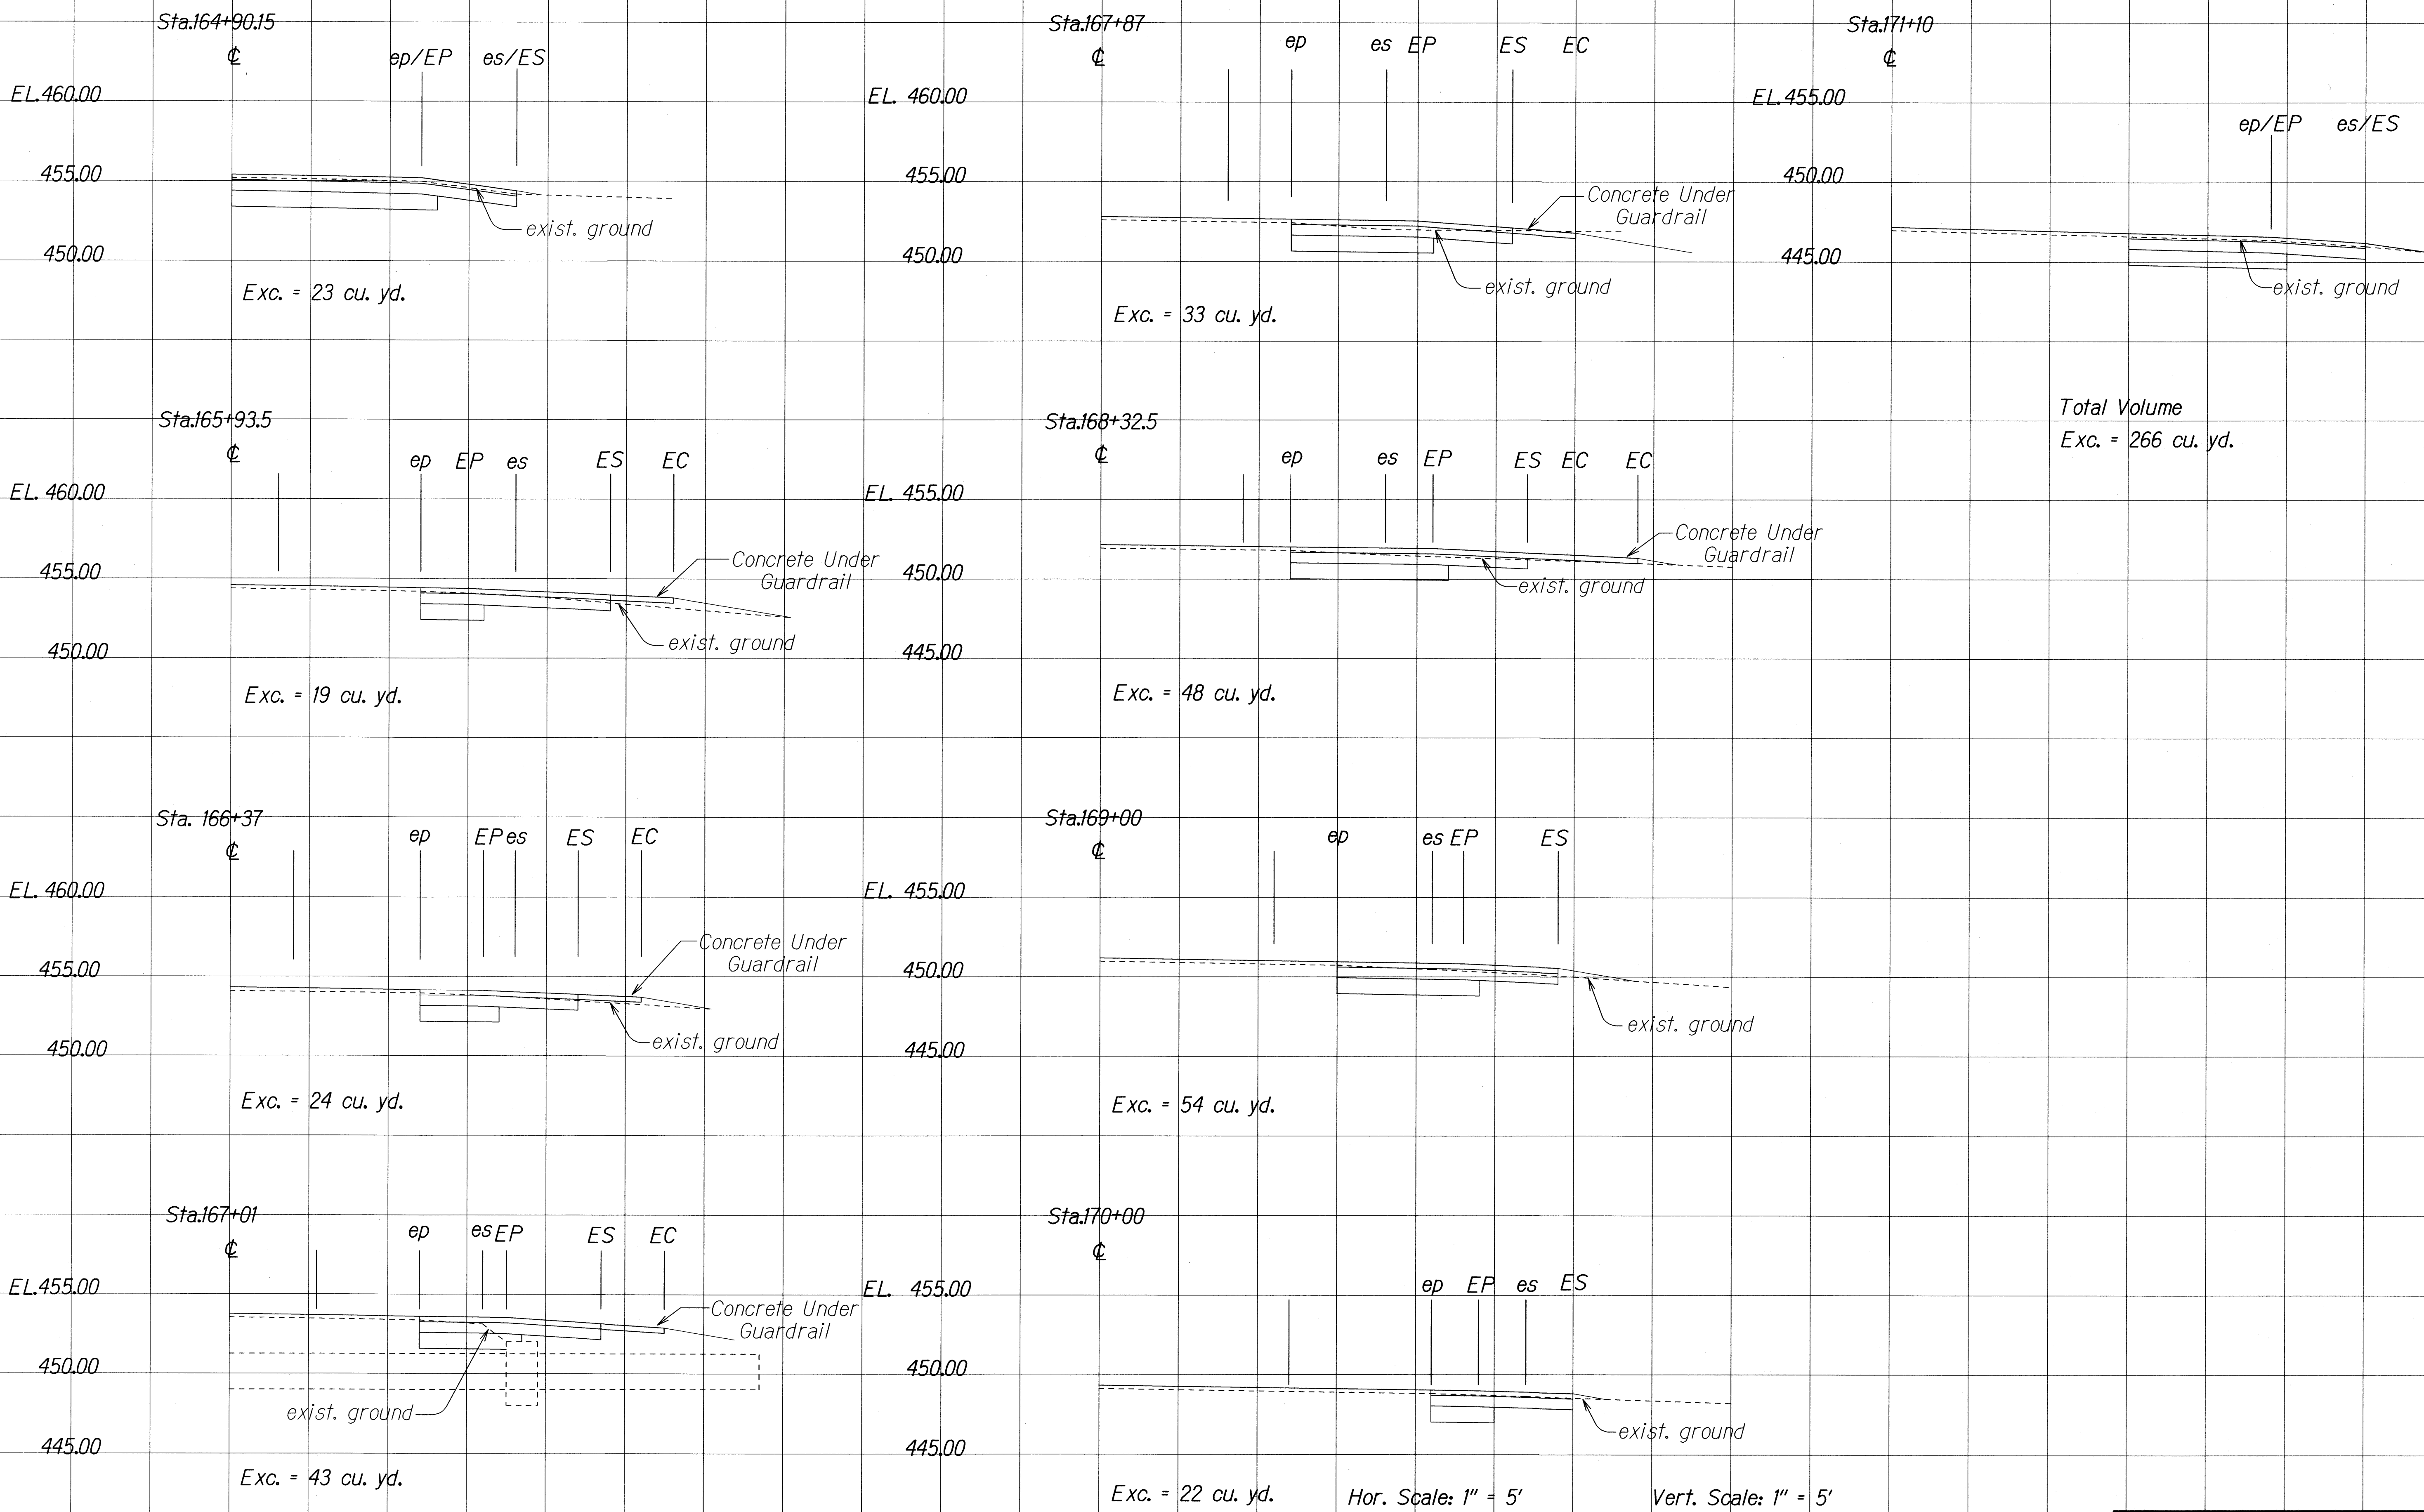

Total Volume
Exc. = 266 cu. yd.

ORIGINAL PLAN	SURVEY PLOTTED BY	DATE
NOTE BOOK	DRAWN BY	4/11
DESIGNED BY	CHECKED BY	
QUANTITIES BY		
BY		

Hor. Scale: 1" = 5' Vert. Scale: 1" = 5'