




FED. ROAD DIST. NO.	STATE	PROJ. NO.	FISCAL YEAR	SHEET NO.	TOTAL SHEETS
HAWAII	HAW.	50D-01-11M	2012	ADD.10	31

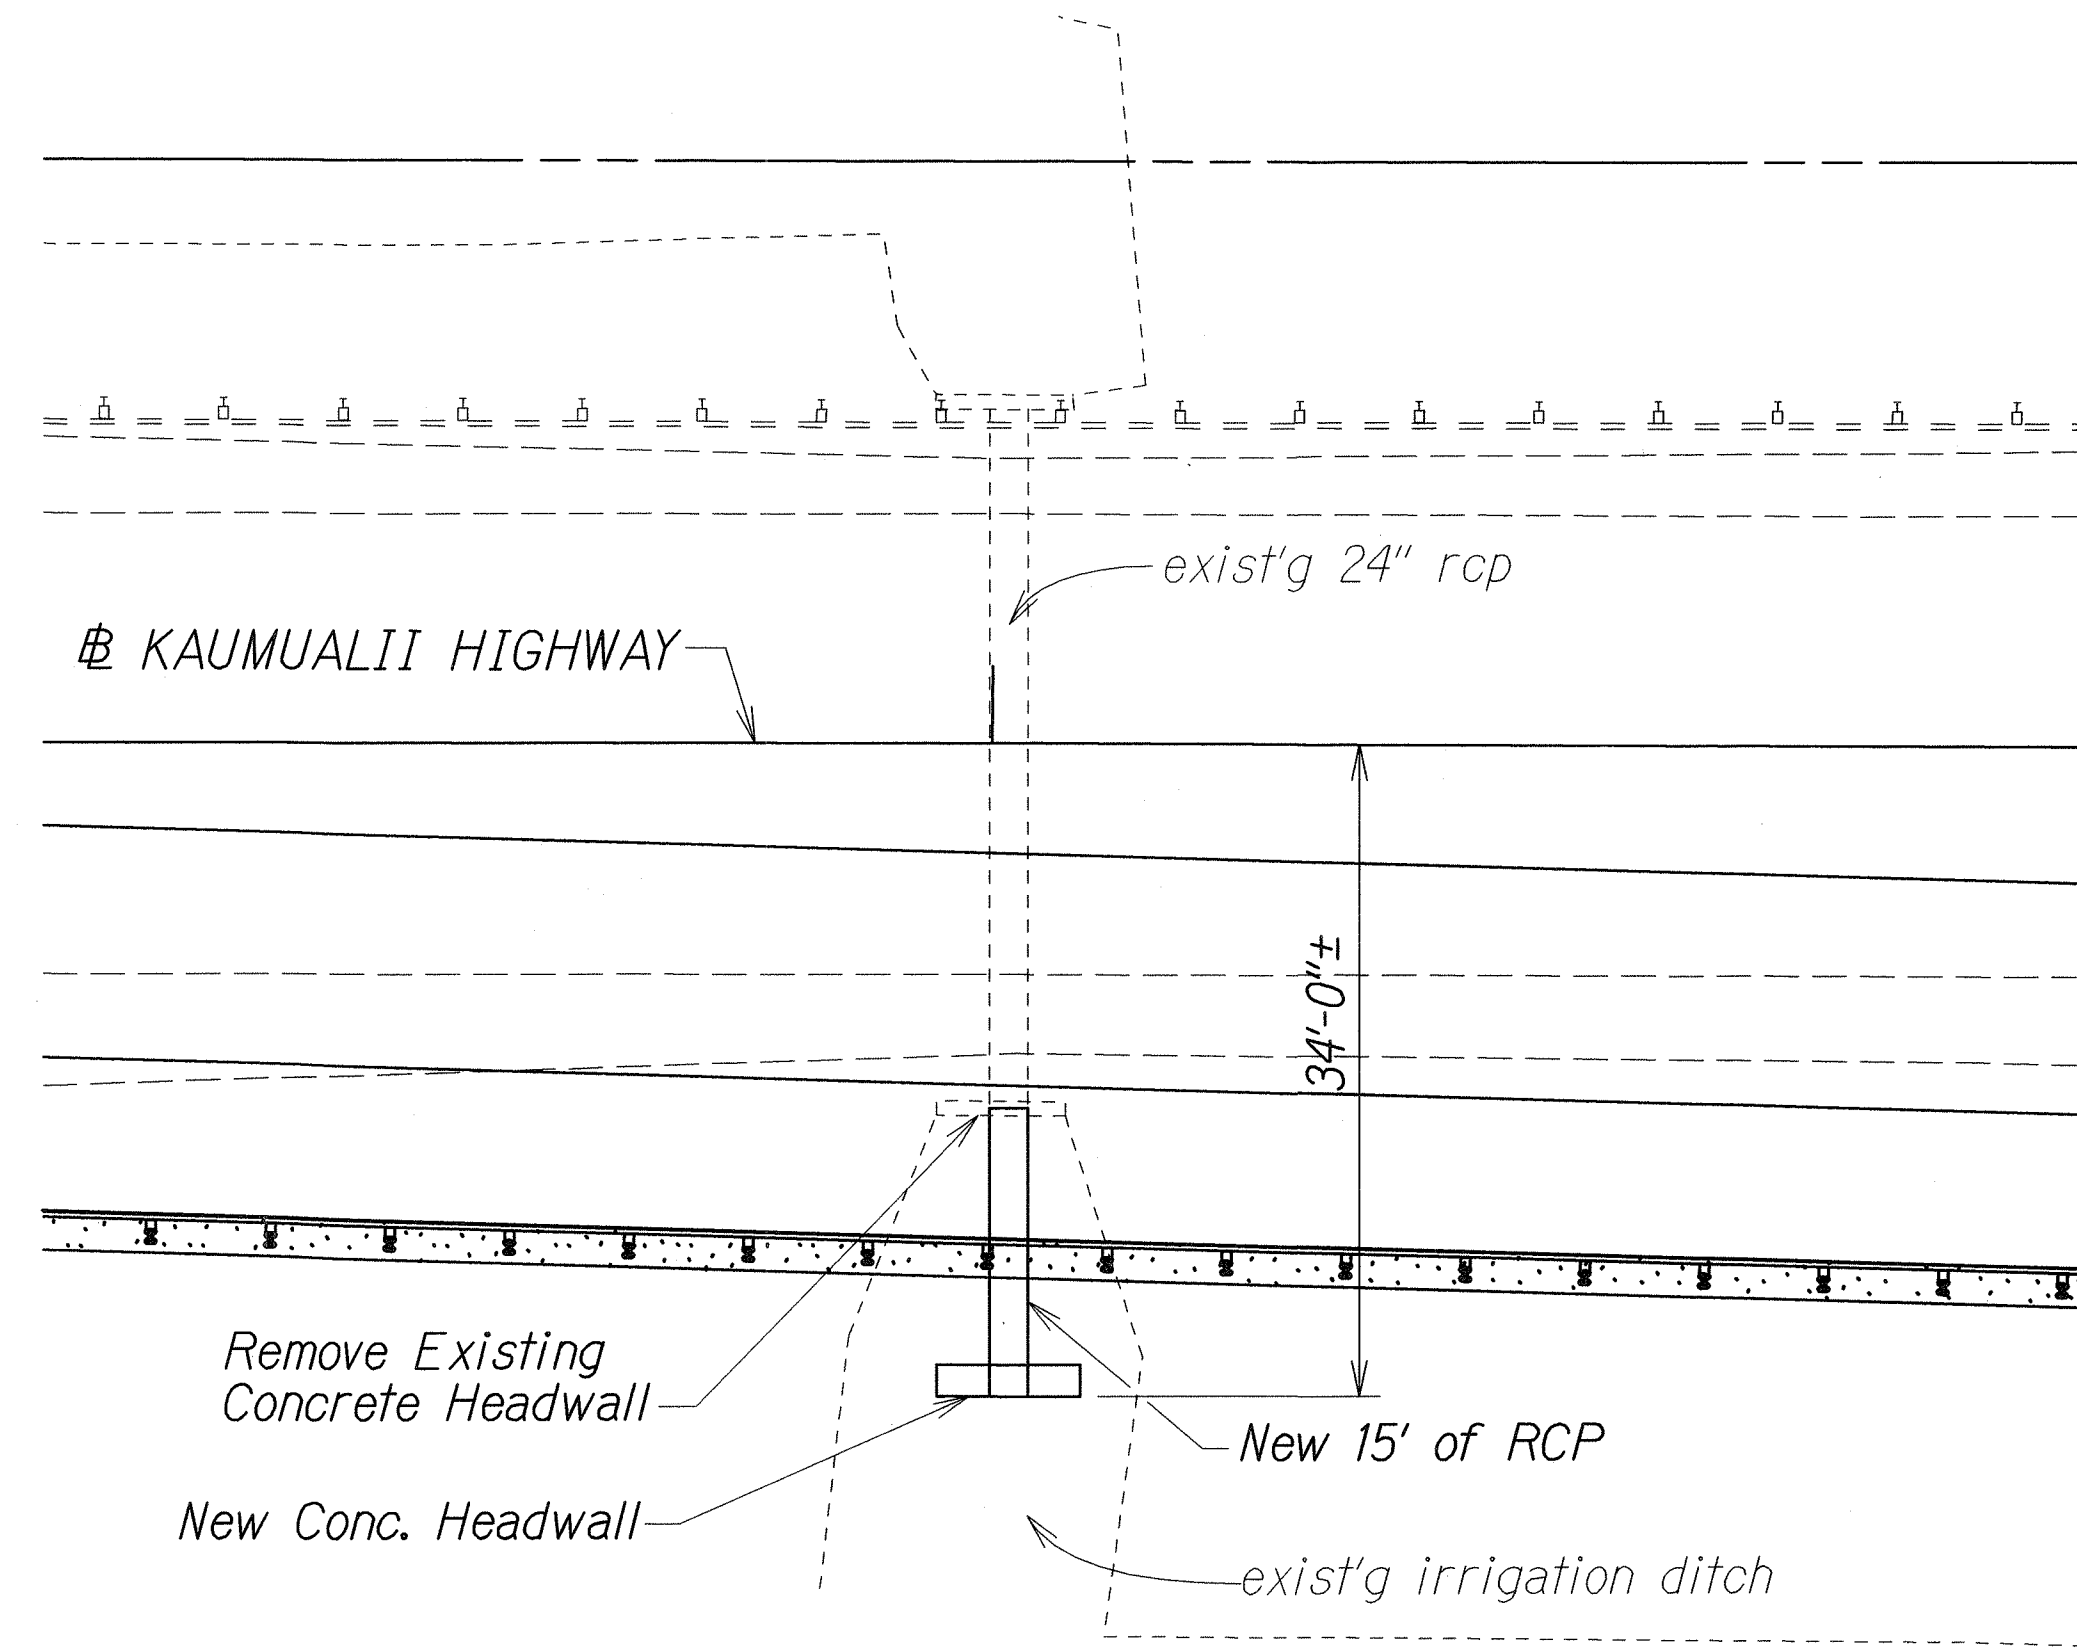


△ CULVERT PLAN AT # STA. 167+00.83±
Scale: 1"=10'

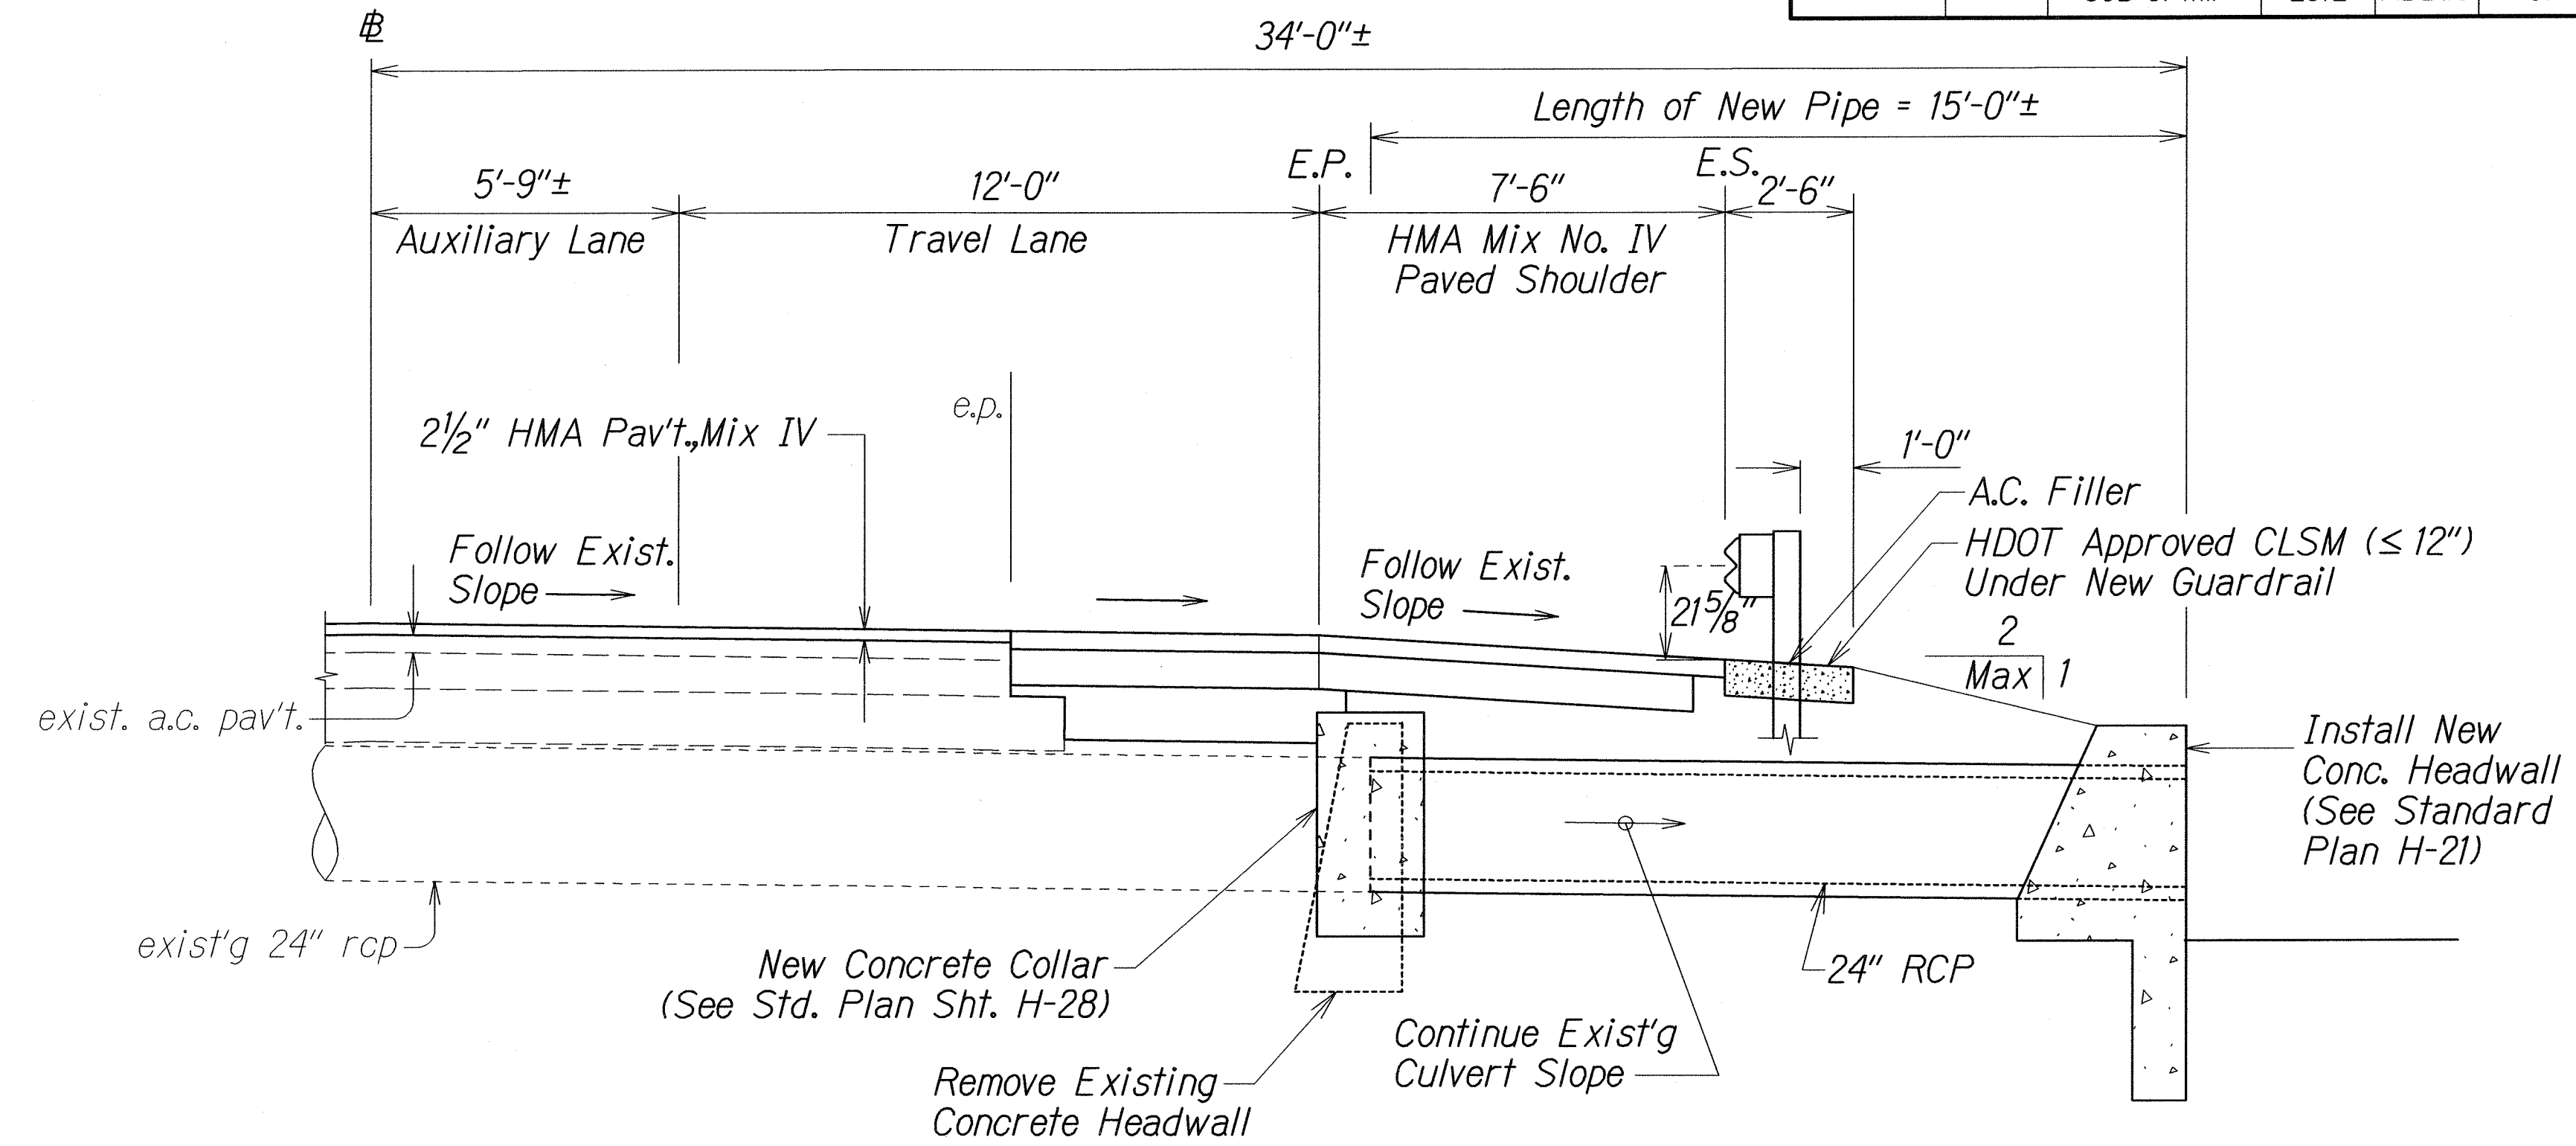

△ CULVERT ELEVATION AT # STA. 167+00.83±
Scale: 3/8"=1'-0'

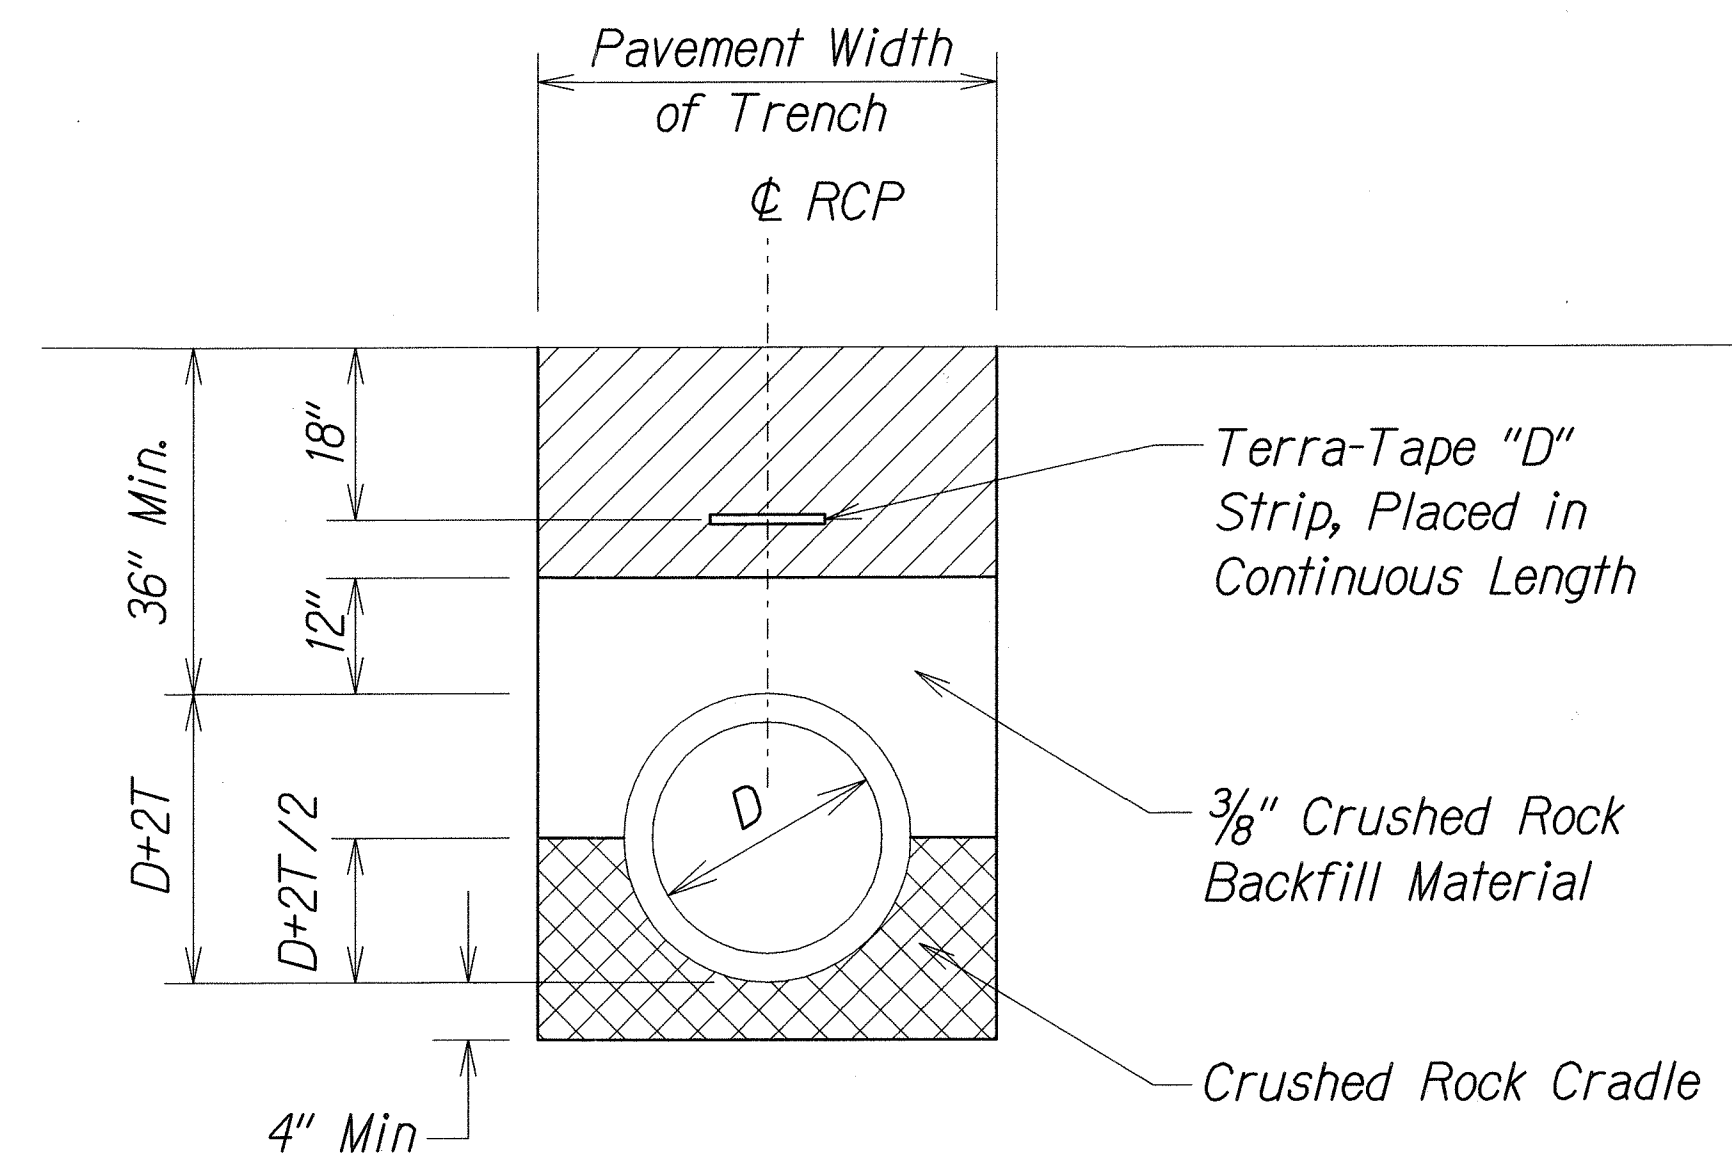

TRENCH RESTORATION - UNPAVED AREA
Not to Scale

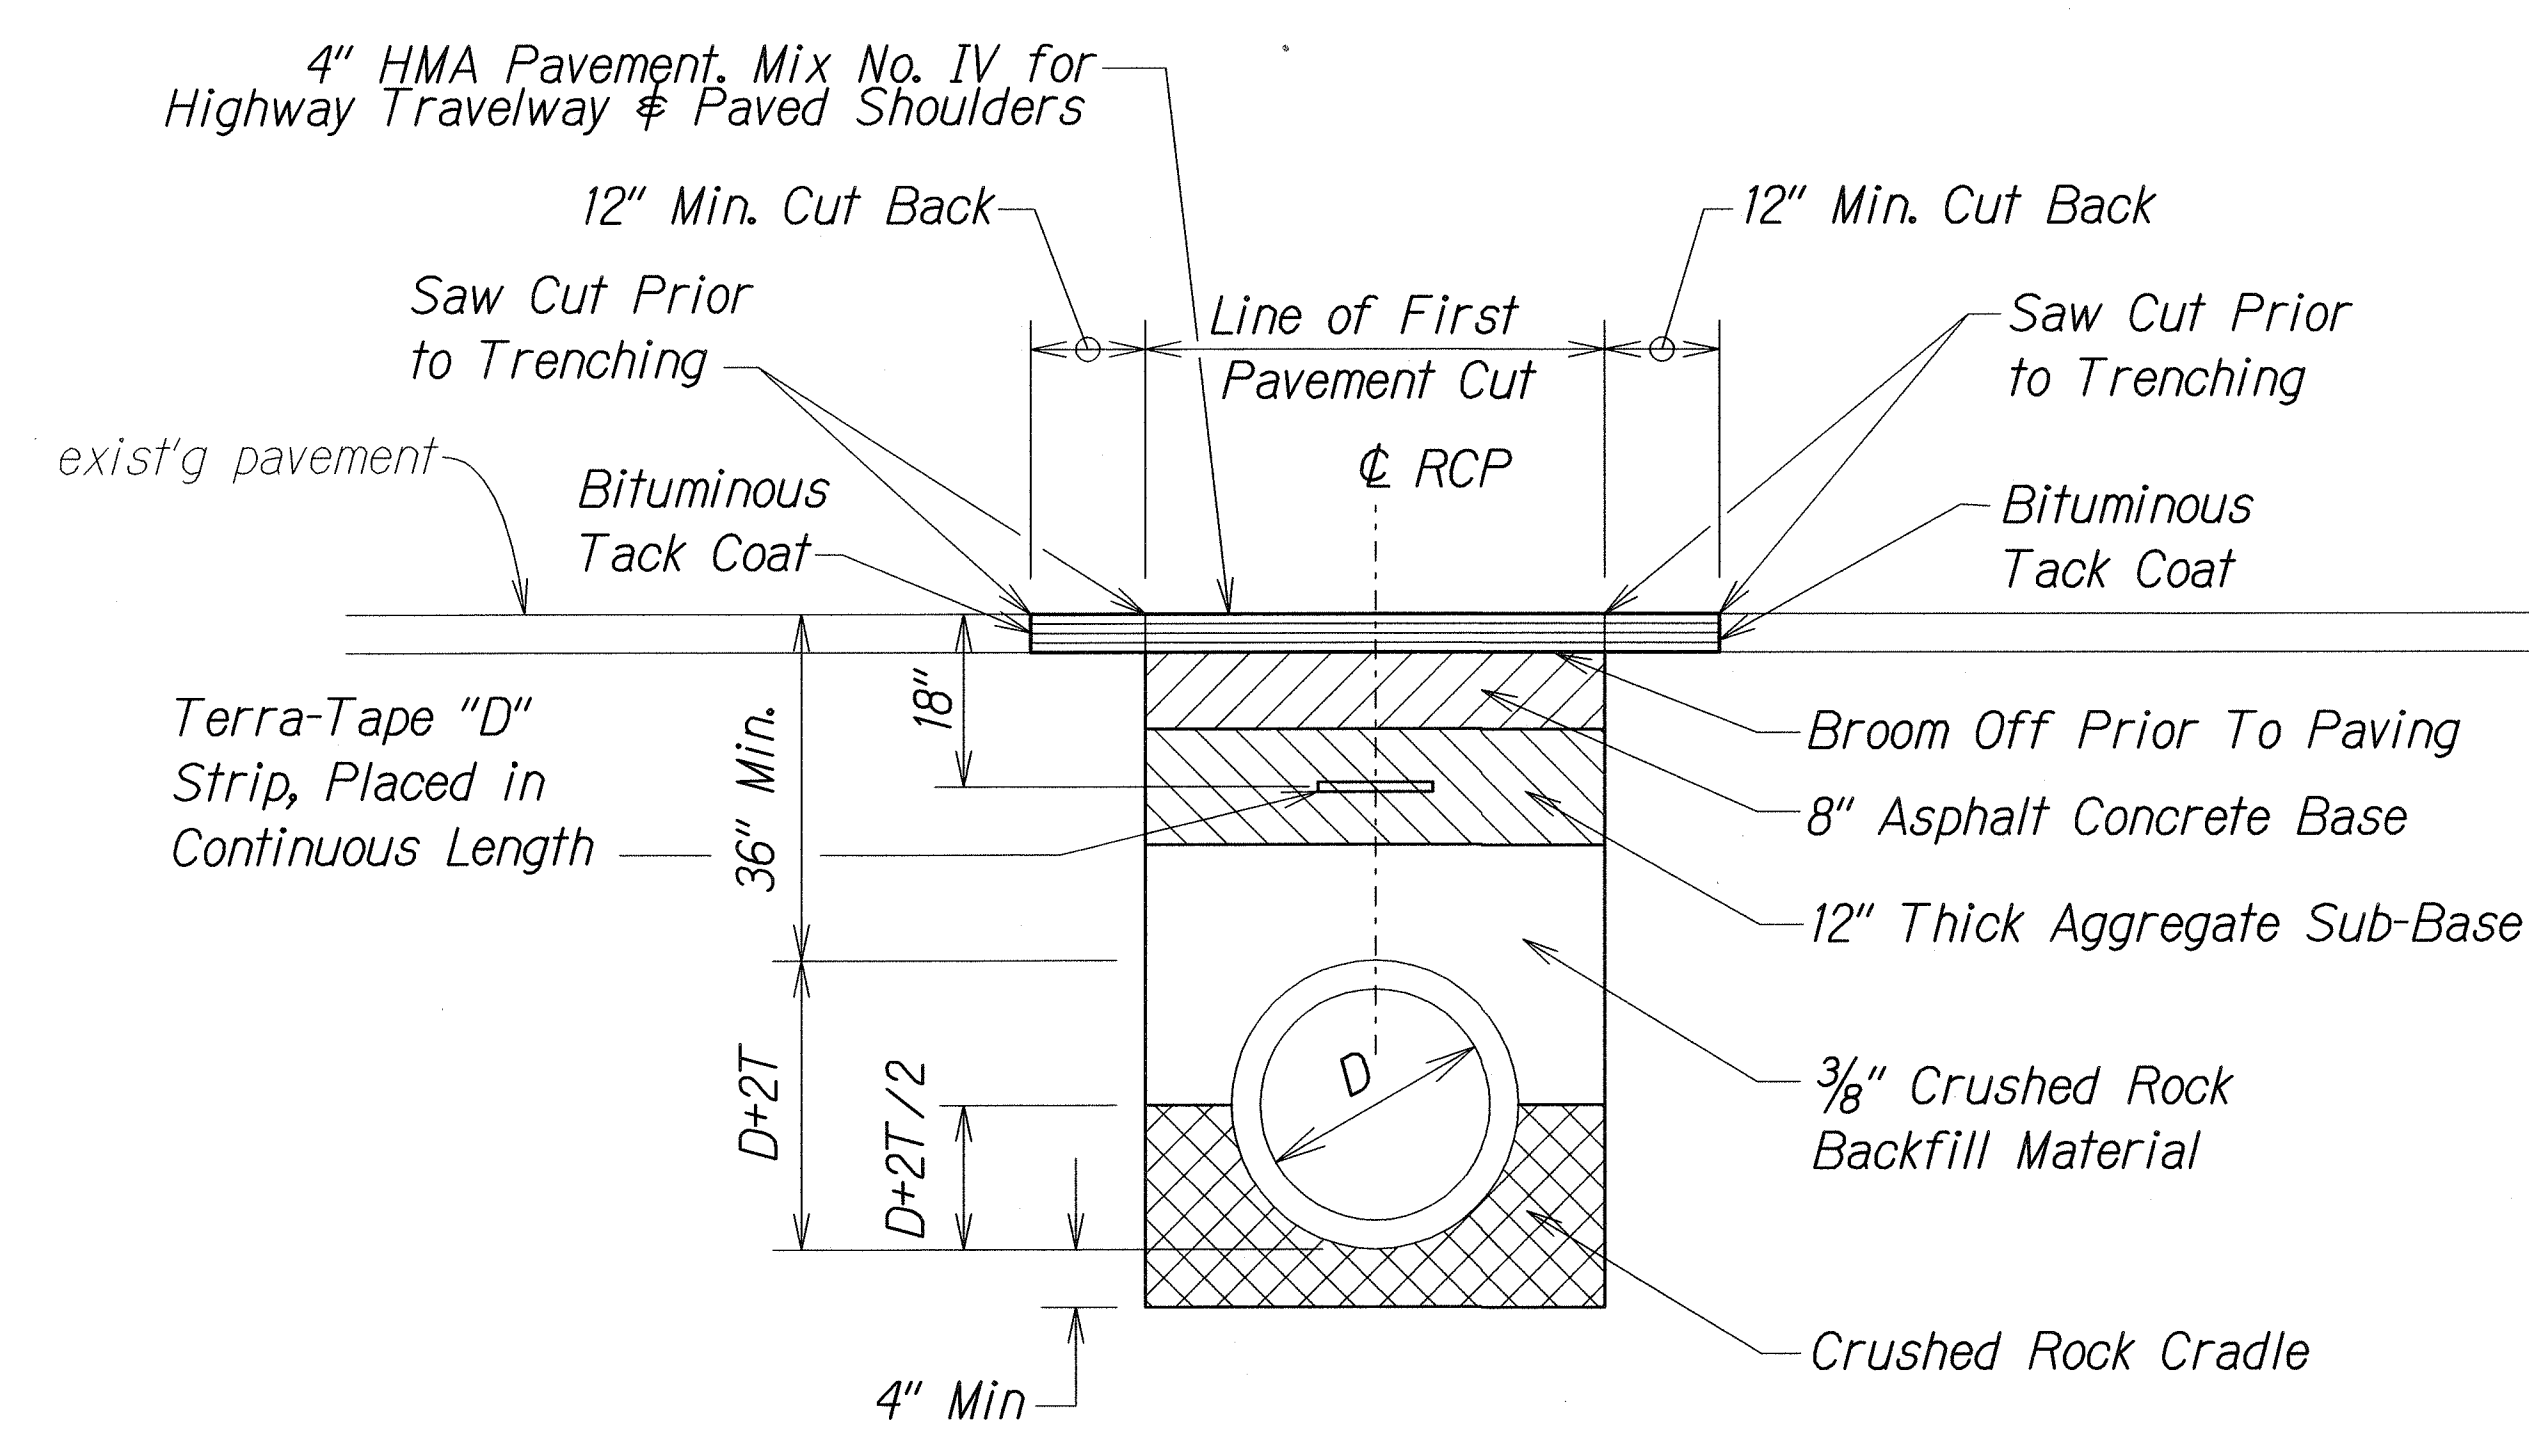

TRENCH RESTORATION - PAVED AREA
Not to Scale

DESIGNED BY	DATE
TRACED BY	
DESIGNED BY	
QUANTITIES BY	
CHECKED BY	
NOTED BY	
BY	

4/11/12	△ Culvert Plan & Elevation at Sta. 167+00.83±
DATE	REVISION
STATE OF HAWAII DEPARTMENT OF TRANSPORTATION HIGHWAYS DIVISION	
CULVERT DETAILS	
KAUMUALII HIGHWAY RESURFACING	
Kipu Road to Huleia Bridge	
Proj. No. 50D-01-11M	
Scale: As Shown	Date: January 2012
SHEET No. 1 OF 1 SHEETS	