

FED. ROAD DIST. NO.	STATE	FEDERAL AID PROJ. NO.	FISCAL YEAR	SHEET NO.	TOTAL SHEETS
HAWAII	HAW.	STP-050-1(038)	2012	ADD. 3	89

GENERAL NOTES

- The scope of work for this project includes removing and disposing of existing pavement markers, striping, and signs; installing new pavement markers, striping, signs, reflector markers, and object markers; and traffic control.
- The Contractor is reminded of the requirements of Subsection 105.16 - Subcontracts.
- The Contractor's attention is directed to the following Sections of the Special Provisions: Subsection 107.06 - Contractor Duty Regarding Public Convenience; Subsection 104.11 - Utilities and Services; and Section 645 -Work Zone Traffic Control.
- At the end of each day's work, the Contractor shall remove all equipment and other obstructions to permit free and safe passage of public traffic.
- The allowable lane closure hours shall be as follows:

1

Maluhia Road (milepost 7.2) to Papalina Road (milepost 11.74)
8:30 pm - 5:30 am, Sunday night through Friday morning


Papalina Road (milepost 11.74) to Mana (milepost 32.93)
8:30 am - 3:00 pm, Monday through Friday

Only one lane of highway shall be closed at any time. Failure of the Contractor to open all lanes of traffic beyond the allowable lane closure hours specified above shall result in assessment of liquidated damages as specified in Section 108.09 of the Special Provisions.

- The Contractor shall notify the Engineer in writing, two (2) weeks prior to starting pavement marking and striping operations.
- The Contractor shall remove and dispose of all existing pavement markings in accordance with Subsection 629.03(D) of the Standard Specifications.
- Any work specified in the contract but not listed separately in the proposal schedule shall be considered incidental to other various contract items and shall not be paid for separately.
- No material and/or equipment shall be stockpiled or otherwise stored within the highway right-of-way except at locations designated in writing and approved by the Engineer. If use of location is approved by the Engineer, the Contractor shall obtain a permit to use the property within the highway right-of-way from the State Highways at Tel. No. 241-3000.
- Object Markers (OM-II) installed on construction warning signs shall not be paid for separately but shall be considered incidental to contract Item No. 645.0100 - Traffic Control.

LEGEND

- Existing Electrical Line
- Existing Electric Manhole
- Existing Telephone Line
- Existing Telephone Pole
- Existing Telephone Manhole
- Existing Signal Corps Line
- Existing TV Cable
- Existing 12" Water Line
- Existing Water Manhole
- Existing Water Valve Box
- Existing Water Meter
- Existing Fire Hydrant
- Existing Sewer Line
- Existing Sewer Manhole
- Existing 6" Gas Line
- Existing Gas Valve Box
- Existing Gas Manhole
- Existing Monument
- Existing 24" Drain Line
- Existing Storm Drain Manhole
- Existing Grated Drop Inlet
- Existing Catch Basin
- Existing Traffic Sign
- Existing Highway Lighting Standard
- Existing Highway Lighting Pullbox
- Existing Traffic Signal Pole
- Existing Traffic Signal Pullbox
- Existing Metal Guardrail

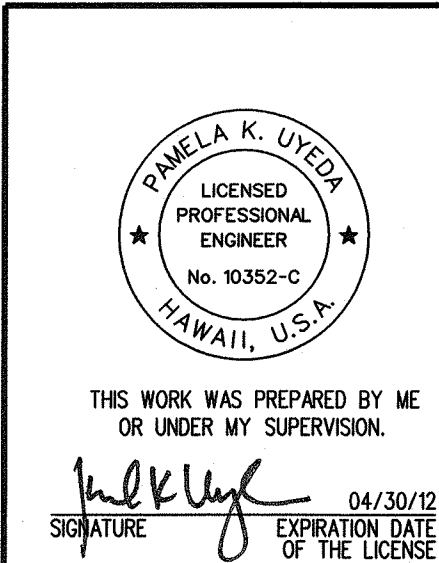

6/15/11	Revised General Note 5.
Date	Revision

STATE OF HAWAII
DEPARTMENT OF TRANSPORTATION
HIGHWAYS DIVISION

GENERAL NOTES AND LEGEND

KAUMUALII HIGHWAY PAVEMENT MARKINGS AND SIGNAGE
Mana to the Vicinity of Maluhia Road
Federal Aid Project No. STP-050-1(038)
Scale: None Date: May 13, 2011