



INDEX TO DRAWINGS	
SHEET NO.	DESCRIPTION
1	TITLE SHEET
2	STANDARD PLAN SUMMARY SHEET
3	GENERAL NOTES & LEGEND
4 - 6	WATER POLLUTION AND EROSION CONTROL NOTES AND DETAILS
7	SIGNING & PAVEMENT MARKING NOTES
8 - 83	SIGNING & PAVEMENT MARKING PLANS ① ②
84 - 85	SIGN DETAILS
86 - 89	TRAFFIC CONTROL NOTES & PLANS

Sheet Nos. ① 218-1 and ② 228-2 are Supplementary Sheets to this project. Total sheet count after "AS-BUILT" posting 21 sheets.

FED. ROAD DIST. NO.	STATE	FEDERAL AID PROJ. NO.	FISCAL YEAR	SHEET NO.	TOTAL SHEETS
HAWAII	HAW.	STP-050-1(038)	2012	1	89

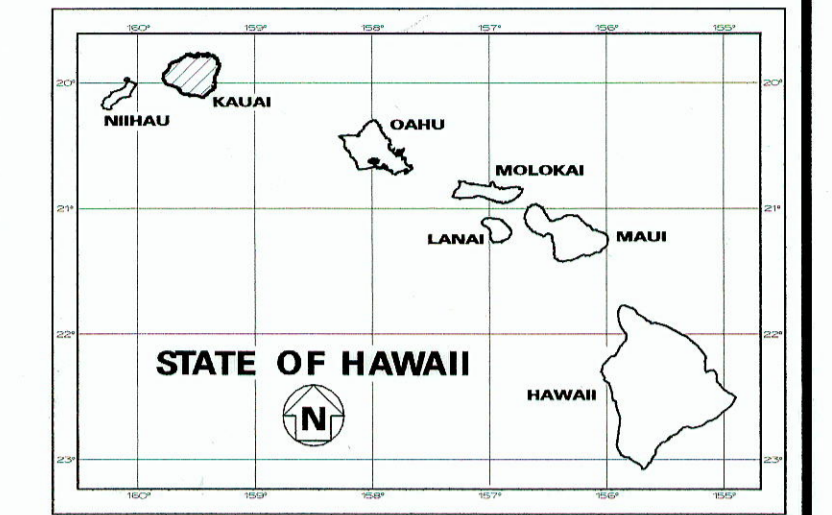

STATE OF HAWAII  
 DEPARTMENT OF TRANSPORTATION  
 HIGHWAYS DIVISION  
 HONOLULU, HAWAII  
**"AS-BUILT"**  
 PLANS FOR  
**KAUMUALII HIGHWAY**  
**PAVEMENT MARKINGS AND SIGNAGE**  
**MANA TO THE VICINITY OF MALUHIA ROAD**  
 FEDERAL-AID PROJECT NO. STP-050-1(038)  
 DISTRICTS OF KOLOA AND WAIMEA  
 ISLAND OF KAUAI

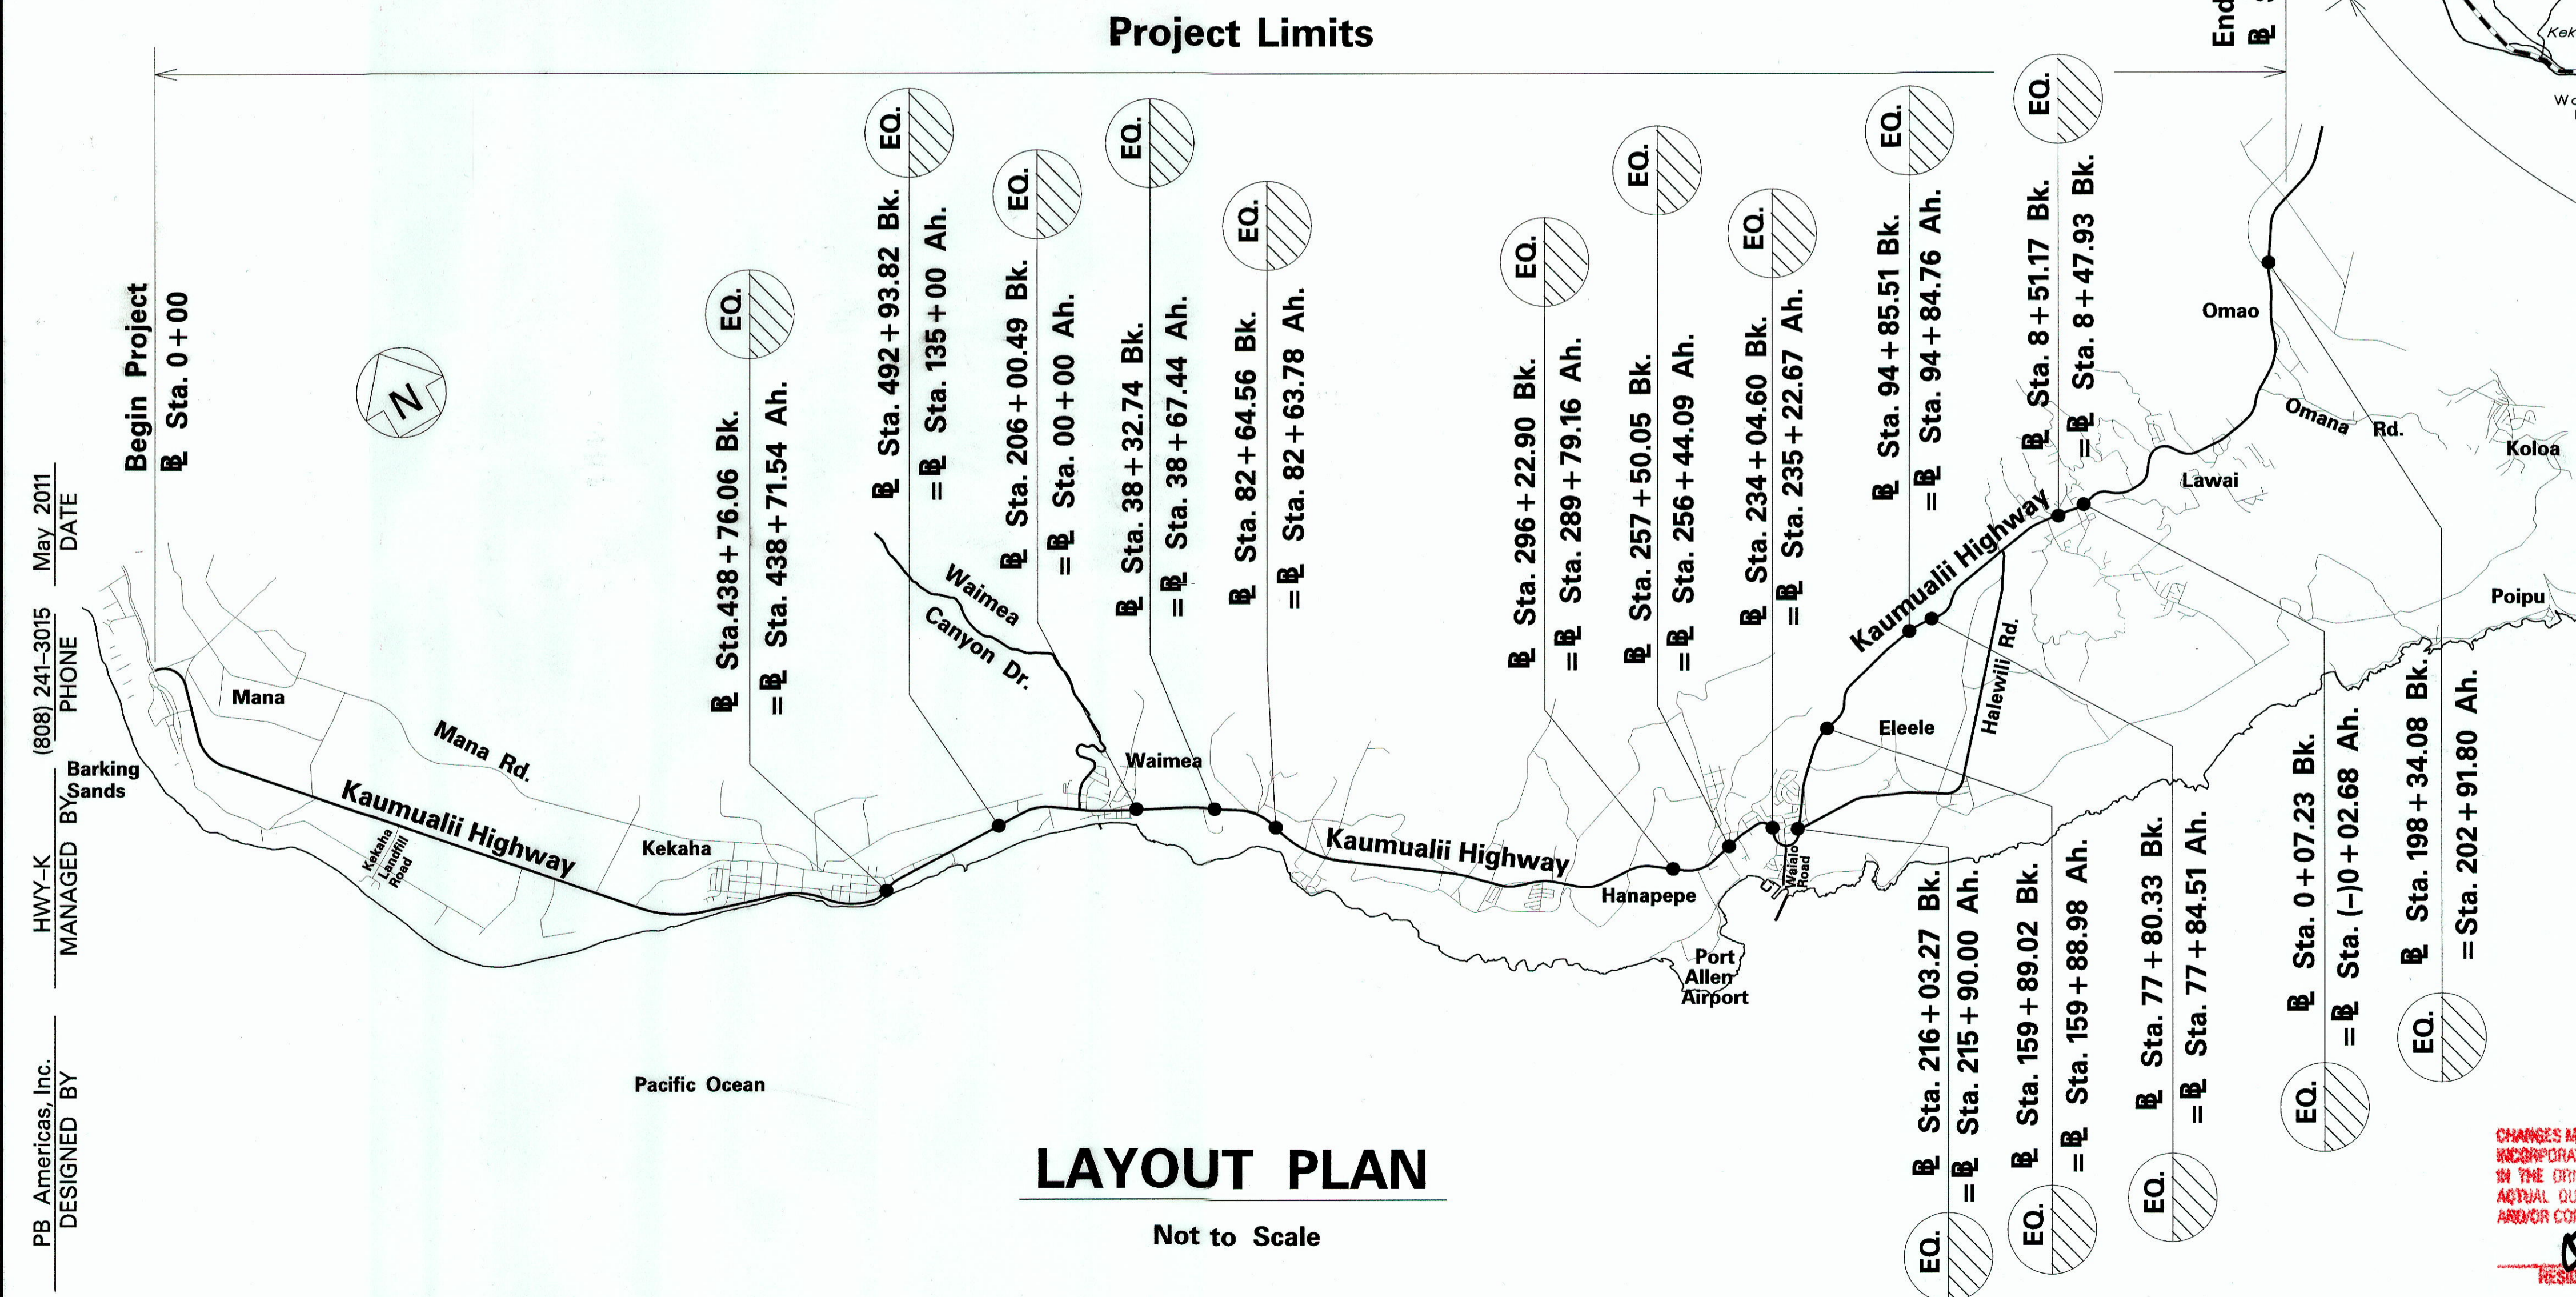

ORIGINAL PLAN	SURVEY PLOTTED BY	DATE
TRACED BY	DRAWN BY	
NOTE BOOK	DESIGNED BY	
	CHECKED BY	

PB Americas, Inc. DESIGNED BY  
 HWY-K MANAGED BY  
 (808) 241-3015 PHONE  
 May 2011 DATE

**LAYOUT PLAN**

Not to Scale



--- FEDERAL AID PROJECTS PREVIOUSLY CONSTRUCTED OR UNDER CONSTRUCTION  
 MILE POST 7.21 TO MILE POST 32.93

**DESIGN DESIGNATION**

ADT (2009)	17,869
ADT (2034)	26,709
DHV	1523
D	49/51
T	2.8 %
V	35 M.P.H.

CHANGES MADE DURING CONSTRUCTION HAVE BEEN INCORPORATED ON THESE PLANS EXCEPT CHANGES IN THE ORIGINAL THEORETICAL QUANTITIES. FOR ACTUAL QUANTITIES, REFER TO PROJECT LEDGER AND/OR COMPUTATION BOOK.

DEPARTMENT OF TRANSPORTATION  
 STATE OF HAWAII  
 APPROVED:   
 DIR. OF TRANSPORTATION  
 DATE: 7-18-18