


| FED. ROAD DIST. NO. | STATE | FED. AID PROJ. NO. | FISCAL YEAR | SHEET NO. | TOTAL SHEETS |
|---------------------|-------|--------------------|-------------|-----------|--------------|
| HAWAII              | HAW.  | STP-050-1(15)      | 1995        | 23        | 36           |

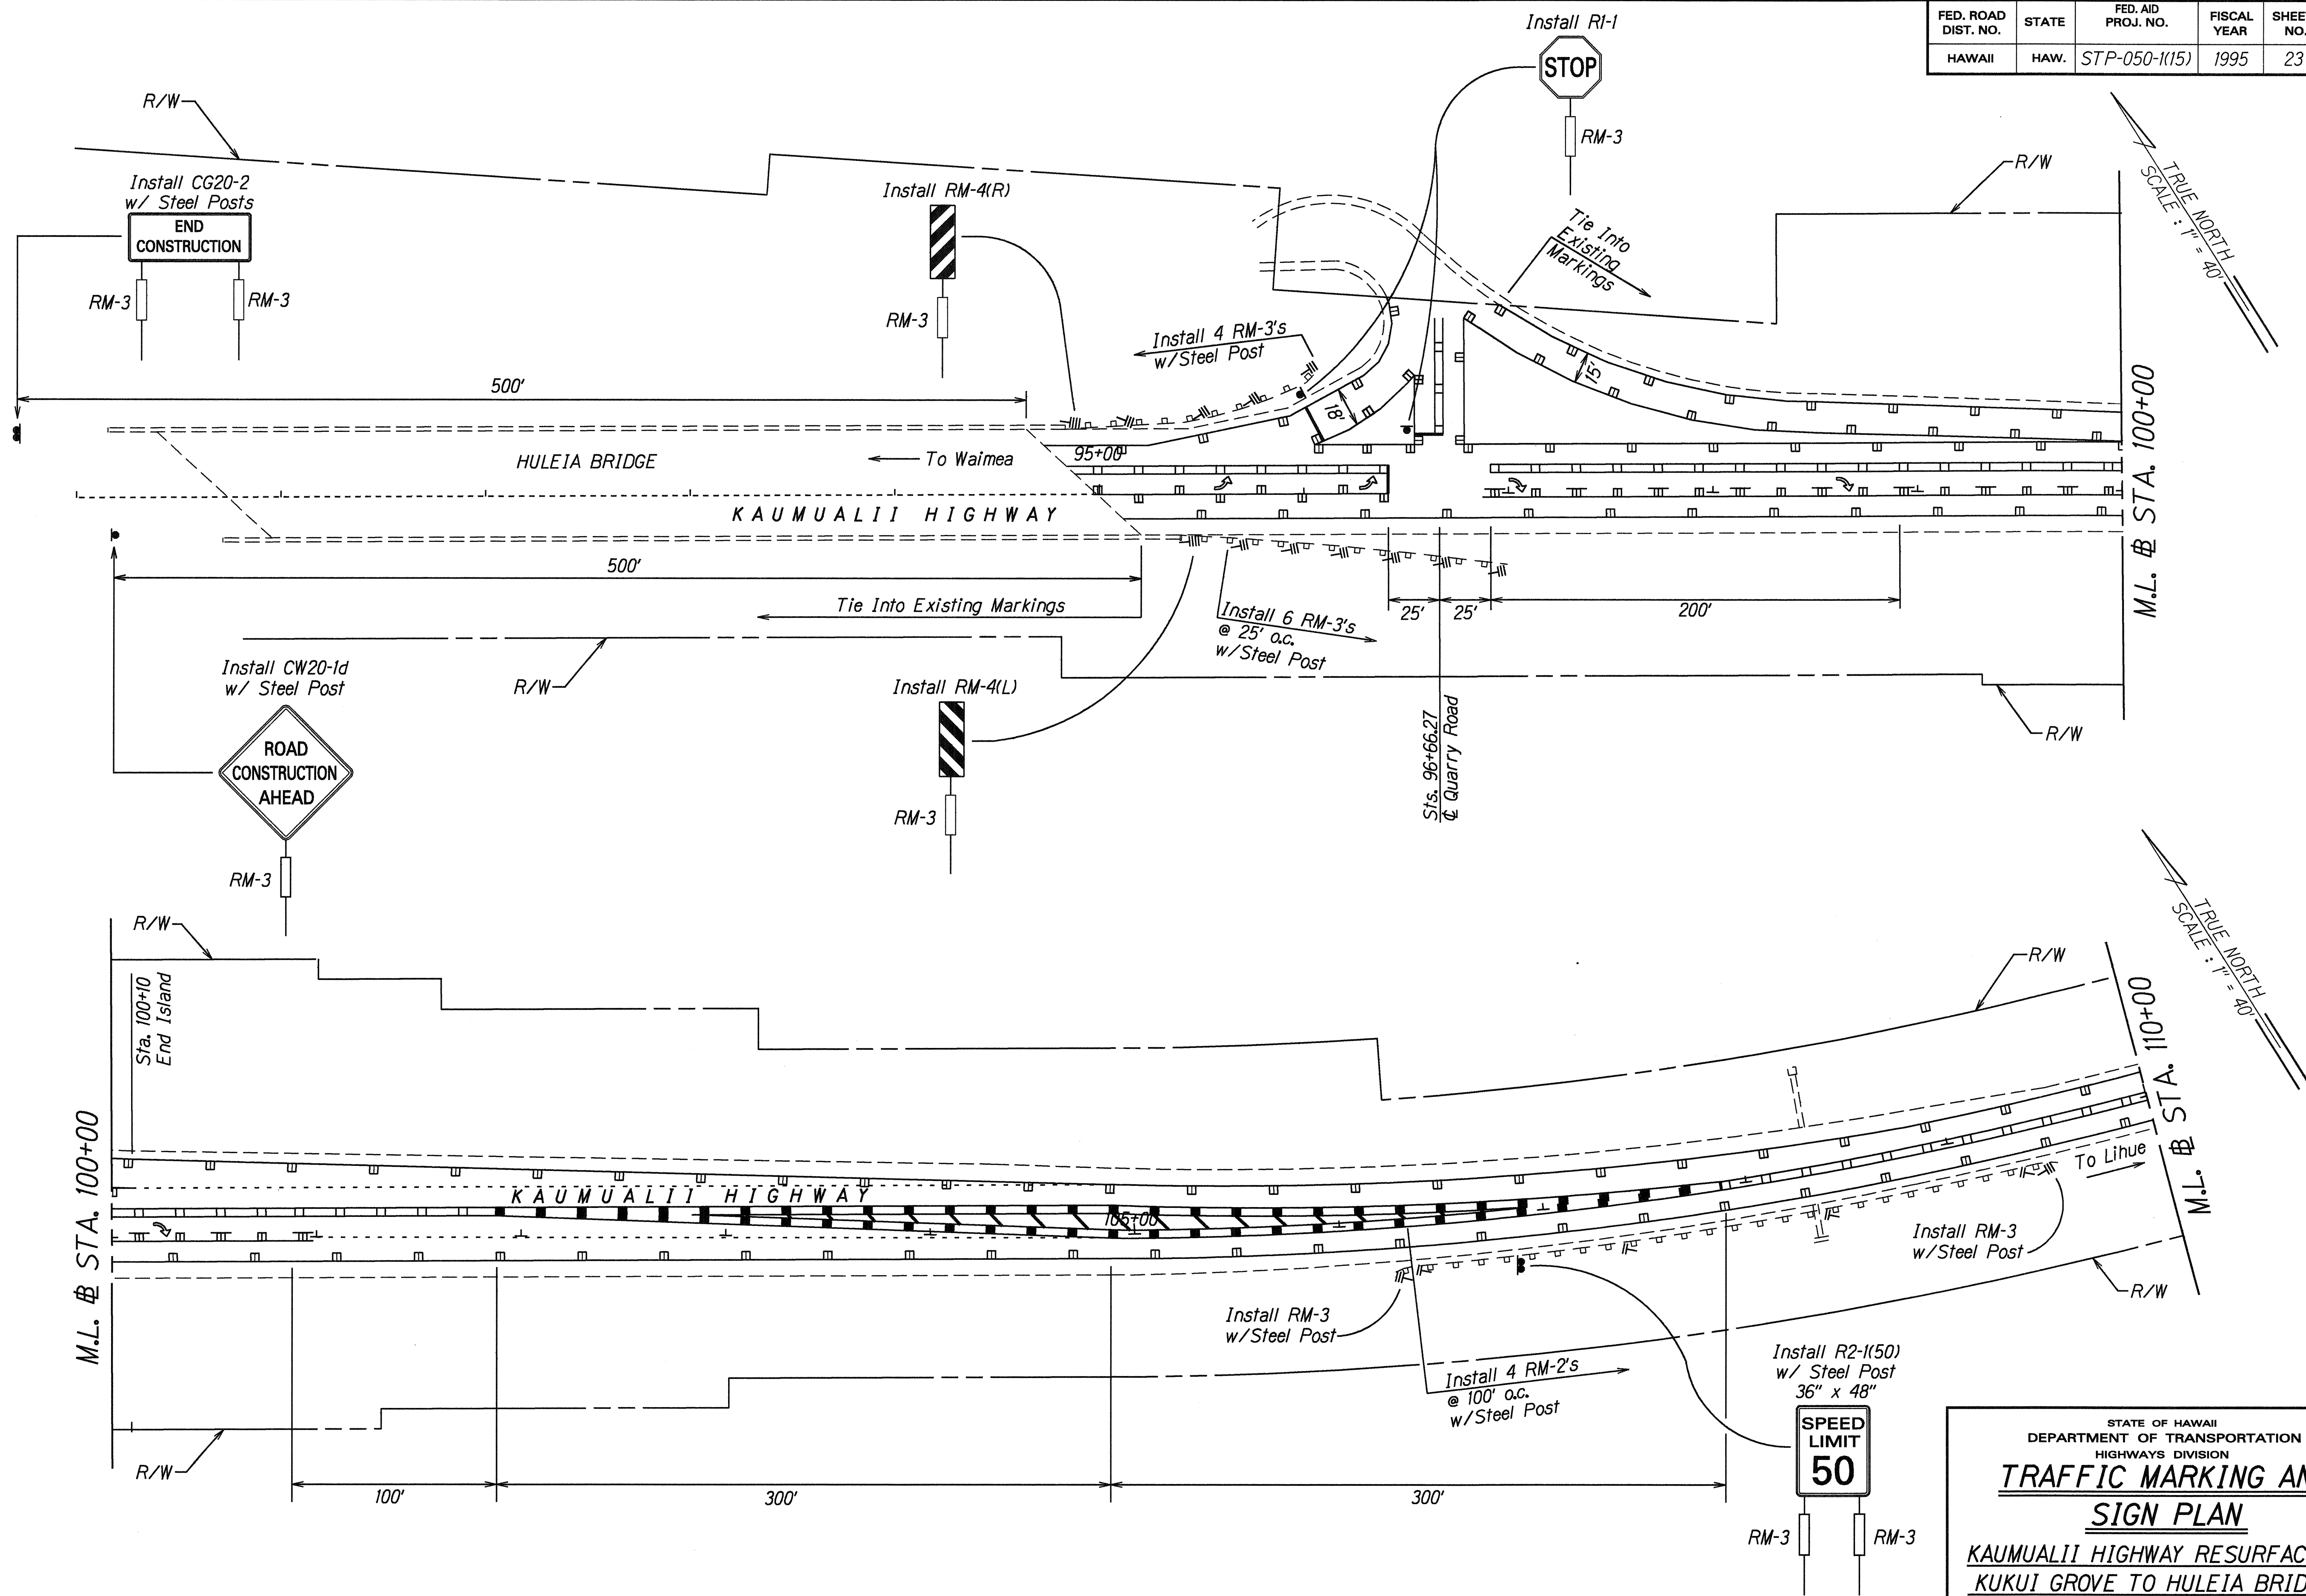

|               |                   |         |
|---------------|-------------------|---------|
| ORIGINAL PLAN | SURVEY PLOTTED BY | DATE    |
| NOTE BOOK     | DRAWN BY          | 5/19/95 |
| del. grace    | TRACED BY         |         |
| 4/10/1995     | CHECKED BY        |         |

STATE OF HAWAII  
DEPARTMENT OF TRANSPORTATION  
HIGHWAYS DIVISION

**TRAFFIC MARKING AND  
SIGN PLAN**


**KAUMUALII HIGHWAY RESURFACING  
KUKUL GROVE TO HULEIA BRIDGE**  
Fed. Aid Proj. No. STP-050-1(15)

Scale: 1" = 40' Date: Apr, 1995

SHEET No. 1 OF 11 SHEETS



| FED. ROAD DIST. NO. | STATE | FED. AID PROJ. NO. | FISCAL YEAR | SHEET NO. | TOTAL SHEETS |
|---------------------|-------|--------------------|-------------|-----------|--------------|
| HAWAII              | HAW.  | STP-050-1(15)      | 1995        | 24        | 36           |

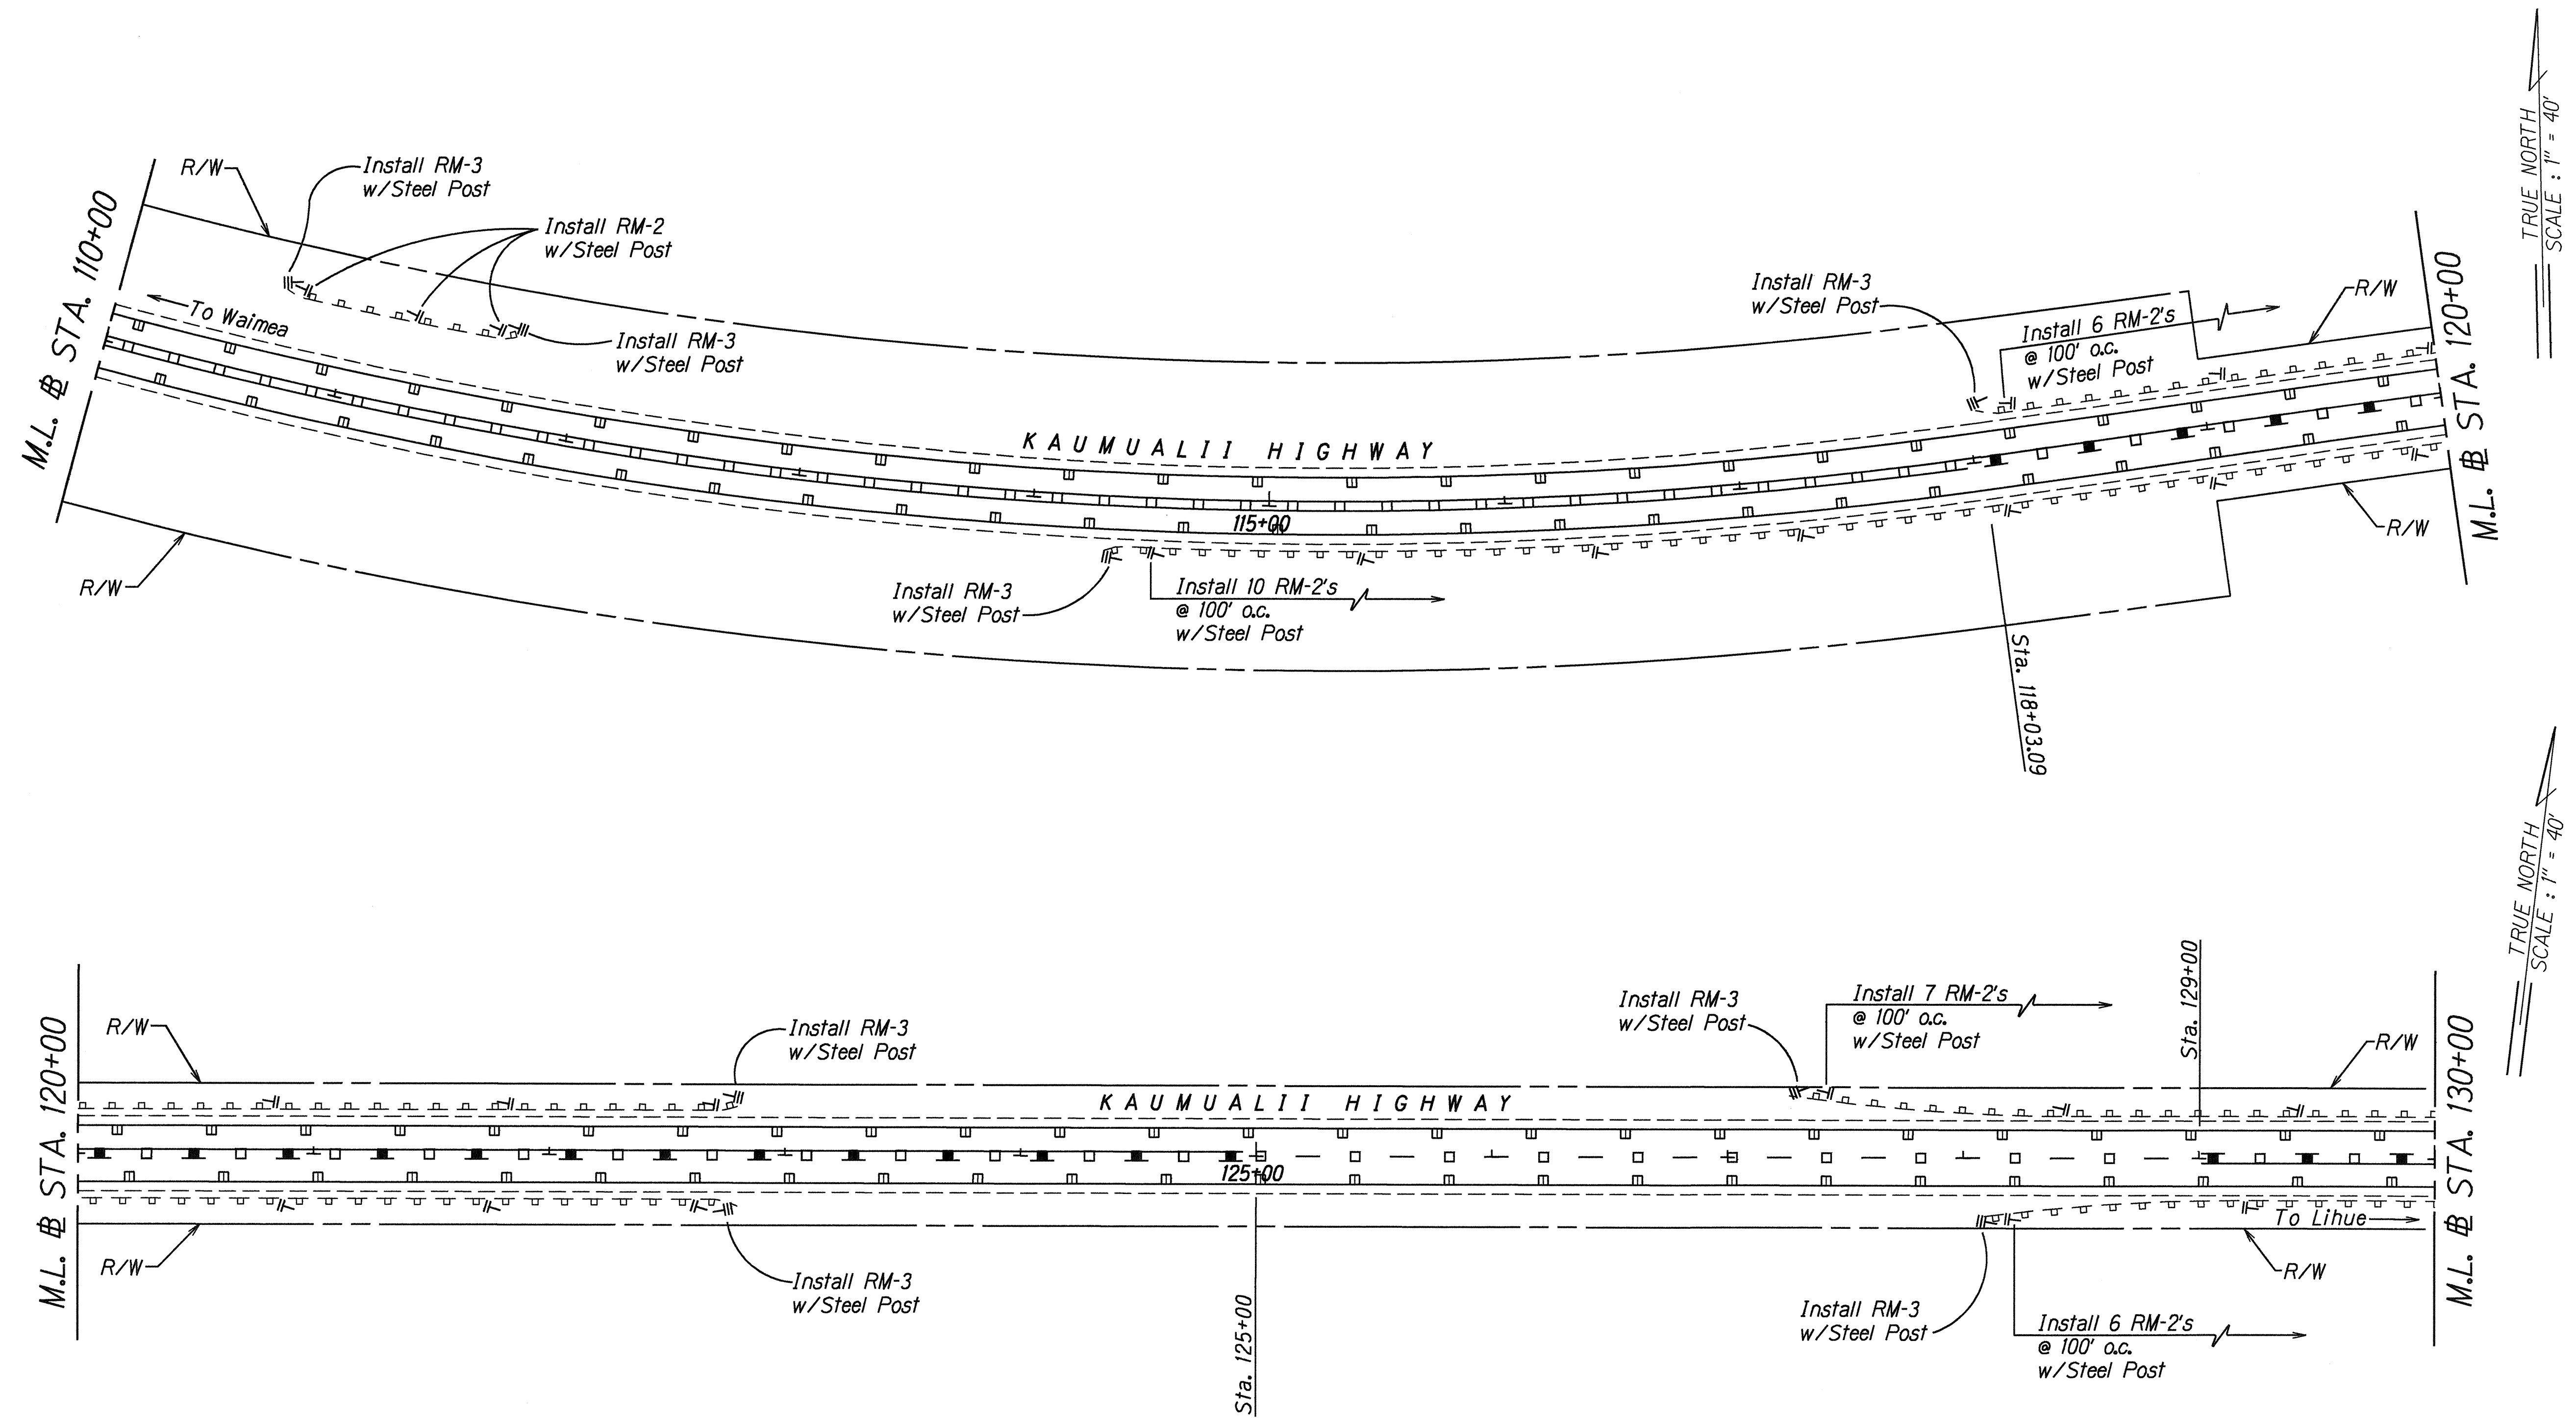

TRUE NORTH  
SCALE: 1" = 40'

TRUE NORTH  
SCALE: 1" = 40'

|                |                   |         |
|----------------|-------------------|---------|
| ORIGINAL PLAN  | SURVEY PLOTTED BY | DATE    |
| PLAN           | DRAWN BY          | 5/13/95 |
| NOTE BOOK      | TRACED BY         |         |
| ddi grace      | CHECKED BY        |         |
| N. Y. M. P. 02 |                   |         |

STATE OF HAWAII  
DEPARTMENT OF TRANSPORTATION  
HIGHWAYS DIVISION

**TRAFFIC MARKING AND  
SIGN PLAN**

**KAUMUALII HIGHWAY RESURFACING  
KUKUI GROVE TO HULEIA BRIDGE  
Fed. Aid Proj. No. STP-050-1(15)**

Scale: 1" = 40' Date: Apr, 1995


SHEET No. 2 OF 11 SHEETS







| FED. ROAD DIST. NO. | STATE | FED. AID PROJ. NO. | FISCAL YEAR | SHEET NO. | TOTAL SHEETS |
|---------------------|-------|--------------------|-------------|-----------|--------------|
| HAWAII              | HAW.  | STP-050-1(15)      | 1995        | 26        | 36           |

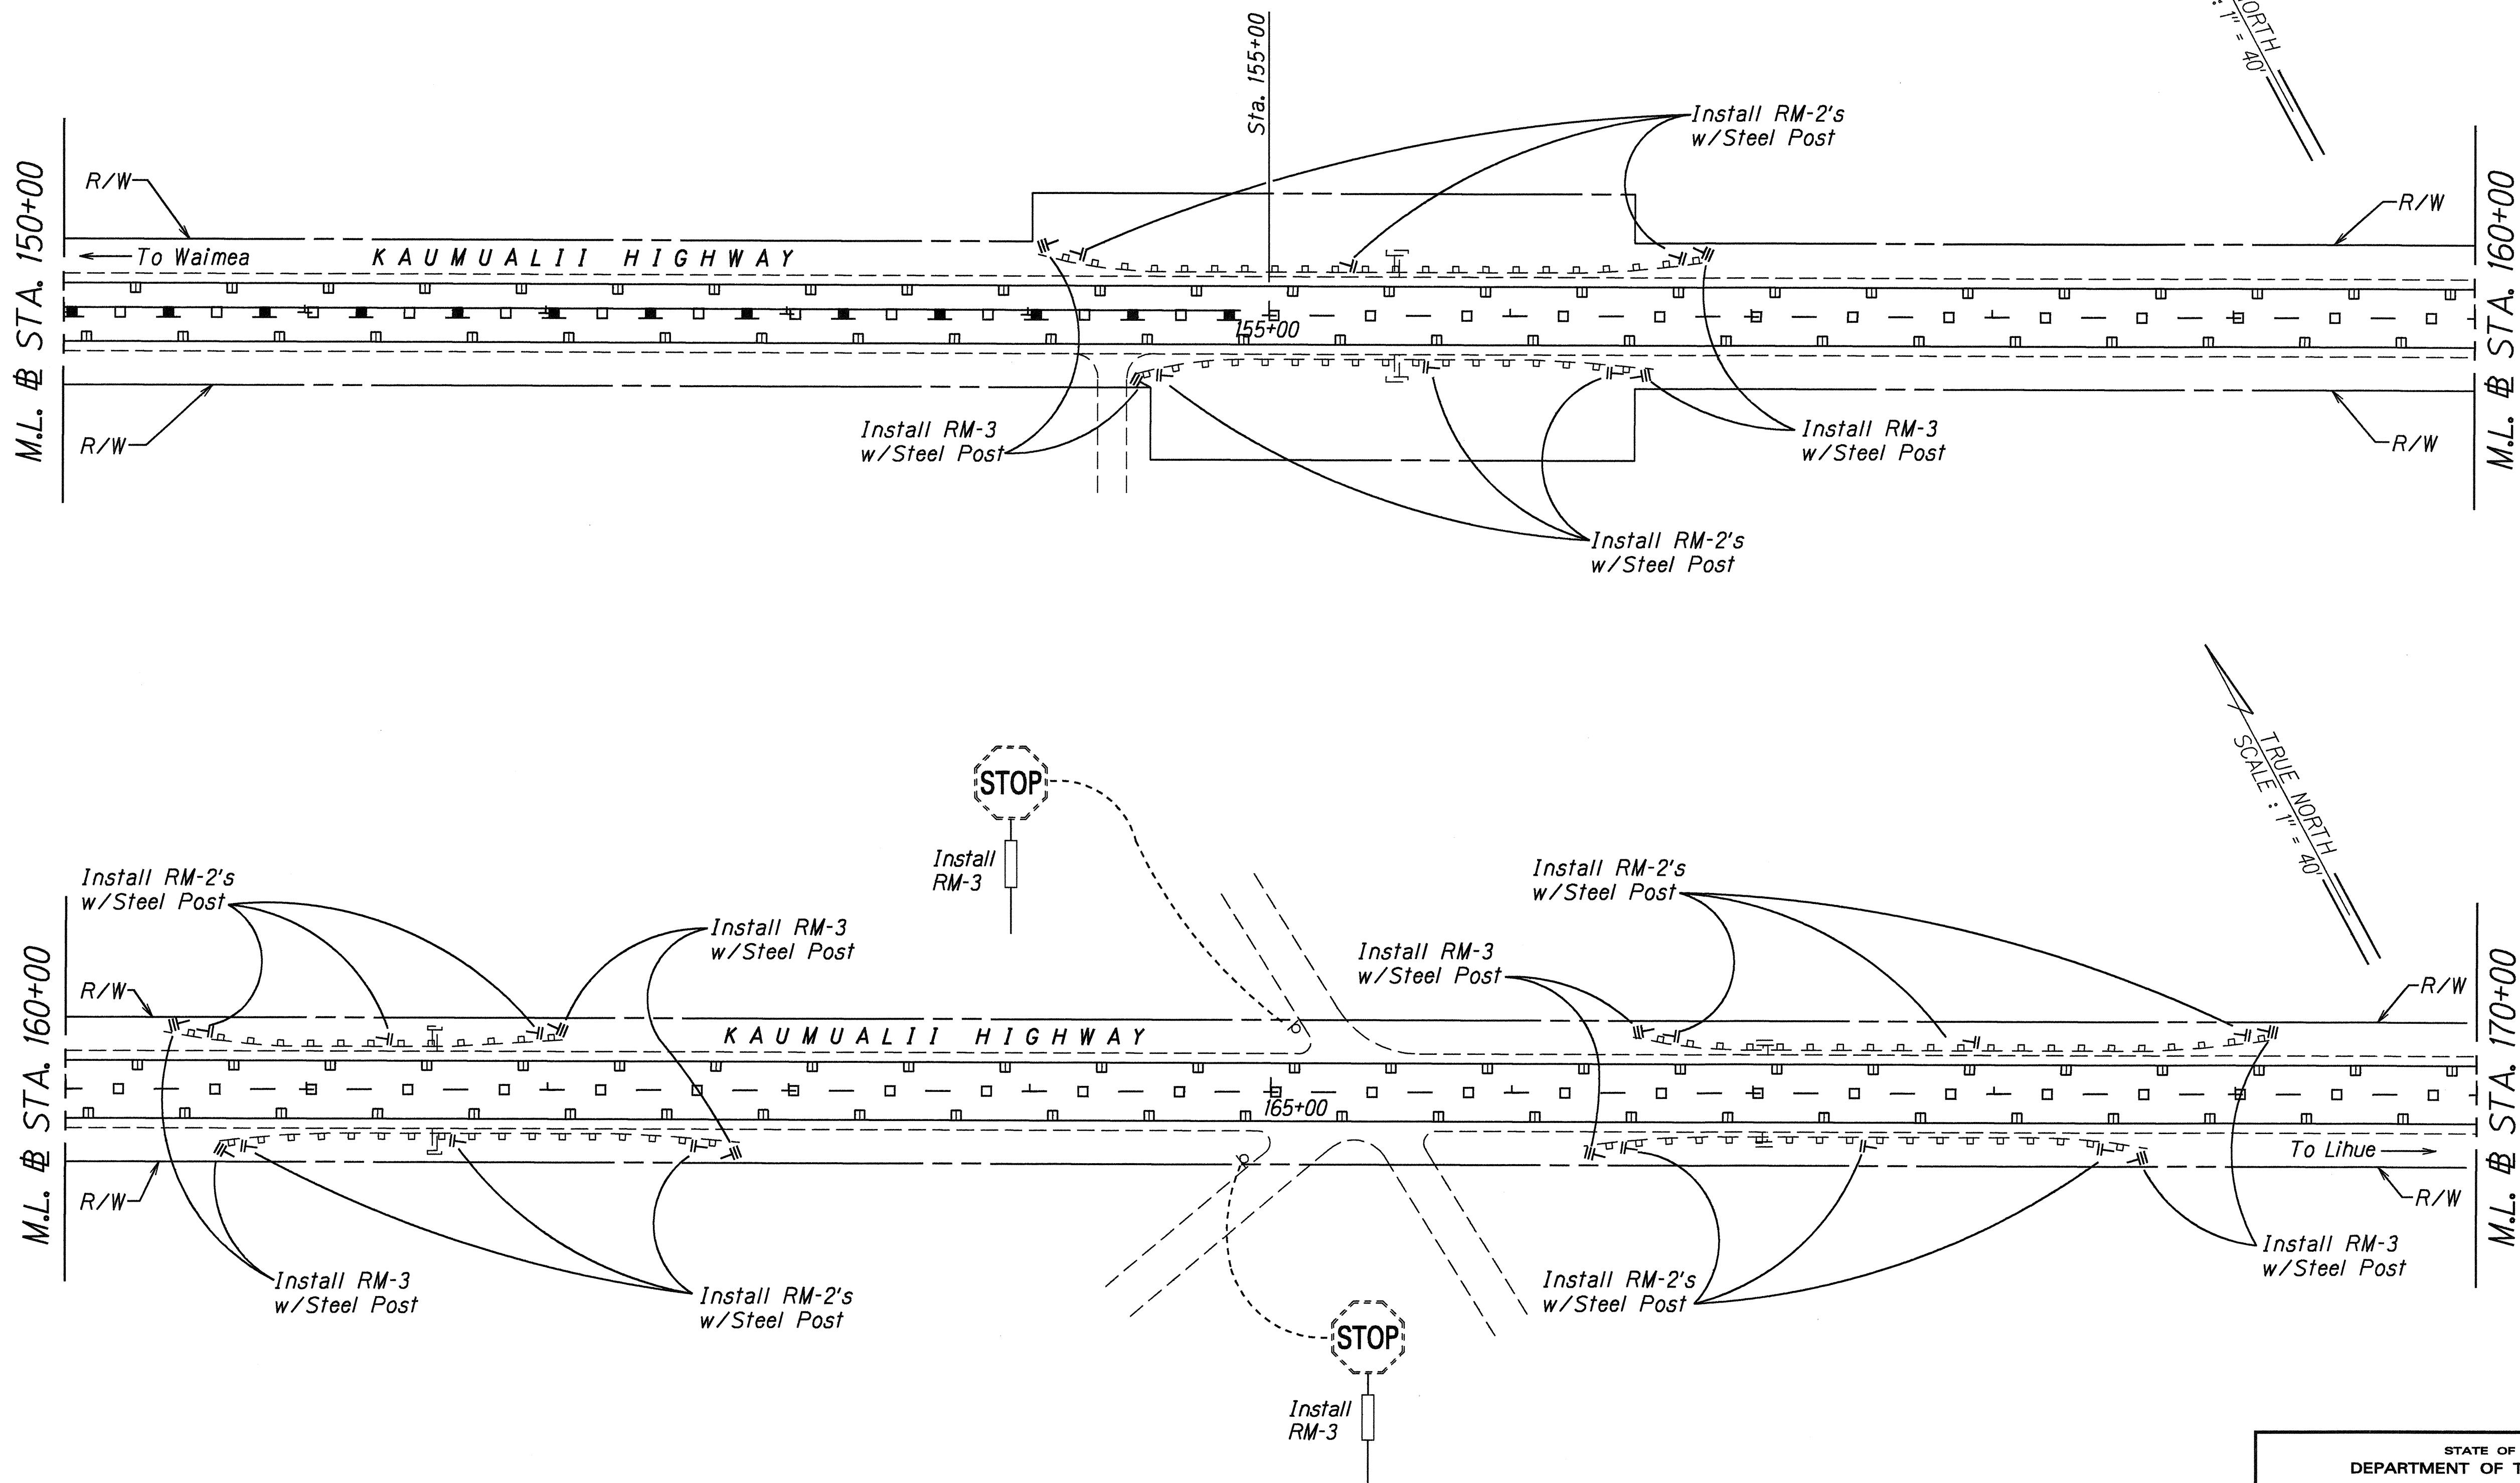

|               |                   |         |
|---------------|-------------------|---------|
| ORIGINAL PLAN | SURVEY PLOTTED BY | DATE    |
| ddi           | Maunaloa          | 5/19/95 |
| ddi           | Maunaloa          |         |
| ddi           | Maunaloa          |         |
STATE OF HAWAII  
DEPARTMENT OF TRANSPORTATION  
HIGHWAYS DIVISION

**TRAFFIC MARKING AND  
SIGN PLAN**

KAUMUALII HIGHWAY RESURFACING  
KUKUL GROVE TO HULEIA BRIDGE

Fed. Aid Proj. No. STP-050-1(15)

Scale: 1" = 40' Date: Apr, 1995


SHEET No. 4 OF 11 SHEETS







| FED. ROAD DIST. NO. | STATE | FED. AID PROJ. NO. | FISCAL YEAR | SHEET NO. | TOTAL SHEETS |
|---------------------|-------|--------------------|-------------|-----------|--------------|
| HAWAII              | HAW.  | STP-050-1(15)      | 1995        | 28        | 36           |

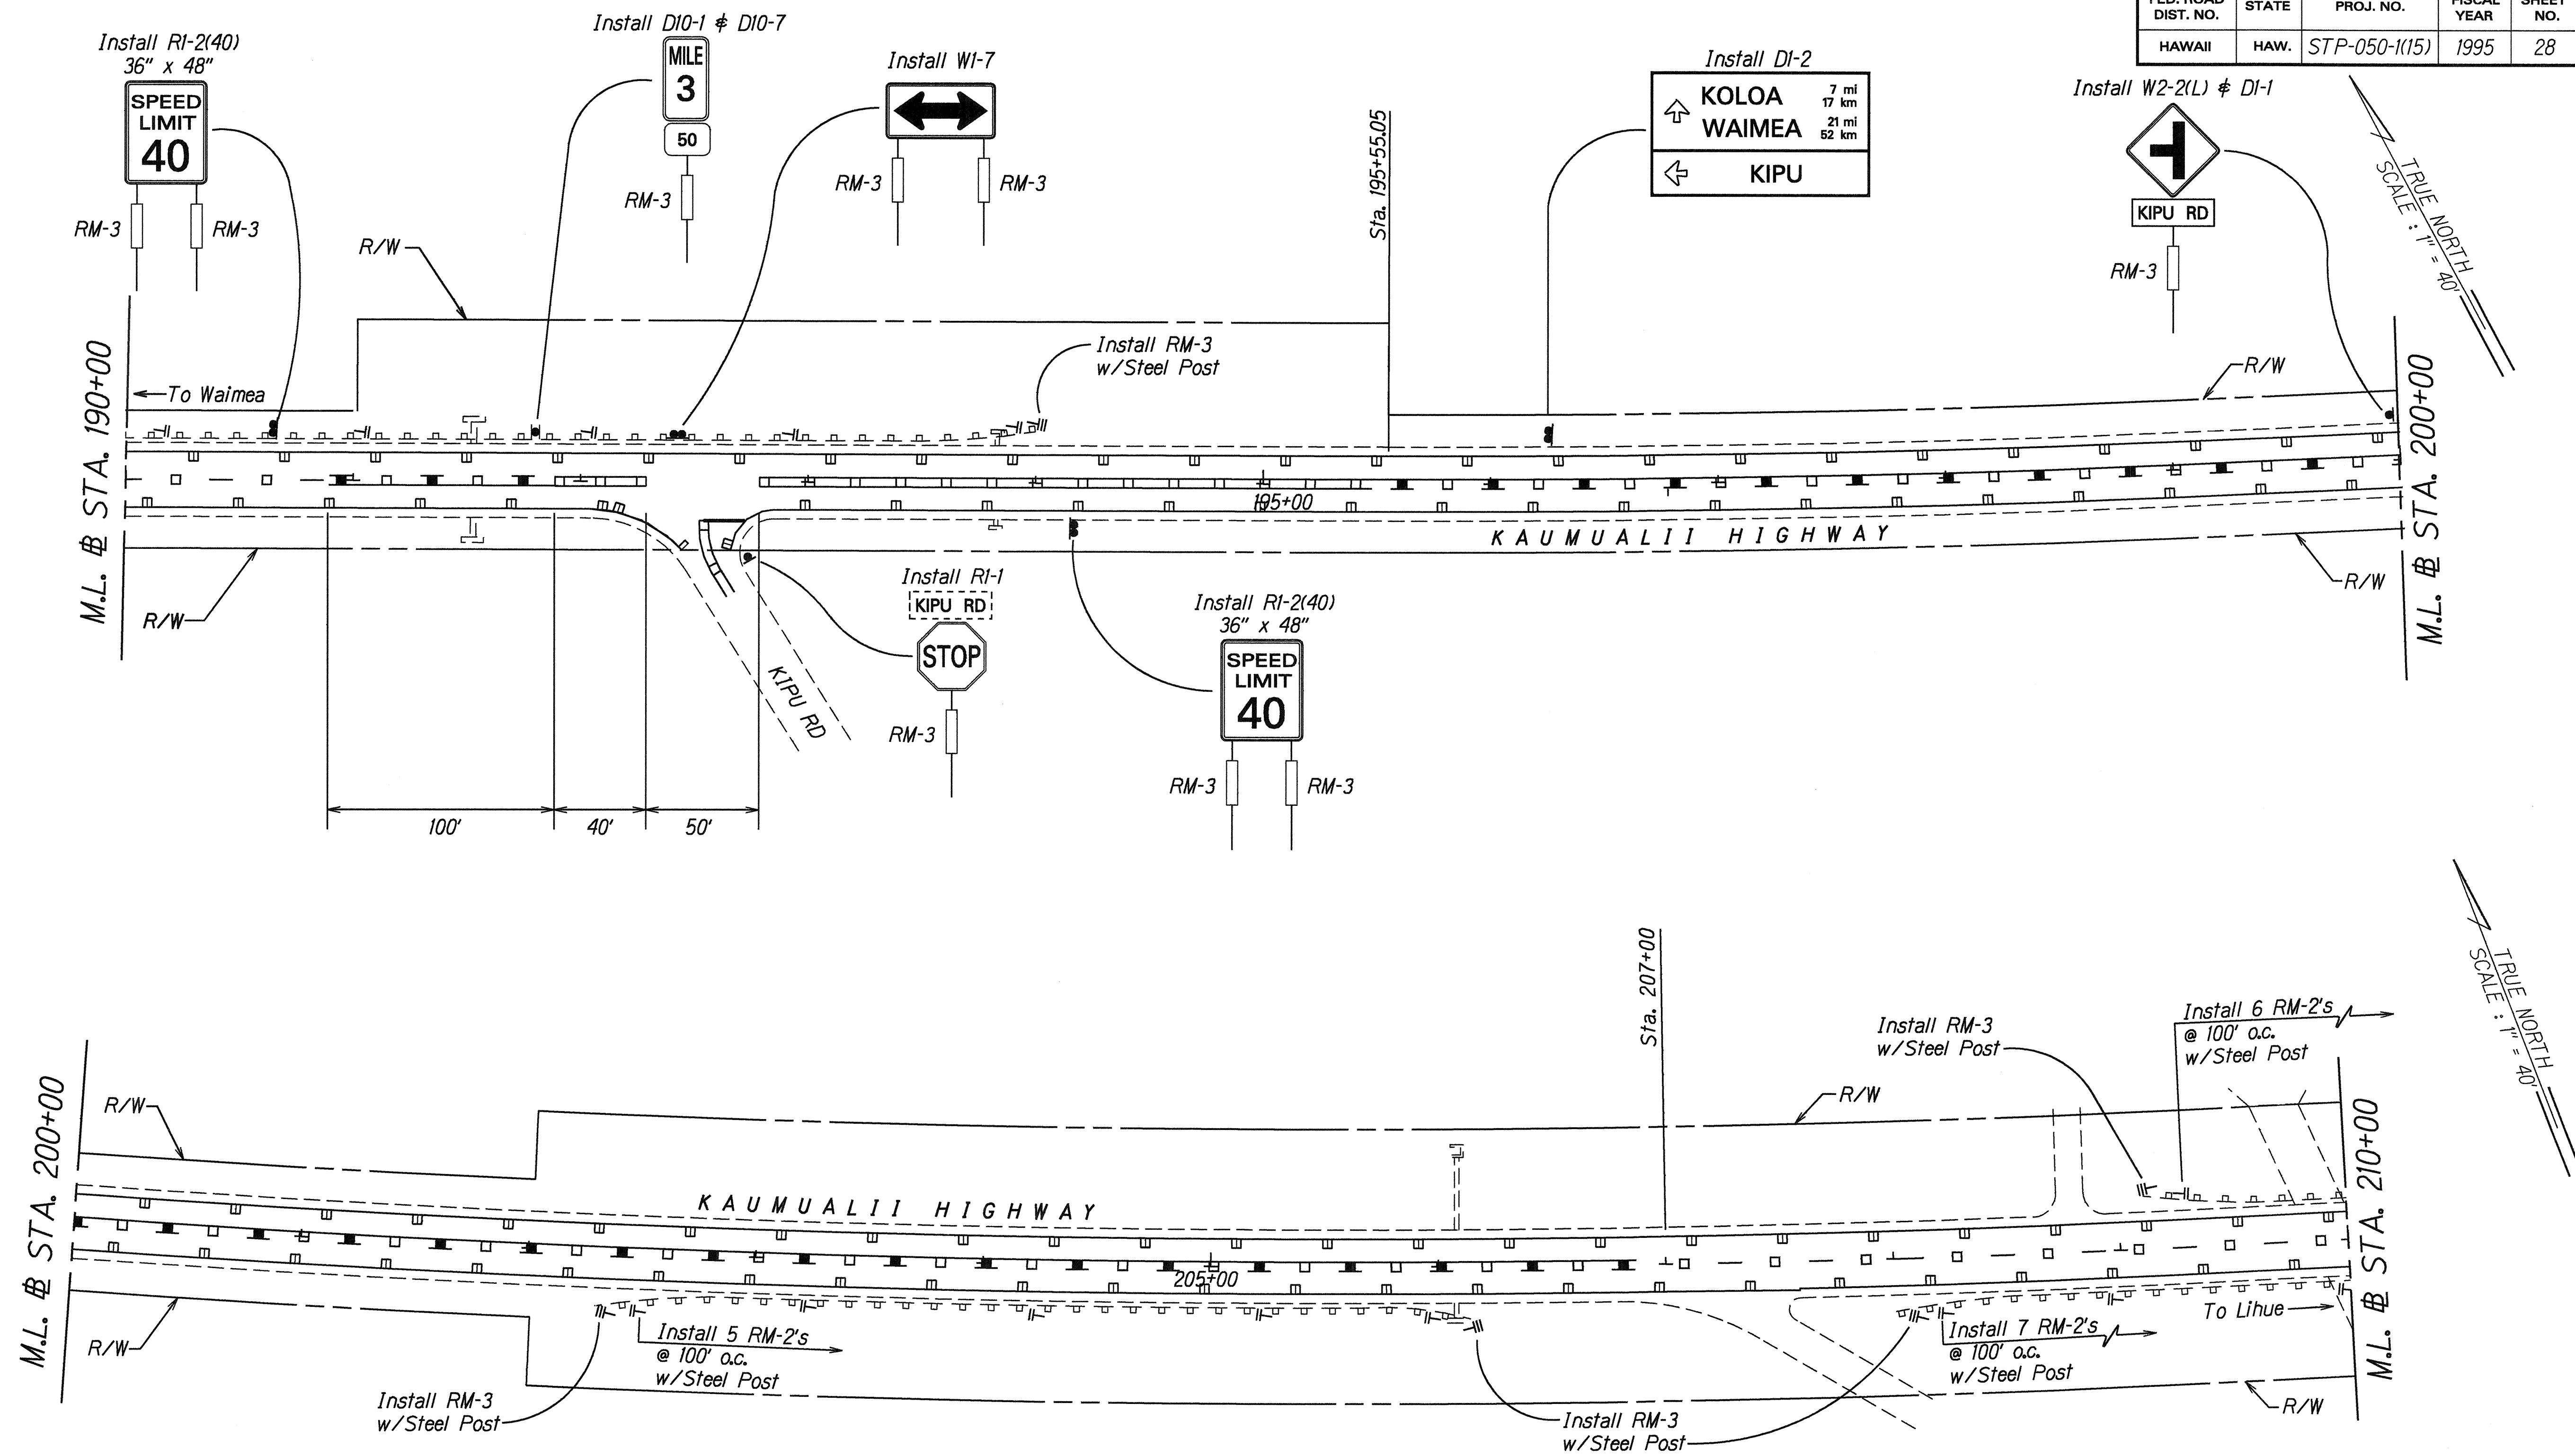

|               |                   |         |
|---------------|-------------------|---------|
| ORIGINAL PLAN | SURVEY PLOTTED BY | DATE    |
| NOTE BOOK     | DRAWN BY          | 5/19/95 |
| ke2 gary      | TRACED BY         |         |
| 44mhp0606m    | CHECKED BY        |         |

STATE OF HAWAII  
DEPARTMENT OF TRANSPORTATION  
HIGHWAYS DIVISION

**TRAFFIC MARKING AND  
SIGN PLAN**

**KAUMUALII HIGHWAY RESURFACING  
KUKUI GROVE TO HULEIA BRIDGE**


Fed. Aid Proj. No. STP-050-1(15)

Scale: 1" = 40' Date: Apr, 1995

SHEET No. 6 OF 11 SHEETS



| FED. ROAD DIST. NO. | STATE | FED. AID PROJ. NO. | FISCAL YEAR | SHEET NO. | TOTAL SHEETS |
|---------------------|-------|--------------------|-------------|-----------|--------------|
| HAWAII              | HAW.  | STP-050-1(15)      | 1995        | 29        | 36           |

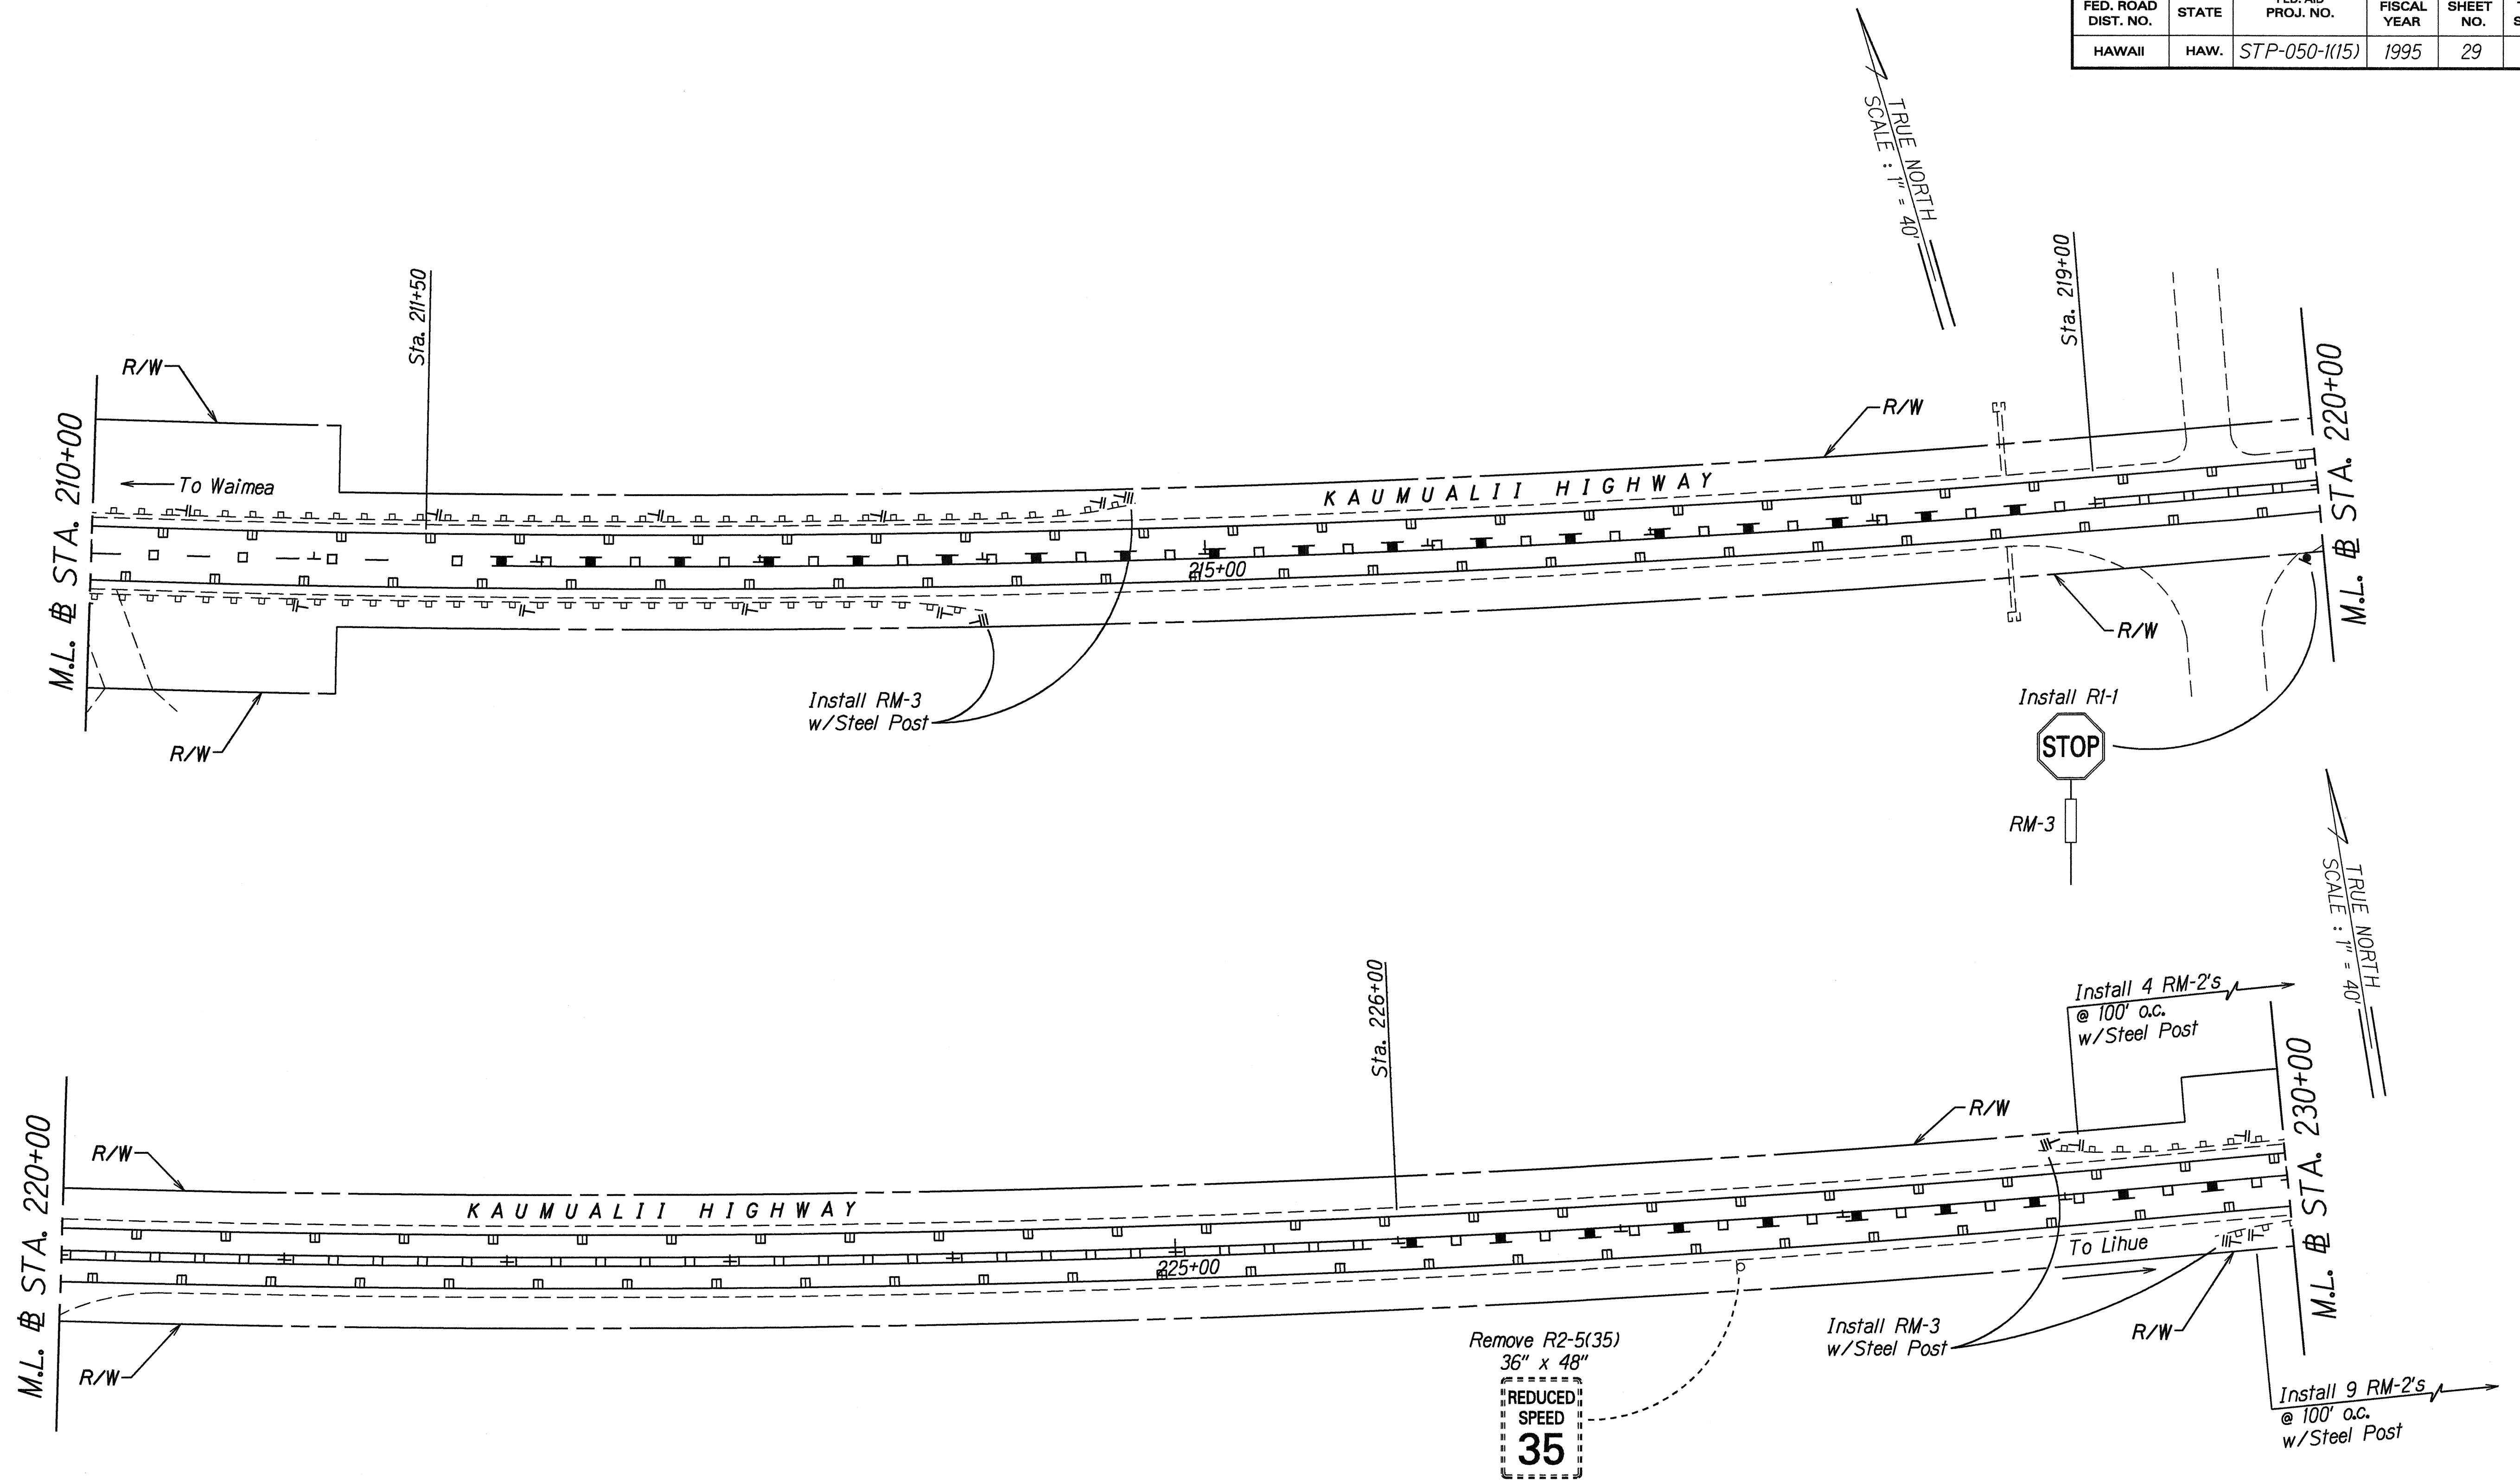

|               |                   |         |
|---------------|-------------------|---------|
| ORIGINAL PLAN | SURVEY PLOTTED BY | DATE    |
| NOTE BOOK     | DRAWN BY          | 5/19/95 |
| ddi grace     | TRACED BY         |         |
| N44m/ppt      | QUANTITIES BY     |         |
|               | CHECKED BY        |         |

STATE OF HAWAII  
DEPARTMENT OF TRANSPORTATION  
HIGHWAYS DIVISION

**TRAFFIC MARKING AND  
SIGN PLAN**

**KAUMUALII HIGHWAY RESURFACING  
KUKUL GROVE TO HULEIA BRIDGE**


**Fed. Aid Proj. No. STP-050-1(15)**

Scale: 1" = 40' Date: Apr, 1995

SHEET No. 7 OF 11 SHEETS



| FED. ROAD DIST. NO. | STATE | FED. AID PROJ. NO. | FISCAL YEAR | SHEET NO. | TOTAL SHEETS |
|---------------------|-------|--------------------|-------------|-----------|--------------|
| HAWAII              | HAW.  | STP-050-1(15)      | 1995        | 30        | 36           |

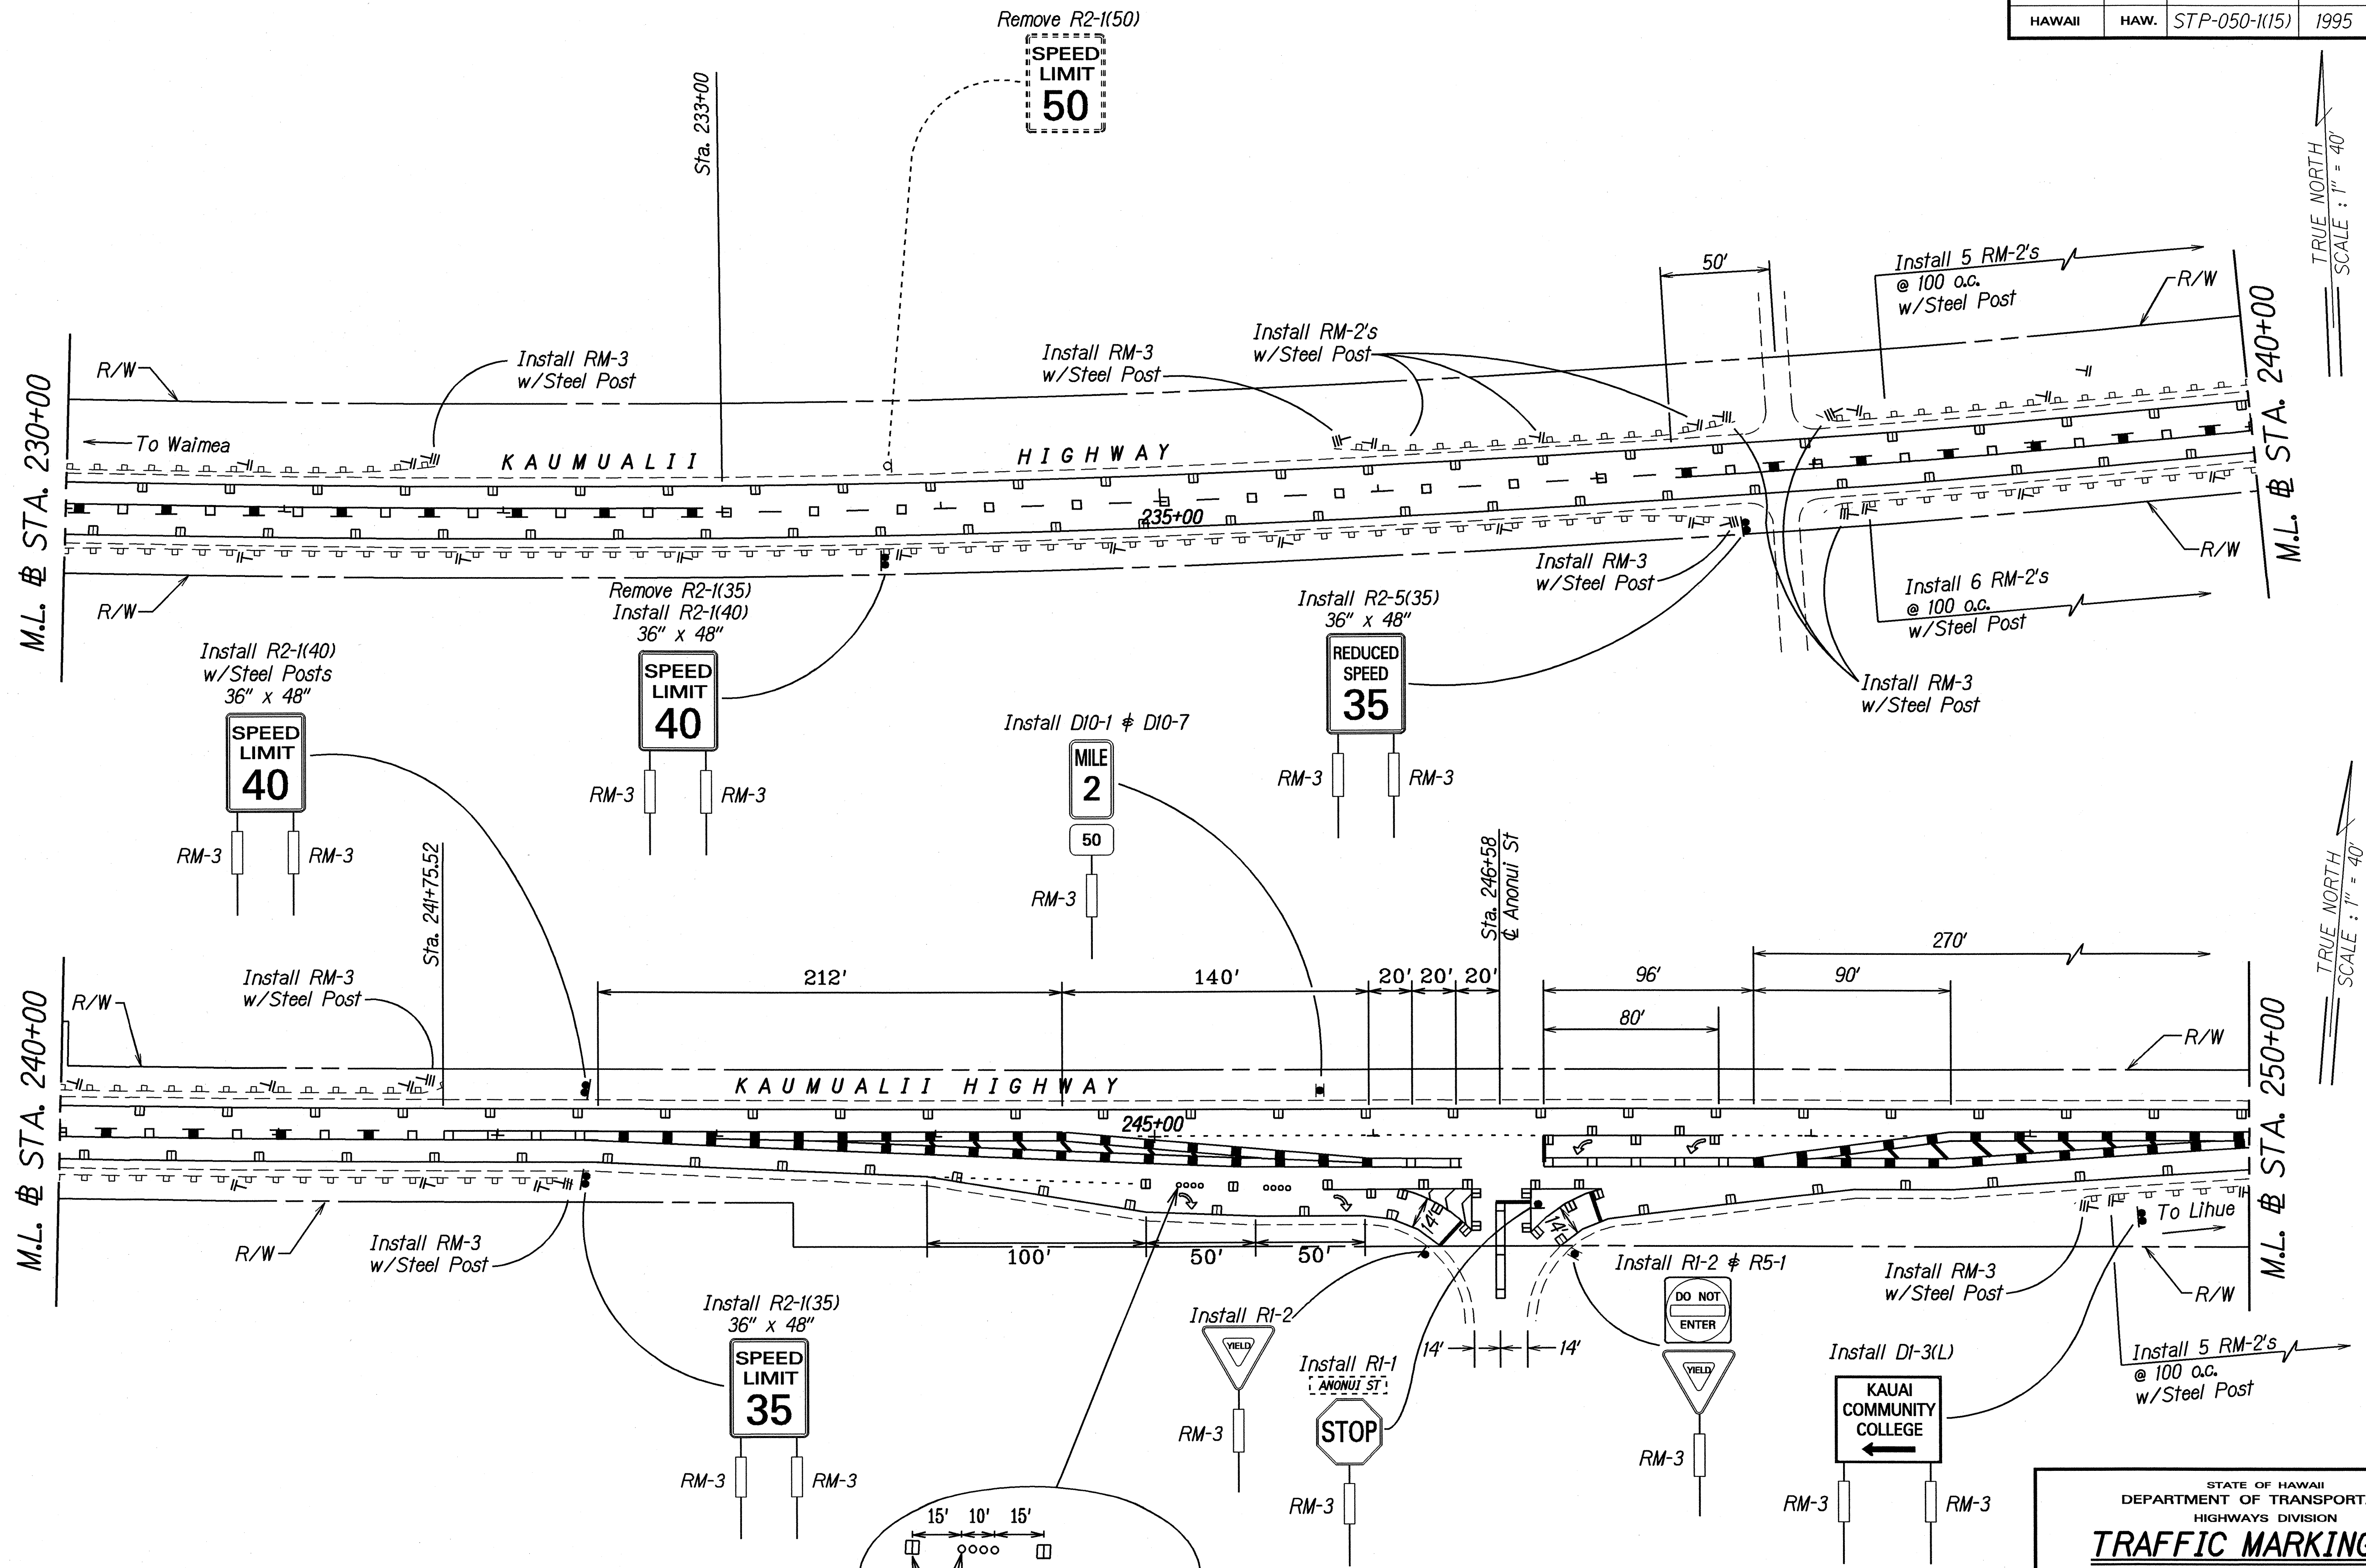

| LEGEND FOR AS-BUILT POSTINGS |                                     |
|------------------------------|-------------------------------------|
|                              | Squiggly line for as-built deletion |
|                              | Double line for as-built deletion   |
| Roadway                      | Text for as-built posting           |

STATE OF HAWAII  
DEPARTMENT OF TRANSPORTATION  
HIGHWAYS DIVISION

**TRAFFIC MARKING AND  
SIGN PLAN**

**KAUMUALII HIGHWAY RESURFACING  
KUKUI GROVE TO HULEIA BRIDGE  
Fed. Aid Proj. No STP-050-1(15)**

Scale: 1" = 40' Date: Apr, 1995


SHEET No. 8 OF 11 SHEETS







| FED. ROAD DIST. NO. | STATE | FED. AID PROJ. NO. | FISCAL YEAR | SHEET NO. | TOTAL SHEETS |
|---------------------|-------|--------------------|-------------|-----------|--------------|
| HAWAII              | HAW.  | STP-050-1(15)      | 1995        | 32        | 36           |

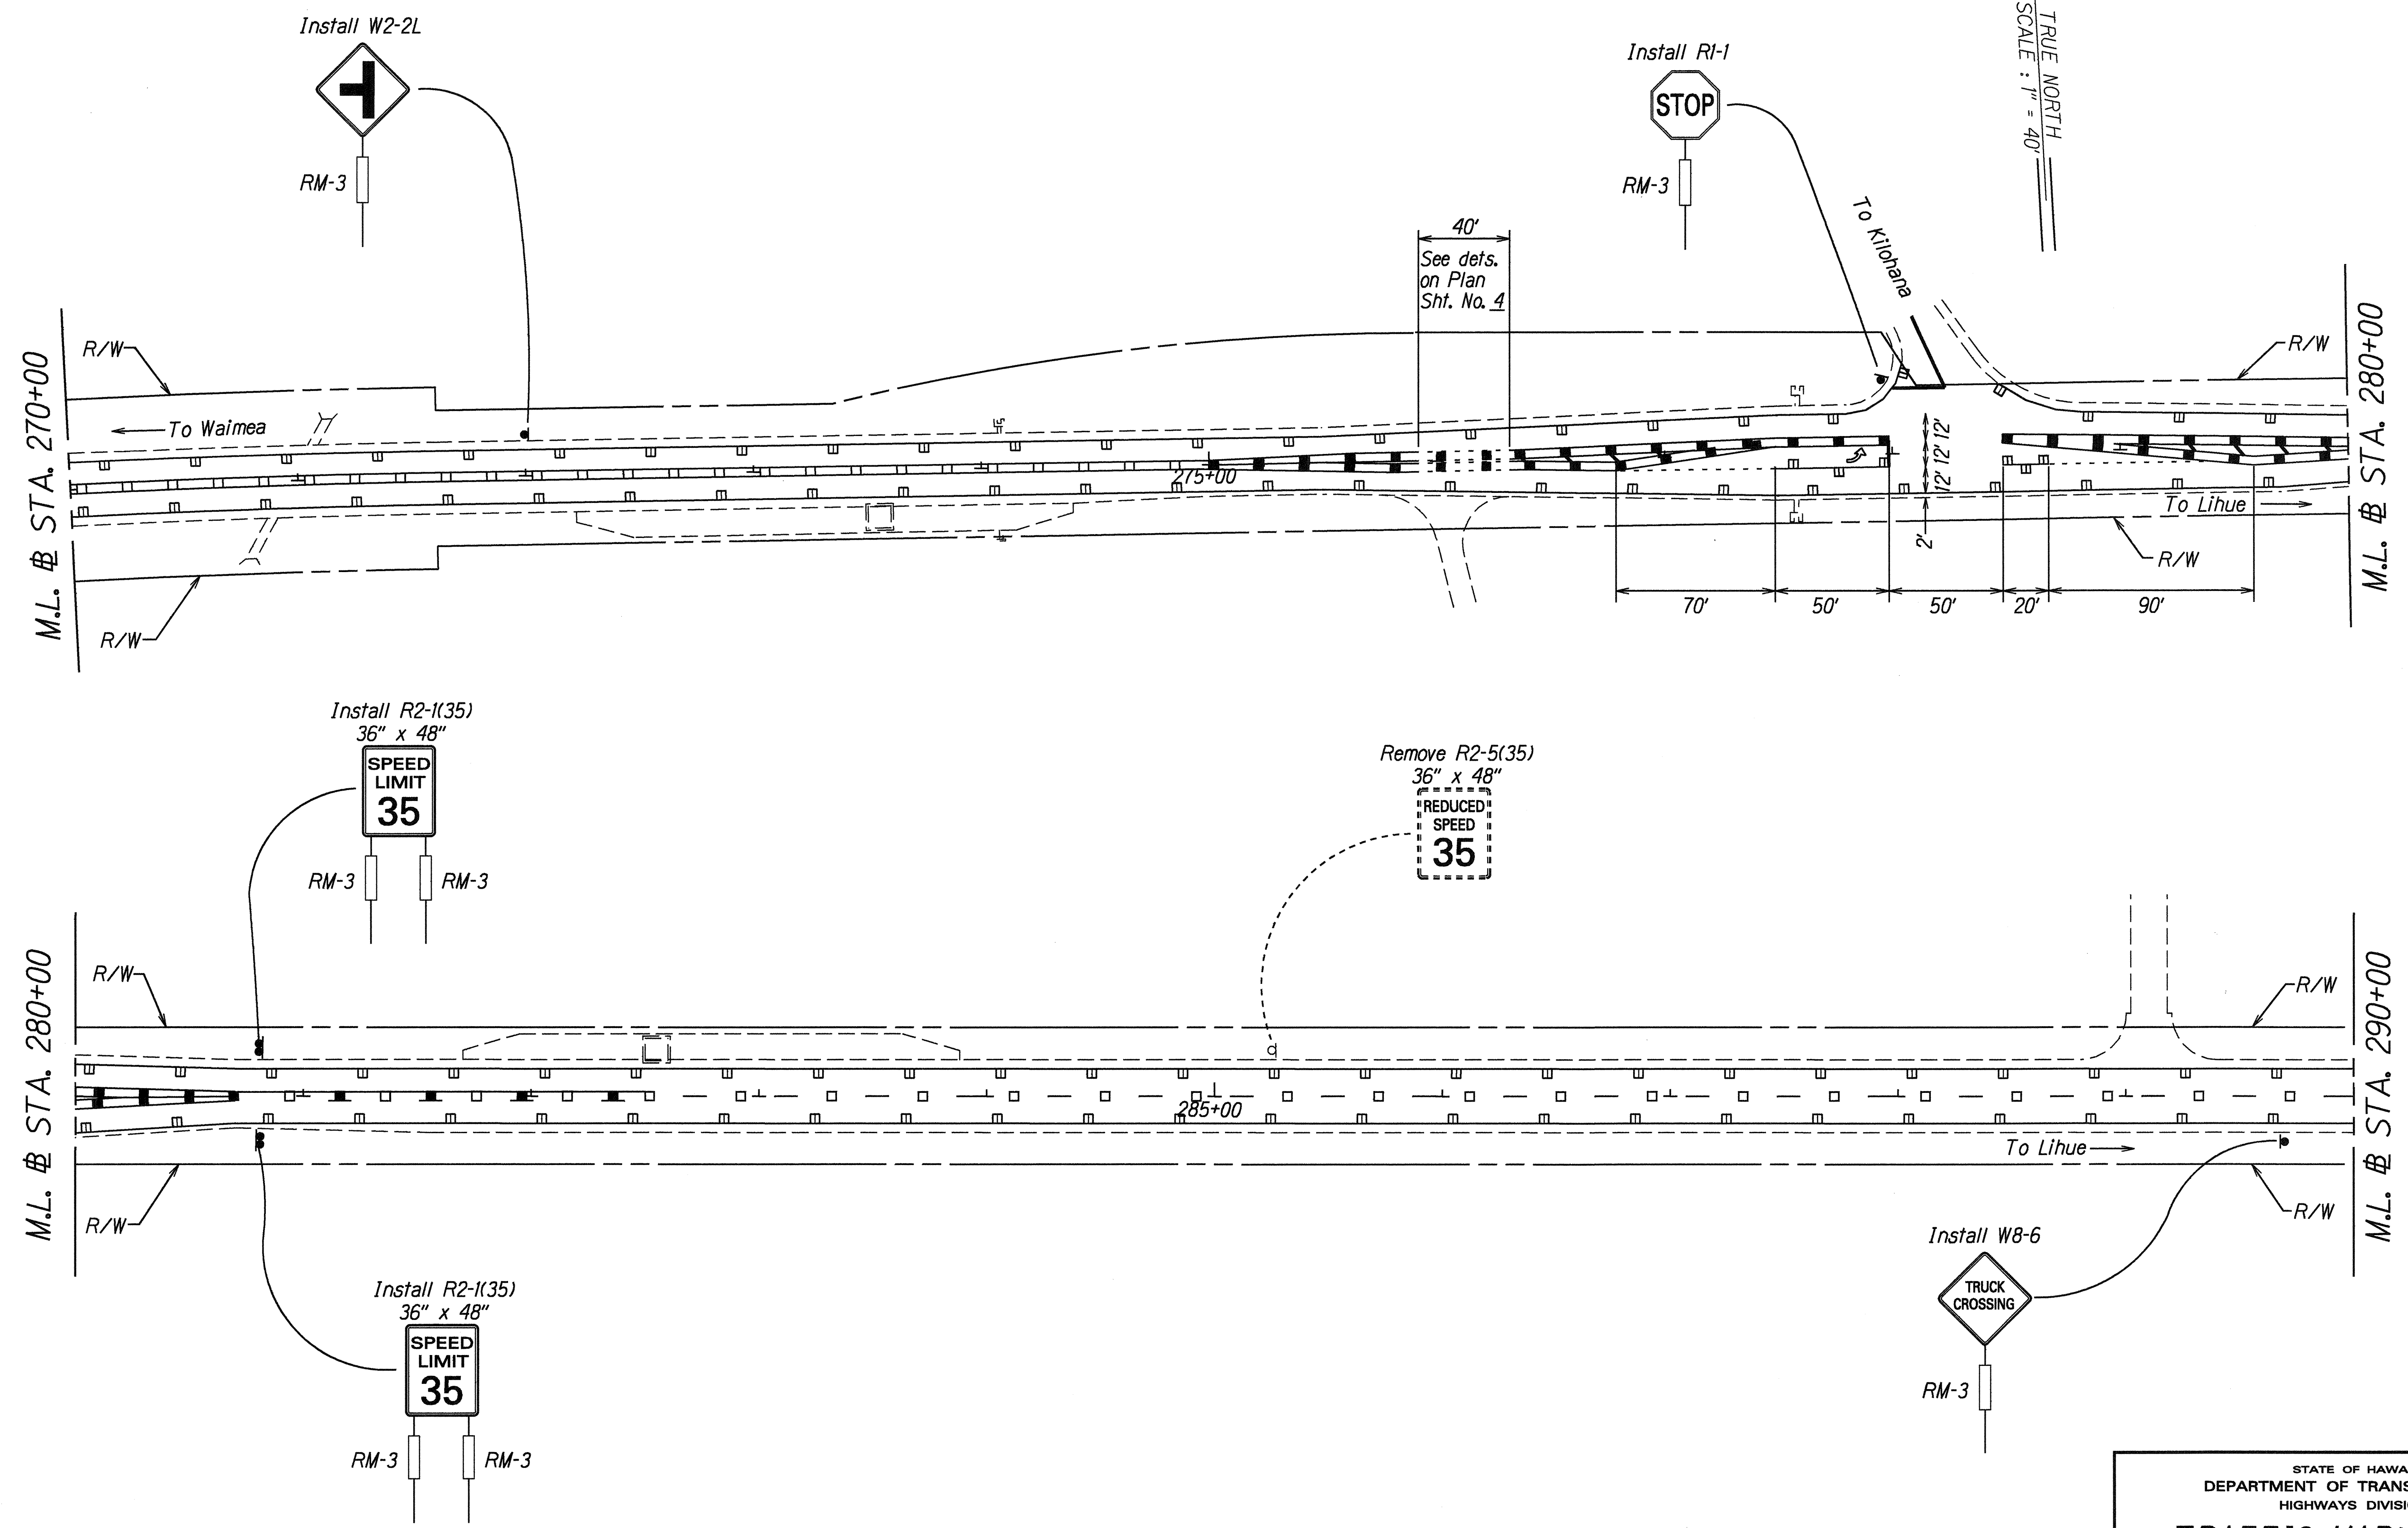

|               |                   |         |
|---------------|-------------------|---------|
| ORIGINAL PLAN | SURVEY PLOTTED BY | DATE    |
| PLAN          | DRAWN BY          | 5/19/95 |
| NOTE BOOK     | TRACED BY         |         |
| ddl grace     | QUANTITIES BY     |         |
| N. 4/10/1990  | CHECKED BY        |         |


STATE OF HAWAII  
DEPARTMENT OF TRANSPORTATION  
HIGHWAYS DIVISION

**TRAFFIC MARKING AND  
SIGN PLAN**  
**KAUMUALII HIGHWAY RESURFACING  
KUKU GROVE TO HULEIA BRIDGE**  
**Fed. Aid Proj. No. STP-050-1(15)**  
Scale: 1" = 40'      Date: Apr, 1995

SHEET No. 10 OF 11 SHEETS



| FED. ROAD DIST. NO. | STATE | FED. AID PROJ. NO. | FISCAL YEAR | SHEET NO. | TOTAL SHEETS |
|---------------------|-------|--------------------|-------------|-----------|--------------|
| HAWAII              | HAW.  | STP-050-1(15)      | 1995        | 33        | 36           |

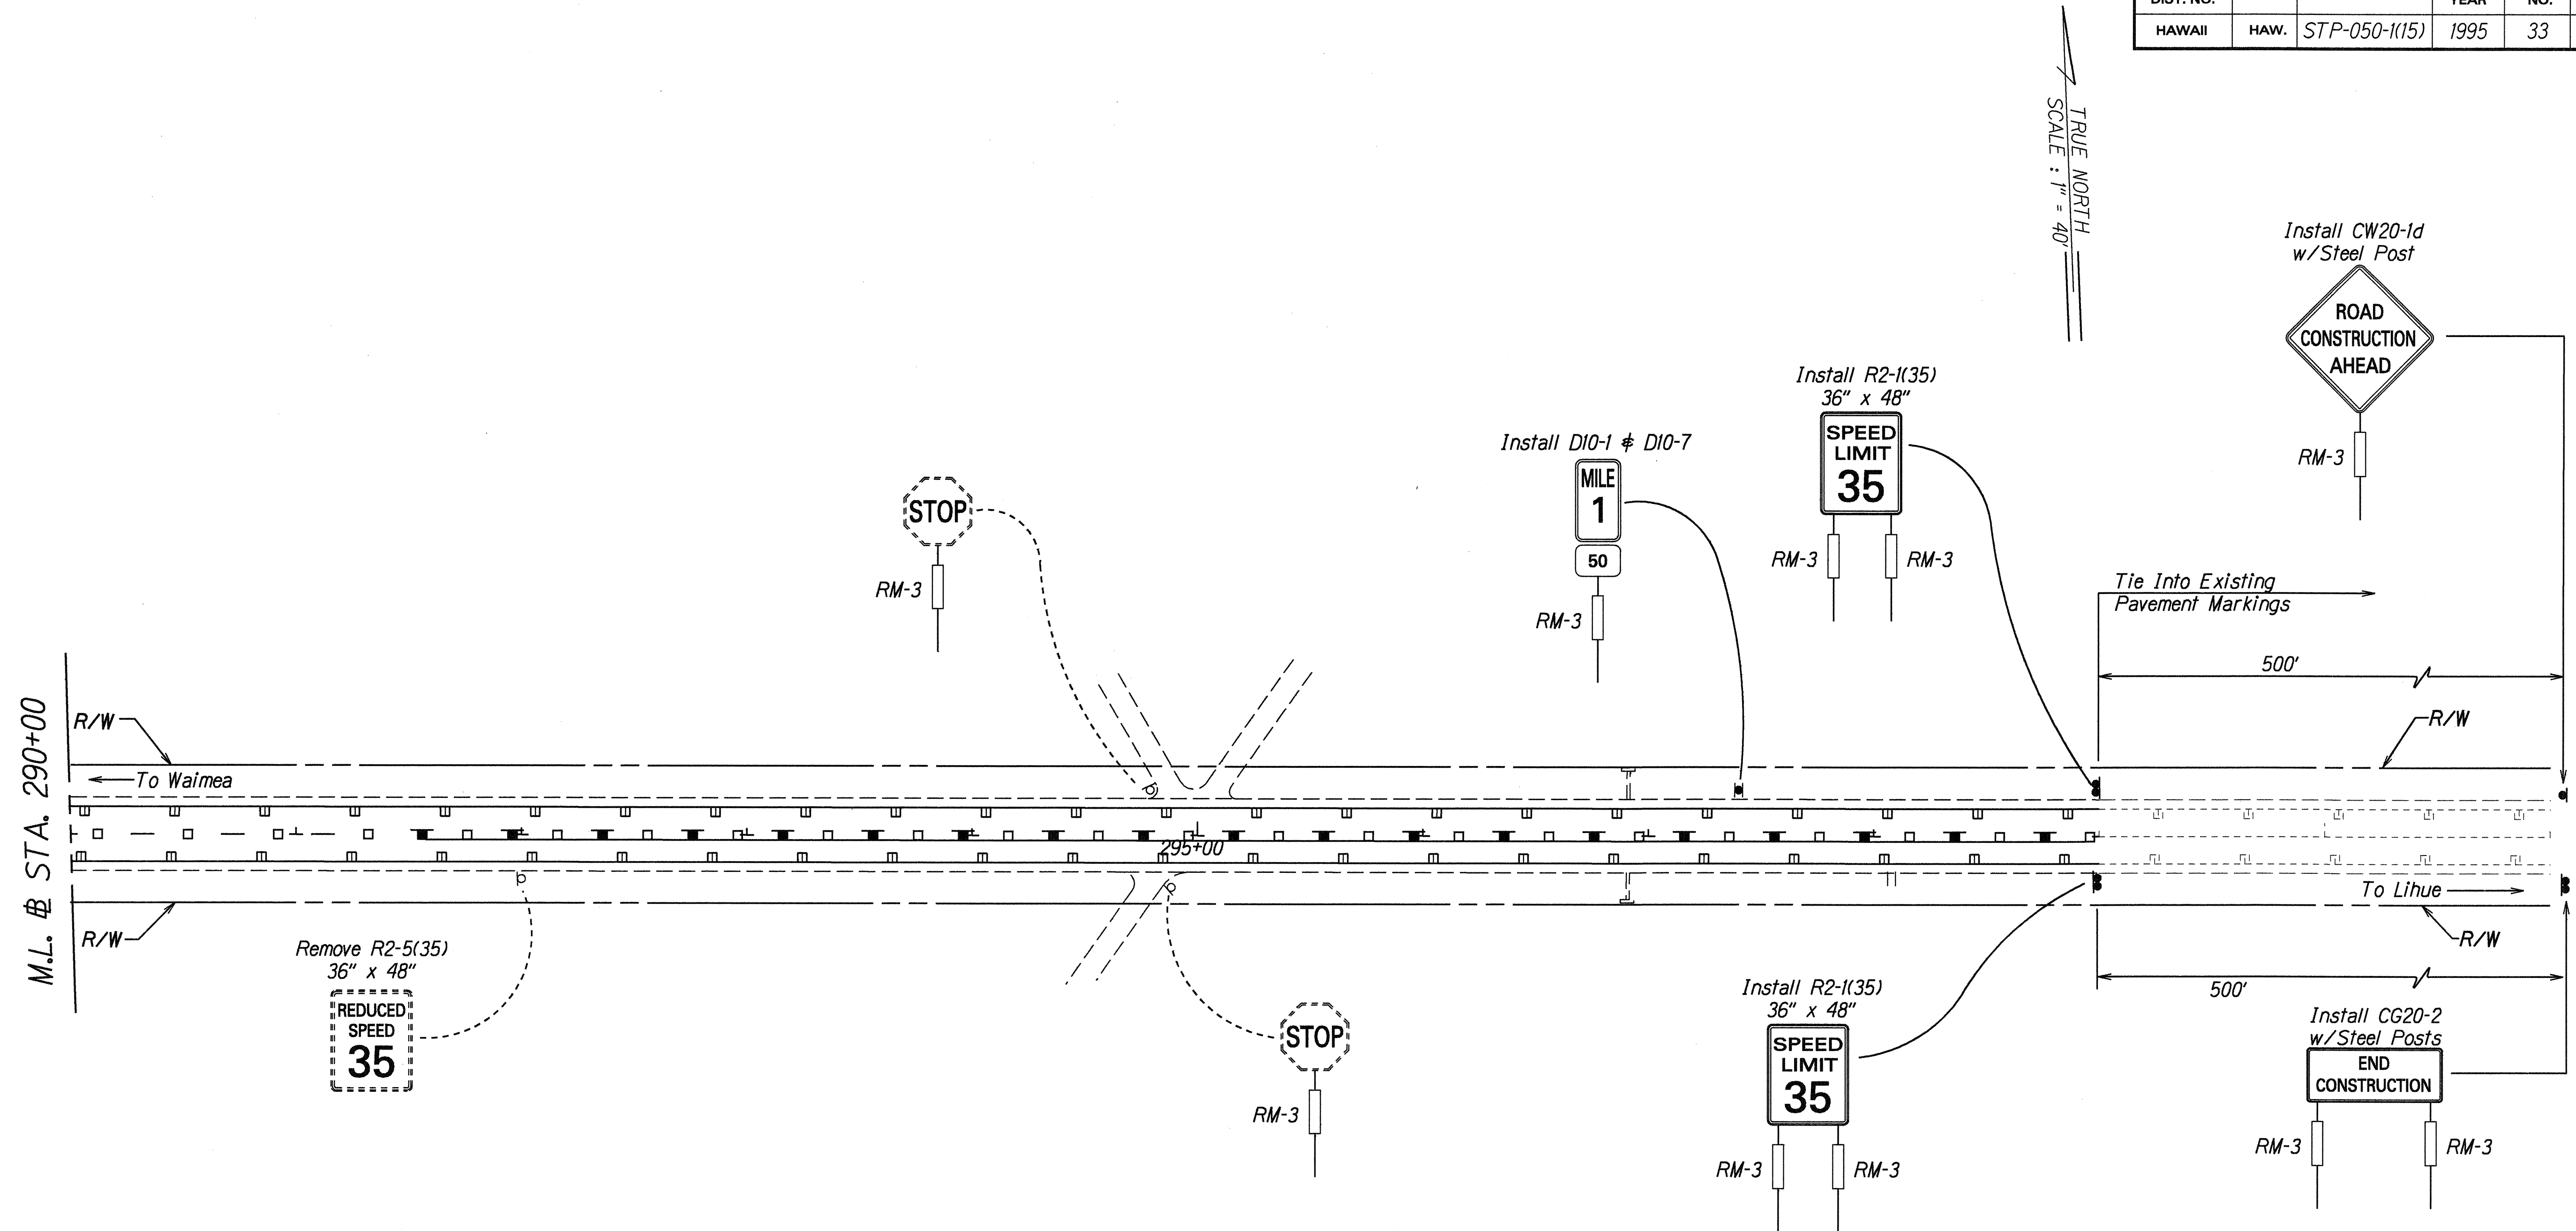

|               |                   |         |
|---------------|-------------------|---------|
| ORIGINAL PLAN | SURVEY PLOTTED BY | DATE    |
| NOTE BOOK     | DRAWN BY          | 5/19/95 |
| old grace     | TRACED BY         |         |
| N. Krumholz   | CHECKED BY        |         |

STATE OF HAWAII  
DEPARTMENT OF TRANSPORTATION  
HIGHWAYS DIVISION

ROADWAY PLAN  
KAUMUALII HIGHWAY RESURFACING  
KUKUI GROVE TO HULEIA BRIDGE  
Fed. Aid Proj. No. STP-050-1(15)

Scale: 1" = 40'
Date: Apr, 1995

SHEET No. 11 OF 11 SHEETS