

INDEX TO DRAWINGS	
SHEET NO.	DESCRIPTION
1	TITLE SHEET
2	STANDARD PLANS SUMMARY
3 - 4	GENERAL NOTES, LEGEND & ABBREVIATIONS
5 - 8	WATER POLLUTION AND EROSION CONTROL NOTES AND DETAILS
9	TYPICAL SECTIONS
10 - 26	ROADWAY PLANS AND DETAILS
27	SIGNING & PAVEMENT MARKING NOTES AND LEGEND
28 - 43	SIGNING & PAVEMENT MARKING PLANS
44	LOW SPEED UNDIVIDED HIGHWAY WORK ZONE SIGNING PLAN, NOTES & DETAILS
45	HIGH SPEED UNDIVIDED HIGHWAY WORK ZONE SIGNING PLAN, NOTES & DETAILS
46 - 56	TRAFFIC CONTROL NOTES AND PLANS

STATE OF HAWAII

DEPARTMENT OF TRANSPORTATION

HIGHWAYS DIVISION

HONOLULU, HAWAII

"AS-BUILT"

PLANS FOR

KAUMUALII HIGHWAY

PAVEMENT PREVENTIVE MAINTENANCE – PHASE I




KOLOA ROAD TO THE VICINITY OF HULEIA BRIDGE

FEDERAL-AID PROJECT NO. STP-050-1(039)

DISTRICTS OF KOLOA AND LIHUE

ISLAND OF KAUAI

FED. ROAD DIST. NO.	STATE	FEDERAL AID PROJ. NO.	FISCAL YEAR	SHEET NO.	TOTAL SHEETS
HAWAII	HAW.	STP-050-1(039)	2014	1	56

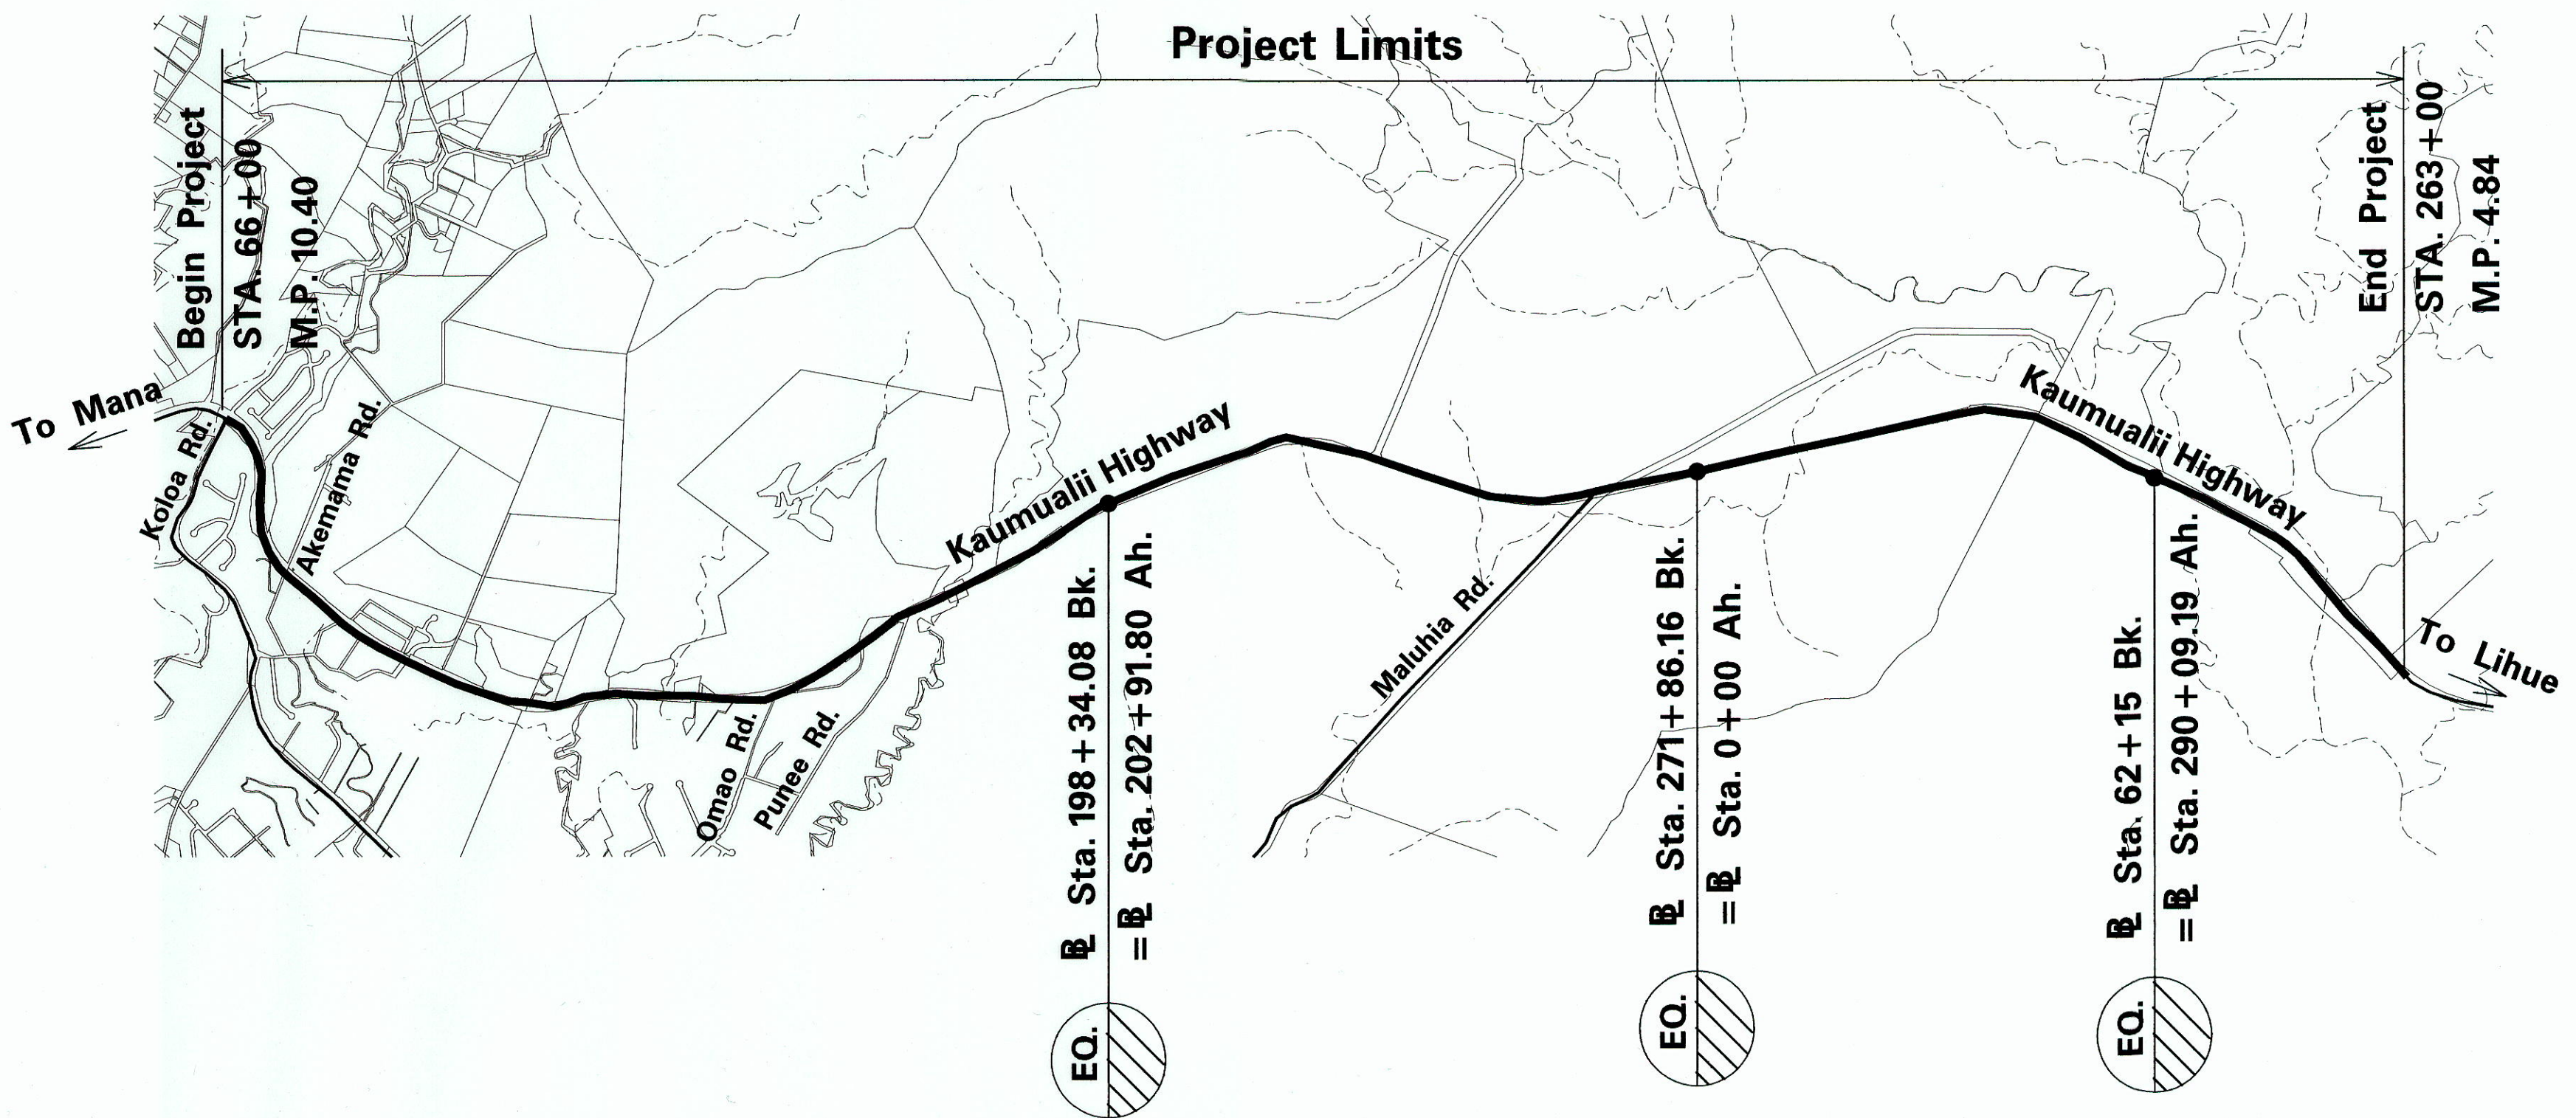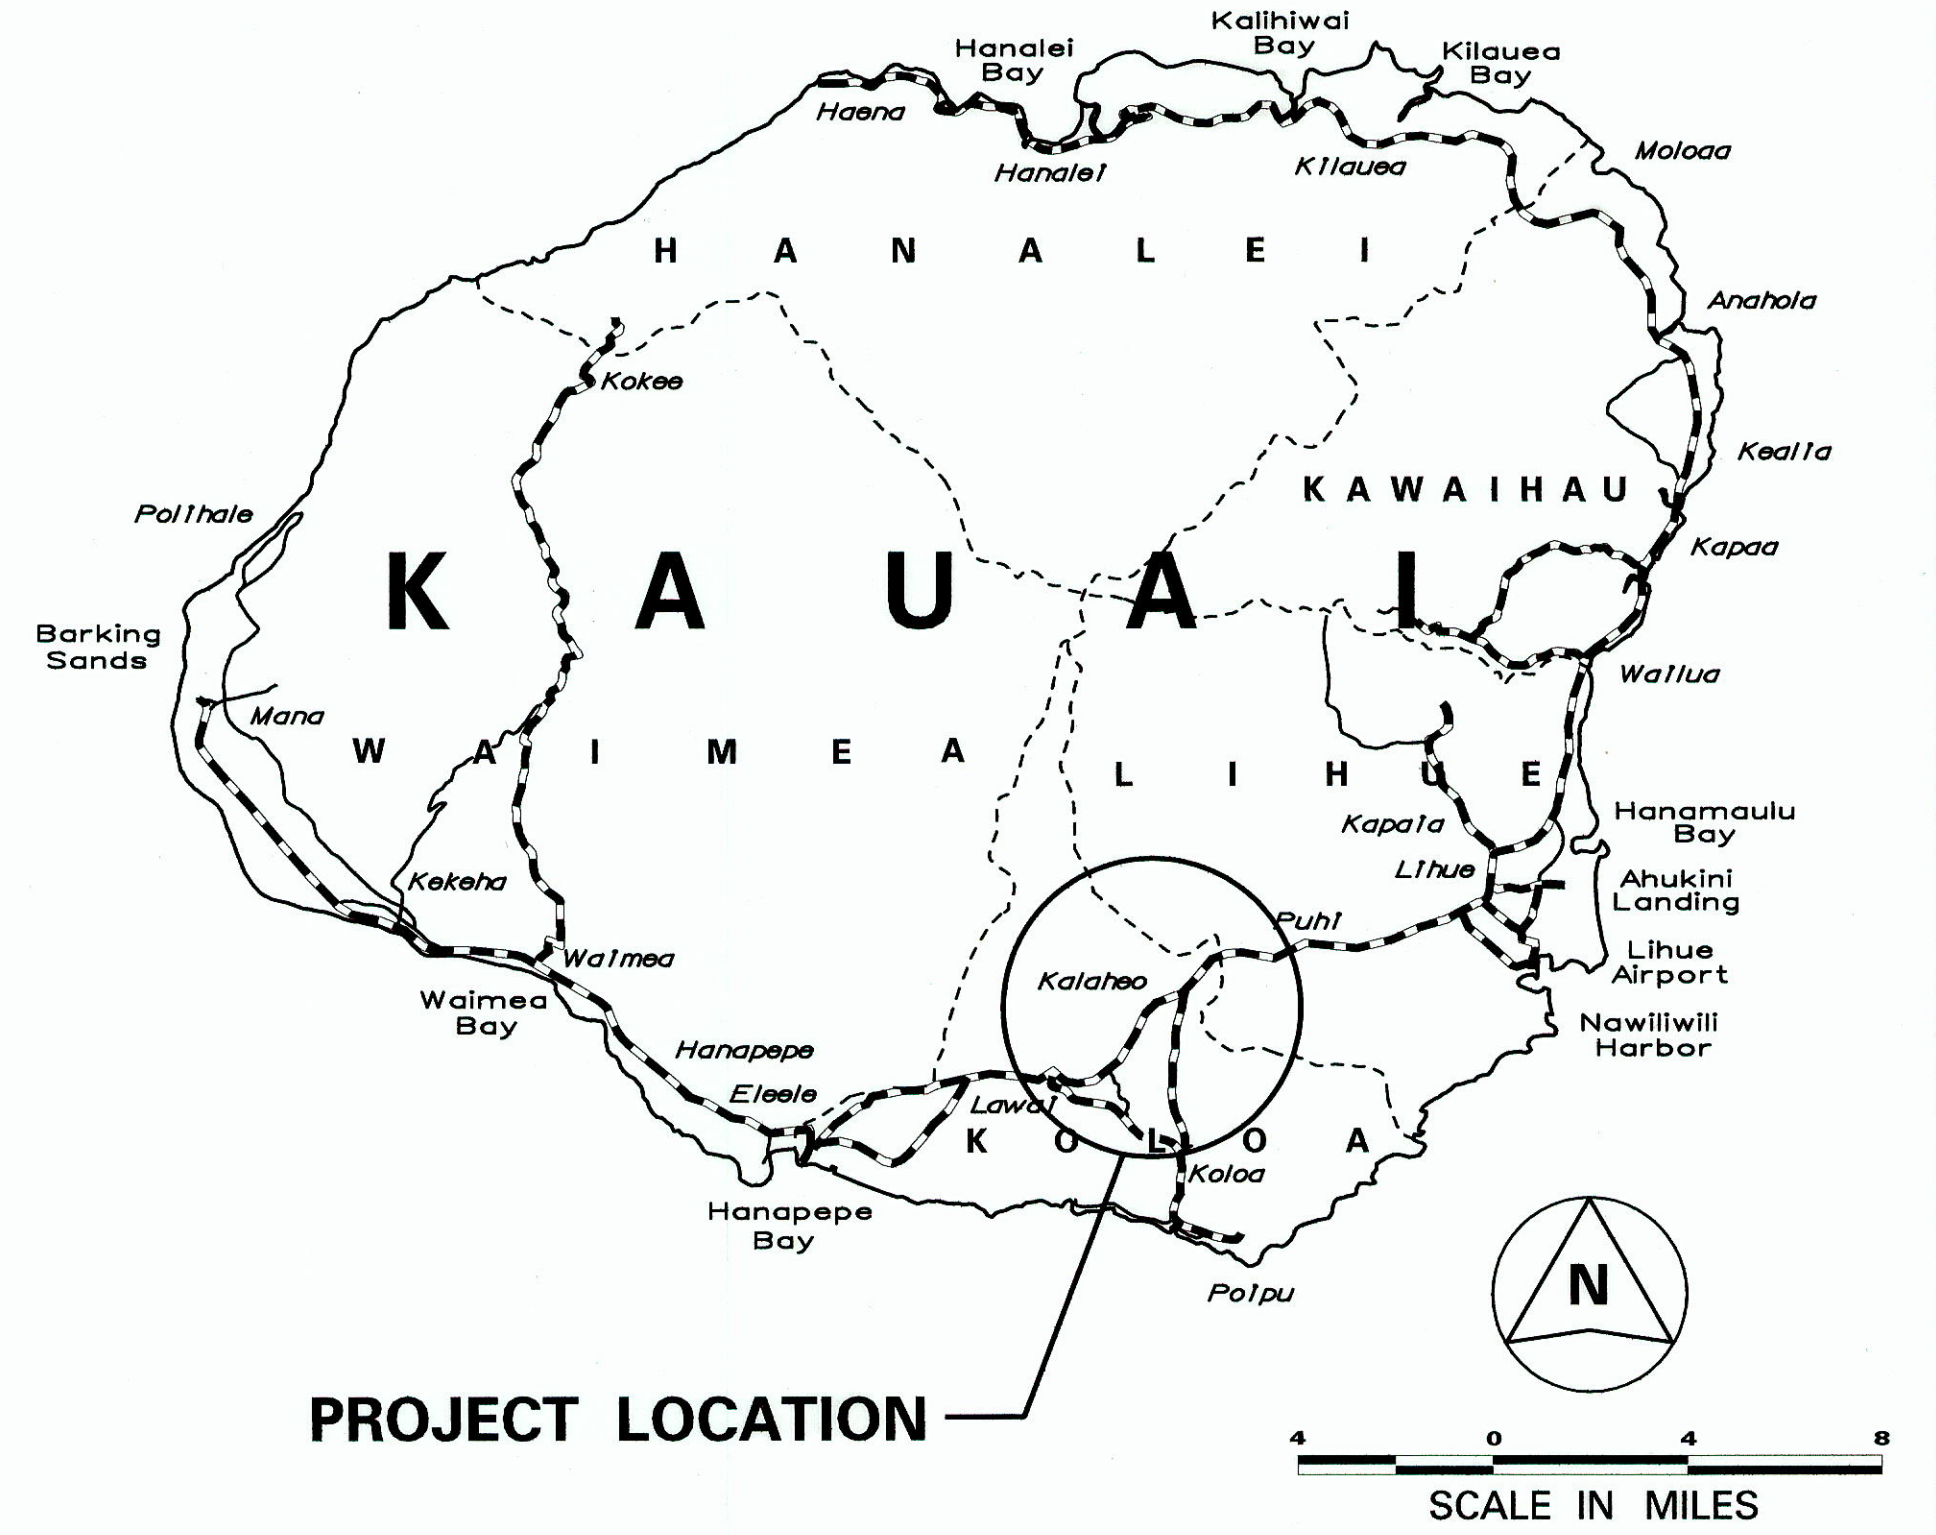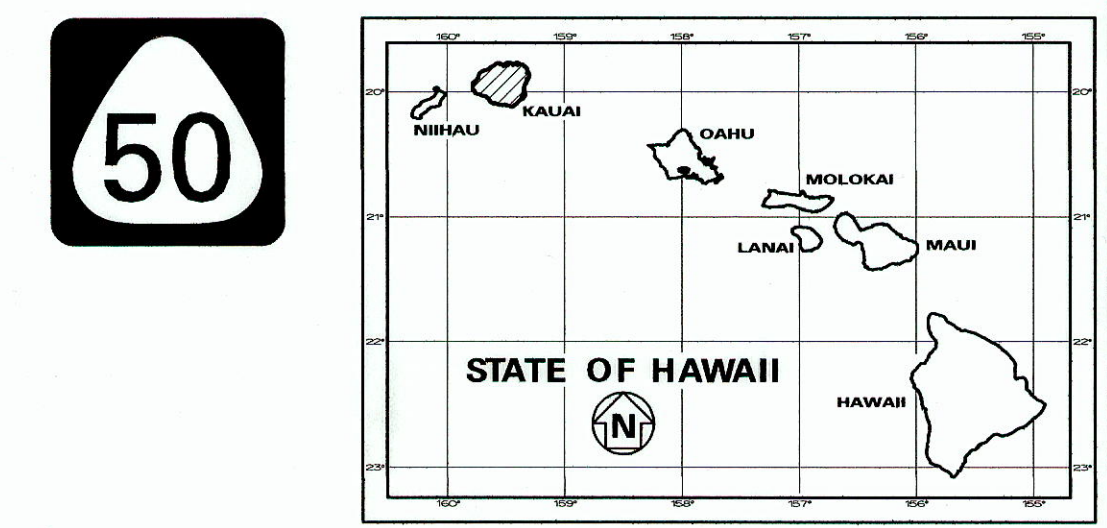

LAYOUT PLAN

NOT TO SCALE

GROSS LENGTH OF PROJECT.....5.56 MILES

NET LENGTH OF PROJECT.....5.56 MILES

DESIGN DESIGNATION		DESIGN DESIGNATION	
(M.P. 4.96 to M.P. 6.72)		(M.P. 6.72 to M.P. 10.30)	
ADT (2012).....	26,300	ADT (2012).....	15,500
ADT (2022).....	34,400	ADT (2022).....	20,200
DHV.....	2,920	DHV.....	1,720
D.....	60/40	D.....	70/30
T.....	3.0 %	T.....	4.0 %
V.....	50 M.P.H.	V.....	35 M.P.H.

CHANGES MADE DURING CONSTRUCTION HAVE BEEN INCORPORATED ON THESE PLANS EXCEPT CHANGES IN THE ORIGINAL THEORETICAL QUANTITIES. FOR ACTUAL QUANTITIES, REFER TO PROJECT LEDGER AND/OR COMPUTATION BOOK.

William R. Hahala

10/24/2017

DATE

RESIDENT ENGINEER

DEPARTMENT OF TRANSPORTATION

STATE OF HAWAII

APPROVED:

for DIR. OF TRANSPORTATION

3/27/14

DATE

DESIGNED BY	DATE
DRAWN BY	
CHECKED BY	
NOTED BY	
QUANTITIES BY	
CHECKED BY	

Parsons Brinckerhoff, Inc.

DESIGNED BY

HWY-K

MANAGED BY

(808) 241-3000

MARCH 2014

DATE

PHONE