



| FED. ROAD DIST. NO. | STATE | FEDERAL AID PROJ. NO. | FISCAL YEAR | SHEET NO. | TOTAL SHEETS |
|---------------------|-------|-----------------------|-------------|-----------|--------------|
| HAWAII | HAW. | STP-050-K039 | 2014 | 9 | 56 |

NOTES:

1. Areas of weakened pavement reconstruction (severe distress) shall be constructed prior to cold planing and laying of final HMA surface course to provide smooth and consistent finish. Assumes 4" HMA Mix No. IV will be used to the existing surface as a temporary condition until 1 1/2" cold planing and the final 1 1/2" HMA Mix No. V is placed.
- ~~2. Areas of weakened pavement reconstruction (moderate distress) shall be constructed after cold planing and prior to laying of final HMA surface to provide a smooth and consistent finish.~~
3. For reconstruction of weakened pavement, if excavation exposes subbase layer, recompact top of existing subbase until it is visually firm and unyielding. The Engineer shall determine acceptance. Payment shall be incidental to the various paving items.

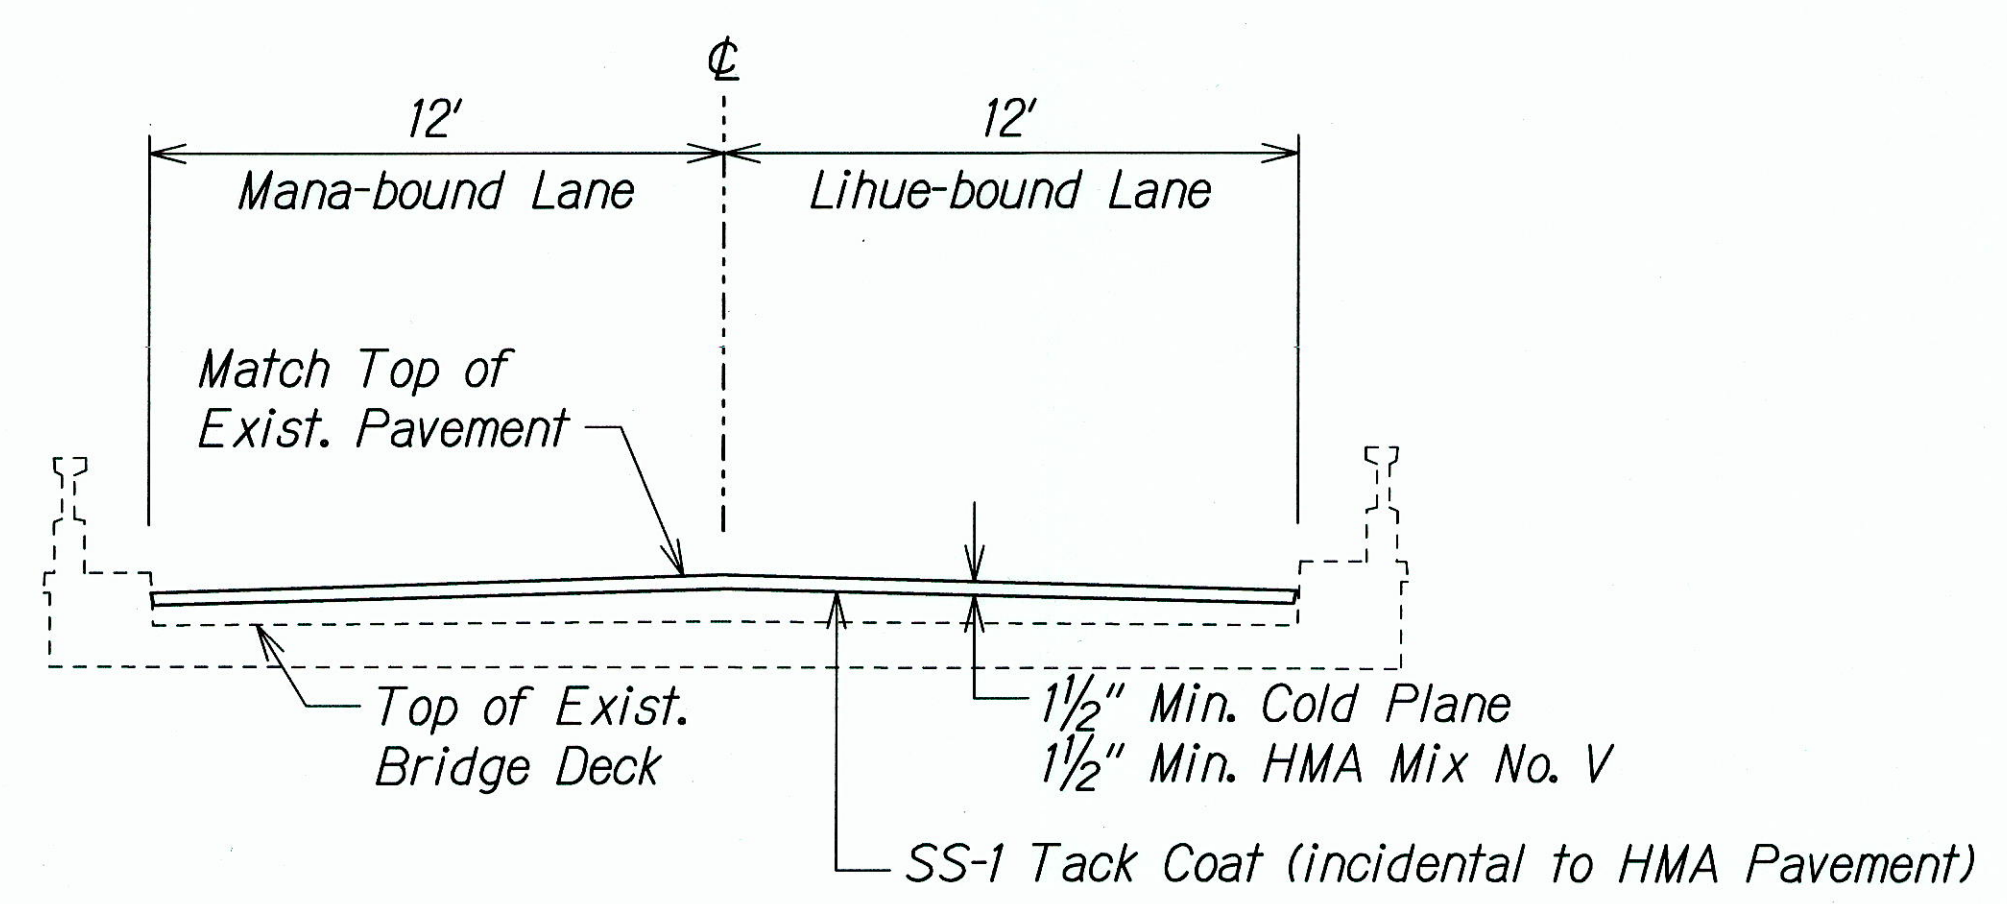

TYPICAL SECTION AT BRIDGES
Not to Scale

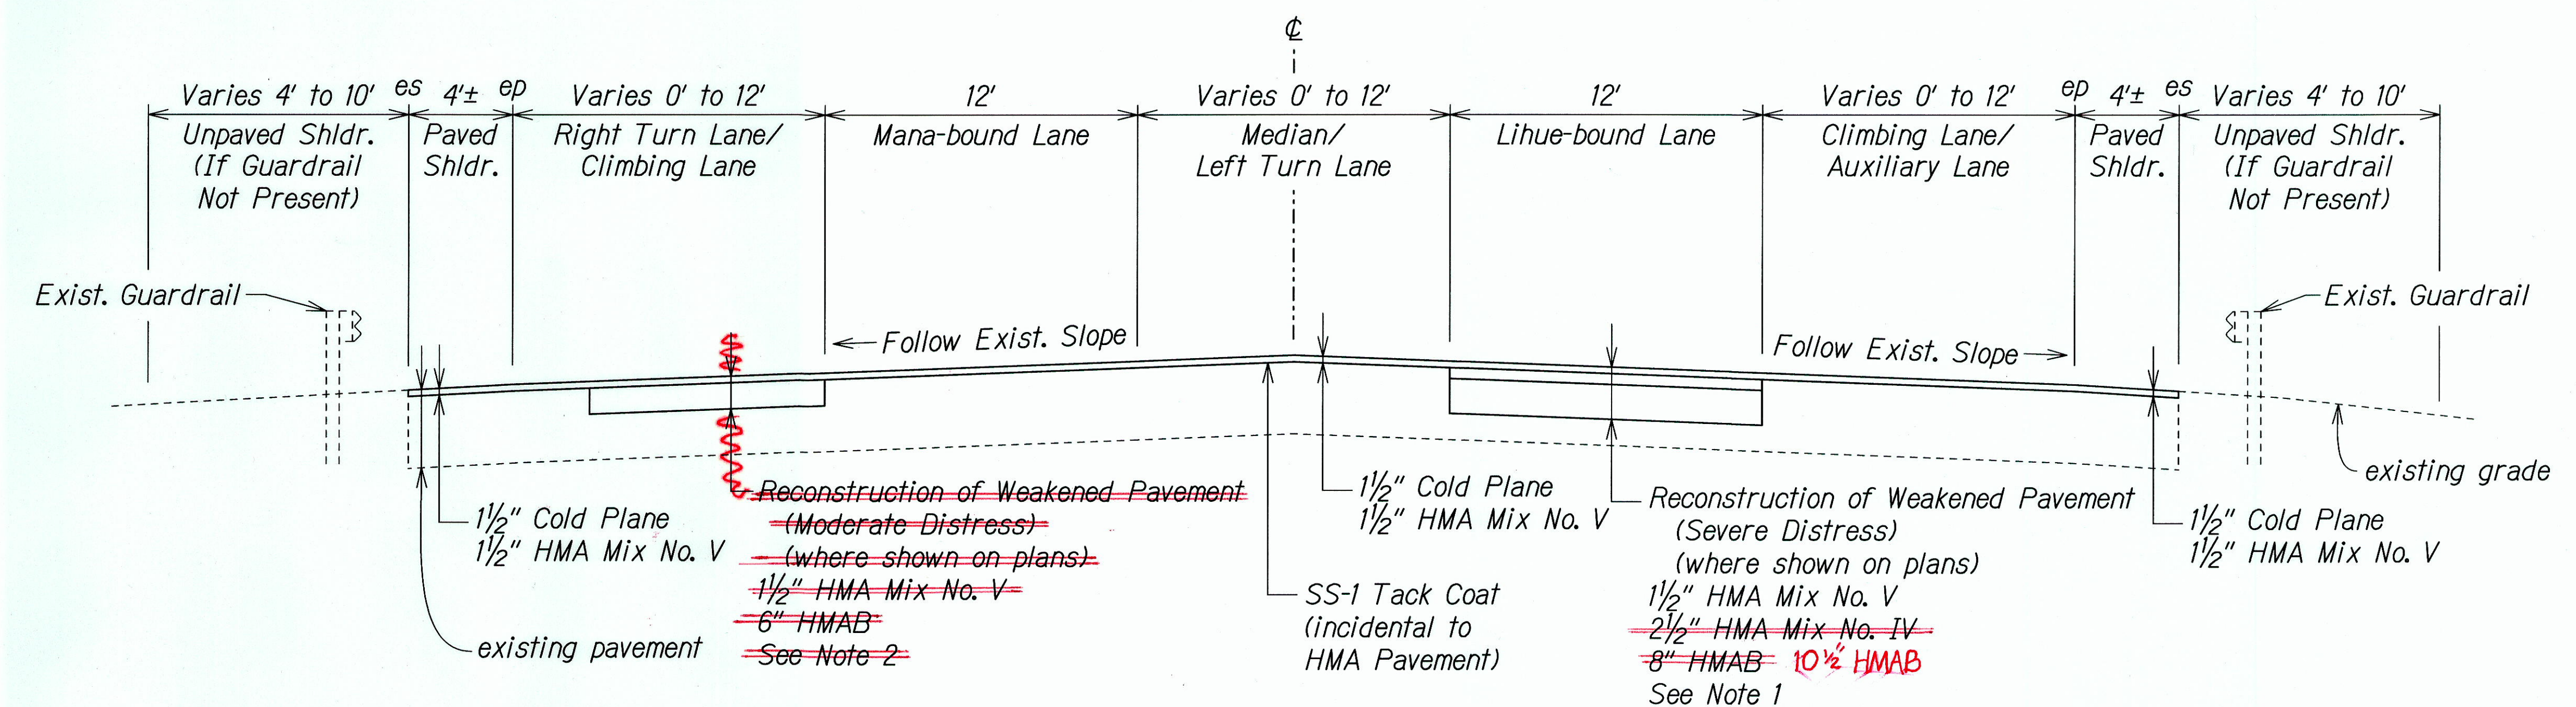

TYPICAL SECTION
Not to Scale

| | | |
|---------------|-------------------|------|
| ORIGINAL PLAN | SURVEY PLOTTED BY | DATE |
| TRACED BY | DRAWN BY | |
| NOTED BY | CHECKED BY | |
| Nr. | | |

T:\164594_PPM\Kaunualii_PPM\Cadd\Sheets\Phase 1\typsect.dgn

THIS WORK WAS PREPARED BY ME OR UNDER MY SUPERVISION.
SIGNATURE: *R. Urashy* EXPIRATION DATE OF THE LICENSE: 04/30/16

STATE OF HAWAII
DEPARTMENT OF TRANSPORTATION
HIGHWAYS DIVISION

TYPICAL SECTIONS

KAUNUALII HIGHWAY PAVEMENT PREVENTATIVE MAINTENANCE
PHASE 1 - KOLOA ROAD TO THE VICINITY OF HULEIA BRIDGE
Federal Aid Project No. STP-050-K039
Scale: Not to Scale Date: April 15, 2014

"AS-BUILT"