



FED. ROAD DIST. NO.	STATE	FEDERAL AID PROJ. NO.	FISCAL YEAR	SHEET NO.	TOTAL SHEETS
HAWAII	HAW.	STP-050-1(041)	2014	9	63

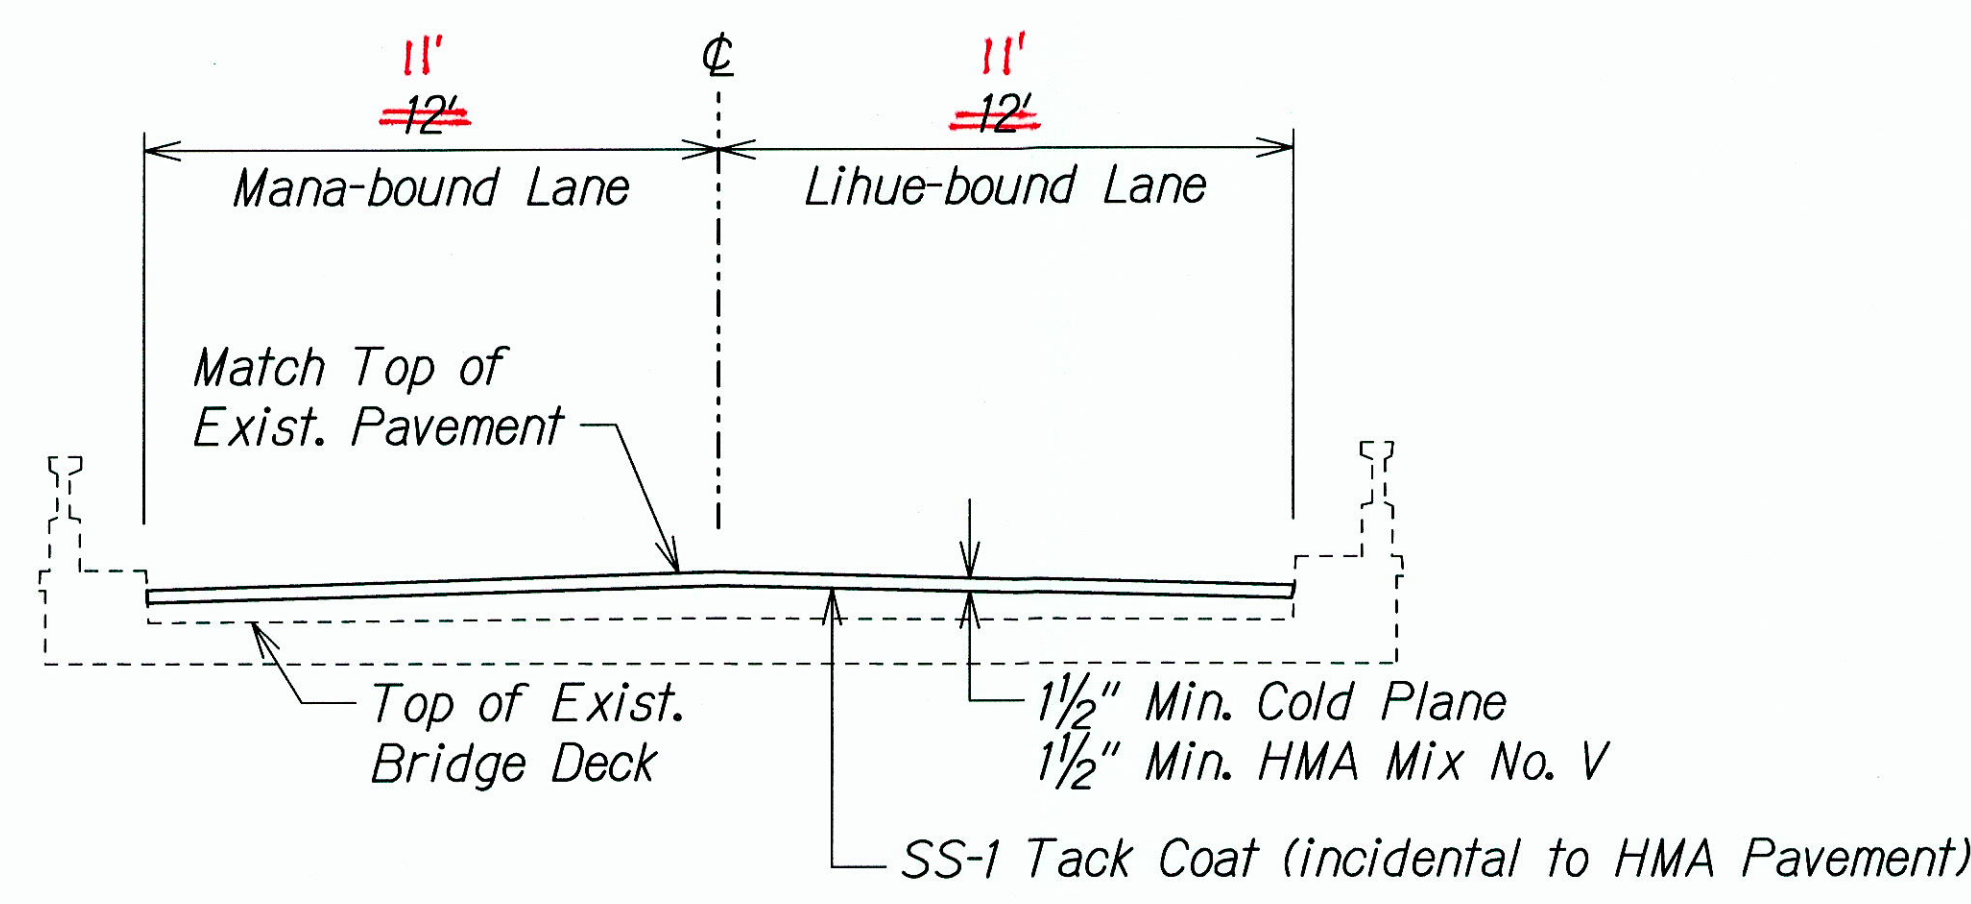

TYPICAL SECTION AT BRIDGES
Not to Scale

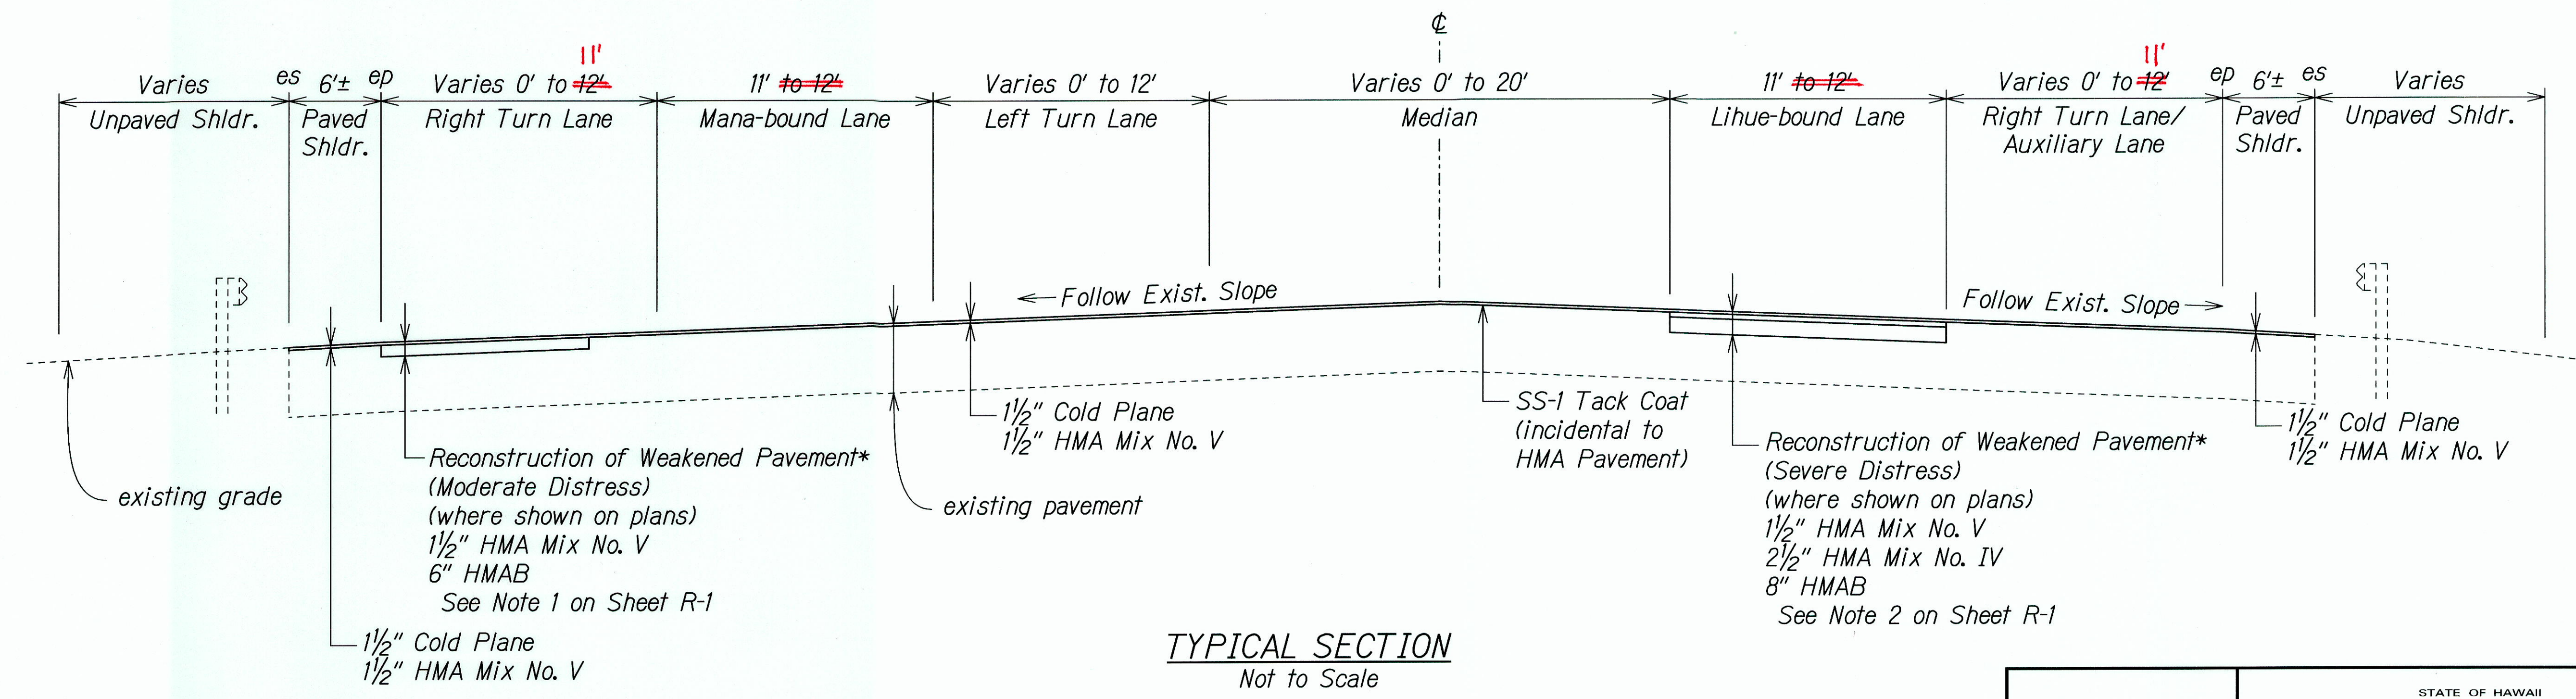

TYPICAL SECTION
Not to Scale

* If excavation exposes subbase layer, recompact top of existing subbase until it is visually firm and unyielding. The Engineer shall determine acceptance. Payment shall be incidental to the various paving items.

ORIGINAL PLAN	SURVEY PLOTTED BY	DATE
NOTE BOOK	DRAWN BY	
	CHECKED BY	
	CHECKED BY	

T:\16459A_PPM\Kaunualii_PPM\Cadd\Sheets\Phase I\typsect.dgn

THIS WORK WAS PREPARED BY ME OR UNDER MY SUPERVISION.

SIGNATURE: *Pamela K. Uyeda* EXPIRATION DATE: 04/30/16

STATE OF HAWAII
DEPARTMENT OF TRANSPORTATION
HIGHWAYS DIVISION

TYPICAL SECTIONS

KAUNUALII HIGHWAY PAVEMENT PREVENTATIVE MAINTENANCE
PHASE III - VICINITY OF MANA TO WAIHEA CANYON DRIVE
Federal Aid Project No. STP-050-1(041)
Scale: Not to Scale Date: Aug. 28, 2014