


FED. ROAD DIST. NO.	STATE	PROJ. NO.	FISCAL YEAR	SHEET NO.	TOTAL SHEETS
HAWAII	HAW.	50C-01-15M	2017	10	24

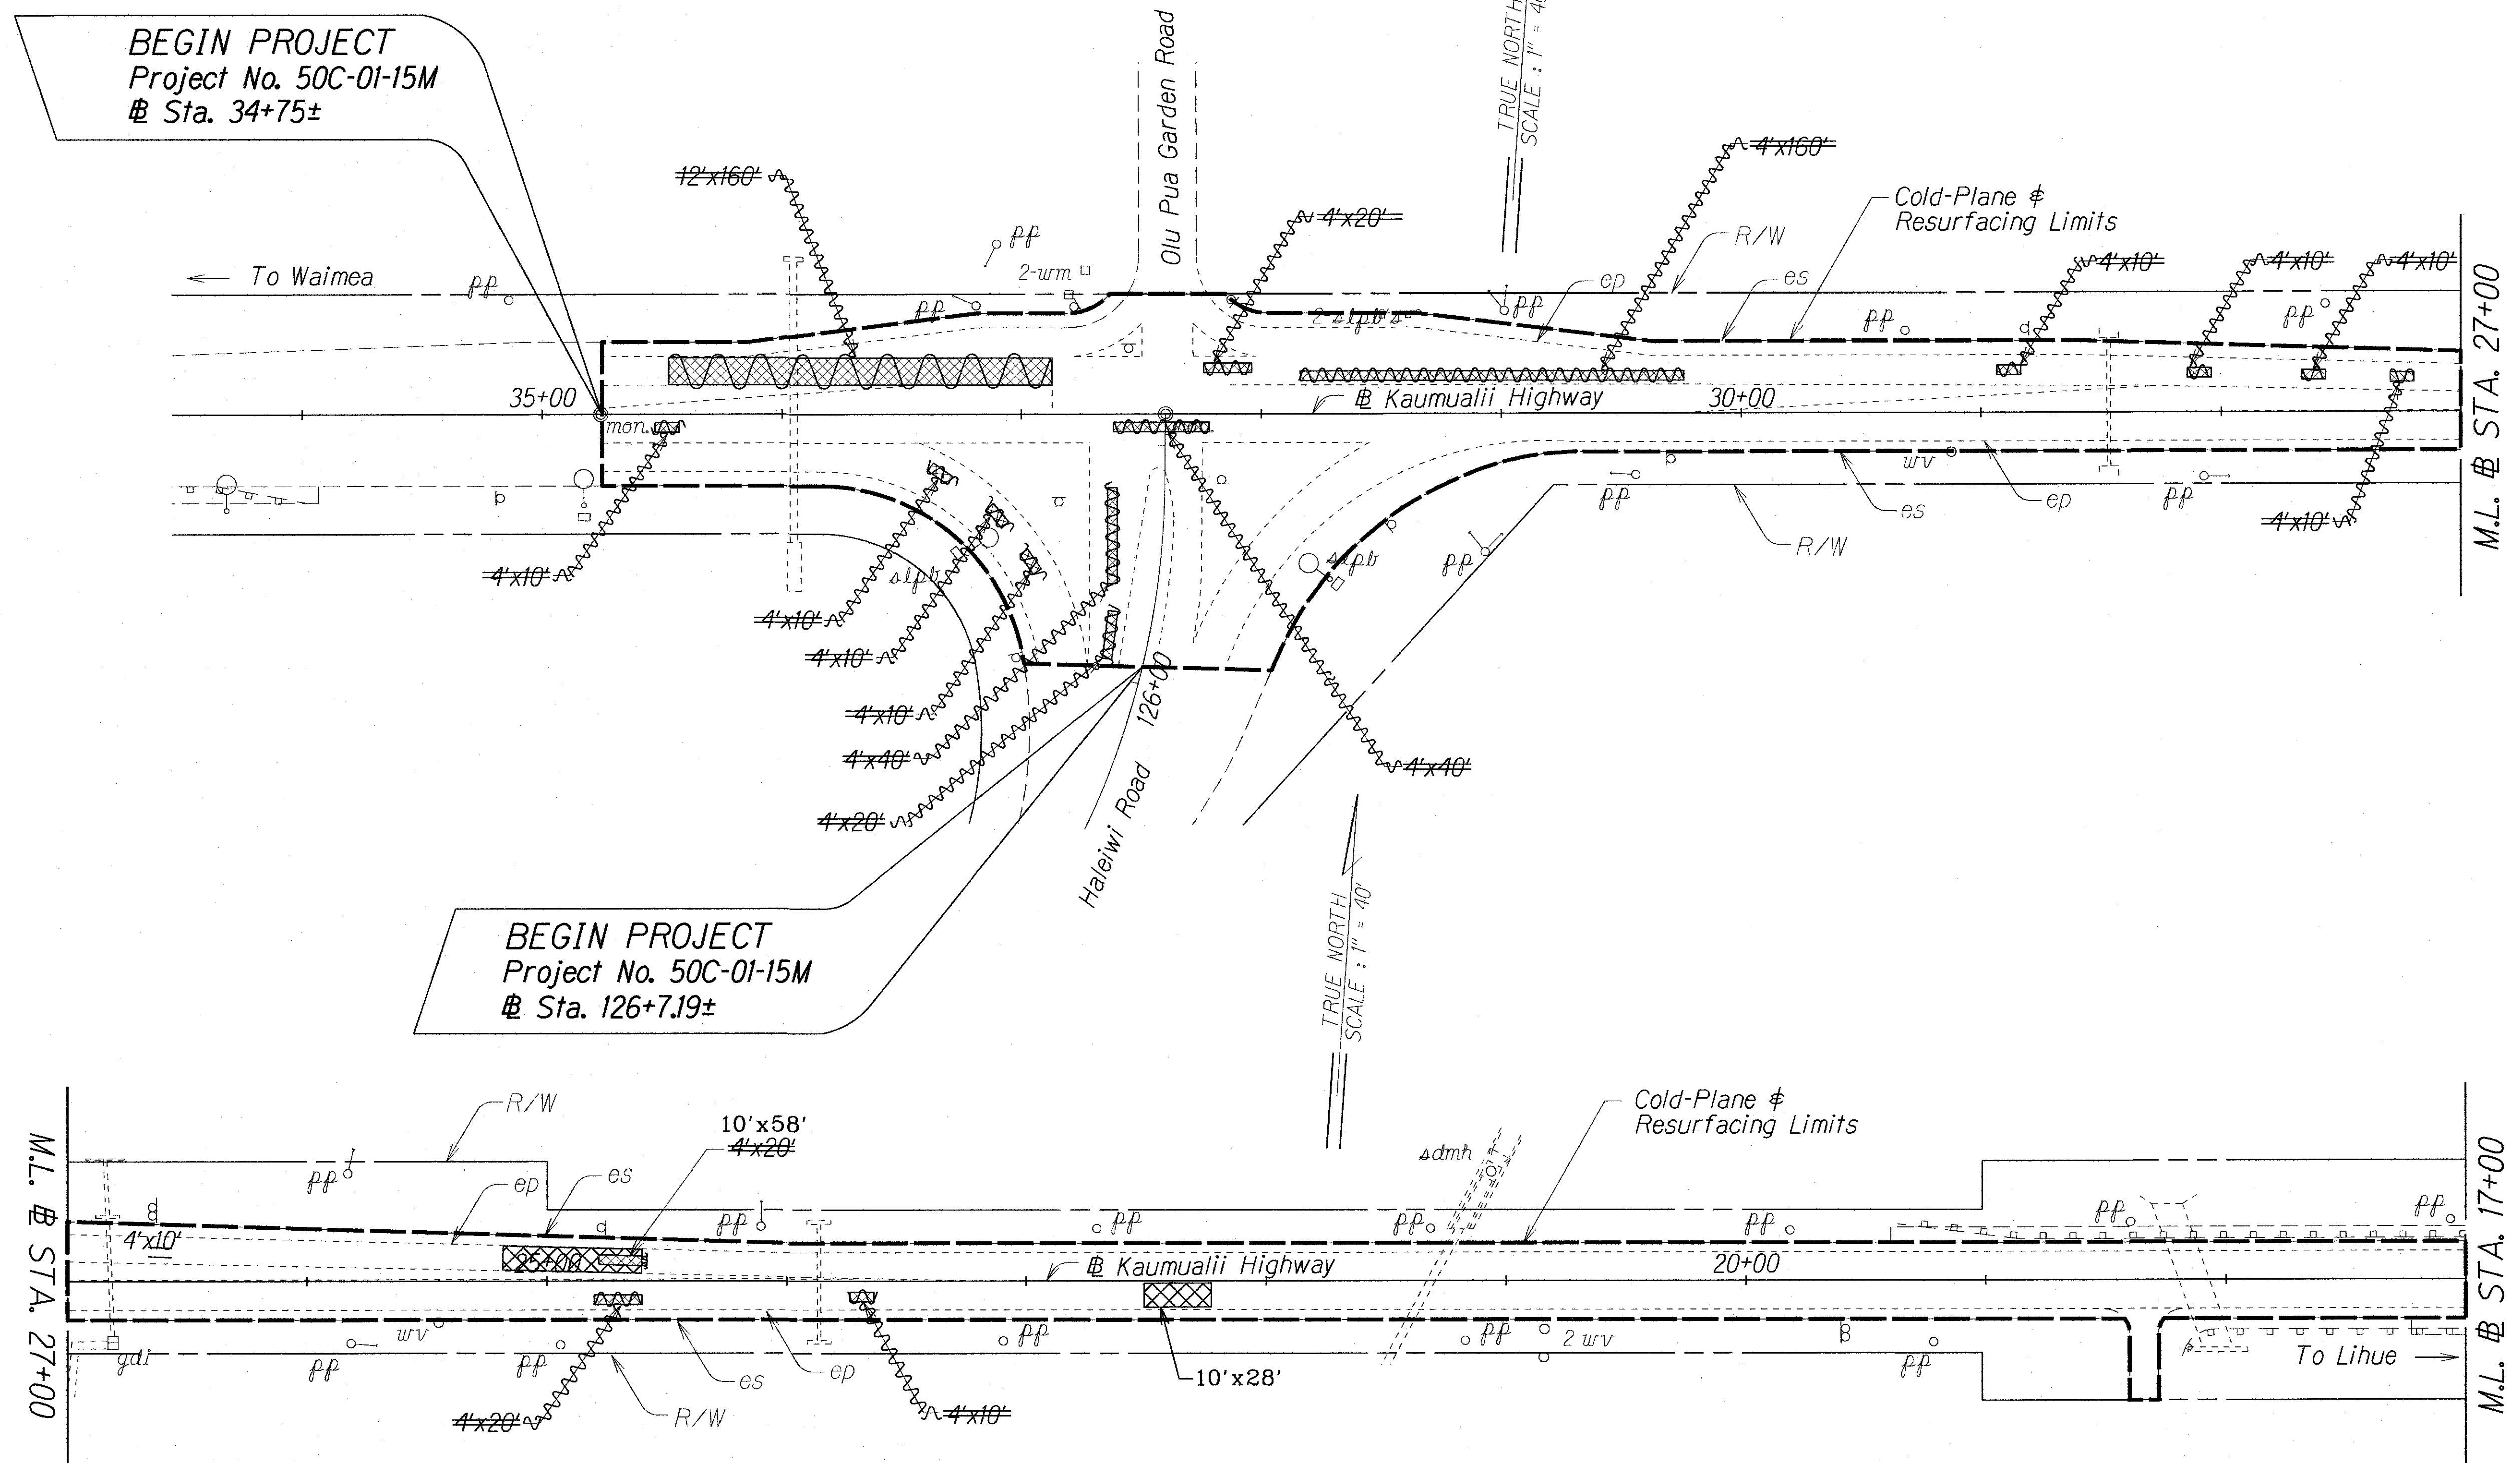

ORIGINAL PLAN	SURVEY PLOTTED BY	DATE
DRAWN BY		
NOTED BY		
CHECKED BY		

- Reconstruction Areas
- State IV

LEGEND FOR AS-BUILT POSTINGS	
	Squiggly line for as-built deletion
	Double line for as-built deletion
Roadway	Text for as-built posting

STATE OF HAWAII
DEPARTMENT OF TRANSPORTATION
HIGHWAYS DIVISION

ROADWAY PLAN

KAUMUALII HIGHWAY RESURFACING



Koloa Road to Haleiwi Road
Project No. 50C-01-15M

Scale: 1" = 40' Date: July 2016

SHEET No. 1 OF 6 SHEETS

"AS-BUILT"

FED. ROAD DIST. NO.	STATE	PROJ. NO.	FISCAL YEAR	SHEET NO.	TOTAL SHEETS
HAWAII	HAW.	50C-01-15M	2017	12	24

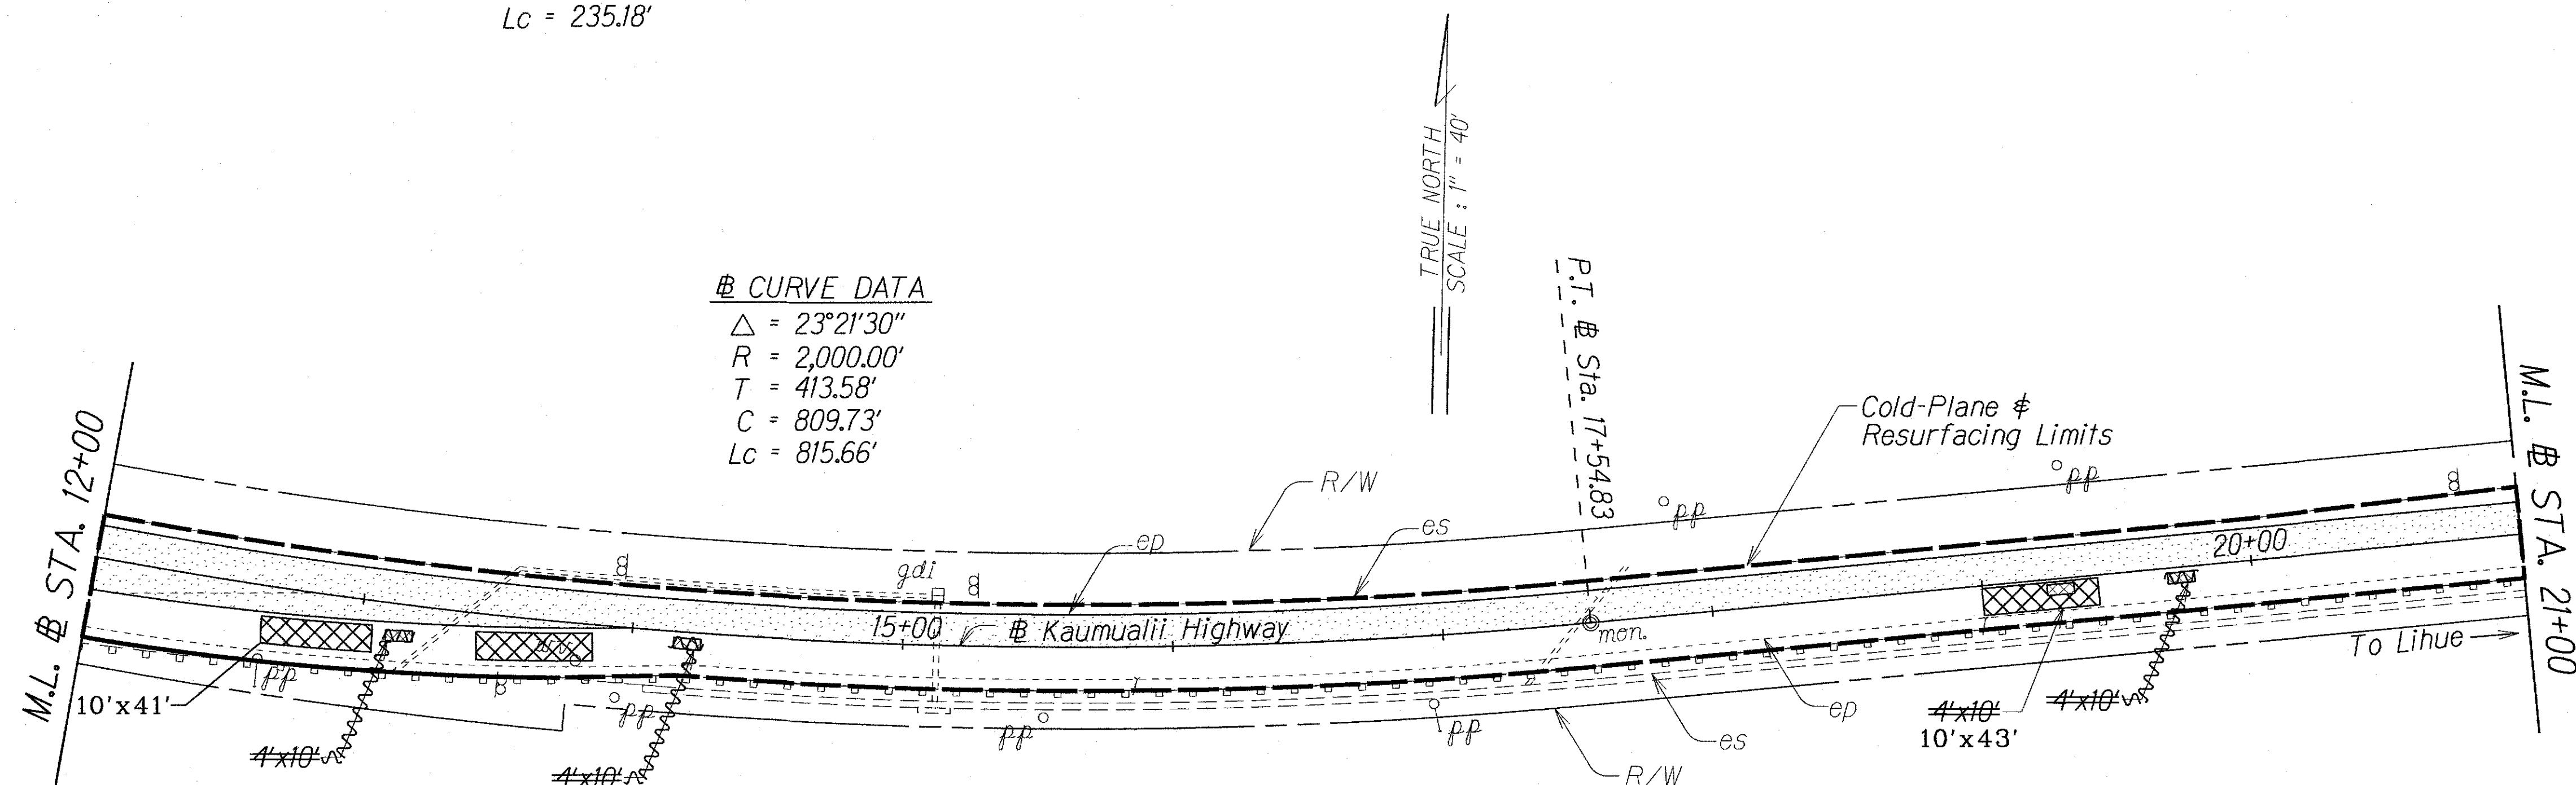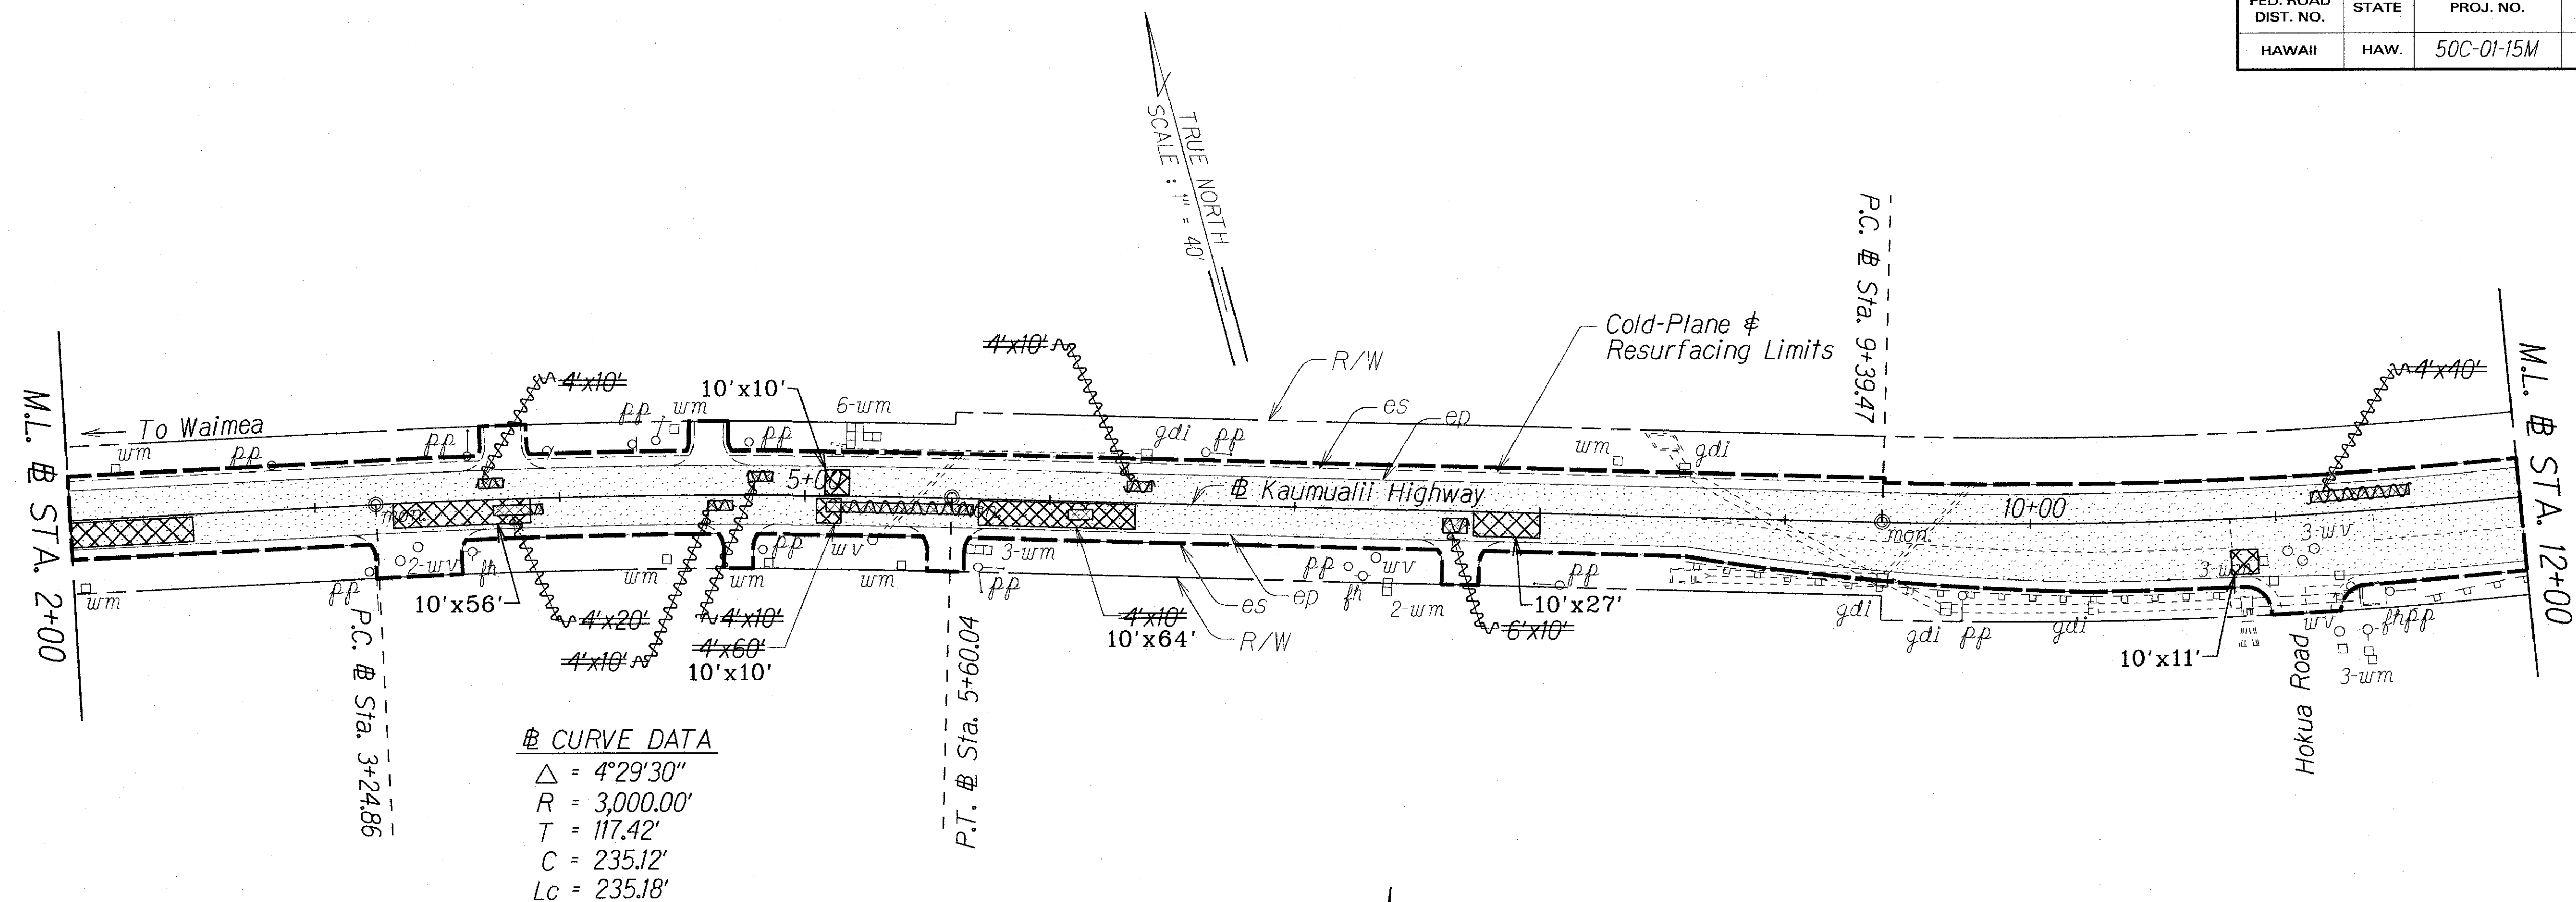

DATE	_____
SURVEY OBTAINED BY	_____
DRAWN BY	_____
DESIGNED BY	_____
CHECKED BY	_____
NOTED BY	_____
DATE	_____

LEGEND FOR AS-BUILT POSTINGS	
	Squiggly line for as-built deletion
	Double line for as-built deletion
Roadway	Text for as-built posting

	Reconstruction Areas
	State IV

LEGEND FOR AS-BUILT POSTINGS	
	Squiggly line for as-built deletion
	Double line for as-built deletion
Roadway	Text for as-built posting

STATE OF HAWAII
DEPARTMENT OF TRANSPORTATION
HIGHWAYS DIVISION

ROADWAY PLAN

KAUMUALII HIGHWAY RESURFACING

Koloa Road to Halewili Road


Project No. 50C-01-15M

Scale: 1" = 40' Date: July 2016

SHEET No. 3 OF 6 SHEETS

"AS-BUILT"

FED. ROAD DIST. NO.	STATE	PROJ. NO.	FISCAL YEAR	SHEET NO.	TOTAL SHEETS
HAWAII	HAW.	50C-01-15M	2017	13	24

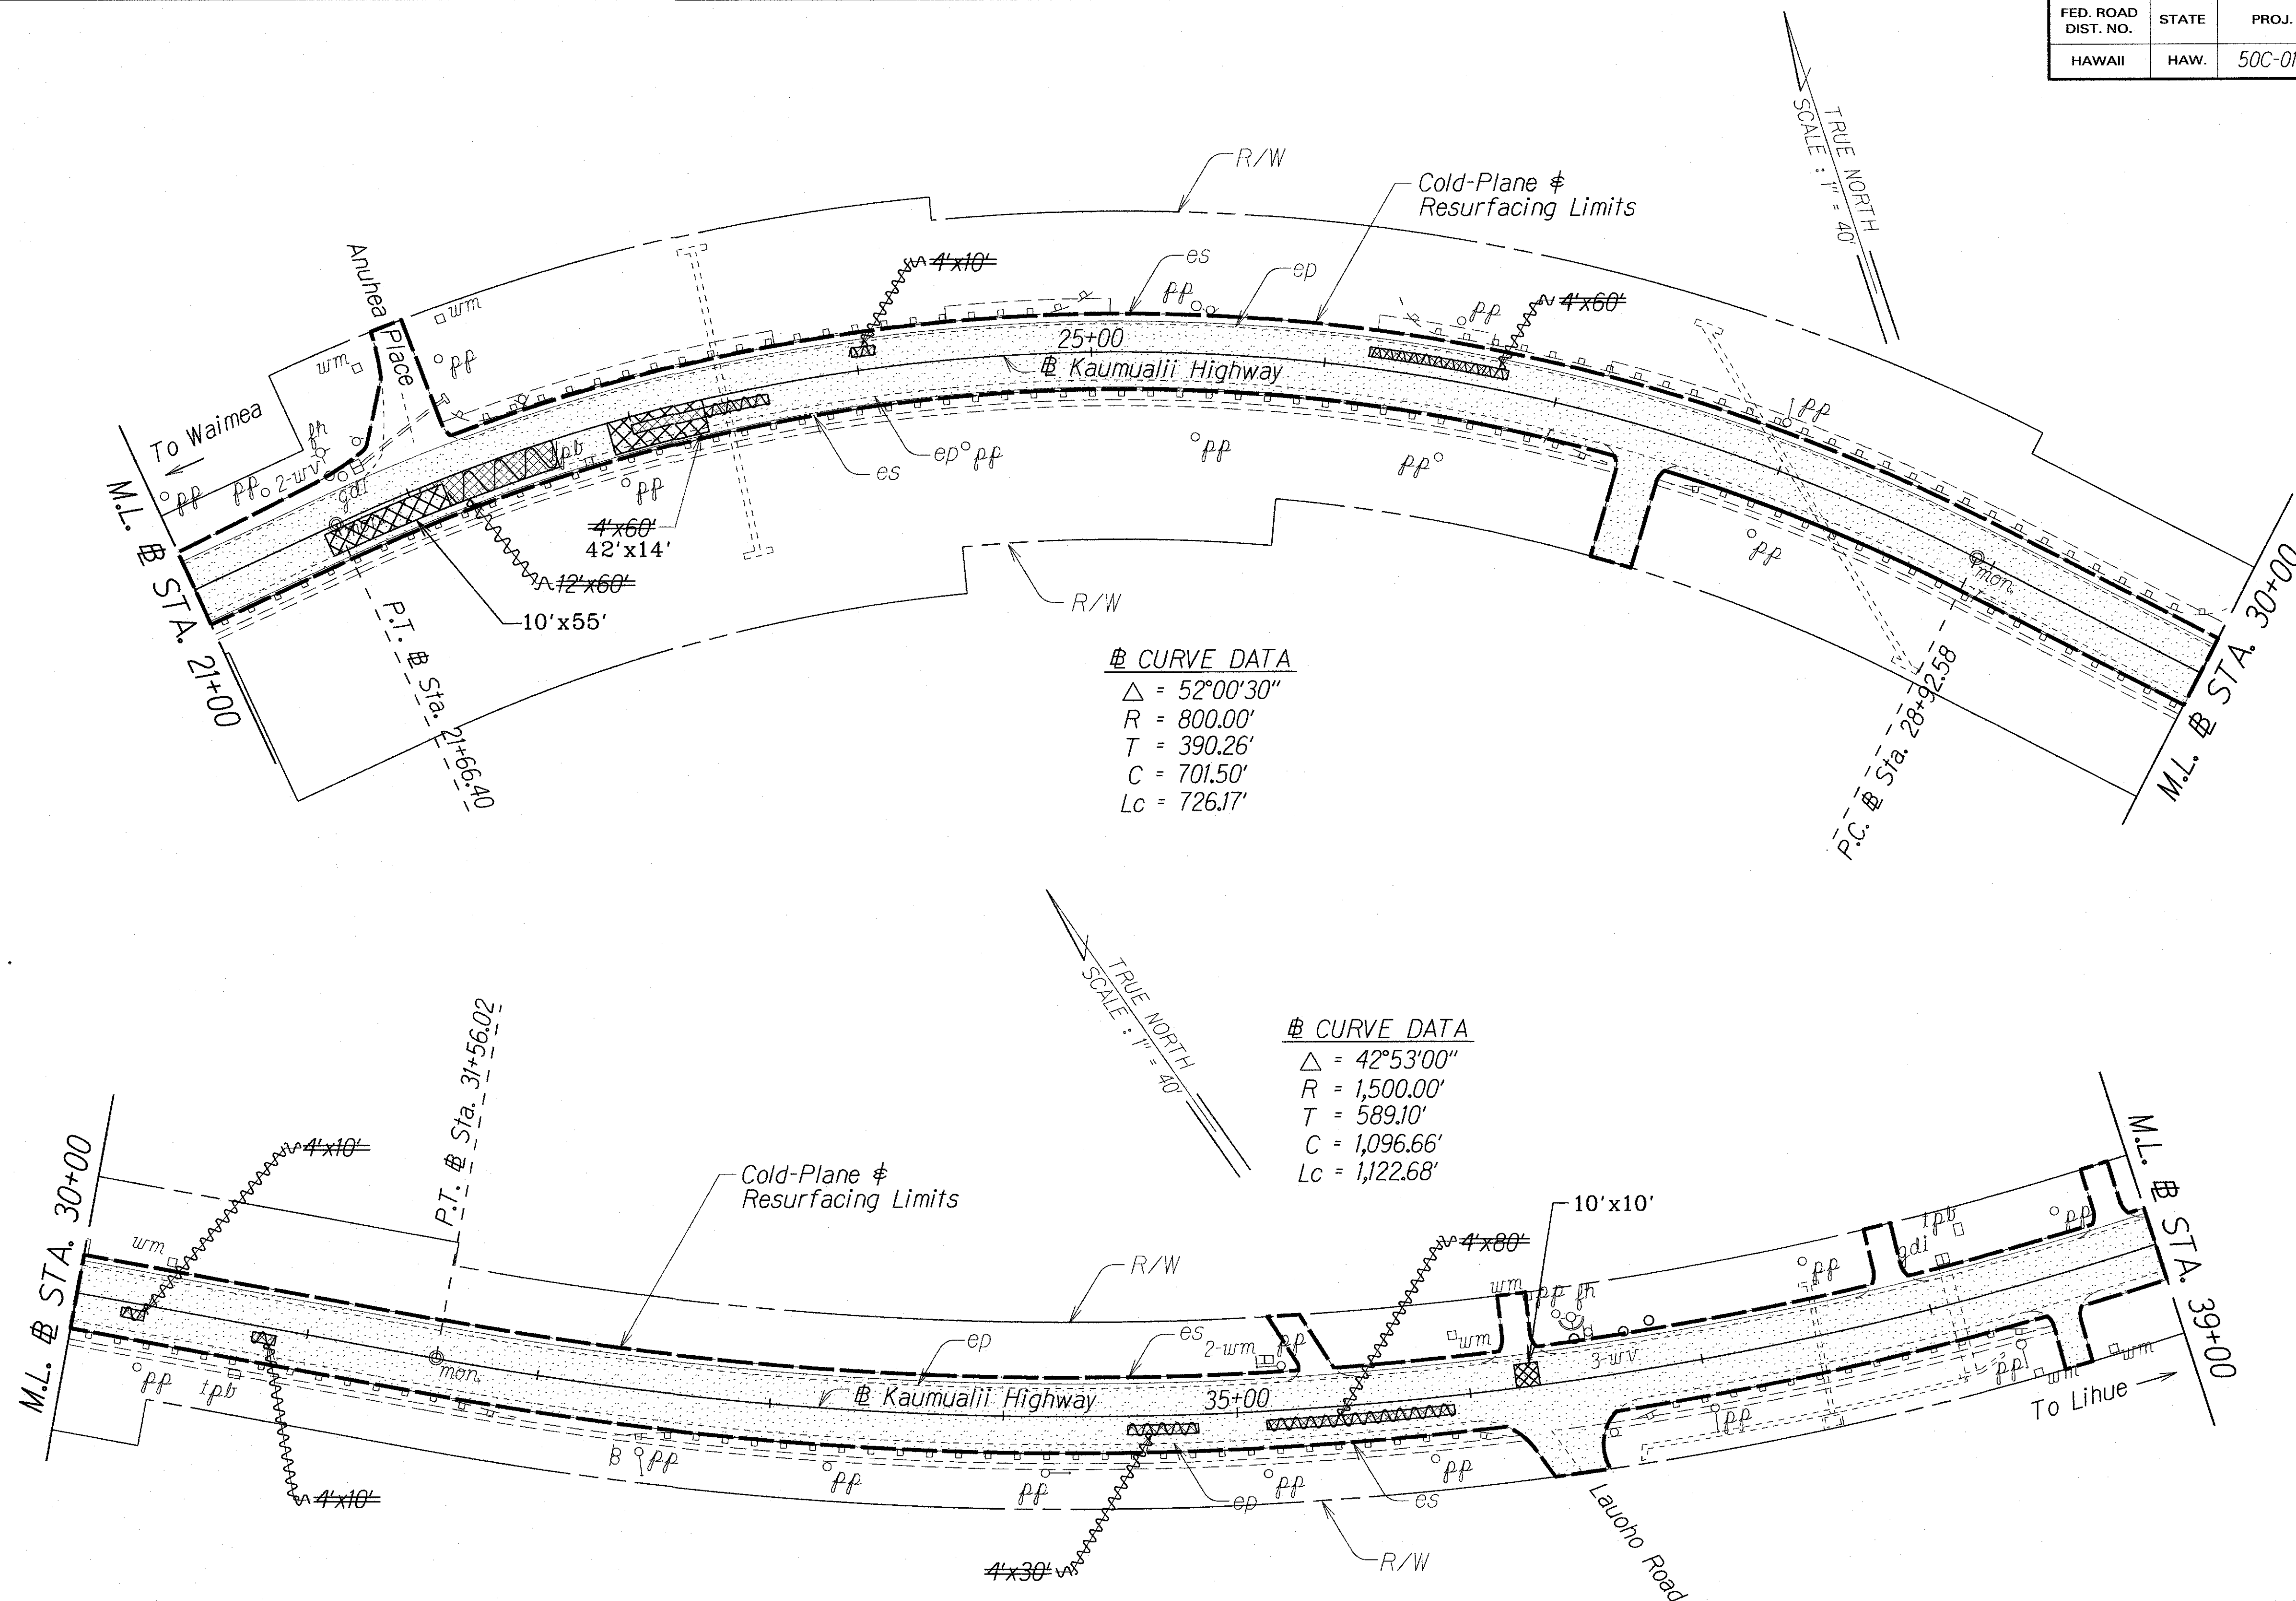

ORIGINAL PLAN	SURVEY PLOTTED BY	DATE
NOTE BOOK	DRAWN BY	
DESIGNED BY		
CHECKED BY		

	Reconstruction Areas
	State IV

LEGEND FOR AS-BUILT POSTINGS	
	Squiggly line for as-built deletion
	Double line for as-built deletion
Roadway	Text for as-built posting

STATE OF HAWAII
DEPARTMENT OF TRANSPORTATION
HIGHWAYS DIVISION

ROADWAY PLAN

KAUMUALII HIGHWAY RESURFACING

Koloa Road to Halewili Road



Project No. 50C-01-15M

Scale: 1" = 40' Date: July 2016

SHEET No. 4 OF 6 SHEETS

"AS-BUILT"

FED. ROAD DIST. NO.	STATE	PROJ. NO.	FISCAL YEAR	SHEET NO.	TOTAL SHEETS
HAWAII	HAW.	50C-01-15M	2017	14	24

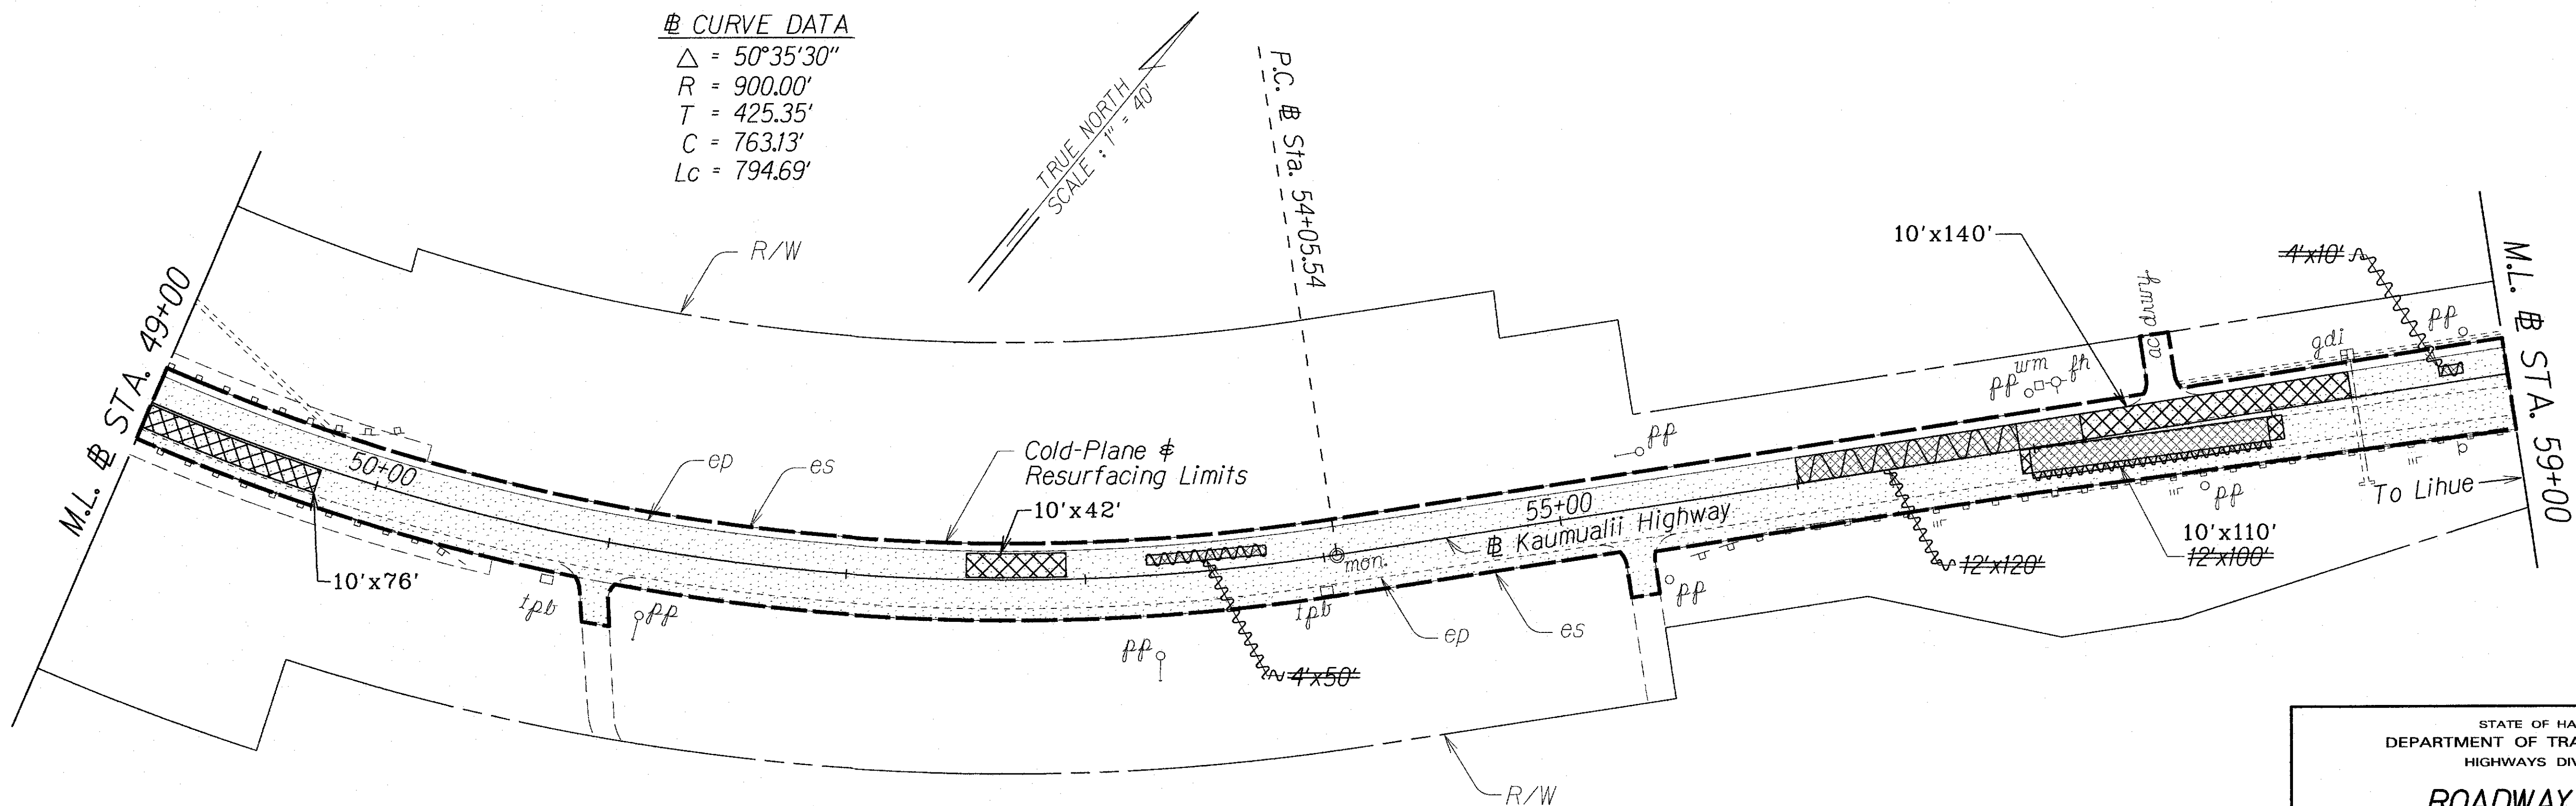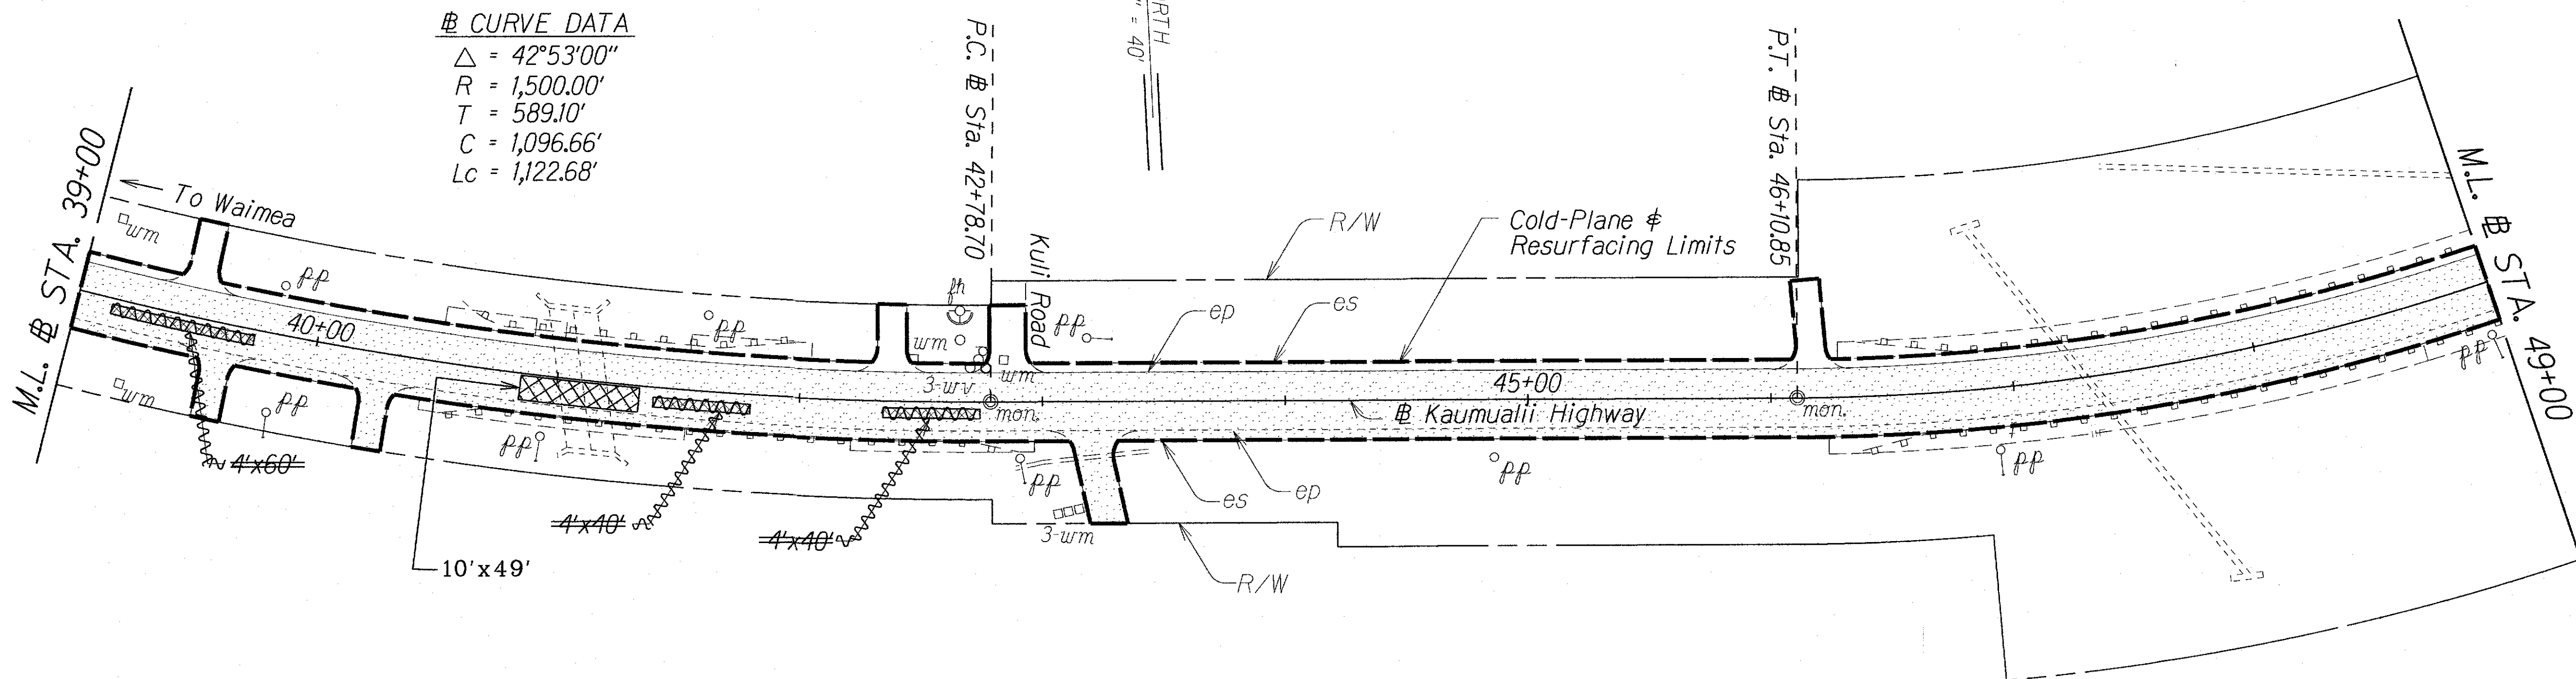

DATE	_____
SURVEY BY	_____
PLAN	_____
DESIGNED BY	_____
QUANTITIES BY	_____
CHECKED BY	_____

- Reconstruction Areas
- State IV

LEGEND FOR AS-BUILT POSTINGS	
	Squiggly line for as-built deletion
	Double line for as-built deletion
Roadway	Text for as-built posting

STATE OF HAWAII
DEPARTMENT OF TRANSPORTATION
HIGHWAYS DIVISION

ROADWAY PLAN
KAUMUALII HIGHWAY RESURFACING
Koloa Road to Halewili Road
Project No. 50C-01-15M

Scale: 1" = 40' Date: July 2016

SHEET No. 5 OF 6 SHEETS

"AS-BUILT"

