

ROAD SIGN SUMMARY

FED. ROAD DIST. NO.	STATE	PROJ. NO.	FISCAL YEAR	SHEET NO.	TOTAL SHEETS
HAWAII	HAW.	HWY-K-01-91M	1991	11	11

REGULATORY SIGNS:

Sign No.	Description	Note	Omao	Kalaheo	Halewili	Summary
R1-1	Stop				5	5
R2-1 (25)	Speed Limit(25 mph)			1	1	2
R2-1 (35)	Speed Limit(35 mph)			2	4	6
R2-1 (50)	Speed Limit(50 mph)		1	1	4	6
R2-5B (25)	Reduce Speed(25 mph)			1	1	2
R2-5B(35)	Reduce Speed 35(mph)			1	3	4
R3-2	No Left Turn(w/pictorial)				1	1
R4-1	Do Not Pass		1	3		4
R4-2	Pass With Care			2		2
R4-3	Slow Traffic Keep Right		1	1		2
R4-6 (500)	Truck Lane 500 Feet			1		1
R4-7	Keep Right(Pictorial)				1	1
R10-7	Do Not Block Intersection			1		1
TOTAL REGULATORY SIGNS			3	14	20	37

WARNING SIGNS

<u>Sign No.</u>	<u>Description</u>	<u>Omao</u>	<u>Kalaheo</u>	<u>Halewili</u>	<u>Summary</u>
W1-4(L)	Curve Ahead (pictorial- left)		2		2
W1-7	<-->(pictorial- bothways)		1		1
W2-3(L)	Intersection (pictorial)		2		2
W3-1a	Stop Ahead (pictorial)			2	2
W4-2R	Lane Ends (pictorial)	1	1		2
CW23-1	Truck Crossing			2	2
W9-2 (L)	Lane Ends - Merge Left	1	1		2
51-1	School Ahead (pictorial)		1		1
52-1	School Xing (pictorial)		2		2
-	Falling Rocks	—	2	—	2
TOTAL WARNING SIGNS		2	12	4	18



DESTINATION SIGNS

Sign No.	Description	Note	Omao	Kalaheo	Halewili	Summary
D10-1(6)	Mile 0	(1)			1	1
D10-1(1)	Mile 1	(1)			1	1
D10-1(2)	Mile 2	(1)			1	1
D10-1(3)	Mile 3	(1)			1	1
D10-1(7)	Mile 7	(1)	1			1
D10-1(8)	Mile 8	(1)	1			1
D10-2(12)	Mile 12	(1)		1		1
D10-2(13)	Mile 13	(1)		1		1
D10-1a(3.95)	Mile 3.95	(1)			1	1
D10-7(50)	HWY 50	(1)	2	2		4
D10-540	HWY 540	(1)			5	5
TOTAL DESTINATION SIGNS			4	4	10	18


AUXILIARY SIGNS

Sign No.	Description	Note	Omao	Kalaheo	Halewili	Summary
M1-6 (50)	HWY 50			2	4	6
M1-6 (540)	HWY 540			4		4
M2-1	JCT			2	2	4
M3-2	EAST			1		1
M6-1	Arrow (right)			1		1
M6-2(L)	Arrow (left)			1		1
M6-3	Arrow(up)			1		1
M6-4	Arrow(left & right)				2	2
-	"UNLAWFUL TO LITTER (2) \$1000 FINE"			1		1
TOTAL AUXILIARY SIGNS			0	13	8	21

Notes: All signs without post(s), unless otherwise noted.
(1) Two (2) panels per sign(set)
(2) Measurement and Payment shall be under Item No. 621.5010 (Regulatory & Warning Sign).

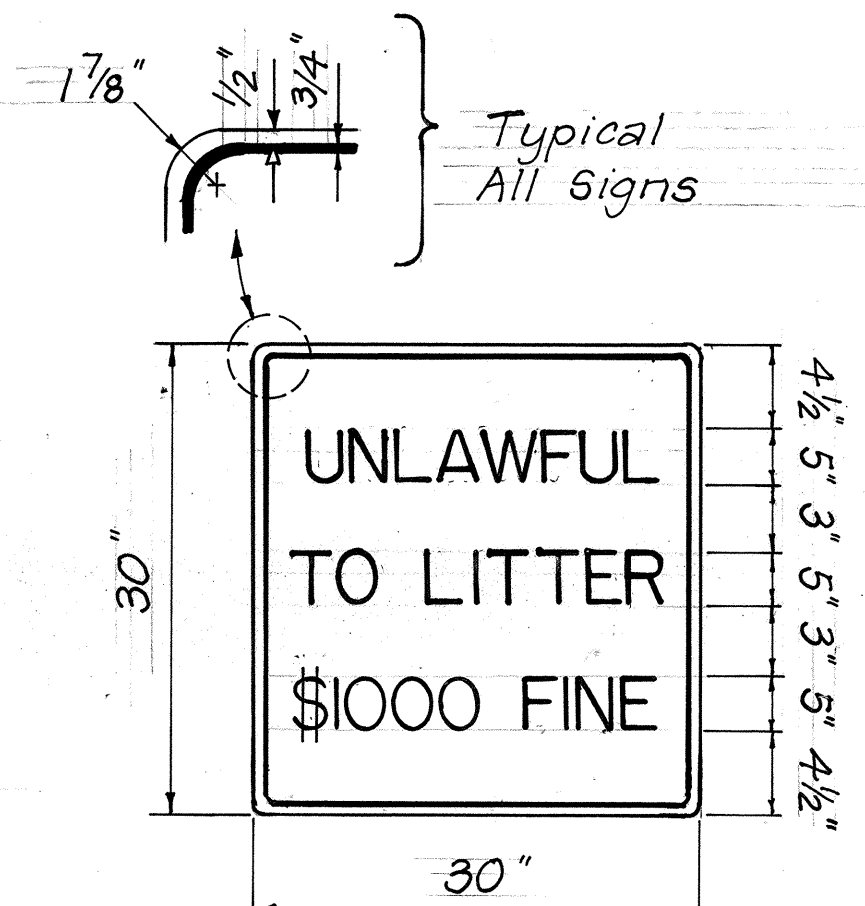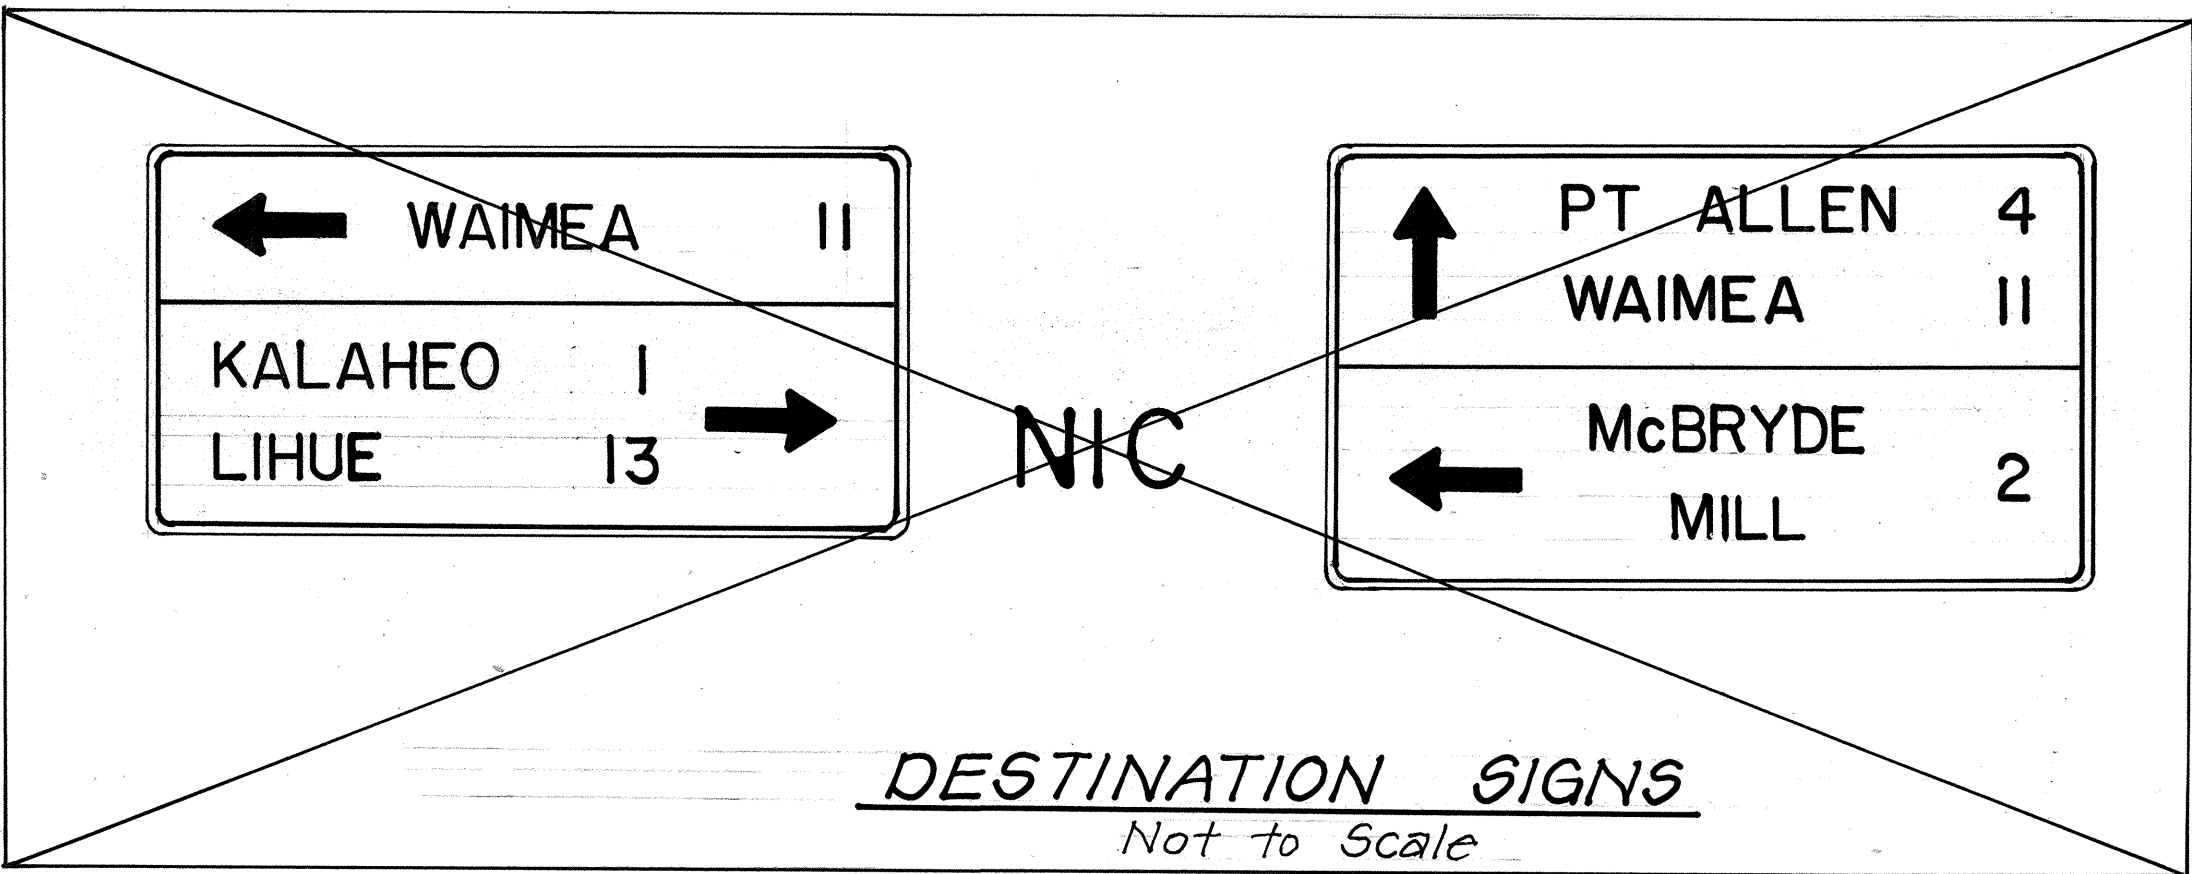


Colors
Legend - Black(Non-Ref.)
Background-White(Ref.)

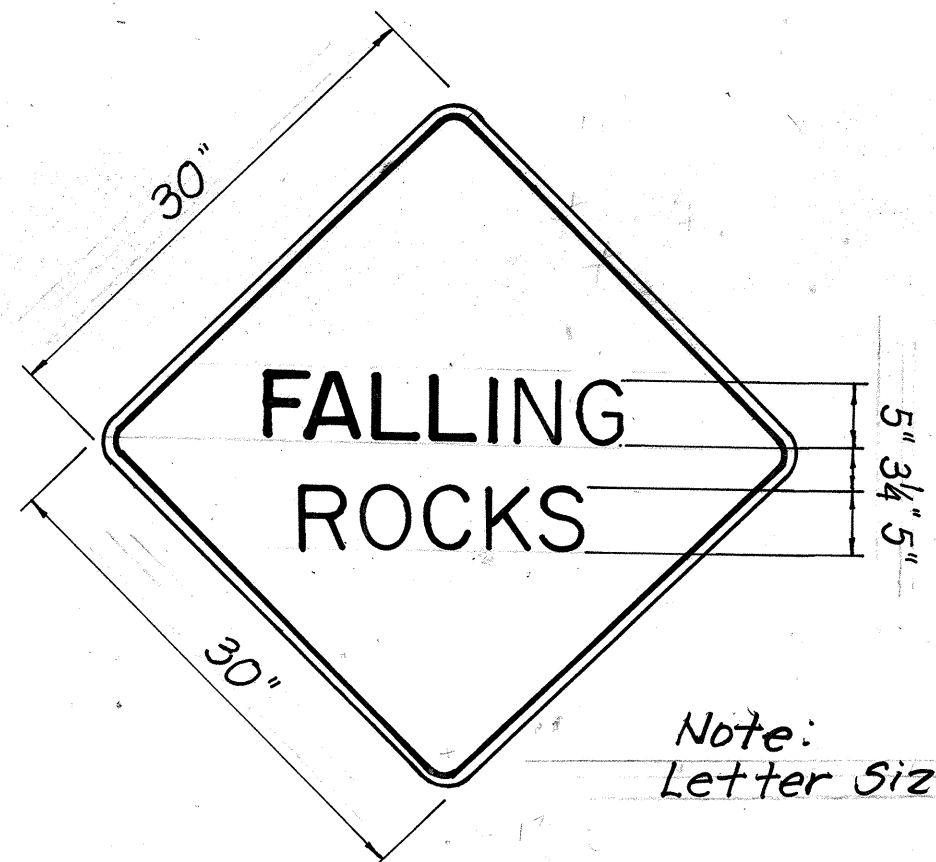

Colors
Legend - Black(Non-Ref.)
Background - Yellow(Ref.)

WARNING SIGN
Not to Scale

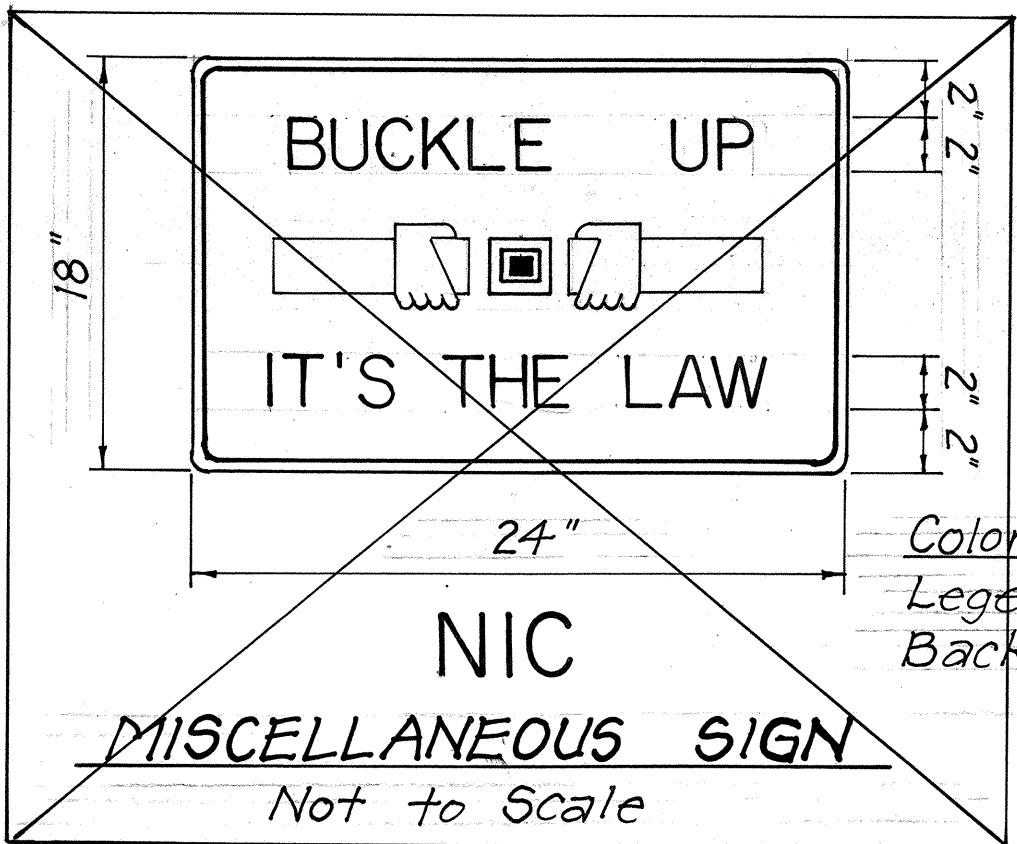

Colors
Legend - Black(Non-Ref.)
Background - White(Ref.)

MISCELLANEOUS SIGN
Not to Scale

STATE OF HAWAII
DEPARTMENT OF TRANSPORTATION
HIGHWAYS DIVISION

SIGN SUMMARIES & DETAILS
KAUMUALII HWY./HALEWILI RD.
RESURFACING
PROJ. NO. HWY-K-01-91M

SCALE: AS NOTED DATE: SEP. 1990
SHEET No. 1 OF 1 SHEETS

DATE	
SURVEY PLOTTED BY	
PLAN	
DRAWN BY	
DESIGNED BY	
QUANTITIES BY	
CHECKED BY	
NO.	