


GENERAL NOTES:

- 1 - The scope of work for this project consists of Fog Sealing the Kaumualii Hwy. travelways between Mahaikona Bridge to Lele Road.
- 2 - The Contractor's attention is directed to Subsection 107.13 - Public Convenience and Safety: Section 645- Traffic Control and Subsection 107.21- Contractor's Responsibility for Utility Property and Service of the Special Provisions.
- 3 - At the end of each day's work, the Contractor shall remove all equipment and other obstructions to permit free and safe passage of public traffic.
- 4 - The exact locations and limits or areas to be Fog Sealed shall be determined in the field by the Engineer.
- 5 - The Contractor shall notify the State in writing, two (2) weeks prior to starting paving operations.
- 6 - The Contractor shall keep at least one lane open to traffic during working hours and both lanes open during non-working hours. All lanes shall be open to traffic during peak hours from 6:00 a.m. to 8:30a.m. and 3:30 p.m. to 6:00 p.m.
- 7 - The Contractor shall be held liable for any damages incurred to the existing highway and utility facilities as the result of his operations. All damaged portions shall be repaired and or replaced in accordance with the Standard Specifications of the State and/or the affected Utility Company.

FED. ROAD DIST. NO.	STATE	FED-AID PROJ. NO.	FISCAL YEAR	SHEET NO.	TOTAL SHEETS
HAWAII	HAW.	50B-01-93M	1993	2	2

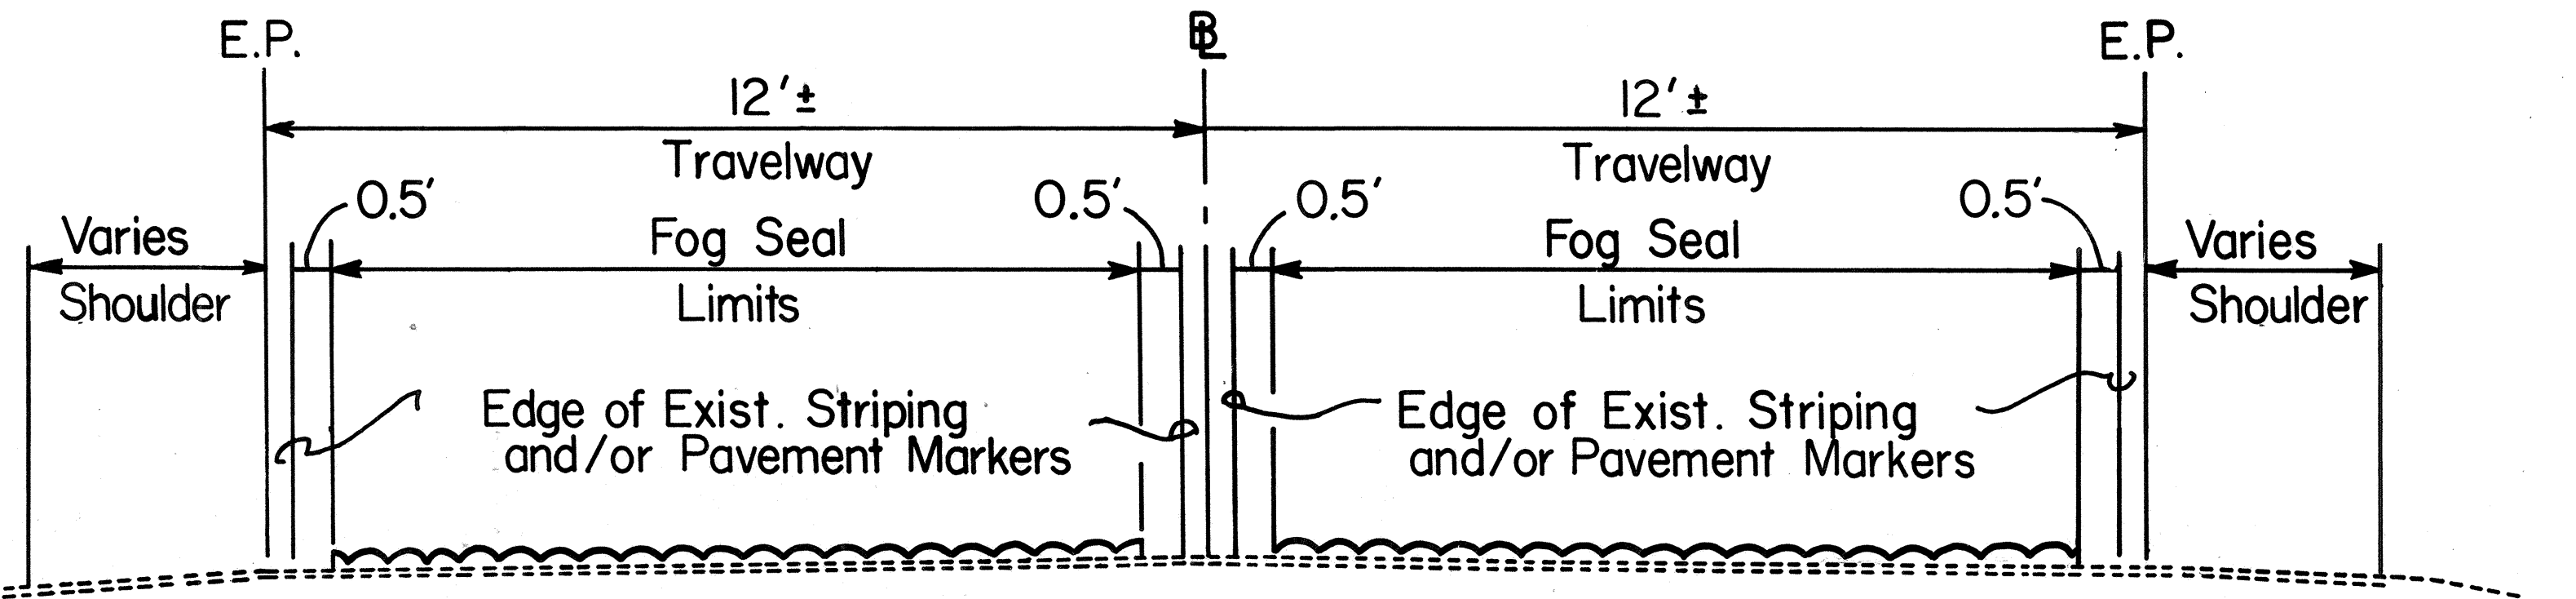

TYPICAL SECTION
Scale: 1/2" = 1'-0"

LEGEND =  Fog Seal

Estimated Quantities: 7,402
413.1000 Fog Seal on Kaumualii Highway ~~12,210~~ Gallons.

SURVEY PLOTTED BY	DATE
DRAWN BY	
DESIGNED BY	
QUANTITIES BY	
CHECKED BY	
ORIGINAL PLAN	
NOTE BOOK	
No.	

STATE OF HAWAII
DEPARTMENT OF TRANSPORTATION
HIGHWAYS DIVISION

GEN. NOTES, TYP. SECTION,
AND ESTIMATED QUANTITIES

KAUMUALII HIGHWAY FOG SEAL
MAHAIKONA BRIDGE TO LELE ROAD
PROJECT NO. 50B-02-93M

SCALE: AS SHOWN MARCH 1993
SHEET NO. 1 OF 1 SHEETS