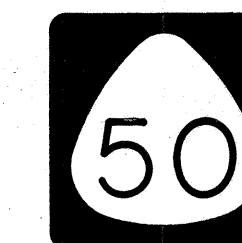



[illegible]

STATE OF HAWAII
DEPARTMENT OF TRANSPORTATION
HIGHWAYS DIVISION
HONOLULU, HAWAII
"AS-BUILT"
PLANS FOR
KAUMUALII HIGHWAY FOG SEAL
MAHAIKONA BRIDGE TO LELE ROAD
PROJECT NO. 50B-02-93M
DISTRICT OF WAIMEA
ISLAND OF KAUAI

 FEDERAL AID PROJECTS PREVIOUSLY CONSTRUCTED
OR UNDER CONSTRUCTION

MILE POST 21.36 TO MILE POST 17.03

Donyl H. Maeda
RESIDENT ENGINEER

DEPARTMENT OF TRANSPORTATION
STATE OF HAWAII

L. Harris 5/6/93
DIR. OF TRANSPORTATION DATE

5/6/93
DATE

10