



"AS-BUILT"
PLANS FOR
KAUMUALII HIGHWAY
ROCK REVETMENT AT KEKAHA
FEDERAL AID PROJECT NO. ER-11(2)


DISTRICT OF WAIMEA
ISLAND OF KAUAI

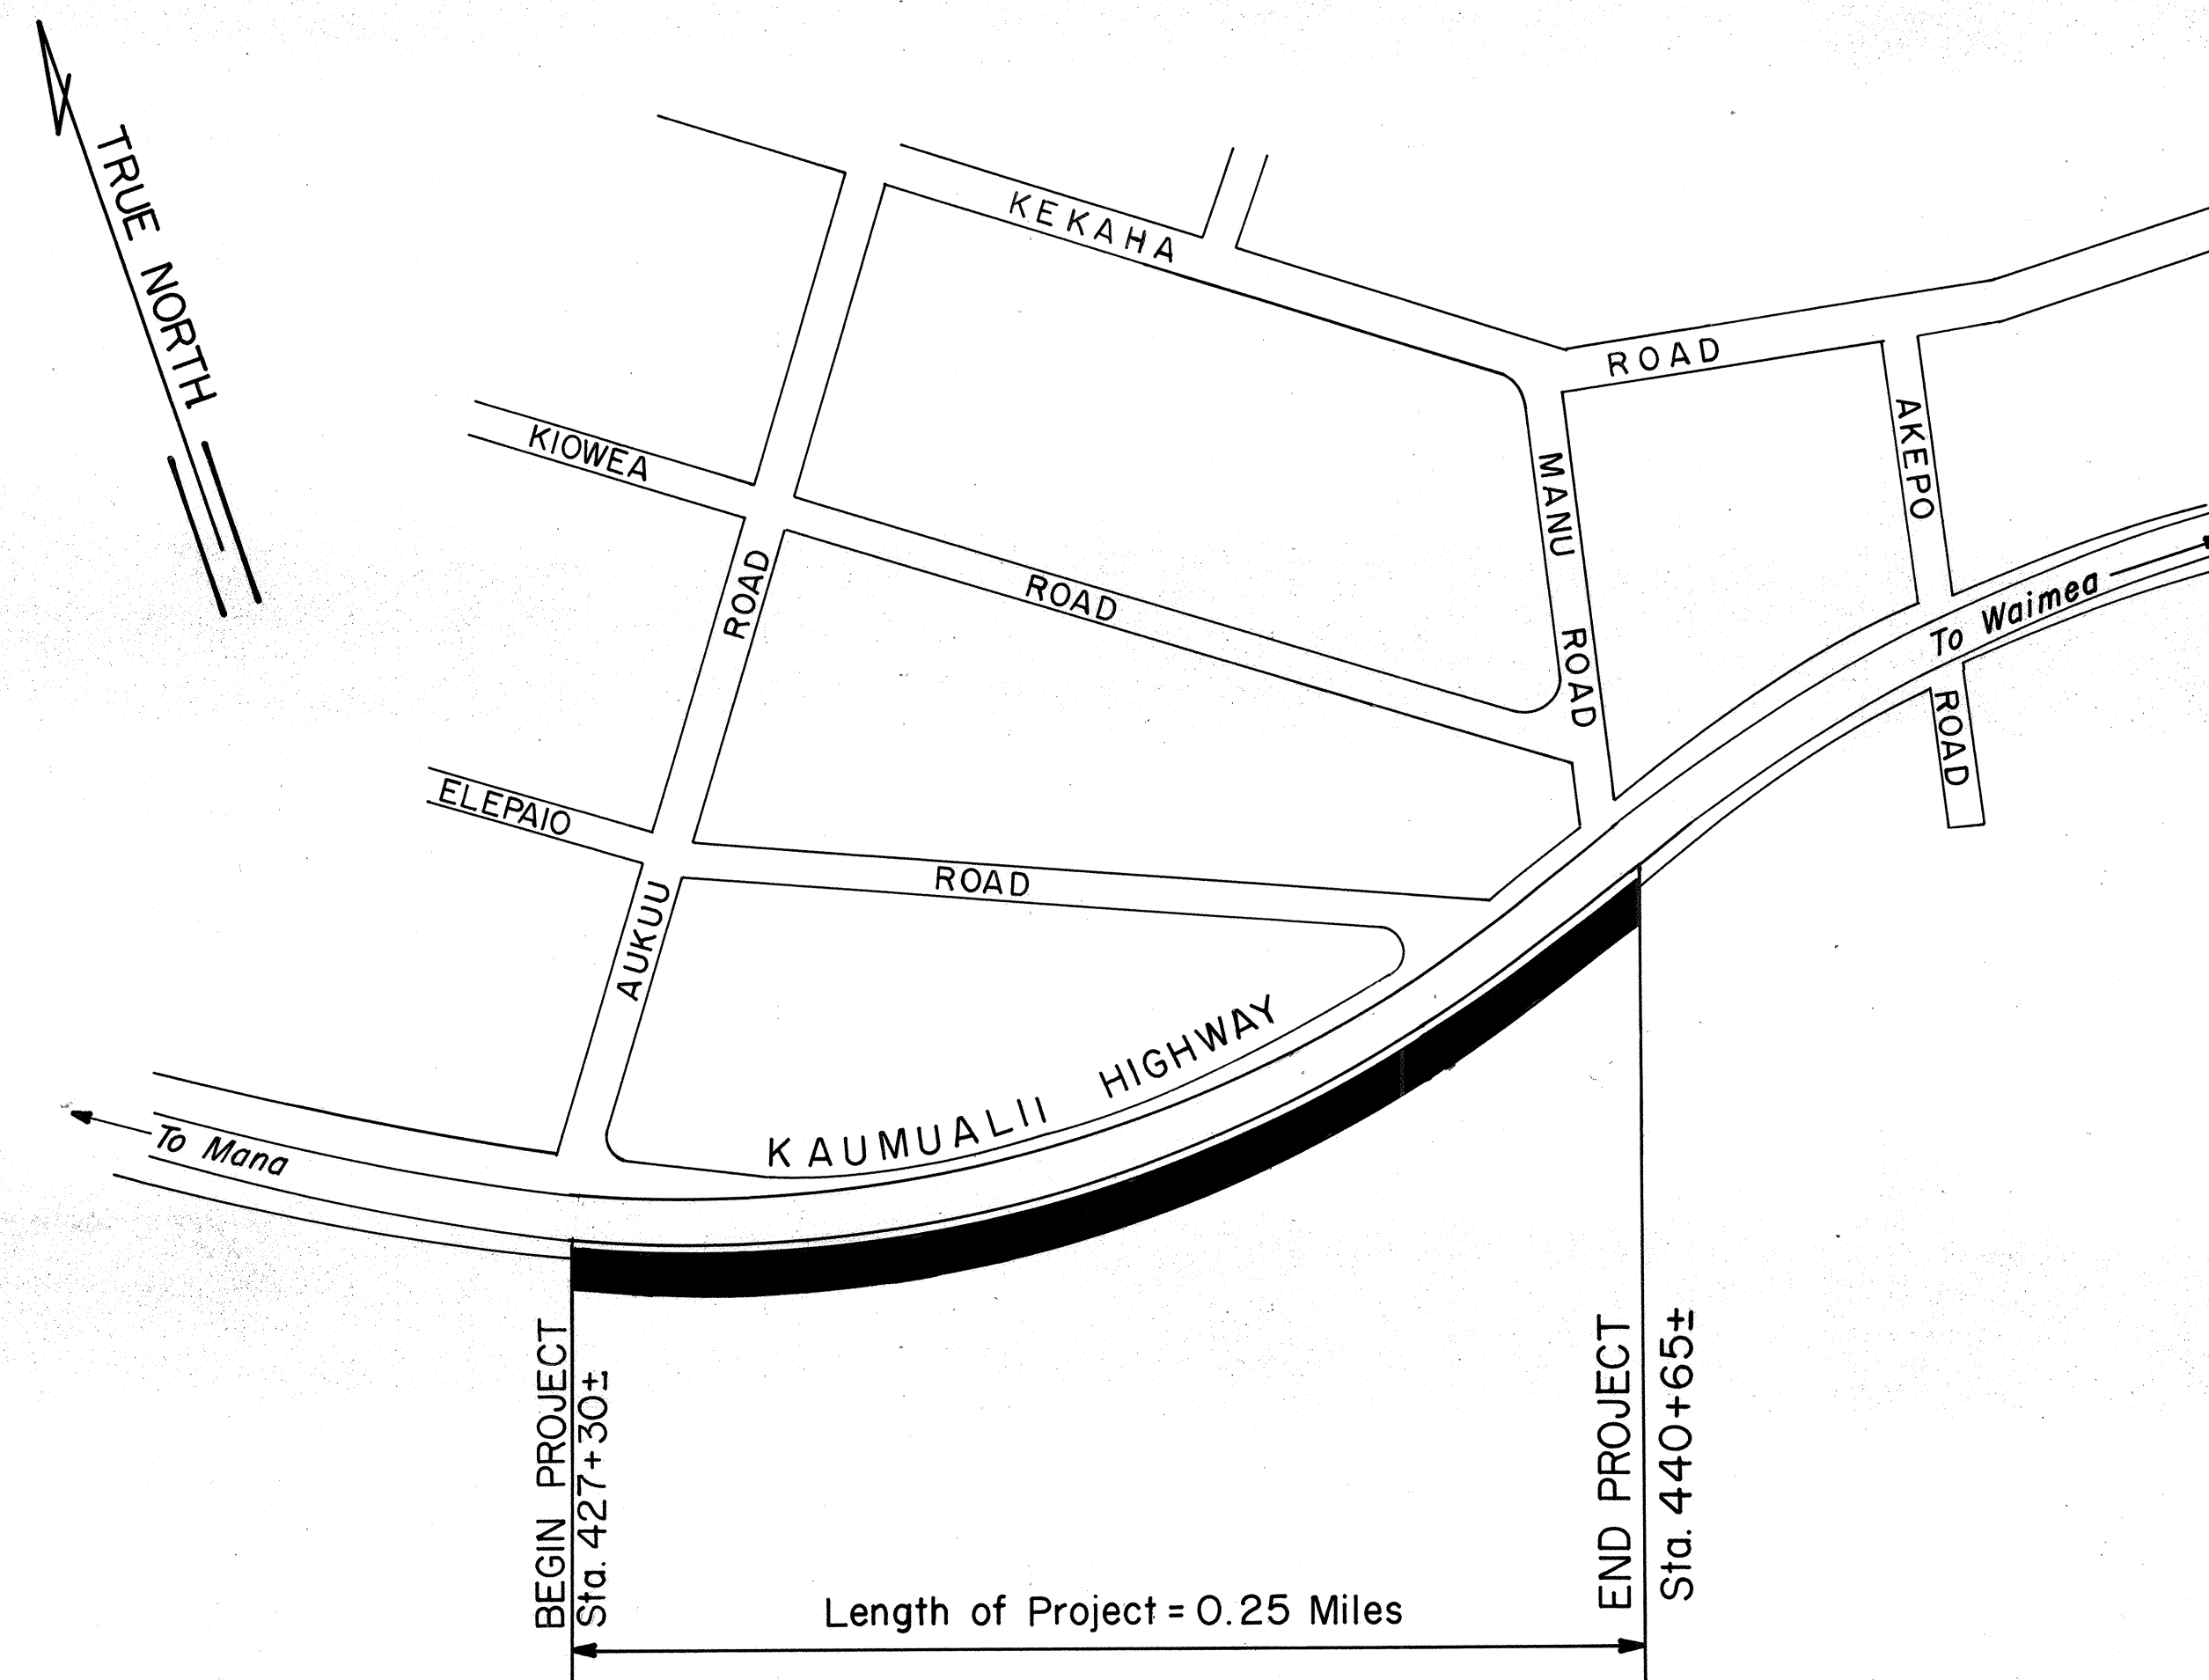

LAYOUT OF PROJECT

Scale: 1" = 100'

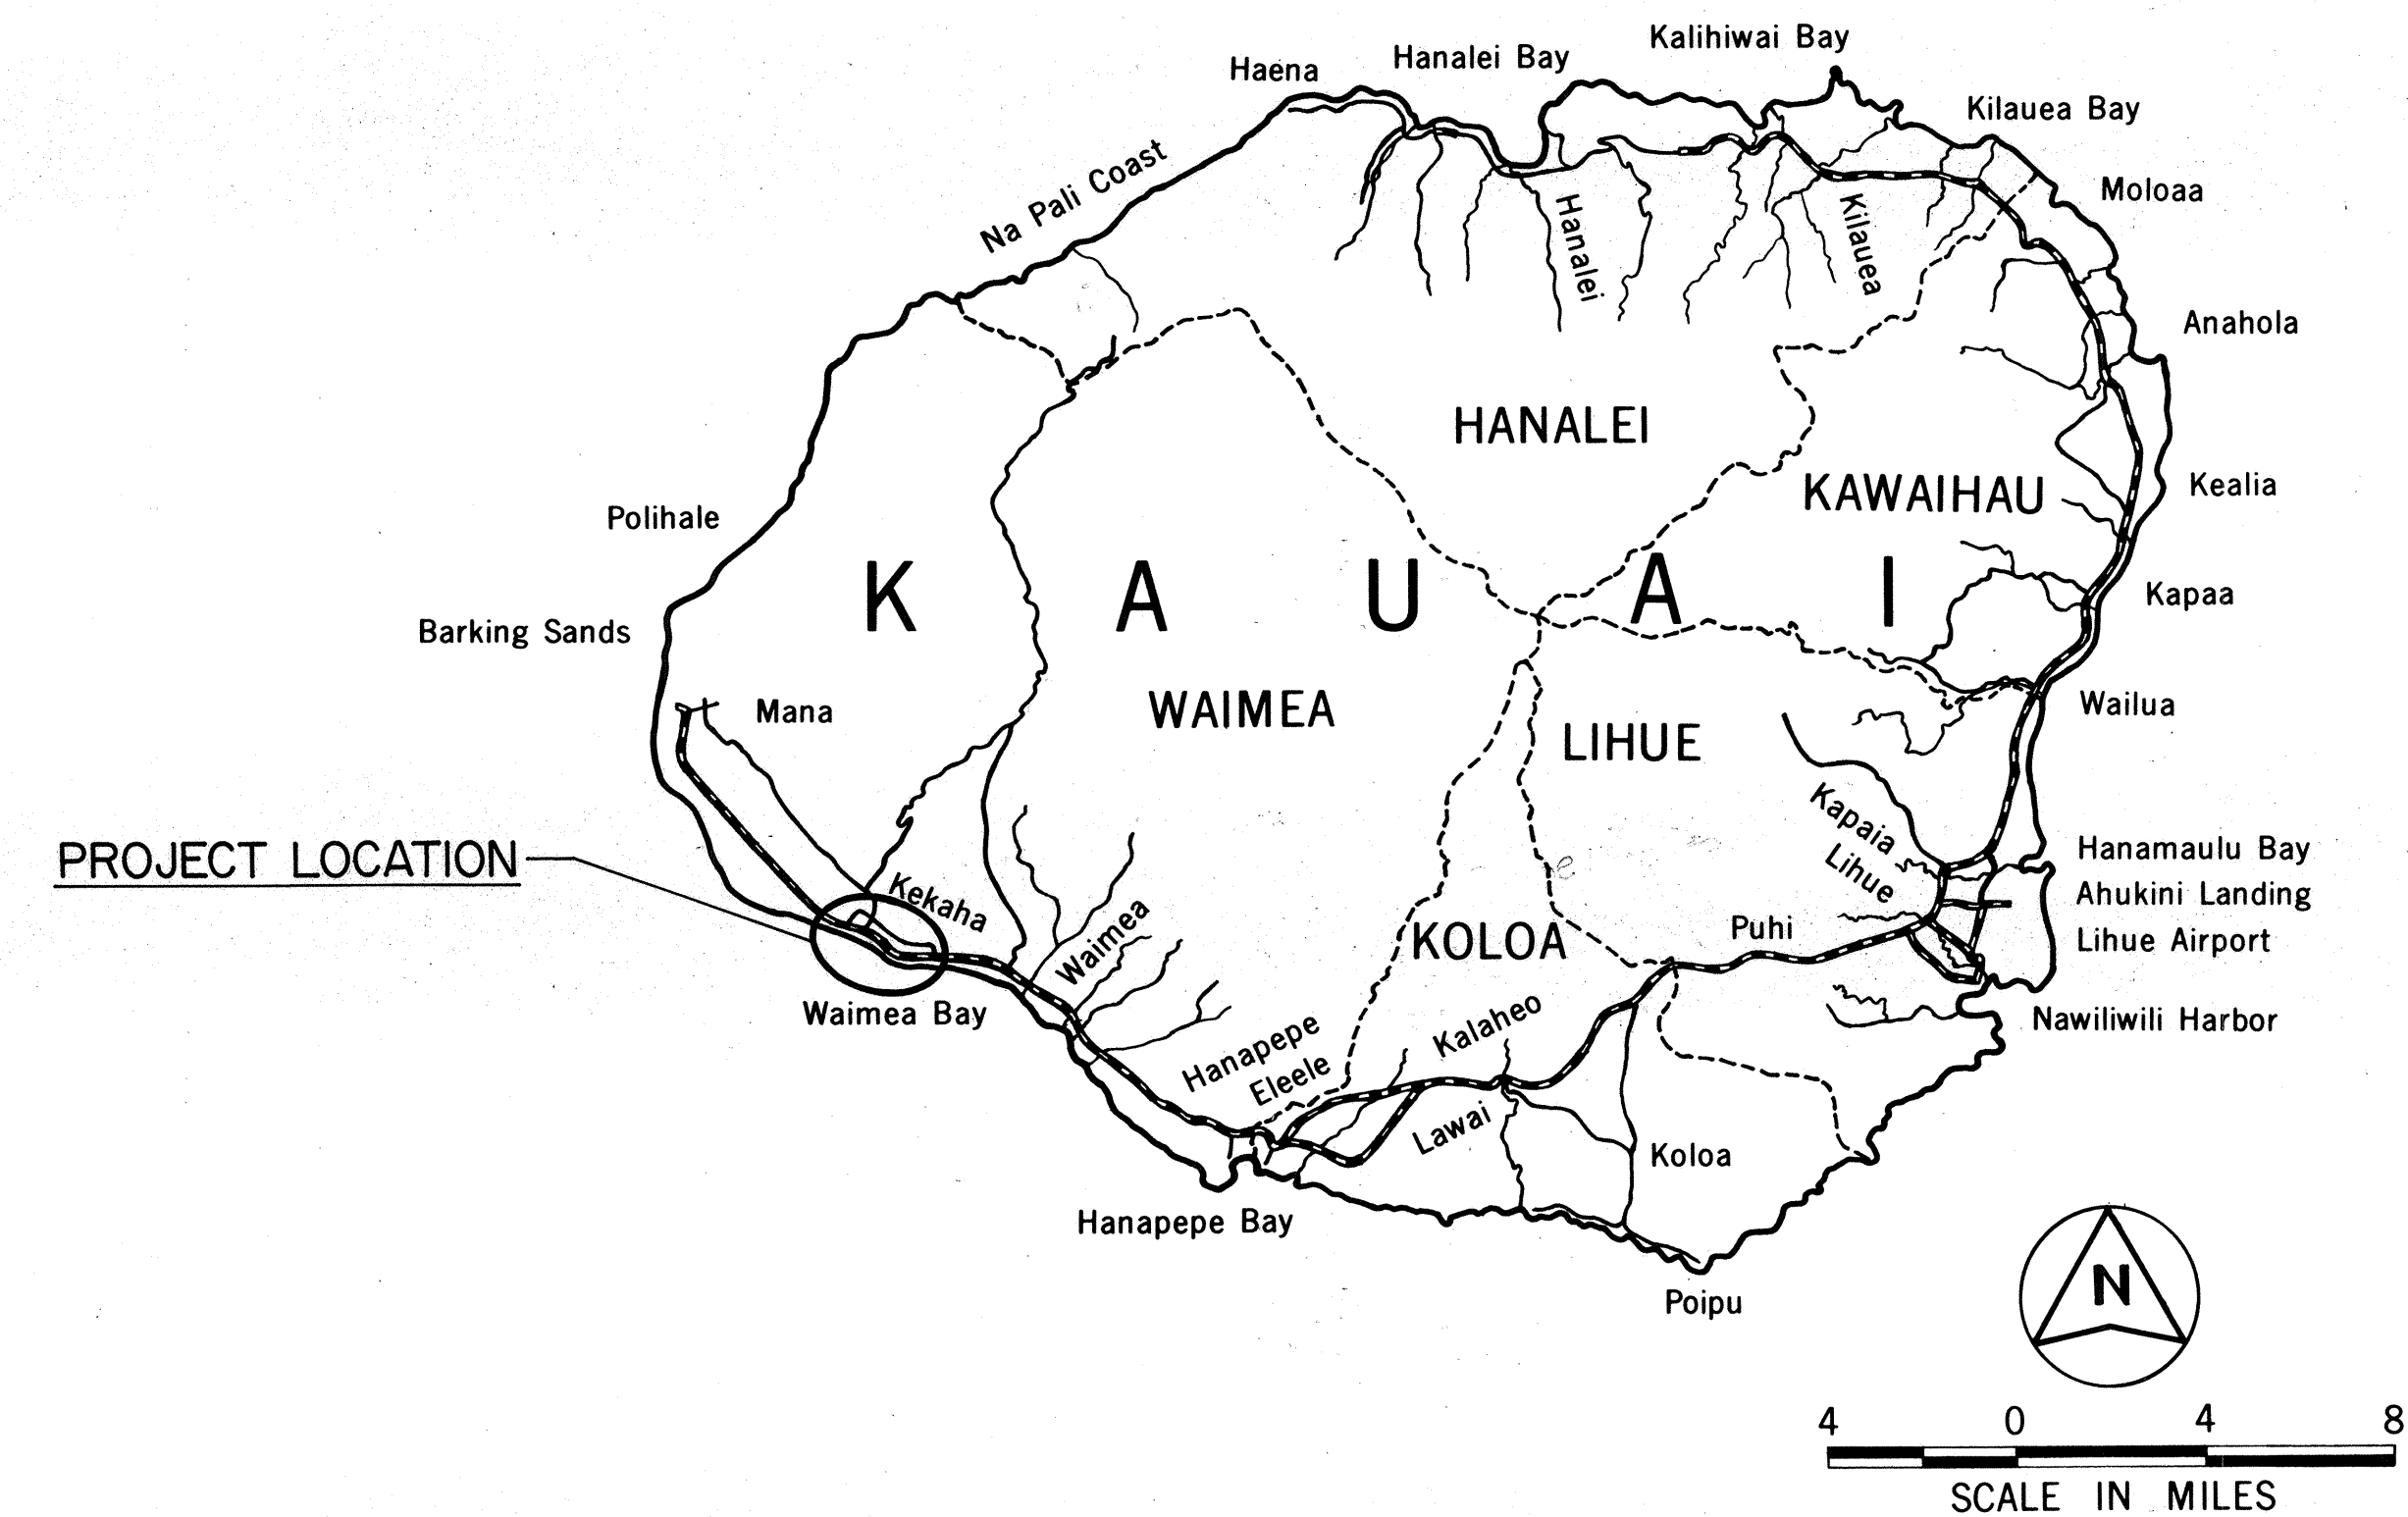

 FEDERAL AID PROJECTS PREVIOUSLY CONSTRUCTED
OR UNDER CONSTRUCTION

 MILE POST 25.41 TO MILE POST 25.16

CHANGES MADE DURING CONSTRUCTION HAVE BEEN
NOTED ON THESE PLANS AND CHECKED BY:

Galen Galt
RESIDENT ENGINEER

10/16/97
DATE

DEPARTMENT OF TRANSPORTATION
STATE OF HAWAII

APPROVED: Kay Haysashide 5/23/96
DIR. OF TRANSPORTATION DATE

[illegible]

KAUAI DISTRICT DESIGNED BY KEVIN ITO P. S. & E. BY 587-2244 PHONE MAR. 1996 DATE