
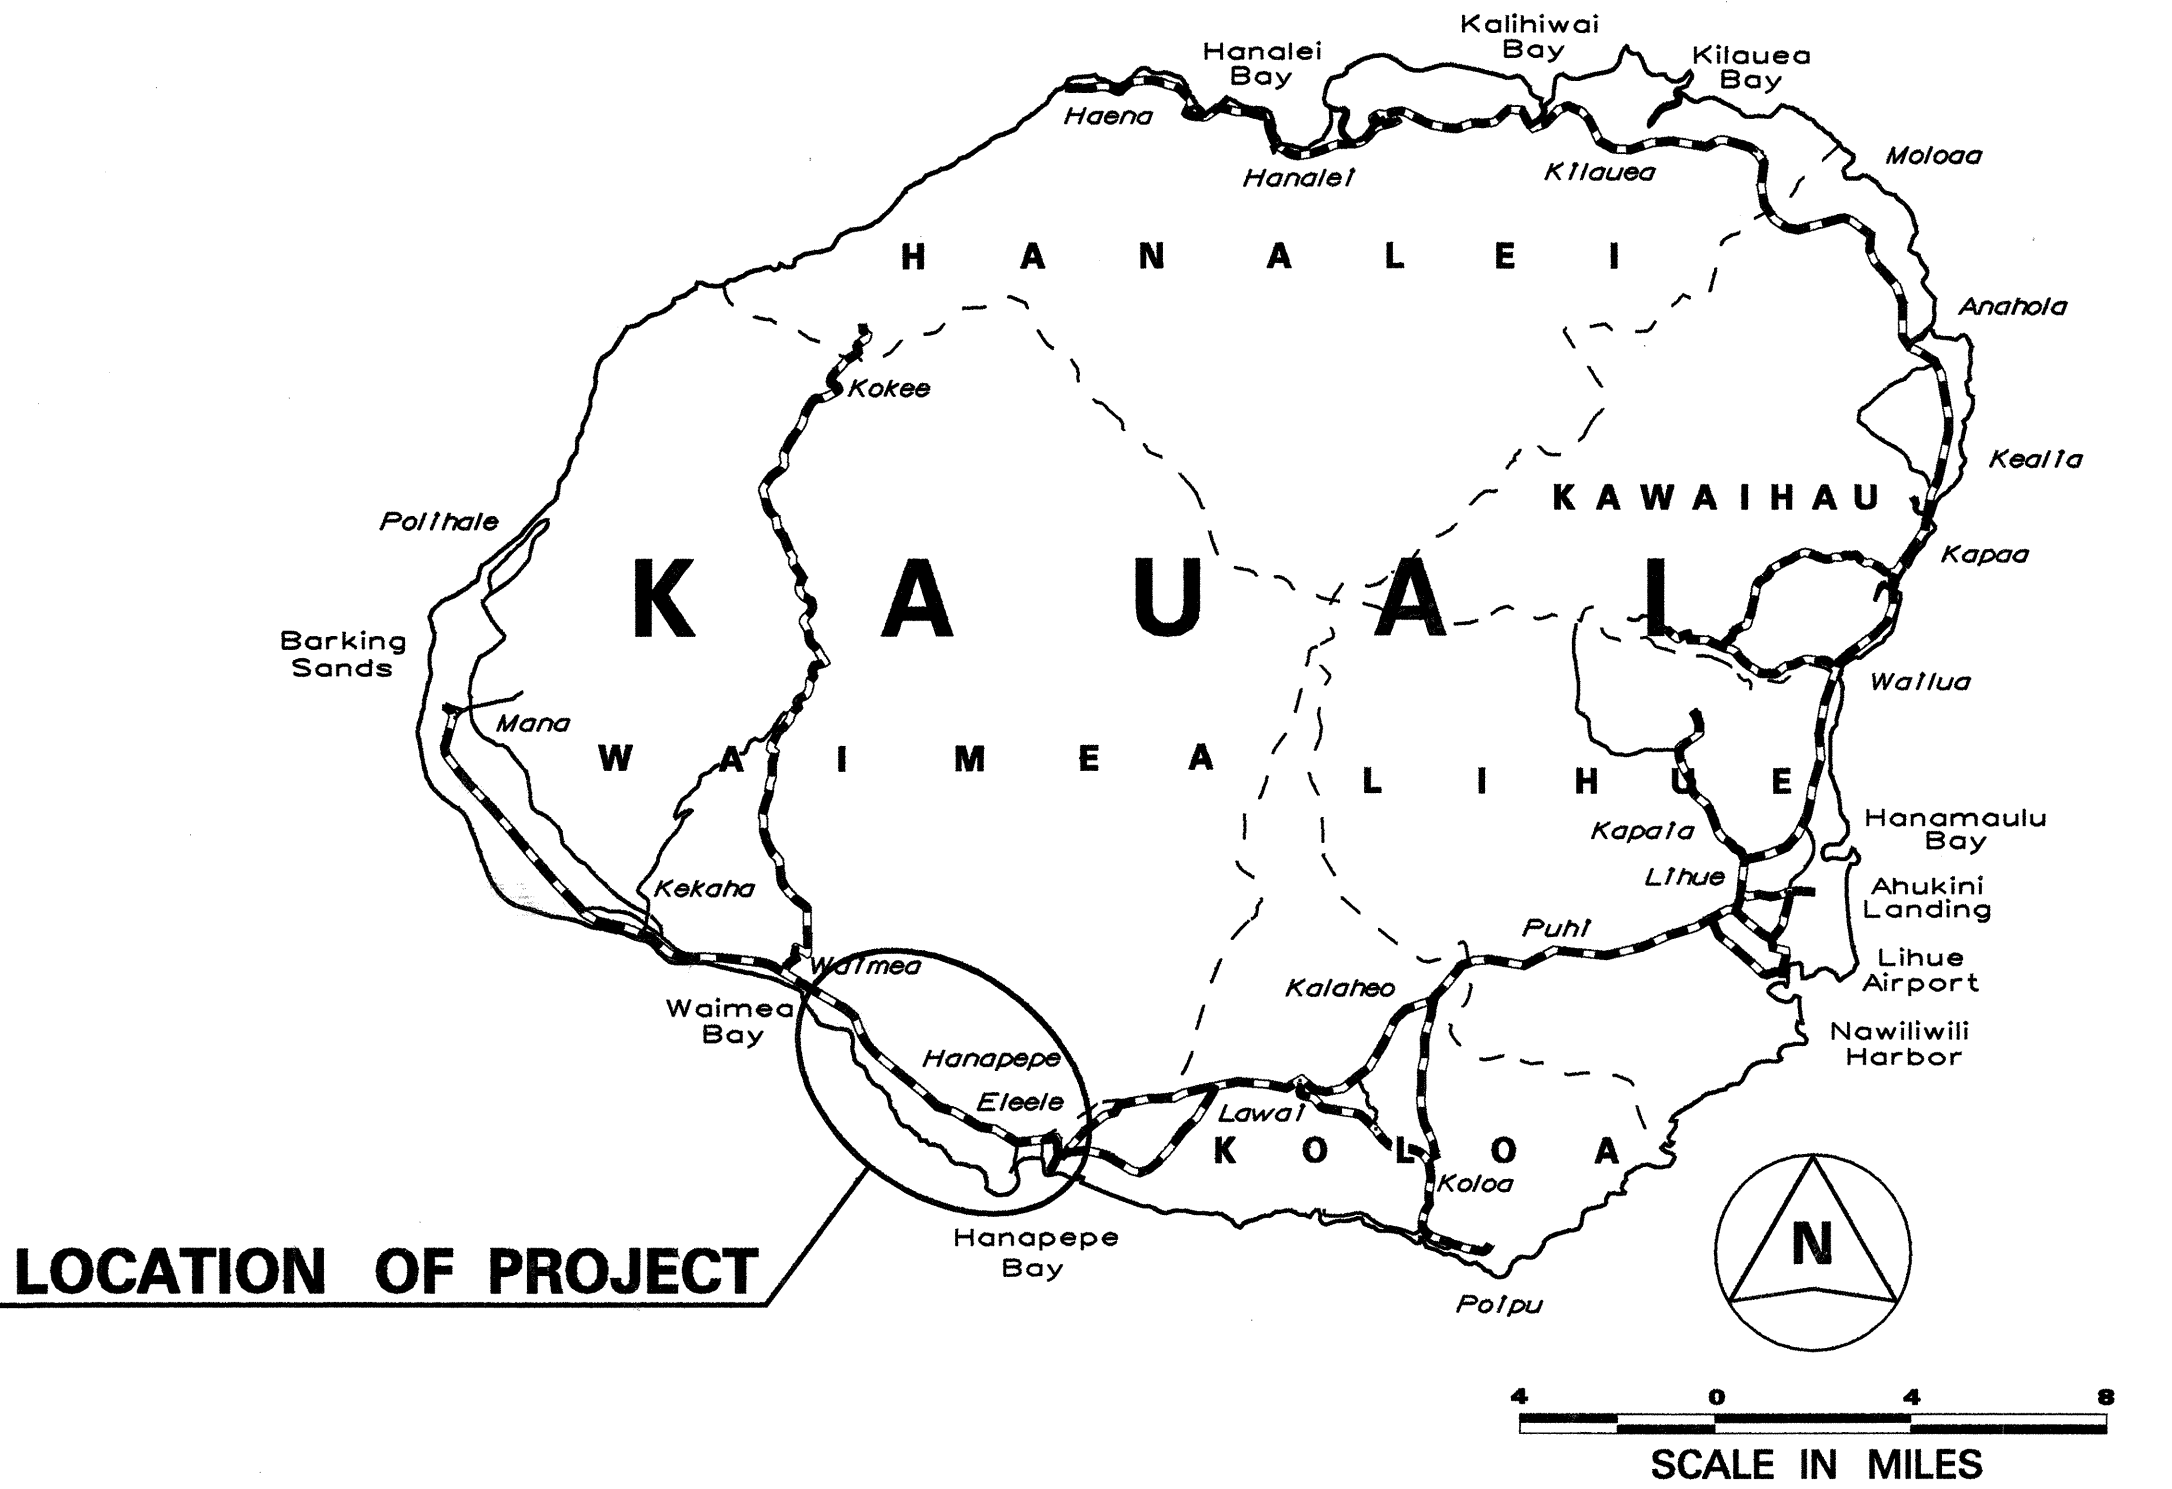
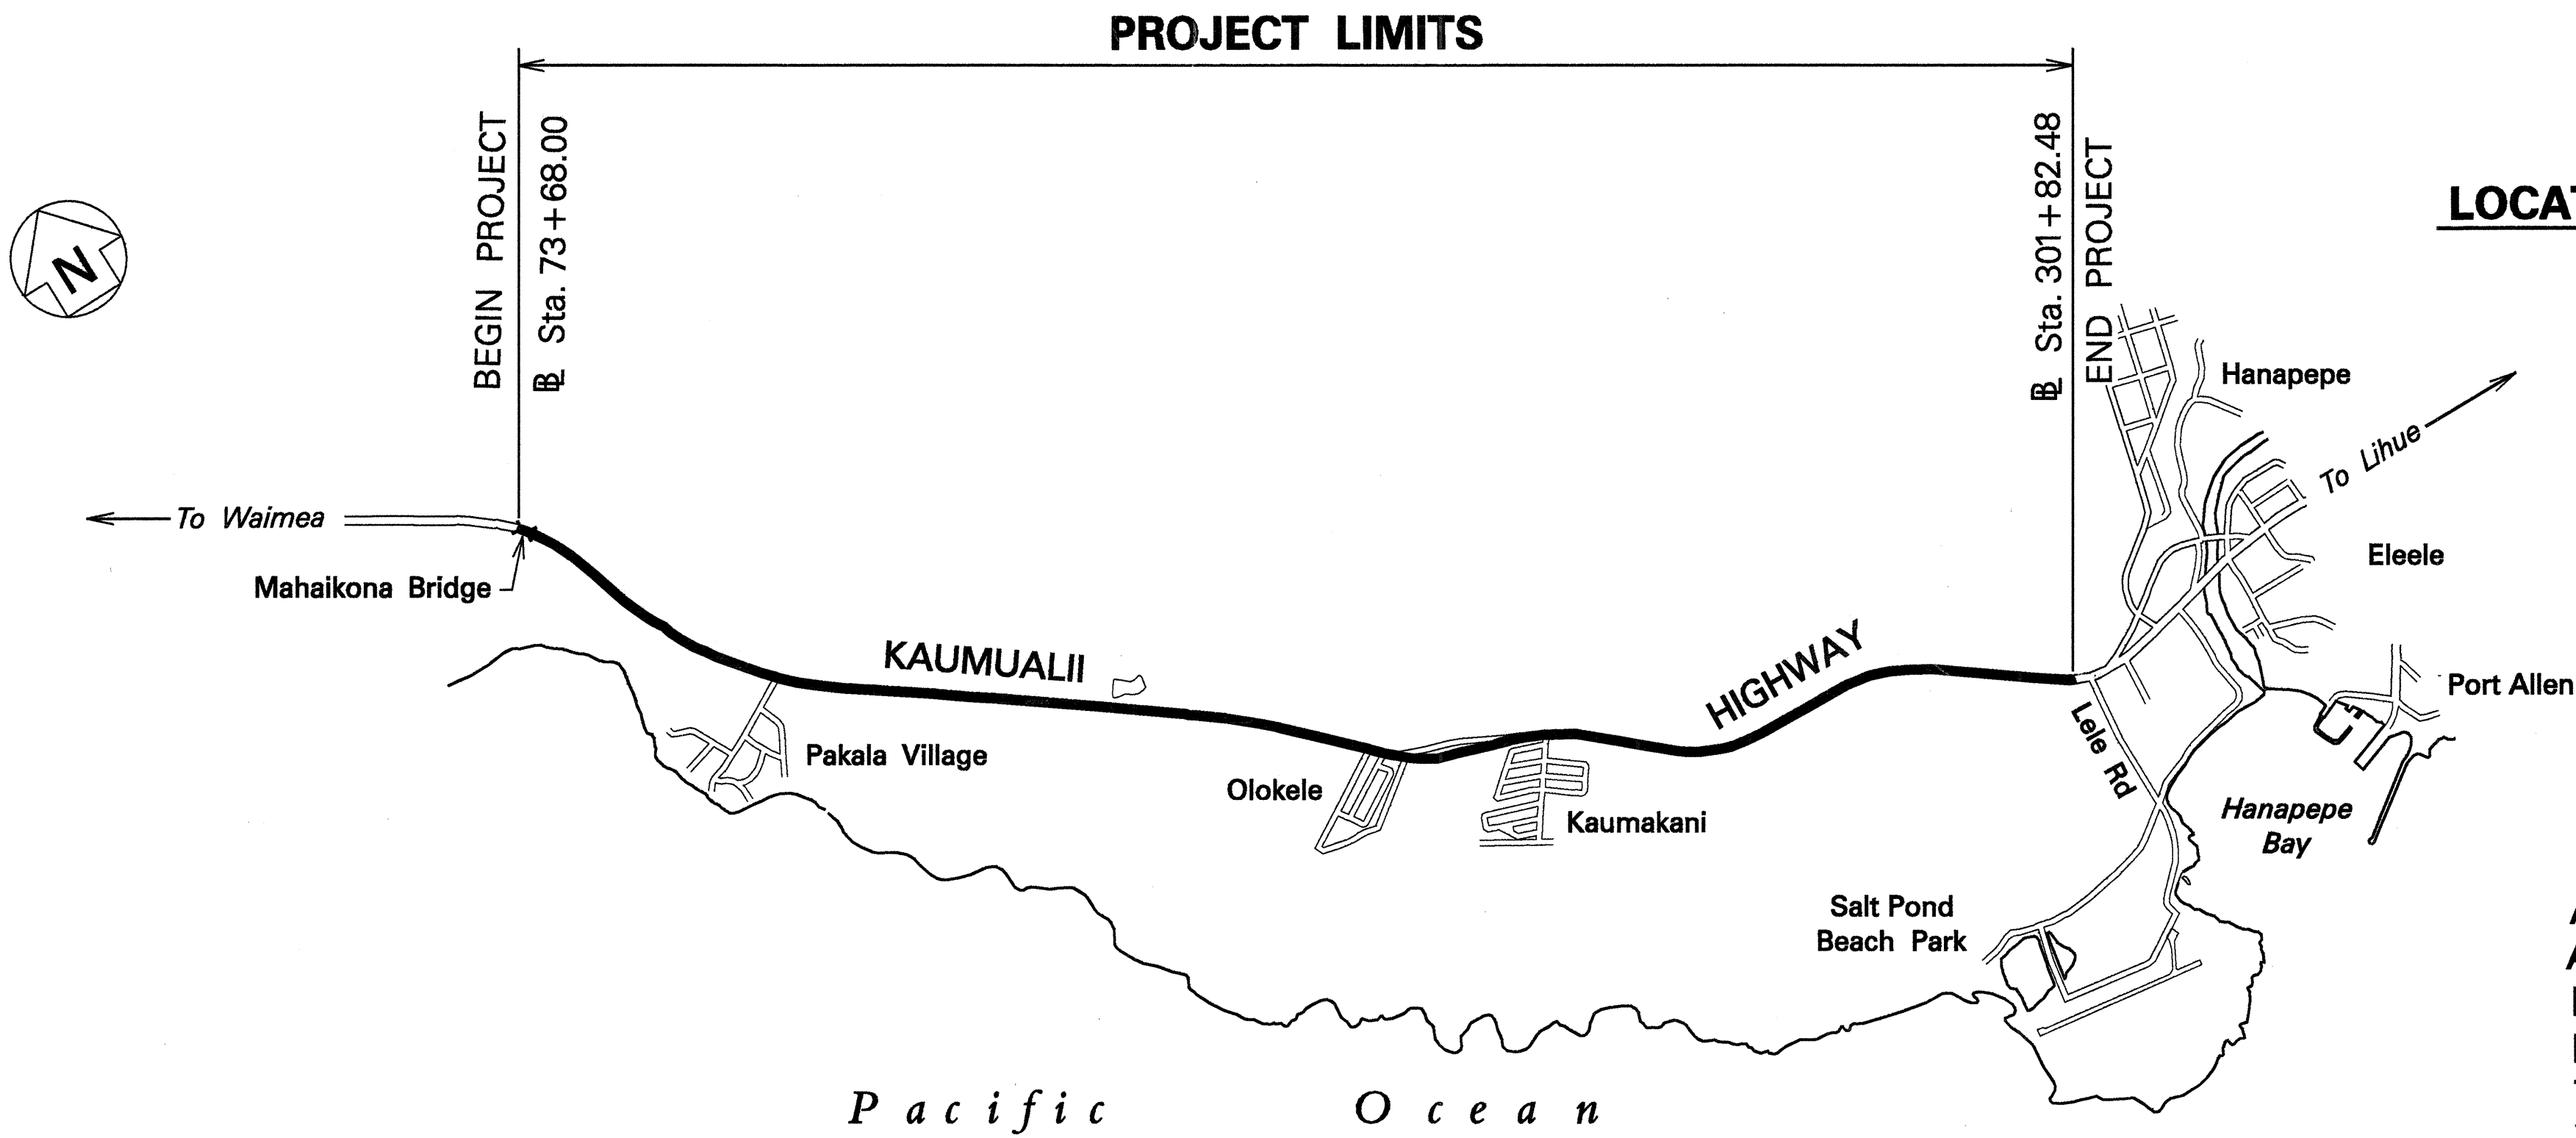


INDEX TO DRAWINGS	
SHEET NO.	DESCRIPTION
1	TITLE SHEET
2	STANDARD PLANS SUMMARY
3	GENERAL NOTES & LEGEND
4 - 6	TYPICAL SECTION & DETAILS
7 - 18	ROADWAY PLANS
19	PAVEMENT MARKING, LEGEND, NOTES & DETAILS
20 - 31	PAVEMENT MARKING, STRIPING & TRAFFIC SIGNING PLAN
32	TRAFFIC SIGN SUMMARY
33	PAVEMENT MARKING & STRIPING SUMMARY

STATE OF HAWAII
DEPARTMENT OF TRANSPORTATION
HIGHWAYS DIVISION
HONOLULU, HAWAII
PLANS FOR
KAUMUALII HIGHWAY RESURFACING
MAHAIKONA BRIDGE TO LELE ROAD
FEDERAL AID PROJECT NO. STP-050-1(18)
DISTRICT OF WAIMEA
ISLAND OF KAUAI

FED. ROAD DIST. NO.	STATE	FED. AID PROJ. NO.	FISCAL YEAR	SHEET NO.	TOTAL SHEETS
HAWAII	HAW.	STP-050-1(18)	1996	1	33

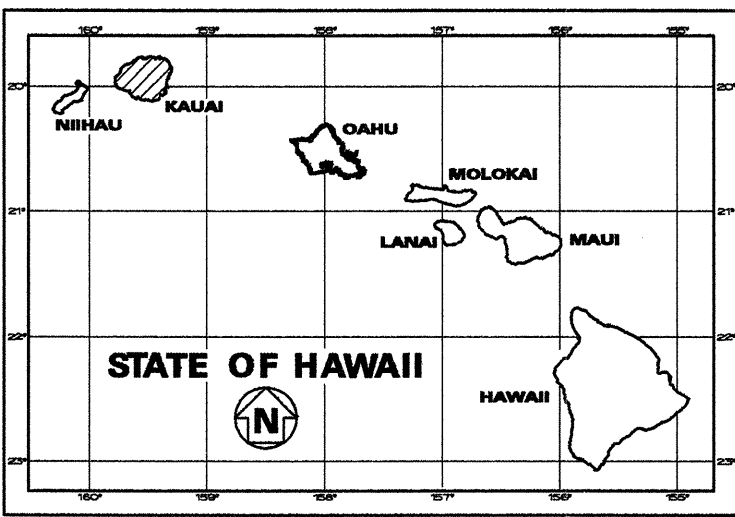


— FEDERAL AID PROJECTS PREVIOUSLY CONSTRUCTED OR UNDER CONSTRUCTION

MILE POST 17.10 TO MILE POST 21.40

DESIGN DESIGNATION ROUTE 50 MAHAIKONA BRIDGE TO KAUMAKANI VILLAGE ROAD	
ADT (1995)	9,600
ADT (2005)	11,400
DHV	1,100
D	60/40
T	4.0 %
V	50 M.P.H.

DESIGN DESIGNATION ROUTE 50 KAUMAKANI VILLAGE ROAD TO LELE ROAD	
ADT (1995)	10,800
ADT (2005)	13,300
DHV	1,200
D	55/45
T	4.0 %
V	50 M.P.H.

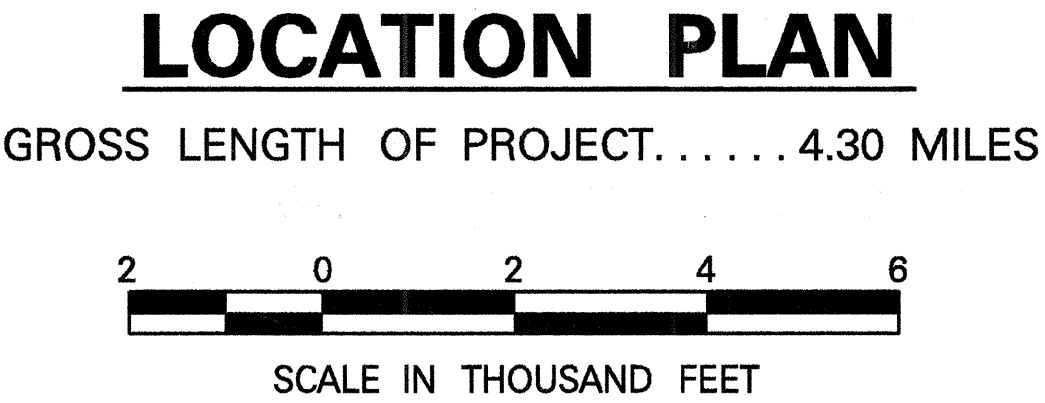

DEPARTMENT OF TRANSPORTATION
STATE OF HAWAII
APPROVED: *[Signature]* 5/17/96
DIR. OF TRANSPORTATION DATE

HWY-K
DESIGNED BY
J. FUJIMOTO
P.S. & E.B.Y.
587-2249
PHONE
SEPT. 1995
DATE