


FED. ROAD DIST. NO.	STATE	PROJ. NO.	FISCAL YEAR	SHEET NO.	TOTAL SHEETS
HAWAII	HAW.	HWY-K-03-96	1996	7	19

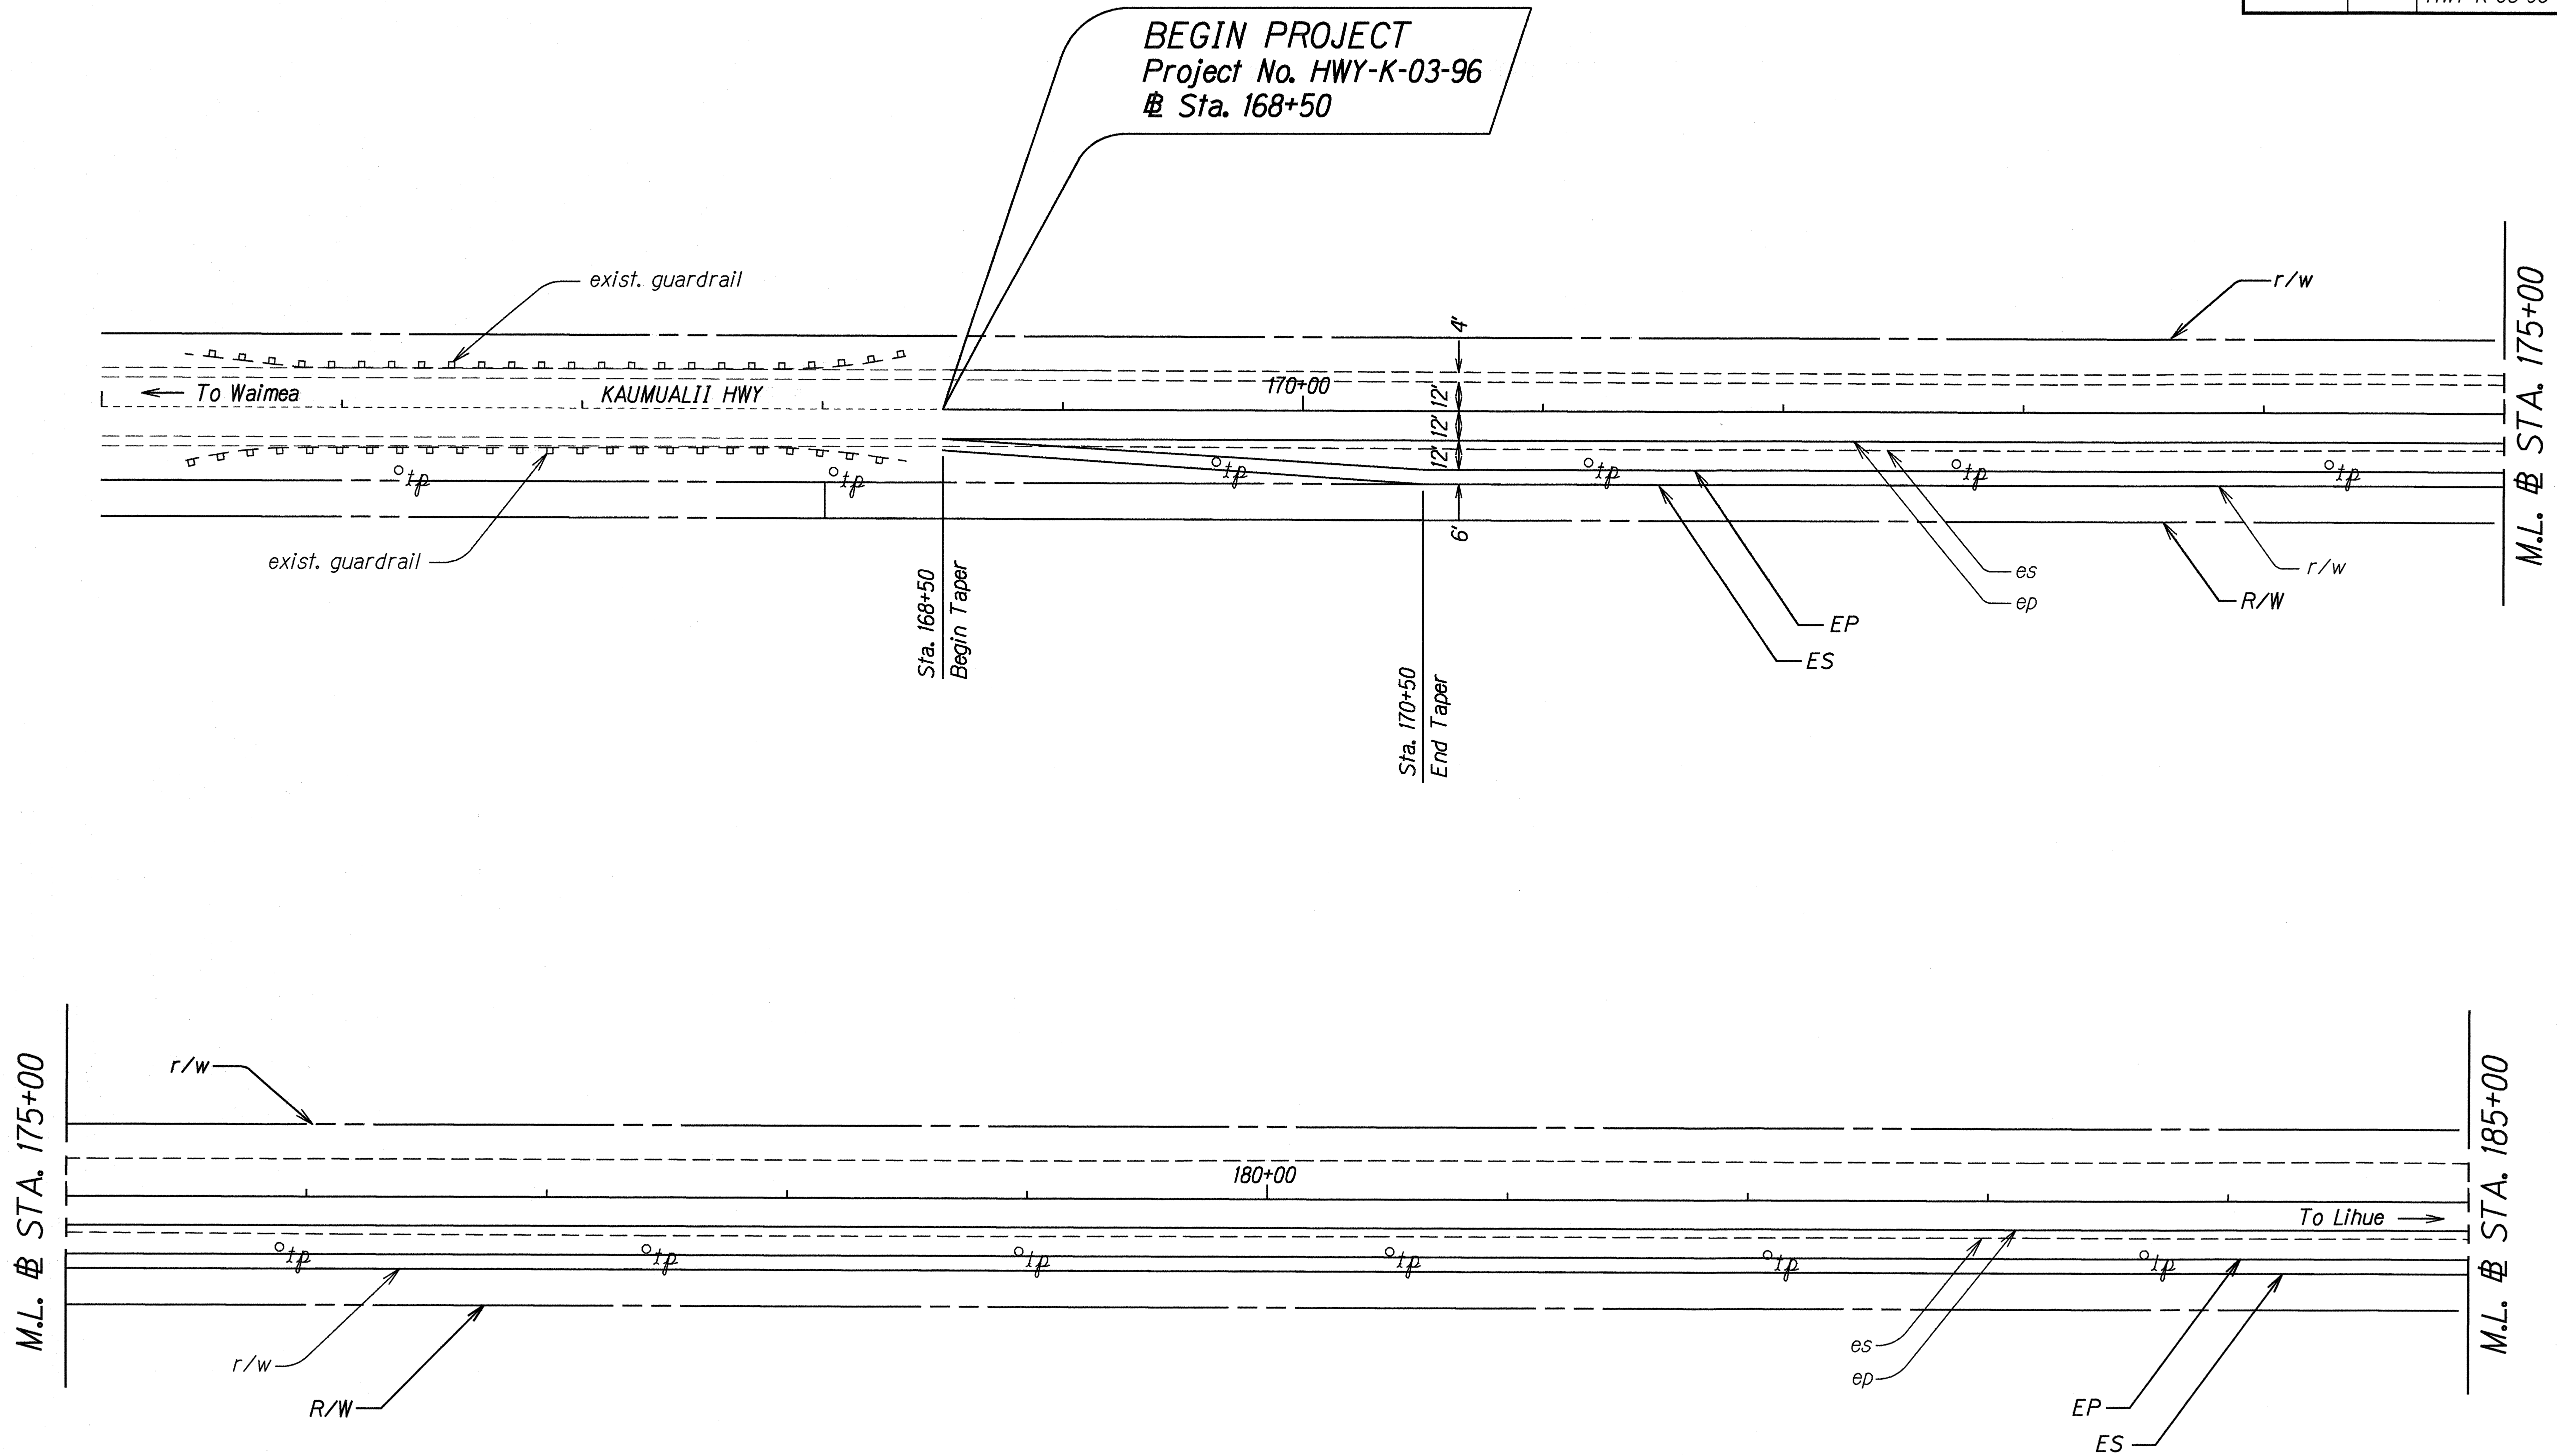

NOTE:
Unless otherwise indicated, all existing telephone poles (tp) within the project limits will be relocated by others.

ORIGINAL PLAN	SURVEY PLOTTED BY	DATE
NOTE BOOK	DRAWN BY	X
Ke-2/2/96	DESIGNED BY	HWY-K
N. Amakahi	CHECKED BY	

STATE OF HAWAII
DEPARTMENT OF TRANSPORTATION
HIGHWAYS DIVISION


ROADWAY PLAN
KAUMUALII HIGHWAY
PUHI TEMPORARY BYPASS ROAD
Project No. HWY-K-03-96
Scale: 1" = 40' Date: Jan, 1996

SHEET No. 1 OF 2 SHEETS

FED. ROAD DIST. NO.	STATE	PROJ. NO.	FISCAL YEAR	SHEET NO.	TOTAL SHEETS
HAWAII	HAW.	Hwy-K-03-96	1996	8	19



END PROJECT
Project No. HWY-K-03-96
Sta. 196+55

CURVE DATA
Δ = 33°05'30"
R = 8,000'
T = 2,376.67'
C = 4,556.52
Lc = 4,620.47

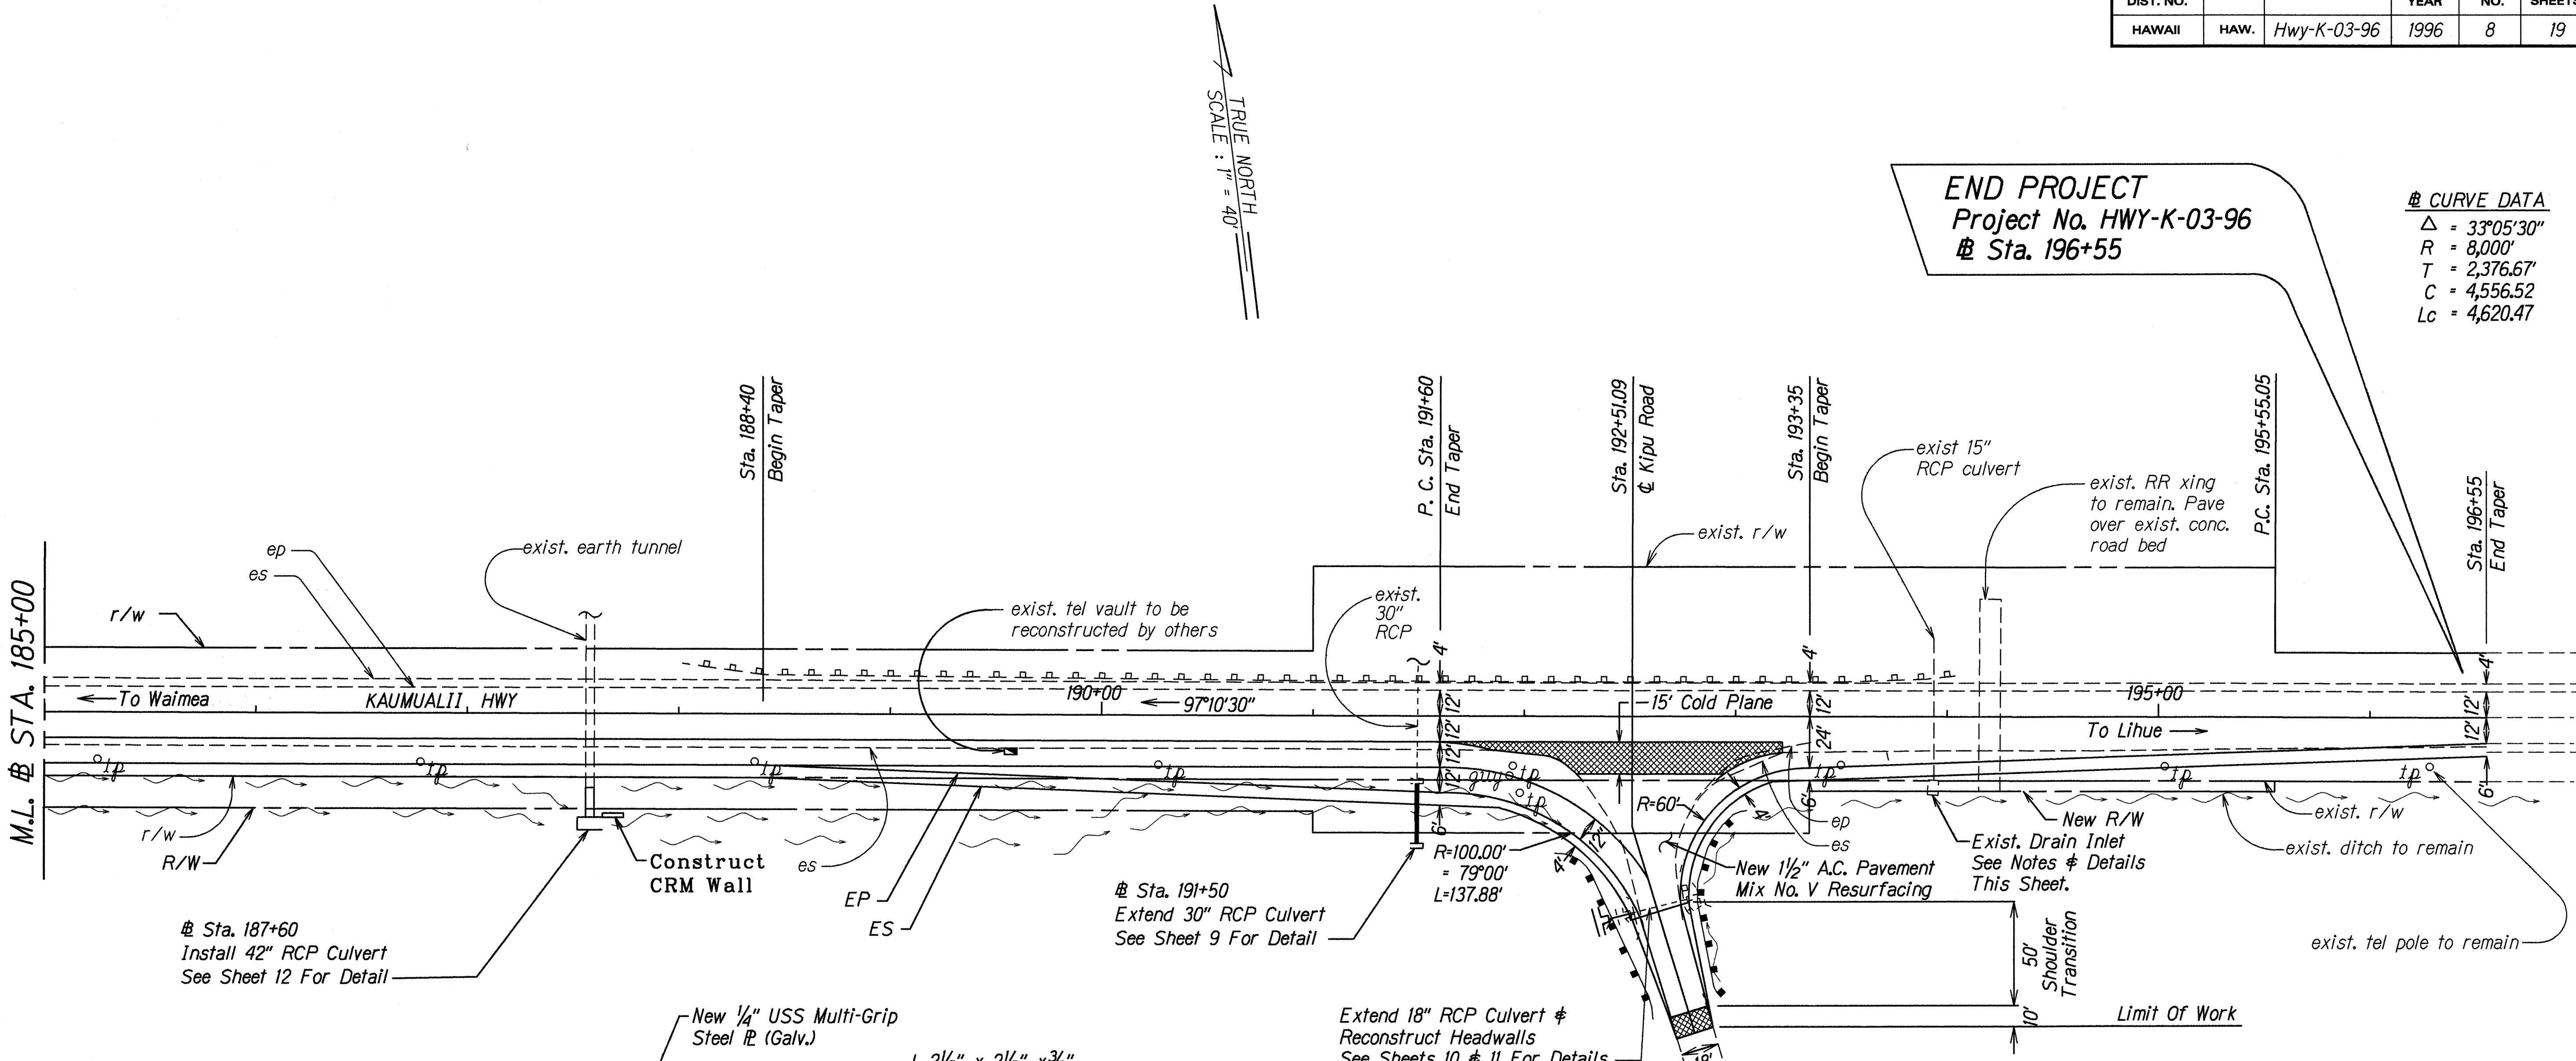

NOTES:

- Existing Drain Inlet to remain.
- Regrade shoulder area around inlet flush with top of exist. concrete.
- Install new cover per detail at right.
- All Drain Inlet work shall be considered incidental to the various storm drain work.
- New steel cover & frame shall be galvanized after fabrication.

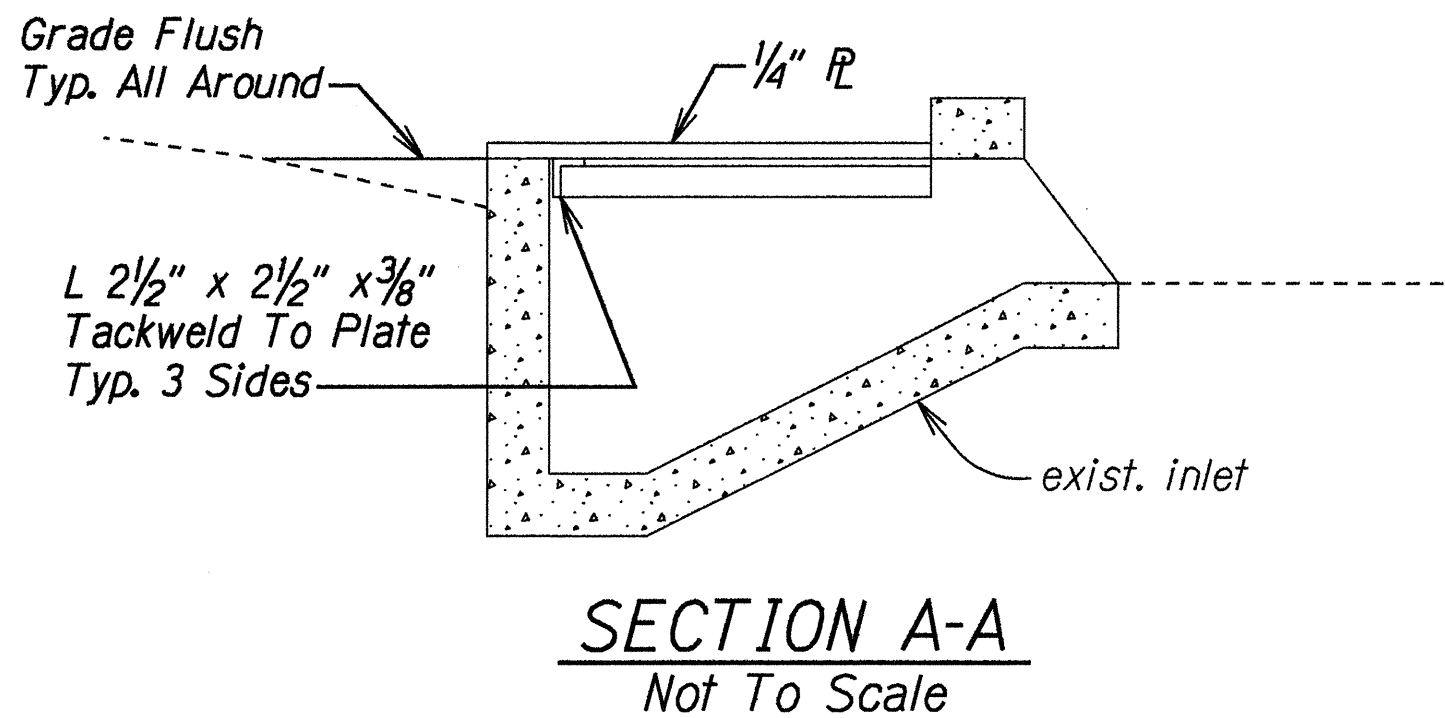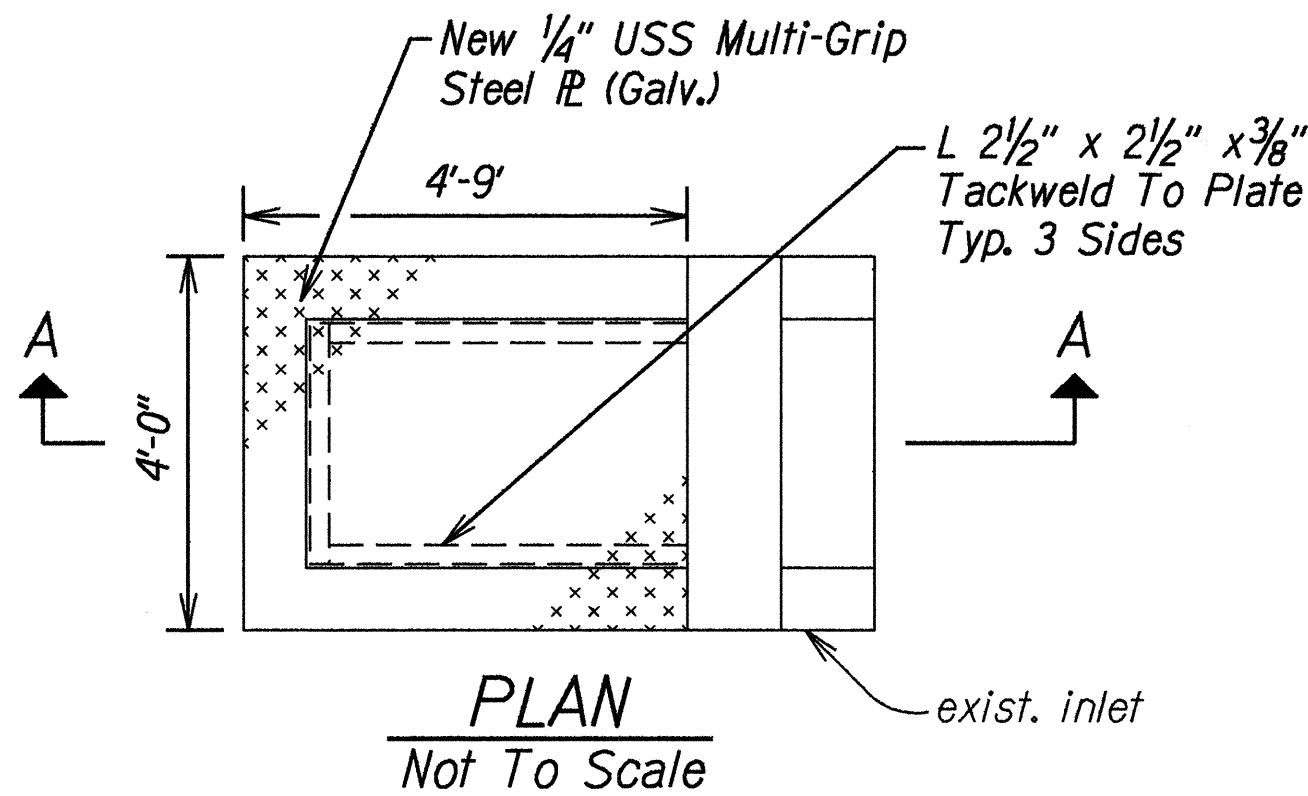

Kipu Road:

- Remove Exist. Wooden Guardrail & Posts, 16LF Lt. & 20LF Rt.
- Install New Metal Guardrail & Posts, 50 LF Type 3, Single, W/Steel Post & Spacer, Lt. & Rt. Centered On Culvert
- Install 2 New SRT, Lt. & Rt. (4 Total)

LEGEND FOR AS-BUILT POSTINGS	
	Squiggly line for as-built deletion
	Double line for as-built deletion
Roadway	Text for as-built posting

STATE OF HAWAII
DEPARTMENT OF TRANSPORTATION
HIGHWAYS DIVISION

ROADWAY PLAN
KAUMUALII HIGHWAY
PUHI TEMPORARY BYPASS ROAD
Project No. HWY-K-03-96
Scale: 1" = 40'
Date: Jan, 1996

SHEET No. 2 OF 2 SHEETS

ORIGINAL PLAN	DATE 1996
SURVEY PLOTTED BY	
DRAWN BY	
NOTED BY	
DESIGNED BY	
CHECKED BY	