





FED. ROAD DIST. NO.	STATE	PROJ. NO.	FISCAL YEAR	SHEET NO.	TOTAL SHEETS
HAWAII	HAW.	HWY-K-03-96	1996	16	19

TRAFFIC SIGN SUMMARY					
SIGN NO.	MESSAGE	QUANTITY			
		10 SQ. FT. OR LESS		GREATER THAN 10 SQ. FT.	
		W/POST	W/O POST	W/POSTS	W/O POST
VARIES	(RELOCATED SIGNS)	2		4	
R1-1	STOP	4			
R1-2	YIELD	5-2			
R2-1(20)	SPEED LIMIT 20 MPH	3			
R2-1(25)	SPEED LIMIT 25 MPH	2			
R2-5A	REDUCE SPEED AHEAD	2			
R3-7(R)	RIGHT TURN MUST TURN RIGHT	1			
R3-40(R)-B				2	
R12-1(6)	WEIGHT LIMIT 6 TONS	2			
W1-2(L)		1			
W1-2(R)		2			
W1-5(R)		2			
W5-2	NARROW BRIDGE	2			
W5-3	ONE LANE BRIDGE	2			
W7-3A	NEXT 1/2 MILE		2		
W13-1(10)	10 MPH		5		
W13-1(15)	15 MPH		2		
M4-1	ALTERNATE		1		
	TOTAL	30-27	10	6	0

CONSTRUCTION SIGN SUMMARY			
SIGN NO.	MESSAGE	W/POSTS	W/O POST
CG20-2	END CONSTRUCTION	2	
CW20-1d	ROAD CONSTRUCTION AHEAD	2	
	TOTAL	4	0

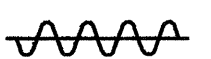
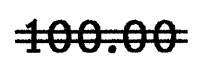
DESTINATION SIGN SUMMARY				
SIGN NO.	MESSAGE	SIZE	NEW PANEL AREA (SQ. FT.)	
			W/O POST	W/POSTS
D1-1	LIHUE ➡	5'-0" x 2'-0"		10.00
D1-1	↙ LIHUE	4'-0" x 1'-6"		6.00
D1-2	⤴ PUHI RD. ↑ TO KIPU RD.	4'-0" x 2'-0"		8.00
D3	HALEHAKA RD.	1@ 3'-0" x 0'-9"	2.25	
D3	HULEMALU RD.	3@ 3'-0" x 0'-9"	6.75	
D3	KIPU RD.	1@ 2'-0" x 0'-9"	1.50	
D3	PUHI RD.	1@ 2'-0" x 0'-9"	1.50	
	TOTAL		12.00	24.00

REFLECTOR MARKER SUMMARY				
TYPE	QUANTITY			
	W/O POST		W/STEEL POST	
	YELLOW	WHITE	YELLOW	WHITE
RM-2				2-4
RM-3	5-20			
RM-4			8	
TYPE II OBJECT MARKER	20		5	

NOTE: All objects (utility poles or trees) that are within the State highway right of way and within 30 feet of the roadway edge of pavement shall be marked as directed by the Engineer.

PAVEMENT MARKING SUMMARY	
DESCRIPTION	QUANTITY
PAVEMENT MARKERS	
TYPE A _____	180 EA.
TYPE C _____	200 EA.
TYPE D _____	765 EA.
TYPE H _____	70 EA.
TYPE J _____	0 EA.
TAPE - TYPE I OR THERMOPLASTIC EXTRUSION	
4-INCH PAVEMENT STRIPE (WHITE) _____	1790 L.F.
4-INCH PAVEMENT STRIPE (YELLOW) _____	0 L.F.
8-INCH PAVEMENT STRIPE (WHITE) _____	540 L.F.
12-INCH PAVEMENT STRIPE (WHITE) _____	0 L.F.
12-INCH PAVEMENT STRIPE (YELLOW) _____	0 L.F.
DOUBLE 4-INCH PAVEMENT STRIPE (YELLOW) _____	15,170 L.F.
PARKING STALLS _____	0 L.F.
TAPE - TYPE II OR THERMOPLASTIC EXTRUSION	
4-INCH PAVEMENT STRIPE (WHITE) _____	28,800 L.F.
4-INCH PAVEMENT STRIPE (YELLOW) _____	0 L.F.
8-INCH PAVEMENT STRIPE (WHITE) _____	0 L.F.
12-INCH PAVEMENT STRIPE (WHITE) _____	200 L.F.
12-INCH PAVEMENT STRIPE (YELLOW) _____	280 L.F.
DOUBLE 4-INCH PAVEMENT STRIPE (YELLOW) _____	1,280 L.F.
TAPE - TYPE III OR THERMOPLASTIC EXTRUSION	
4-INCH PAVEMENT STRIPE (WHITE) _____	200 L.F.
4-INCH PAVEMENT STRIPE (YELLOW) _____	0 L.F.
8-INCH PAVEMENT STRIPE (WHITE) _____	0 L.F.
12-INCH PAVEMENT STRIPE (WHITE) _____	160 L.F.
CROSSWALK MARKINGS _____	0 LANES
PAVEMENT ARROW _____	13 EA.
PAVEMENT WORD _____	0 EA.

- NOTES:
- Tape, Type I or Thermoplastic Extrusion (No Passing Zones, Channelizing Lines or Solid Lines)
 - Tape, Type II or Thermoplastic Extrusion (Transverse Median Markings, Transverse Shoulder Markings, Channelizing Islands or Edge Striping)
 - Tape, Type III or Thermoplastic Extrusion (Guide Lines Pavement Words or Pavement Arrows)

LEGEND FOR AS-BUILT POSTINGS	
	Squiggly line for as-built deletion
	Double line for as-built deletion
Roadway	Text for as-built posting

STATE OF HAWAII
DEPARTMENT OF TRANSPORTATION
HIGHWAYS DIVISION

TRAFFIC SUMMARIES

KAUMUALII HIGHWAY
PUHI TEMPORARY BYPASS ROAD
Project No. HWY-K-03-96

Date: Jan, 1996

SHEET No. 1 OF 1 SHEETS