

FED. ROAD DIST. NO.	STATE	FEDERAL-AID PROJ. NO.	FISCAL YEAR	SHEET NO.	TOTAL SHEETS
HAWAII	HAW.	STP-050-1(19)	1998	10	10


LEGEND



4" or 8" White Edge Stripe with Type C Raised Pavement Markers @ 40'-0" o.c. (Tape, Type II or Thermoplastic Extrusion)


NOTES

- Layout of pavement markings and striping shall be done by the Contractor and approved by the Engineer prior to any installation work.
- All pavement striping shall be as noted on the legend or plans.
- All preformed pavement marking tapes over existing pavement shall be applied with an approved primer as recommended by the tape manufacturer and as approved by the Engineer. The primer shall be allowed to dry to the tacky stage prior to tape application.

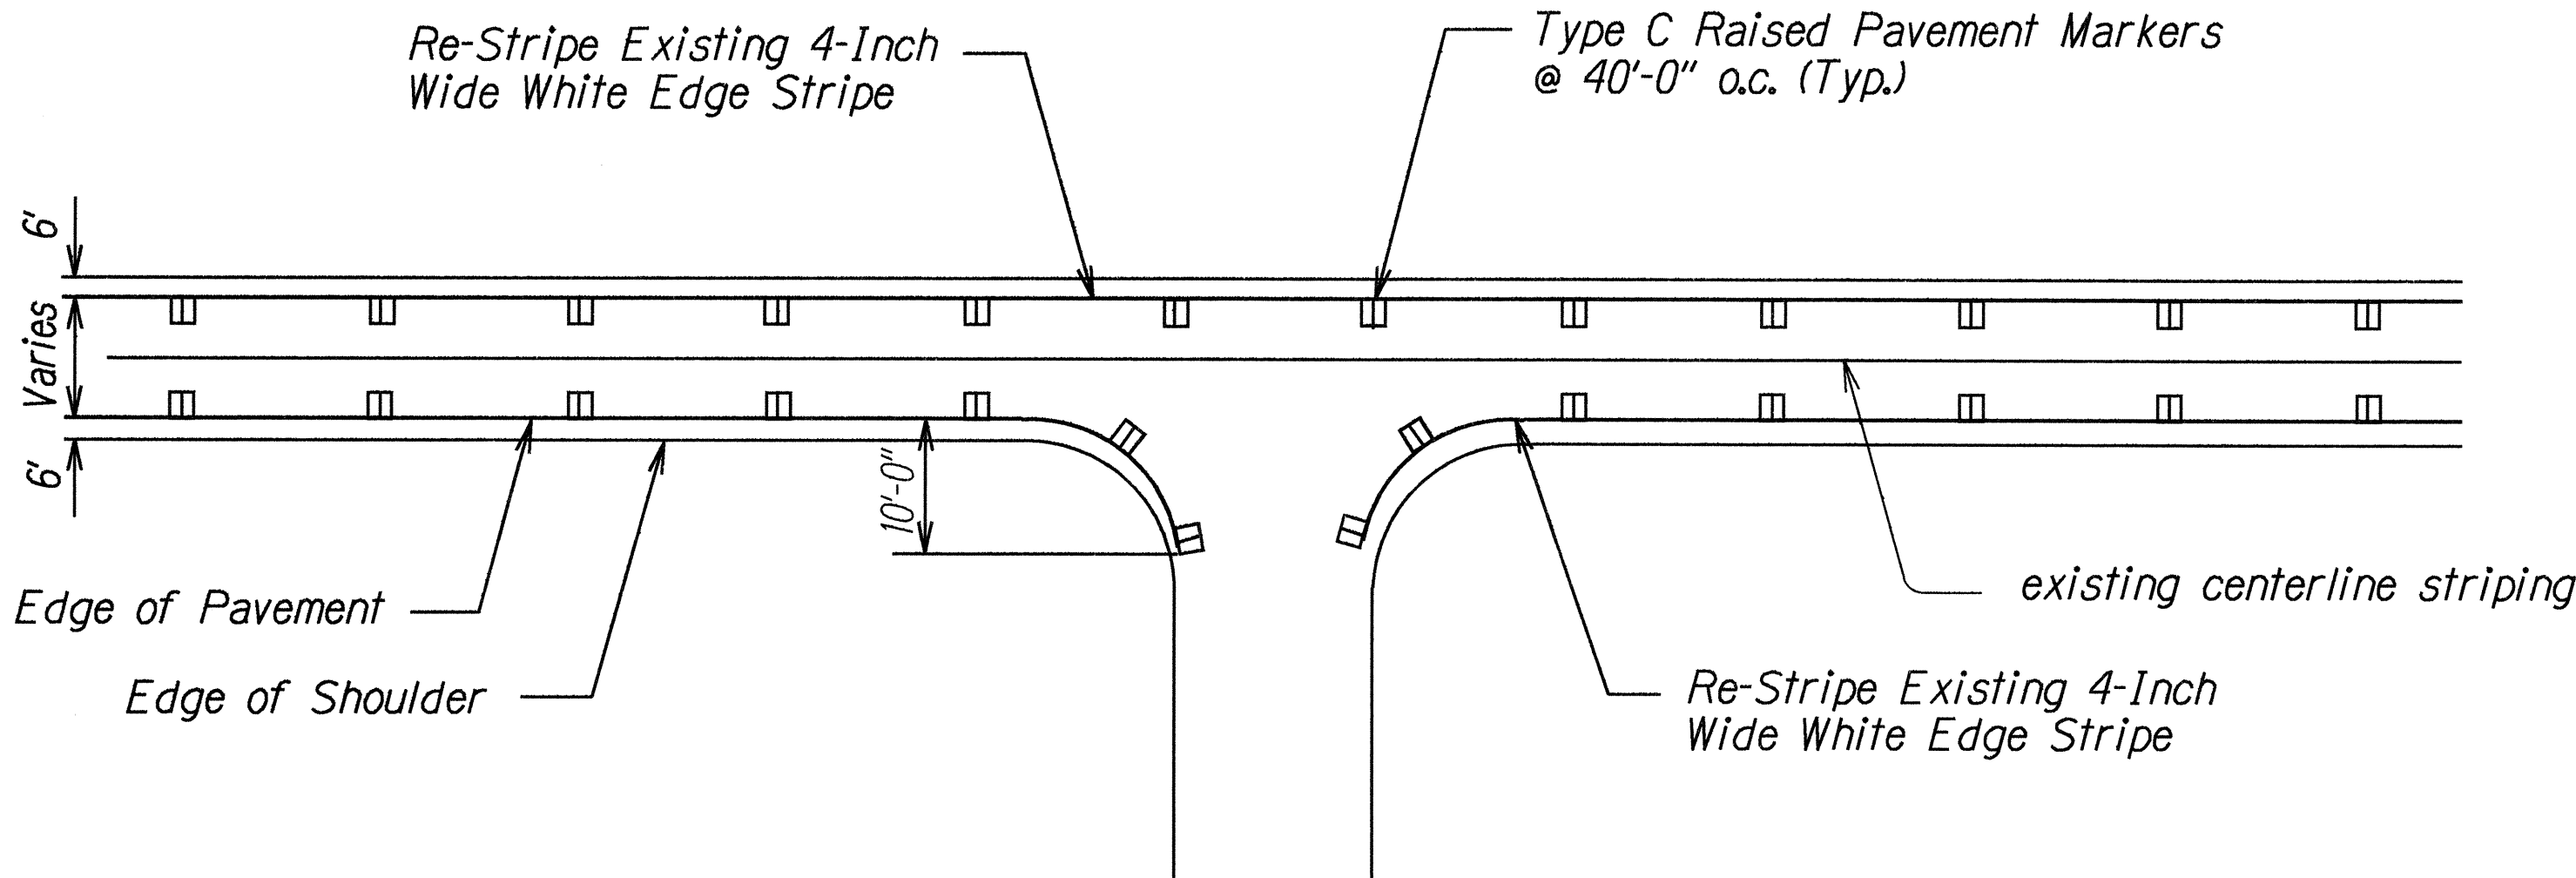

TYPICAL EDGE STRIPING DETAIL

Not To Scale

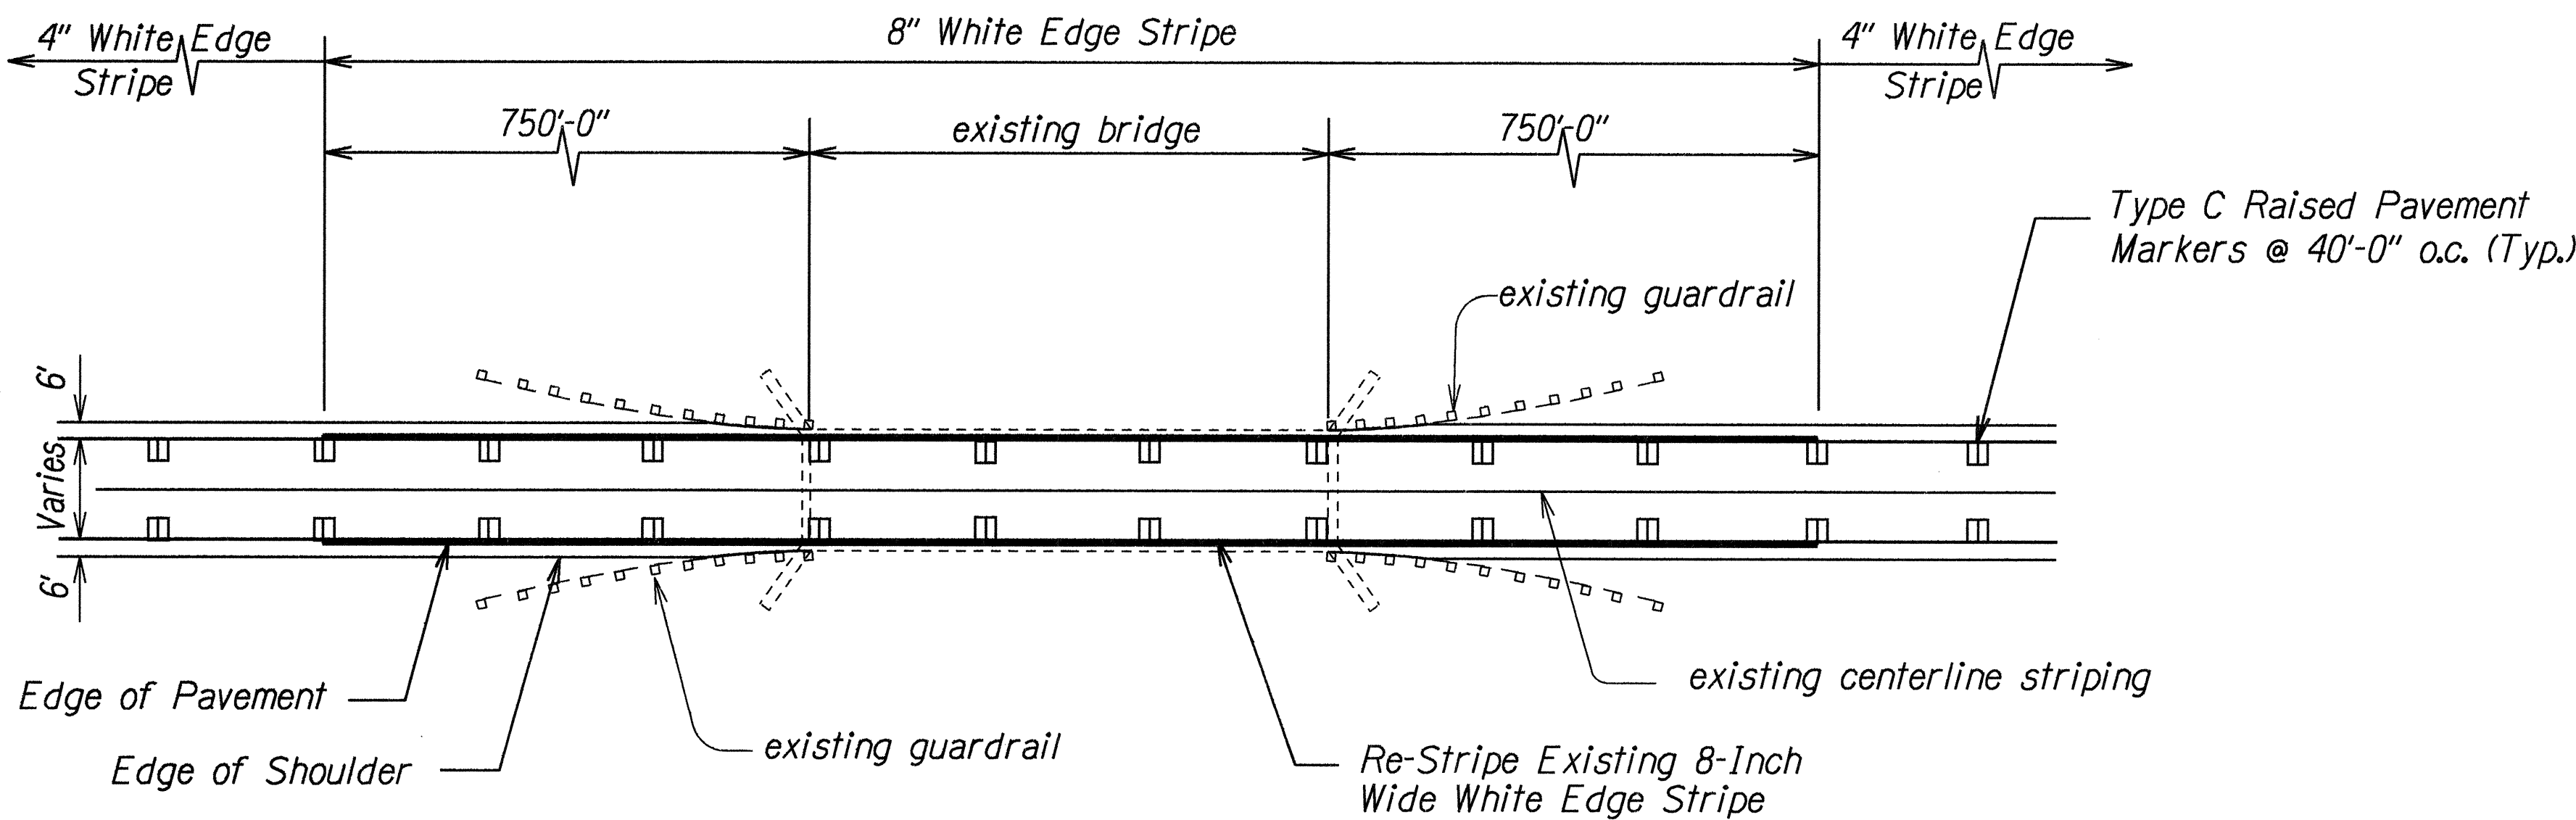

TYPICAL EDGE STRIPING DETAIL AT BRIDGE APPROACHES

Not To Scale

SUMMARY OF ESTIMATED QUANTITIES

ITEM	QUANTITY
ROADWAY EXCAVATION	2,777 <del>3,800</del> C.Y.
AGGREGATE BASE	2,083 <del>2,850</del> C.Y.
A.C., MIX IV	1,708 <del>1,820</del> T.
4-INCH WHITE EDGE STRIPE	52,000 L.F.
8-INCH WHITE EDGE STRIPE	7,000 L.F.
TYPE C PAVEMENT MARKER	1,450 EA.
CONSTRUCTION SIGN WITH POSTS	4 EA.
BIKE ROUTE SIGN WITH POST	4 EA.
BIKE ROUTE SIGN WITH POST AND SUPPLEMENTARY PLATE	4 EA.

SUMMARY OF RELOCATED TRAFFIC SIGNS

DESCRIPTION	QUANTITY
SIGNS 10 SQUARE FEET OR LESS	11 <del>25</del> EACH
SIGNS GREATER THAN 10 SQ. FT.	10 <del>20</del> EACH
MILE POST MARKERS	4 EACH

LIST OF BRIDGES

NAME OF BRIDGE	MILE POST LOCATION
Lihue Mill Bridge	M.P. 0.22
Hoinakaunalehua Stream Bridge	M.P. 2.64
Huleia Stream Bridge	M.P. 4.91

LEGEND FOR AS-BUILT POSTINGS

~~~~~	Squiggly line for as-built deletion
==	Double line for as-built deletion
Roadway	Text for as-built posting

STATE OF HAWAII  
DEPARTMENT OF TRANSPORTATION  
HIGHWAYS DIVISION

PAVEMENT MARKING  
LEGEND, DETAILS & NOTES  
KAUMUALII HIGHWAY BIKEWAY  
IMPROVEMENTS

Huleia Stream Bridge to Rice Street  
Federal Aid Project No. STP-050-1(19)  
Scale: None Date: May, 1997

SHEET No. 1 OF 1 SHEETS