

INDEX TO DRAWINGS	
SHEET NO.	DESCRIPTION
1	TITLE SHEET
2	STANDARD PLANS SUMMARY
3	GENERAL NOTES AND LEGEND
4	TYPICAL SECTIONS
5	TYPICAL PLAN AT BRIDGES
6	RAILING TYPICAL SECTIONS & DETAILS
7 - 8	ROADWAY PLAN
9	SHOULDER CONDITIONS
10	PAVEMENT MARKING LEGEND, DETAILS & NOTES

STATE OF HAWAII

DEPARTMENT OF TRANSPORTATION

HIGHWAYS DIVISION

HONOLULU, HAWAII

"AS-BUILT"

PLANS FOR



KAUMUALII HIGHWAY BIKEWAY IMPROVEMENTS

HULEIA STREAM BRIDGE TO RICE STREET

FEDERAL AID PROJECT NO. STP-050-1(19)

DISTRICTS OF KOLOA AND LIHUE

ISLAND OF KAUAI

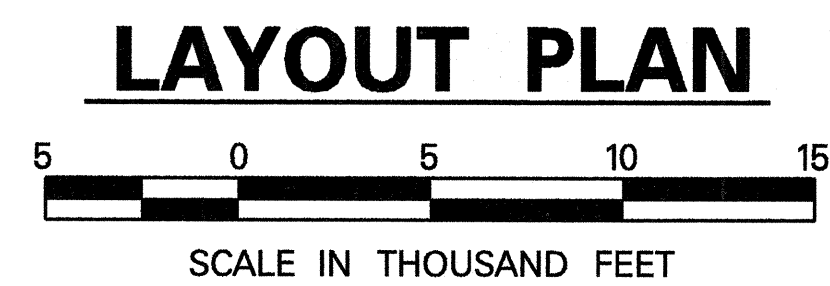
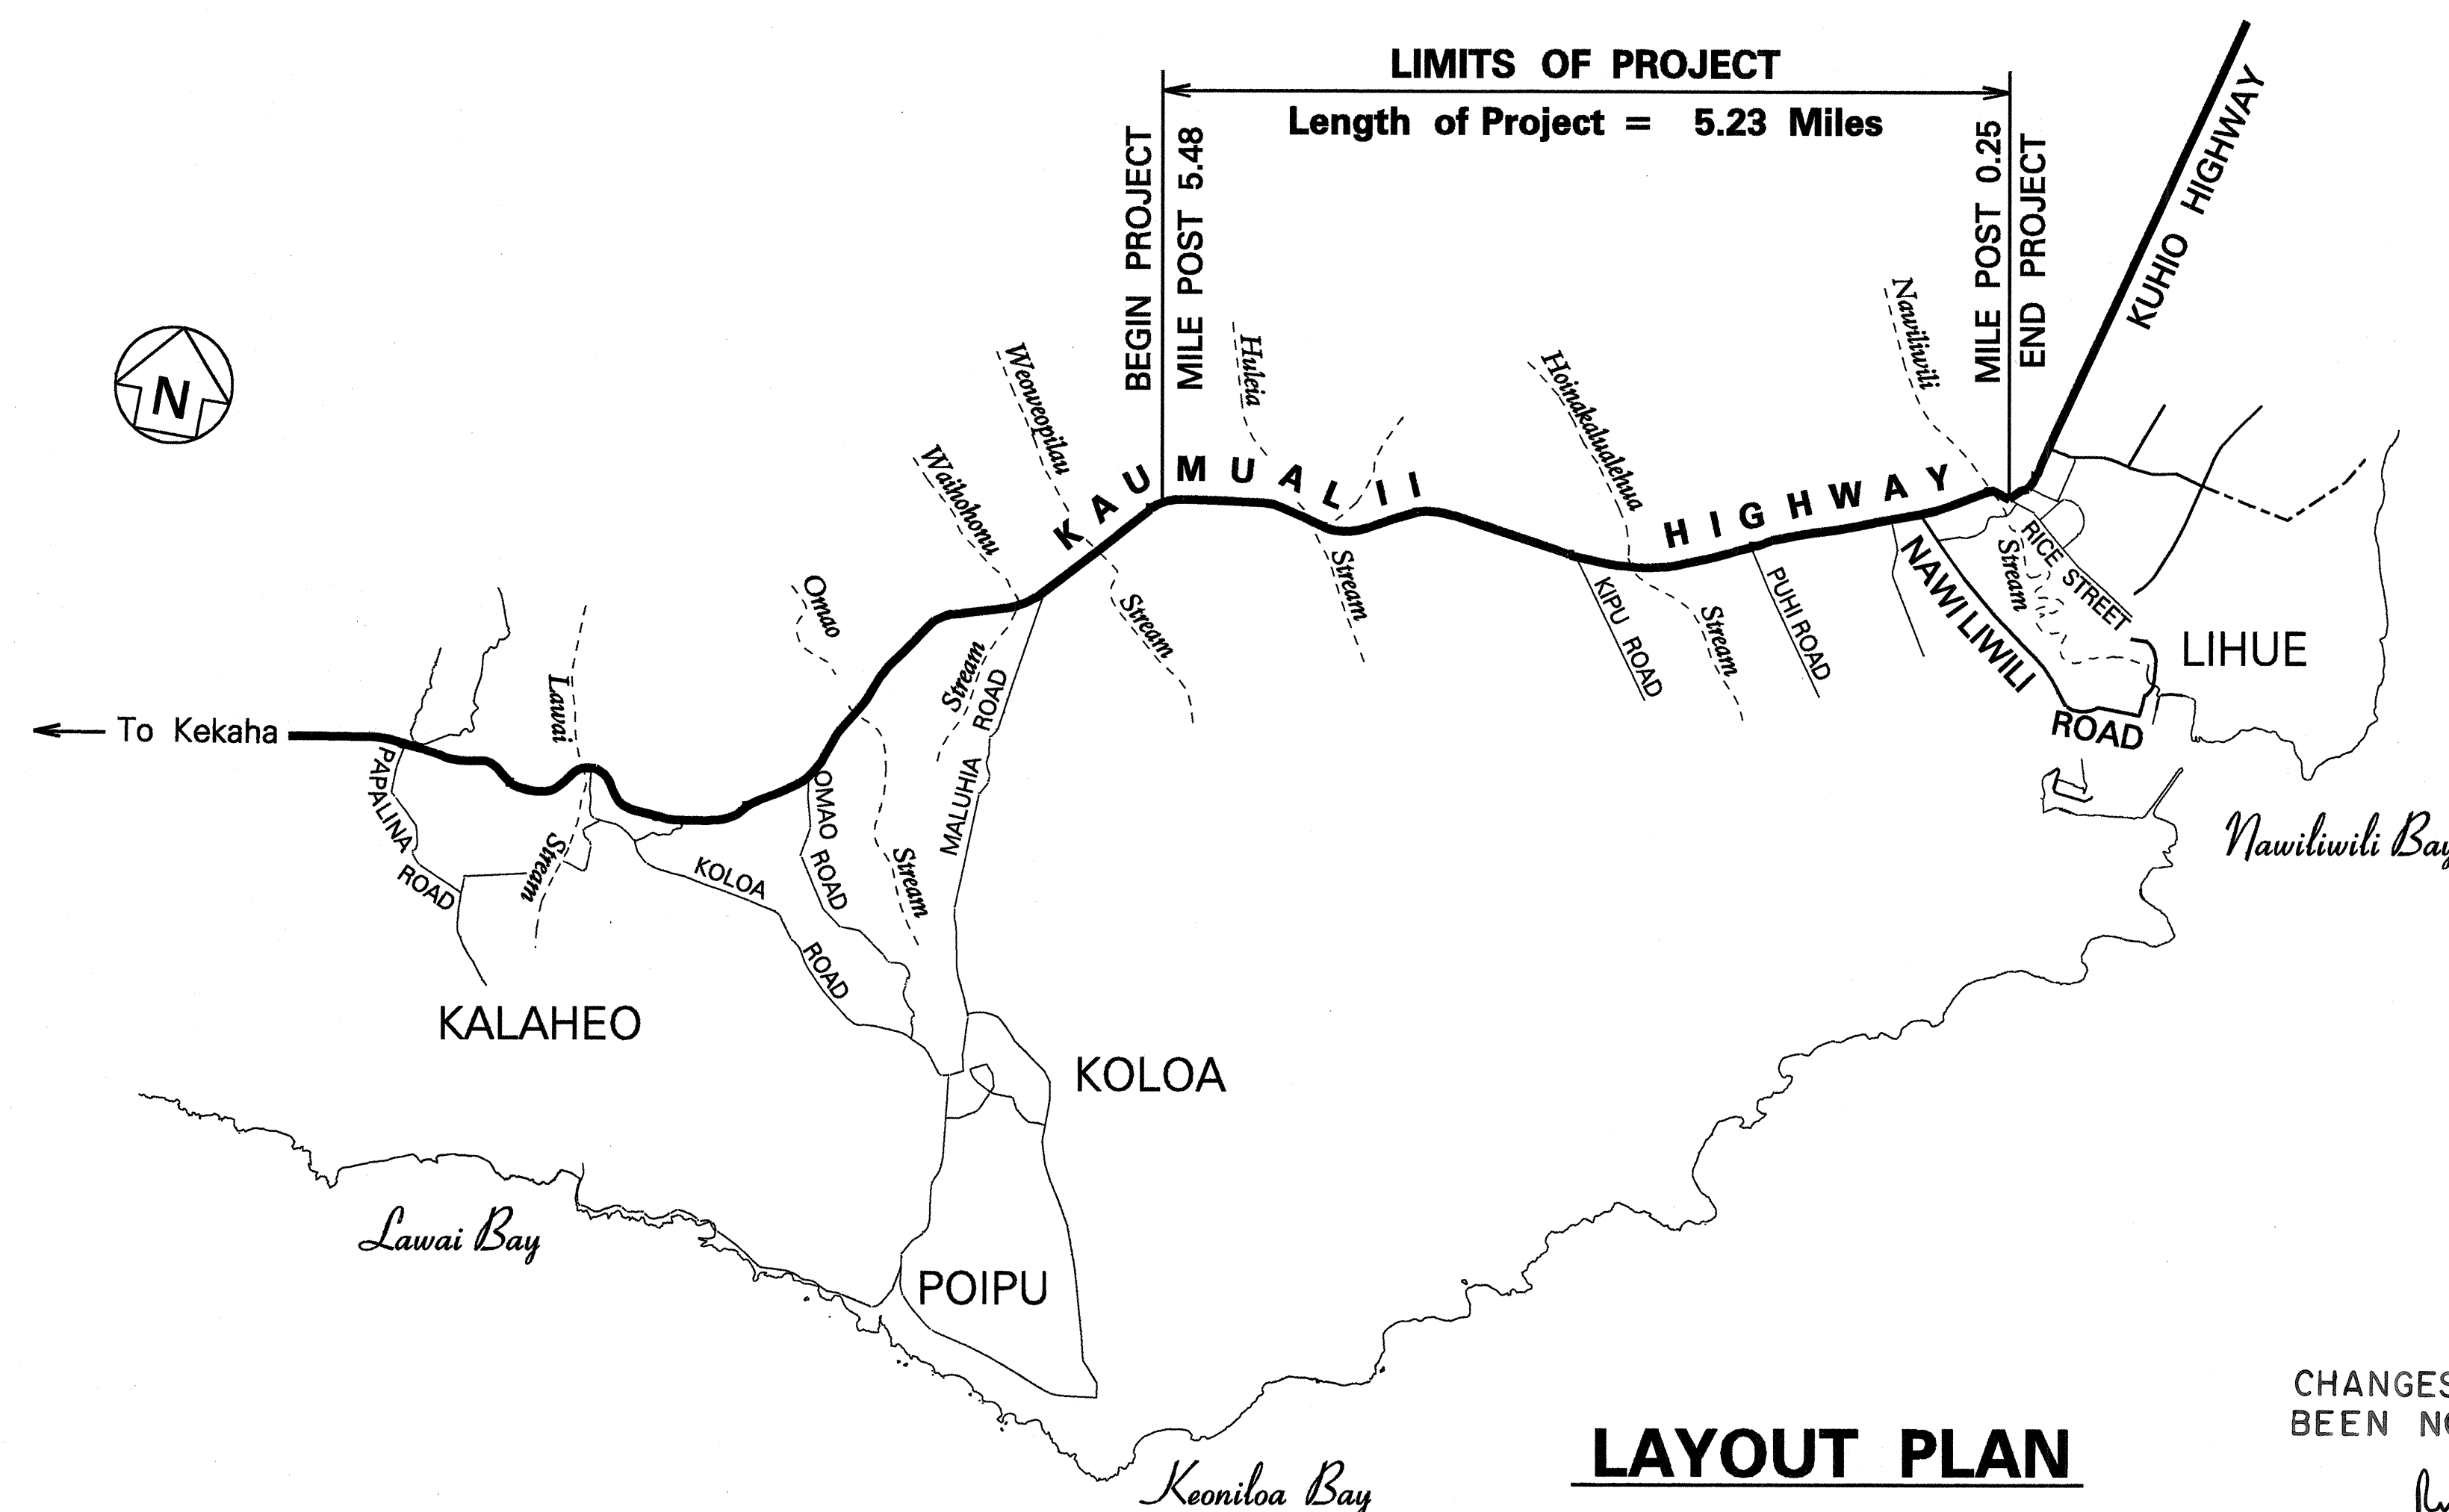


CHANGES MADE DURING CONSTRUCTION HAVE BEEN NOTED ON THESE PLANS AND CHECKED BY:

[Signature]
RESIDENT ENGINEER

2/17/99
DATE

FED. ROAD DIST. NO.	STATE	FED. AID PROJ. NO.	FISCAL YEAR	SHEET NO.	TOTAL SHEETS
HAWAII	HAW.	STP-050-1(19)	1998	1	10

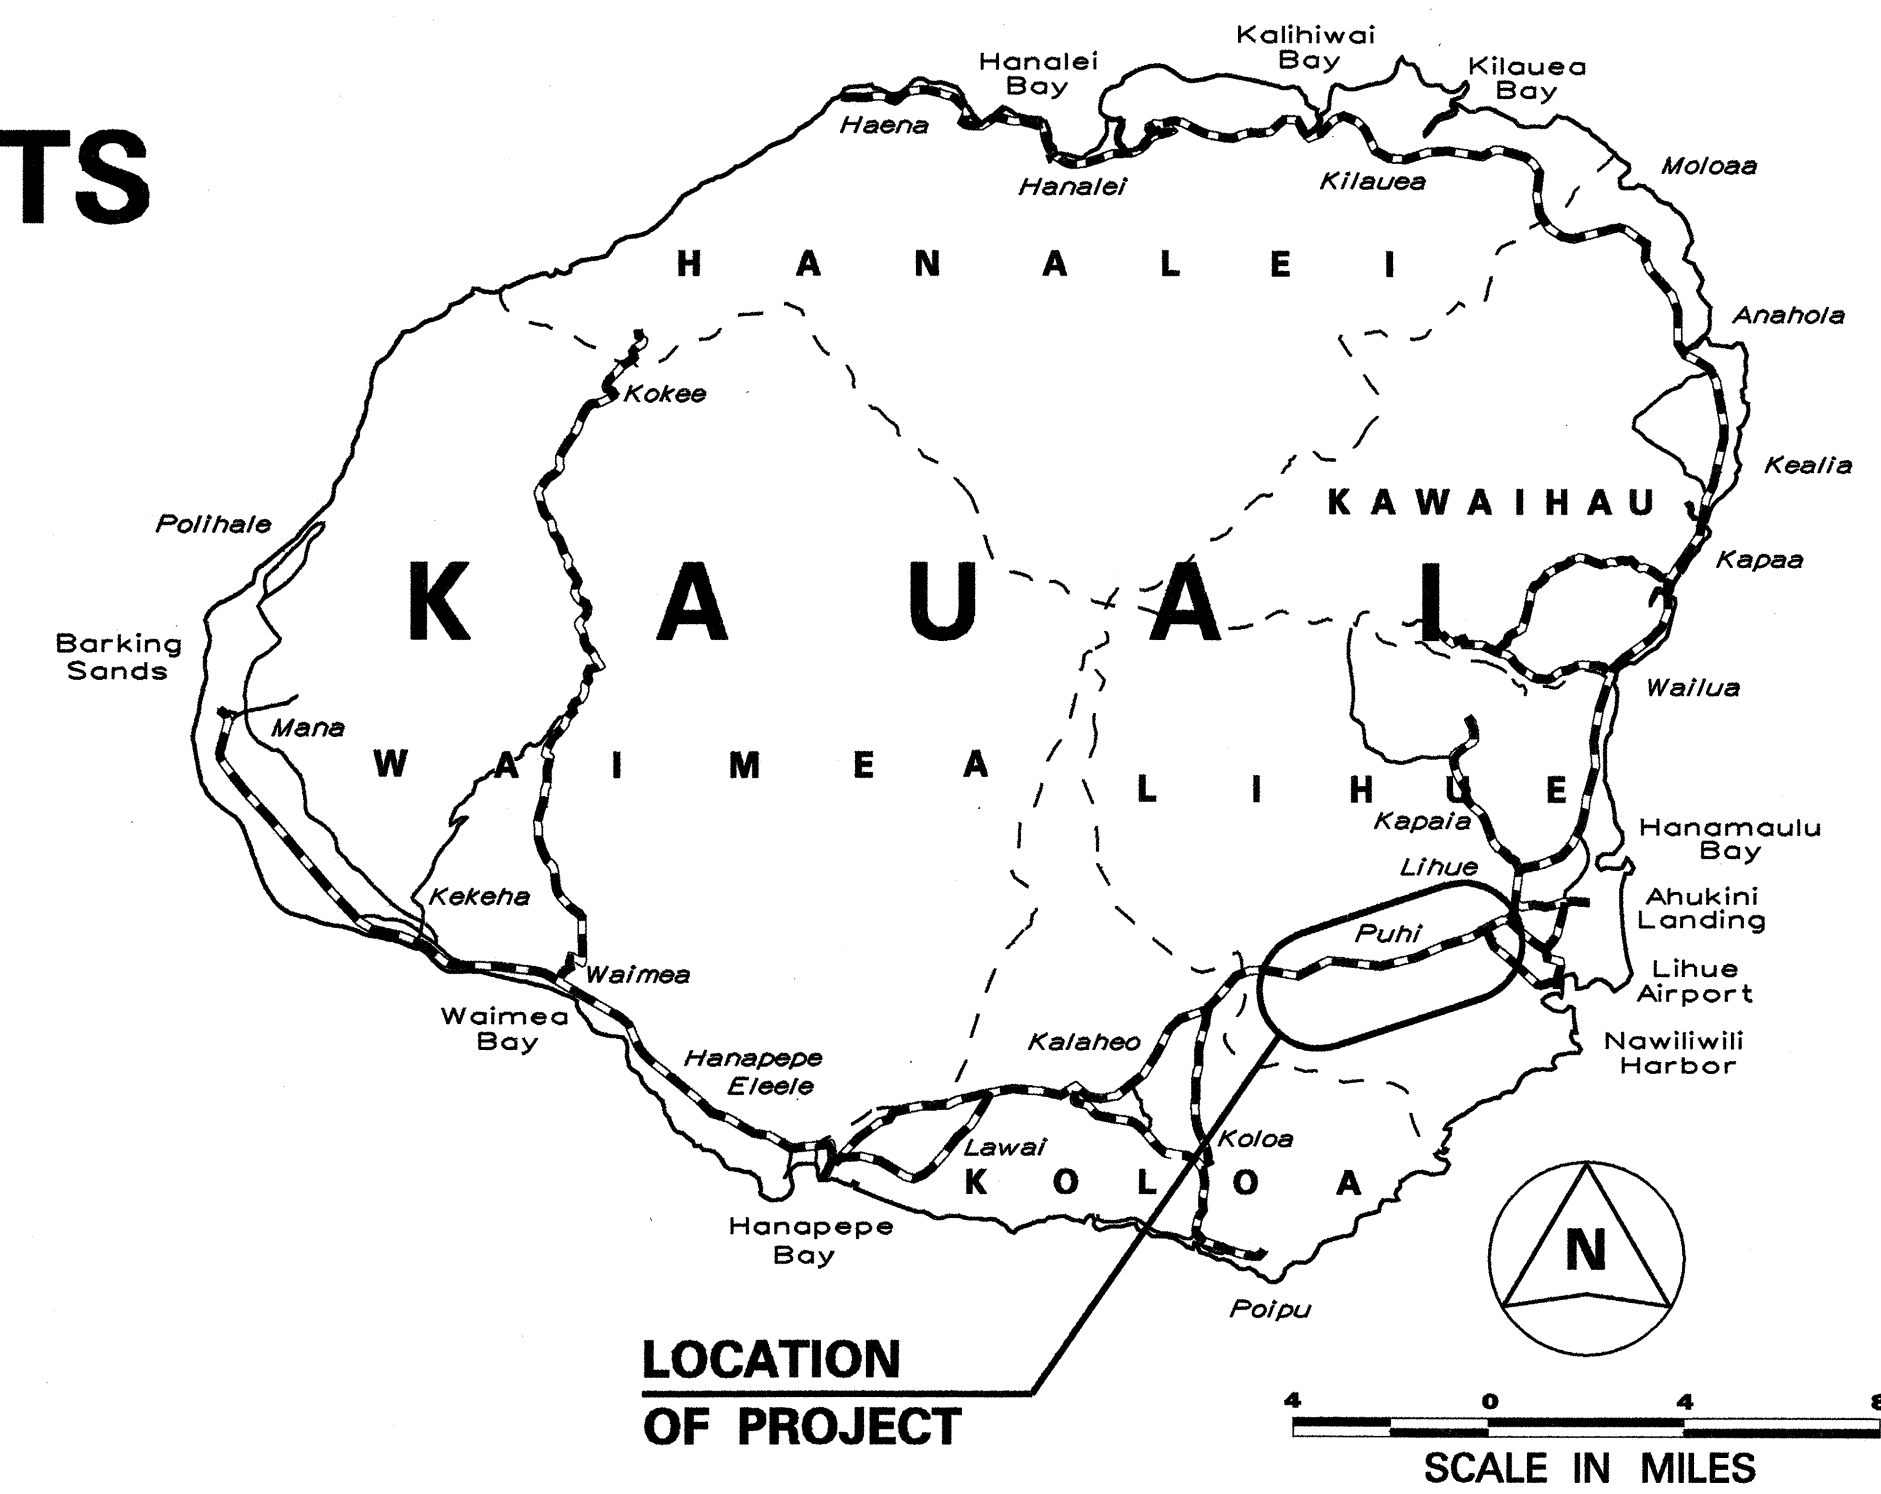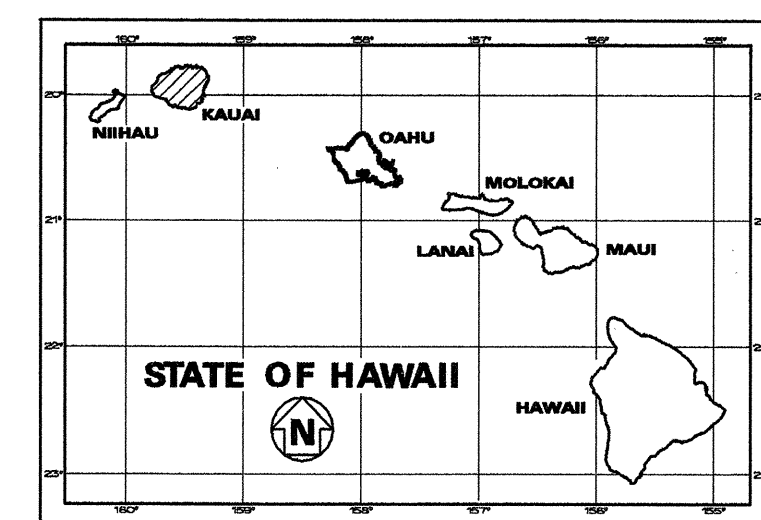

----- FEDERAL AID PROJECTS PREVIOUSLY CONSTRUCTED OR UNDER CONSTRUCTION

MILE POST 5.48 TO MILE POST 0.25

DESIGN DESIGNATION

ADT (1997)	20,330
ADT (2017)	25,460
DHV	2,165
D	55/45
T	4.0 %
V	50 M.P.H.

DEPARTMENT OF TRANSPORTATION STATE OF HAWAII	
APPROVED:	
<i>[Signature]</i>	8/13/97
DIR. OF TRANSPORTATION	DATE

DESIGNED BY
HWY-K
J. FUJIMOTO
P.S. & E.BY
587-2249
PHONE
MAY, 1997
DATE