	INDEX TO DRAWINGS						
SHEET NO.	DESCRIPTION						
1	TITLE SHEET						
2	STANDARD PLANS SUMMARY						
3	CONSTRUCTION NOTES, LEGEND, AND ABBREVIATIONS						
4	ROADWAY PLAN						
5	SIGNING AND STRIPING PLAN						
6	MISCELLANEOUS DETAILS						
7	MISCELLANEOUS DETAILS						
8	TRAFFIC SIGNAL LEGEND, NOTES, AND DETAILS						
9	TRAFFIC SIGNAL PLAN						
10	TRAFFIC SIGNAL DETAILS						
11	SIGN MOUNTING DETAILS						

STATE OF HAWAII

DEPARTMENT OF TRANSPORTATION

HIGHWAYS DIVISION HONOLULU, HAWAII


"AS-BUILT"

PLANS FOR

KAUMUALII HIGHWAY IMPROVEMENTS AT MOI ROAD


FEDERAL AID PROJECT NO. STP-050-1(14)


DISTRICT OF WAIMEA ISLAND OF KAUAI

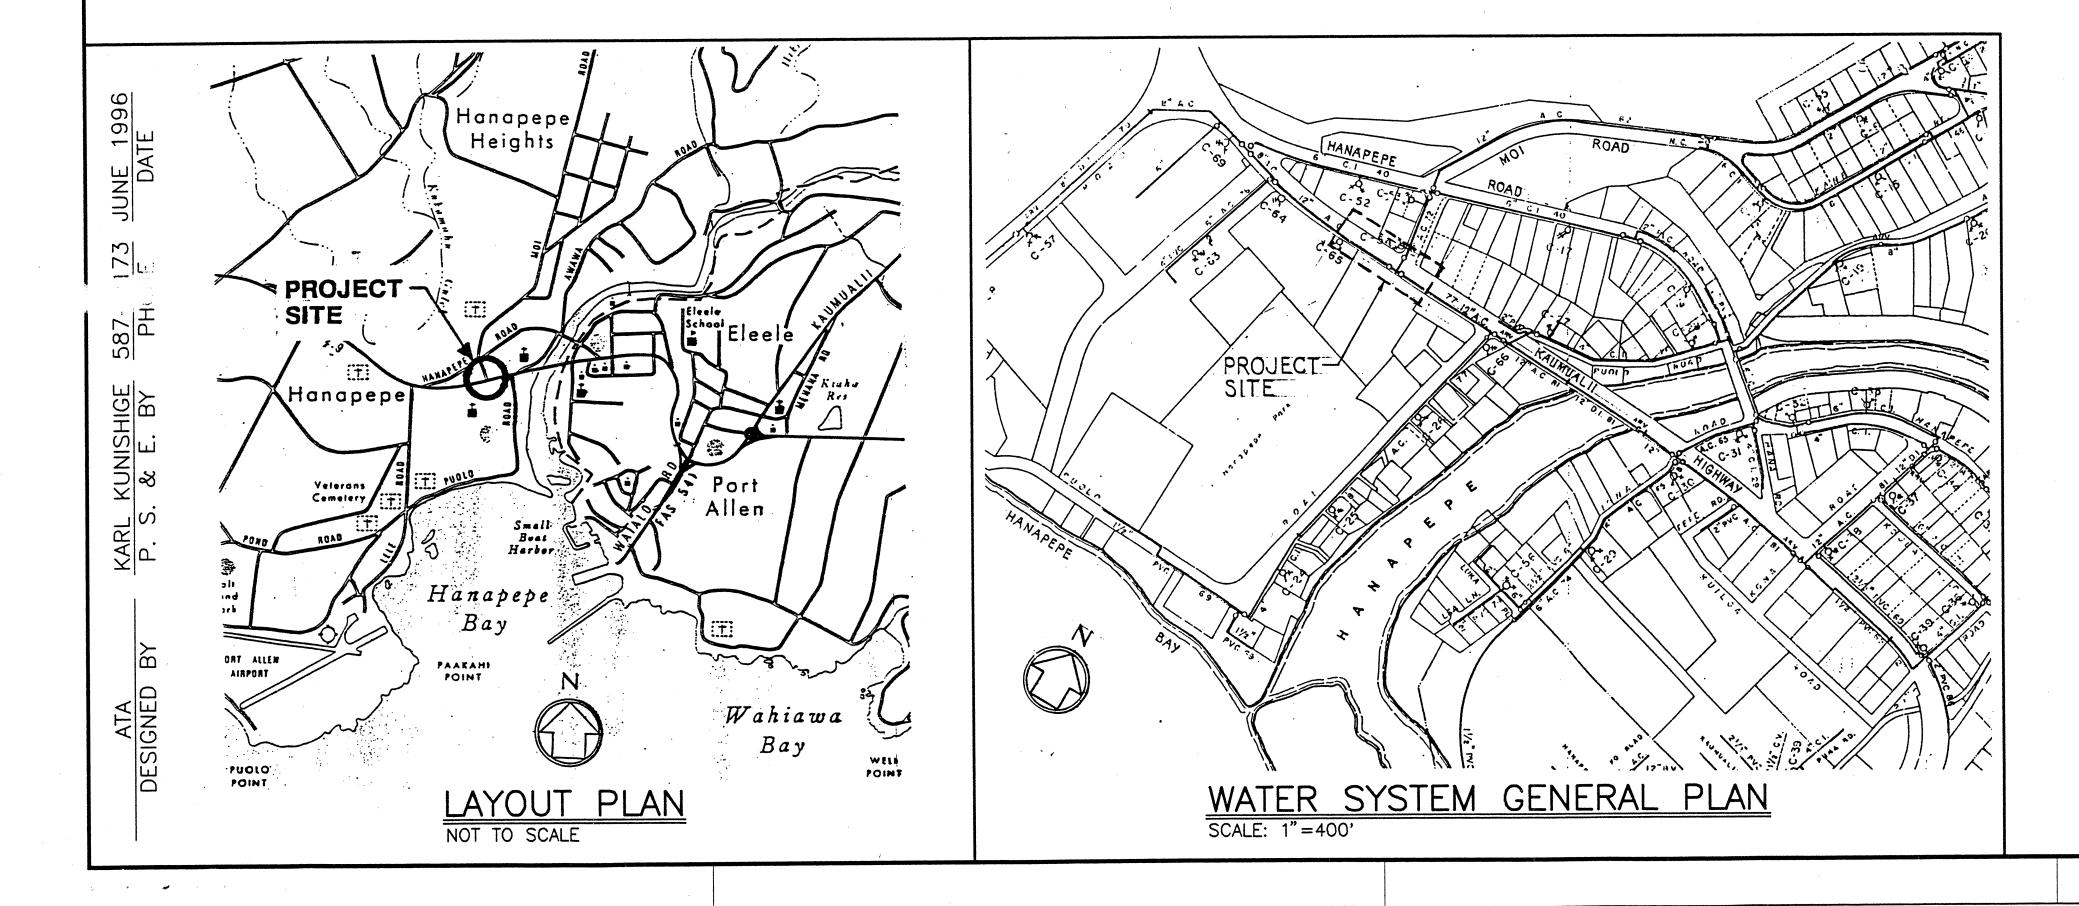

FED. ROAD DIST. NO.	STATE	FED. AID PROJ. NO.	FISCAL YEAR	SHEET NO.	TOTAL SHEETS
HAWAII	HAW.	STP-050-1(14)	1997	1	11



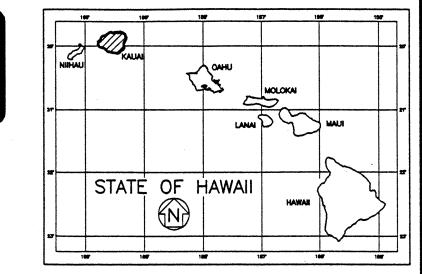

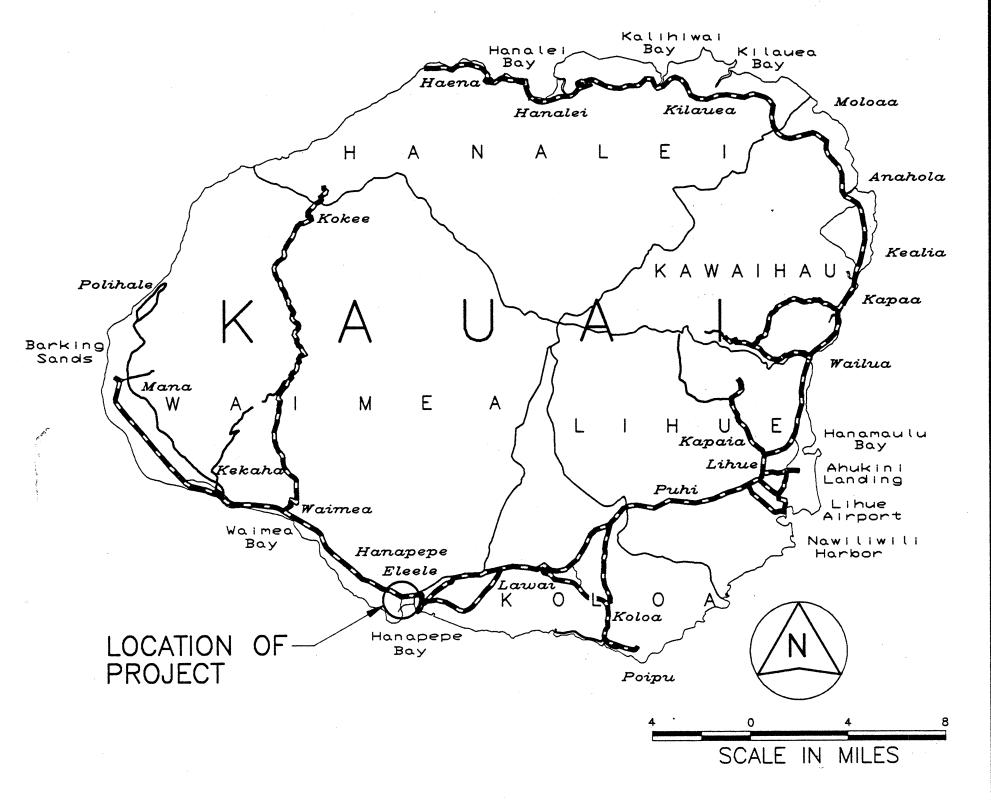

FEDERAL AID PROJECTS PREVIOUSLY CONSTRUCTED OR UNDER CONSTRUCTION

MILE POST 16.75 TO MILE POST 16.95

CHANGES MADE DURING CONSTRUCTION HAVE BEEN INCORPORATED ON THESE PLANS EXCEPT CHANGES IN THE ORIGINAL THEORETICAL QUANTITIES. FOR ACTUAL QUANTITIES REFER TO PROJECT LEDGER AND OR COMPUTATION BOOK.

Bulu Bort

9/29/98

PROJECT ENGINEER

DATE

DEPARTMENT OF TRANSPORTATION
STATE OF HAWAII

APPROVED:

Lagn Gayashide 1/16/97

DIR. OF TRANSPORTATION DATE