


FED. ROAD DIST. NO.	STATE	FED. AID PROJ. NO.	FISCAL YEAR	SHEET NO.	TOTAL SHEETS
HAWAII	HAWAII	STP-050-1(14)	1997	9	11

NOTES:

- ALL CABLE AND ELEMENTS FOR GROUNDING SHALL BE NEW.
- TYPE 5 CABLE (SEE SPECIALS) BETWEEN SIGNAL FACE AND PULLBOX ARE NOT CALLED OUT ON THE PLAN, BUT SHALL BE FURNISHED AND INSTALLED IN SUFFICIENT NUMBERS AND LENGTHS AS REQUIRED. COST SHALL BE INCIDENTAL TO THE INSTALLATION OF THE SIGNAL HEADS.
- TYPE 2 CABLE BETWEEN THE PEDESTRIAN PUSH BUTTON AND THE PULLBOX ARE NOT CALLED OUT ON THE PLAN, BUT SHALL BE FURNISHED IN SUFFICIENT LENGTH AS REQUIRED. COST SHALL BE INCIDENTAL TO THE INSTALLATION OF THE PEDESTRIAN PUSH BUTTON.
- CONDUITS BETWEEN THE TRAFFIC SIGNAL STANDARD AND THE PULLBOX SHALL BE IN SUFFICIENT NUMBER AS REQUIRED. COST SHALL BE INCIDENTAL TO THE INSTALLATION OF THE TRAFFIC SIGNAL STANDARD FOUNDATION.

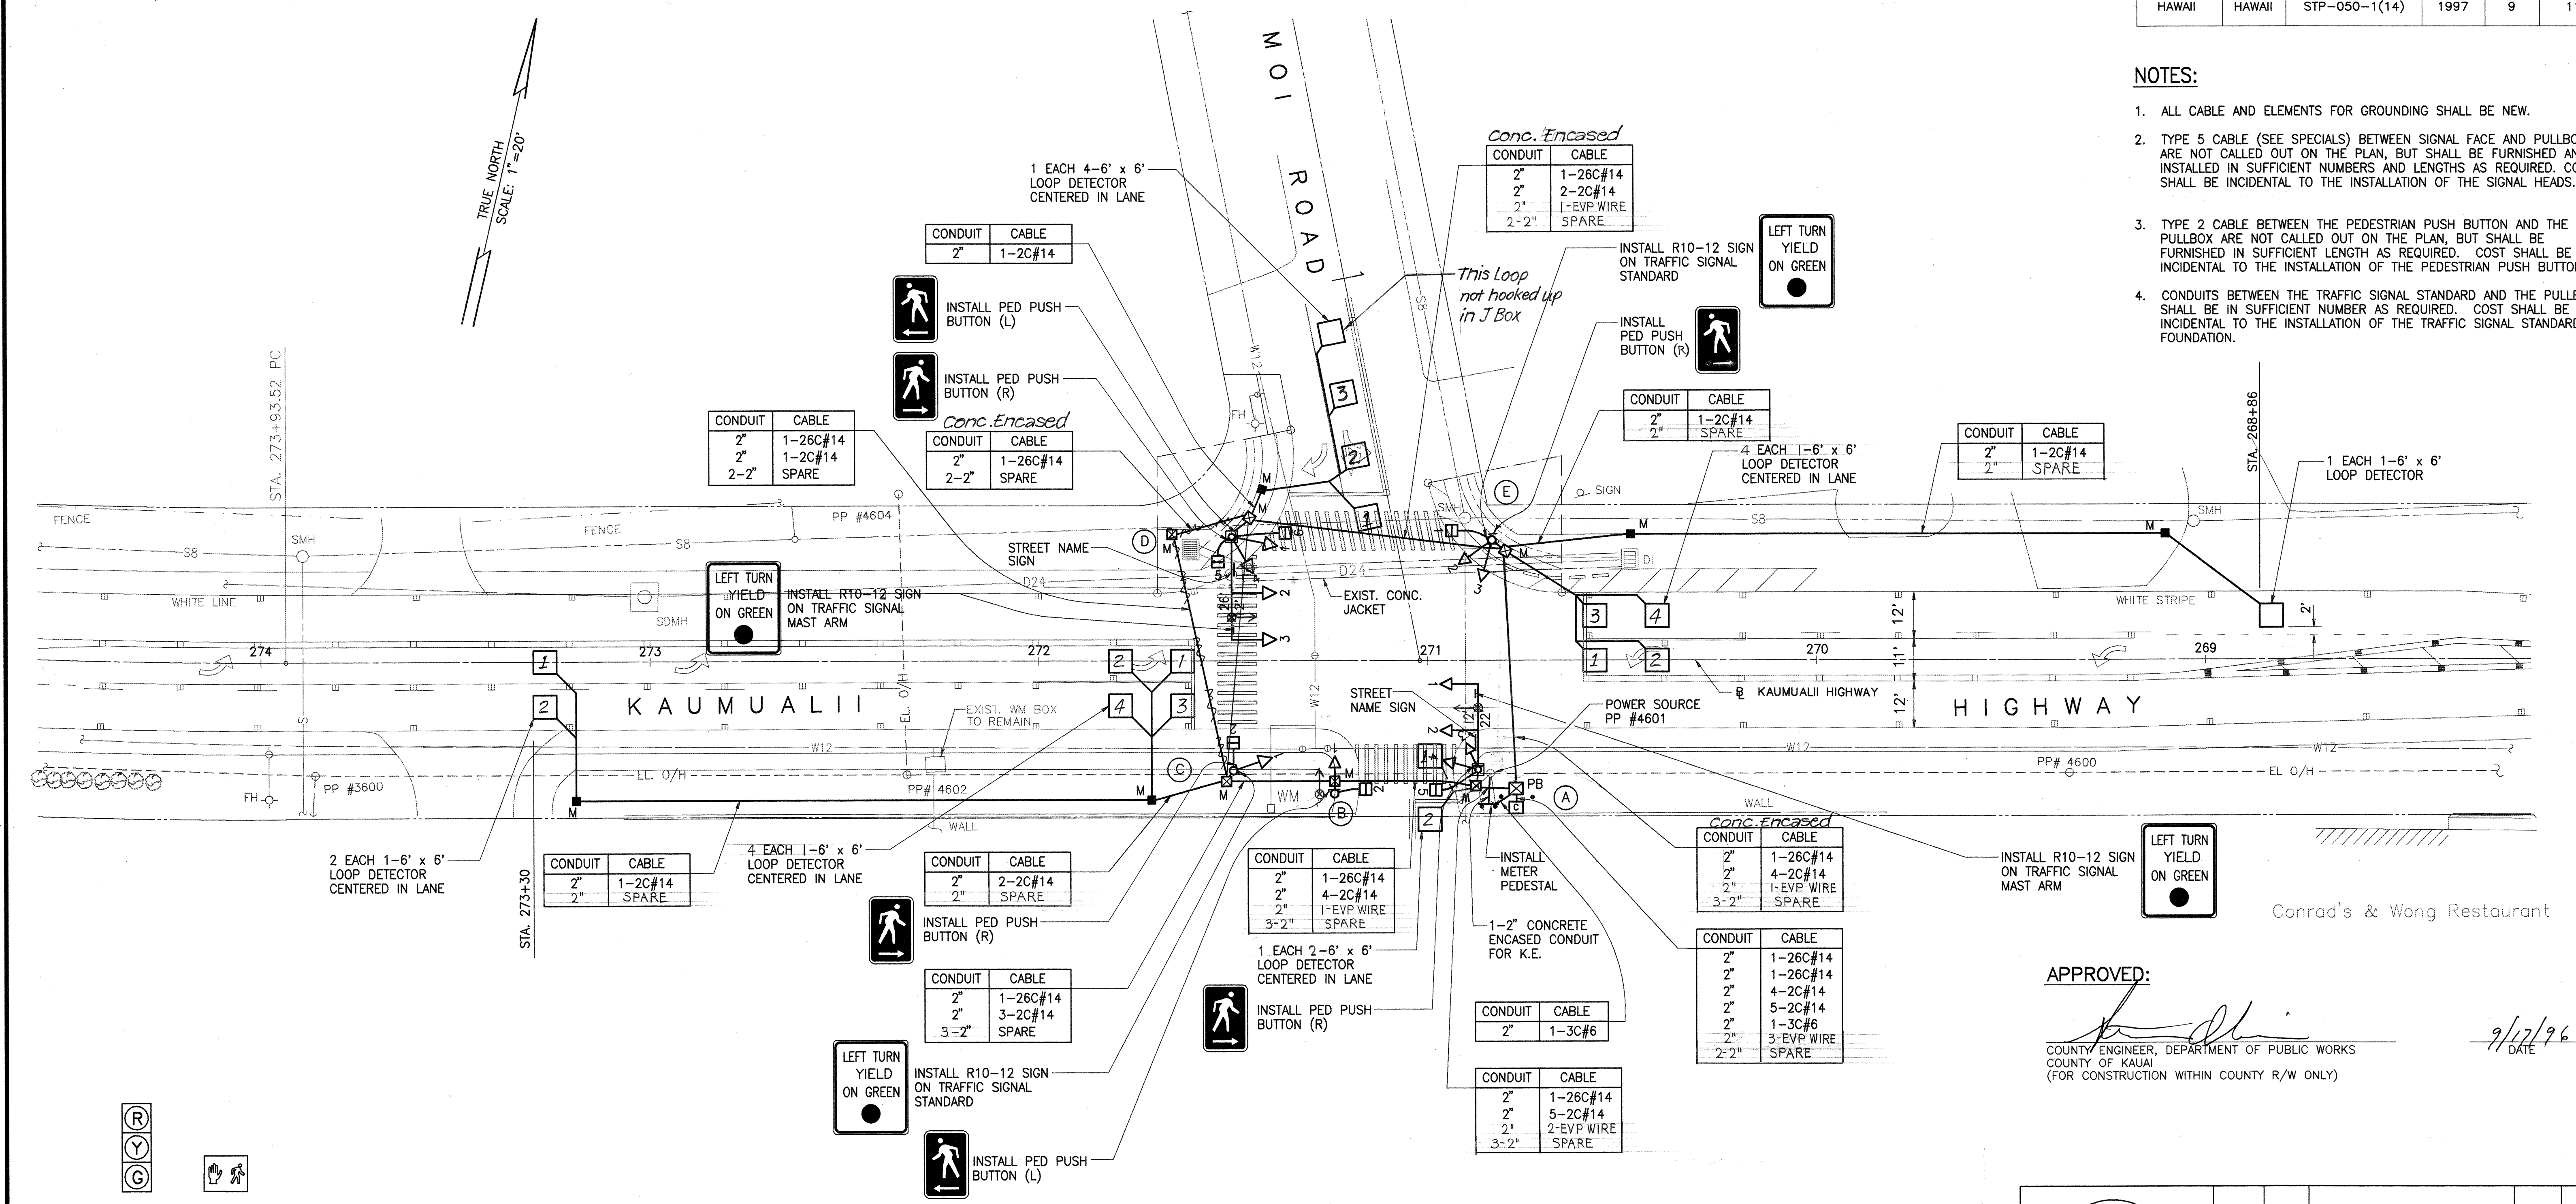

APPROVED:

[Signature]
COUNTY ENGINEER, DEPARTMENT OF PUBLIC WORKS
COUNTY OF KAUAI
(FOR CONSTRUCTION WITHIN COUNTY R/W ONLY)


9/17/96
DATE




- A-1
- A-2
- A-3
- A-4
- B-1
- C-1
- D-1
- D-2
- D-3
- D-4
- E-2
- E-3



- A-5
- B-2
- C-2
- D-5
- D-6
- E-1

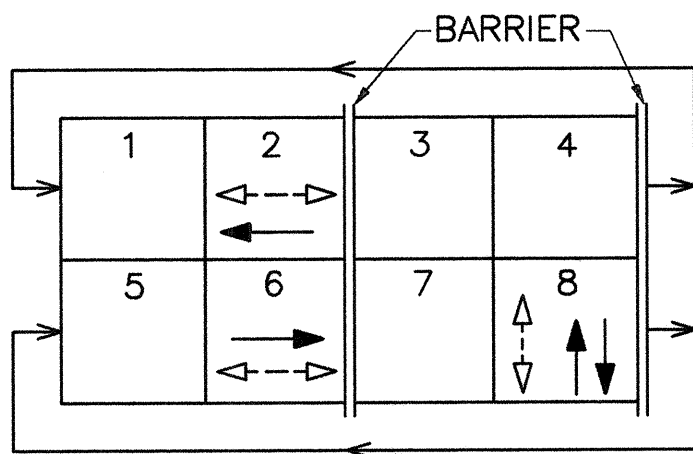


PHASE ASSIGNMENT DIAGRAM
MODEL 170 CONTROLLER
MODEL 332 CABINET

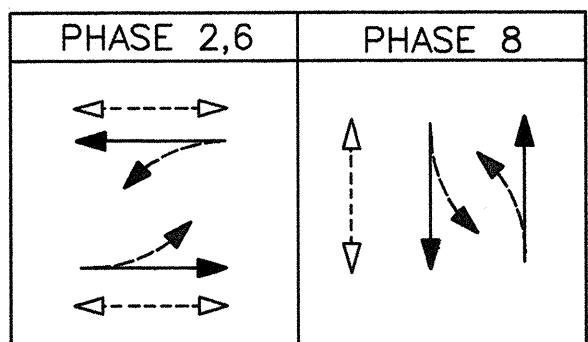

PHASE DIAGRAM

TRAFFIC SIGNAL PLAN

SCALE: 1"=20'

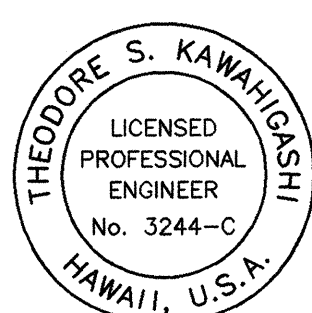

THIS WORK WAS PREPARED BY ME
OR UNDER MY SUPERVISION
Theodore S. Kawahigashi

REVISION	DATE	BRIEF	MADE BY	APPROVED

STATE OF HAWAII
DEPARTMENT OF TRANSPORTATION
HIGHWAYS DIVISION

TRAFFIC SIGNAL PLAN

KAUMUALII HIGHWAY IMPROVEMENTS
AT MOI ROAD
FED. AID PROJECT NO. STP-050-1(14)

SCALE: 1"=20' DATE: APRIL 1997