




FED. ROAD DIST. NO.	STATE	PROJ. NO.	FISCAL YEAR	SHEET NO.	TOTAL SHEETS
HAWAII	HAW.	50B-01-99	2000	7	11

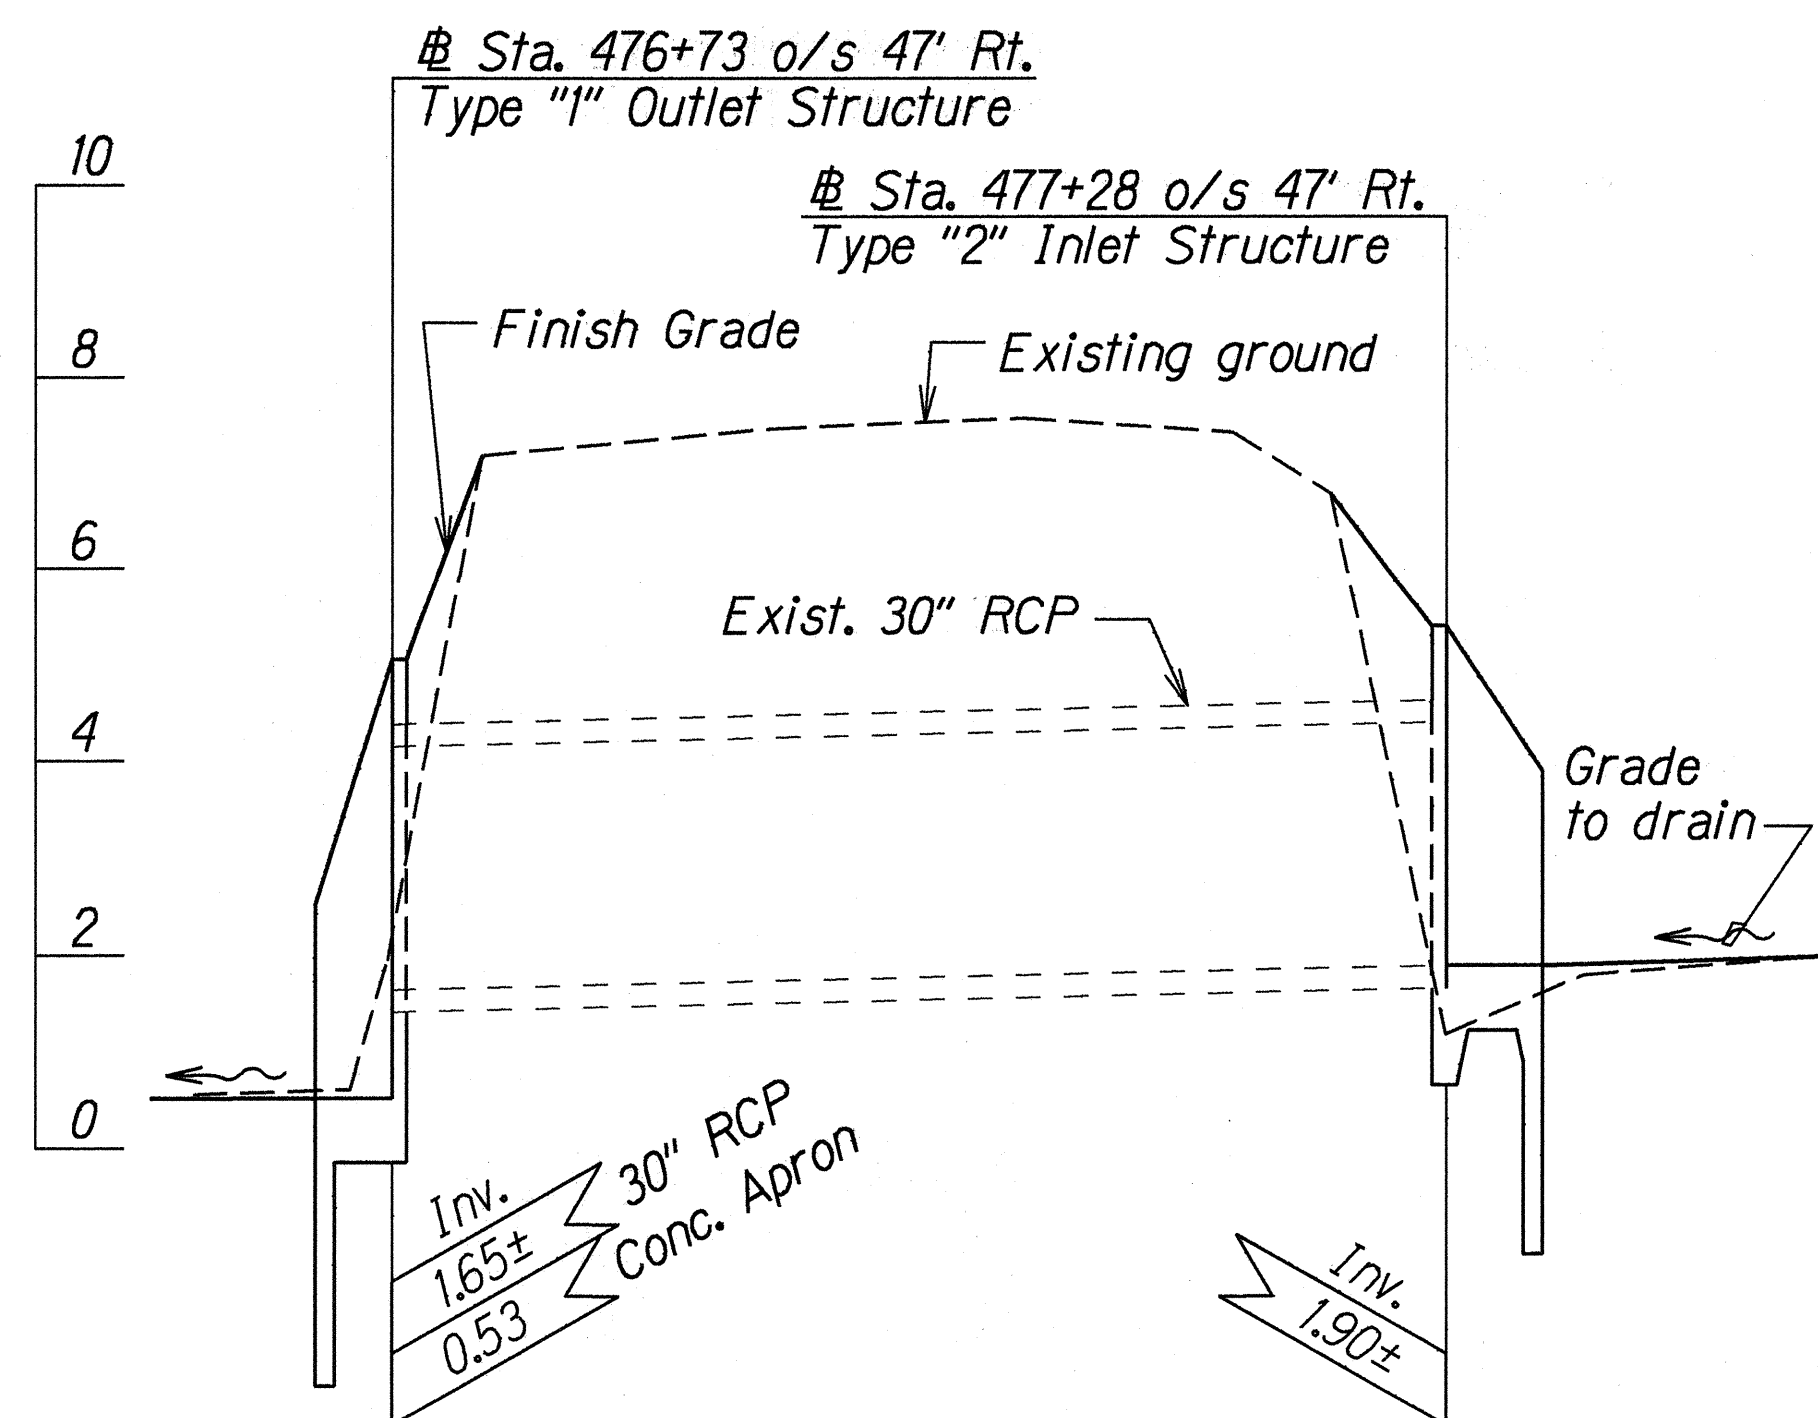


**PROFILE-# STA. 476+73 o/s 47' RT. TO
STA. 477+28 o/s 47' RT.**
Scale: Horiz. 1"=10'
Vert. 1"=2'

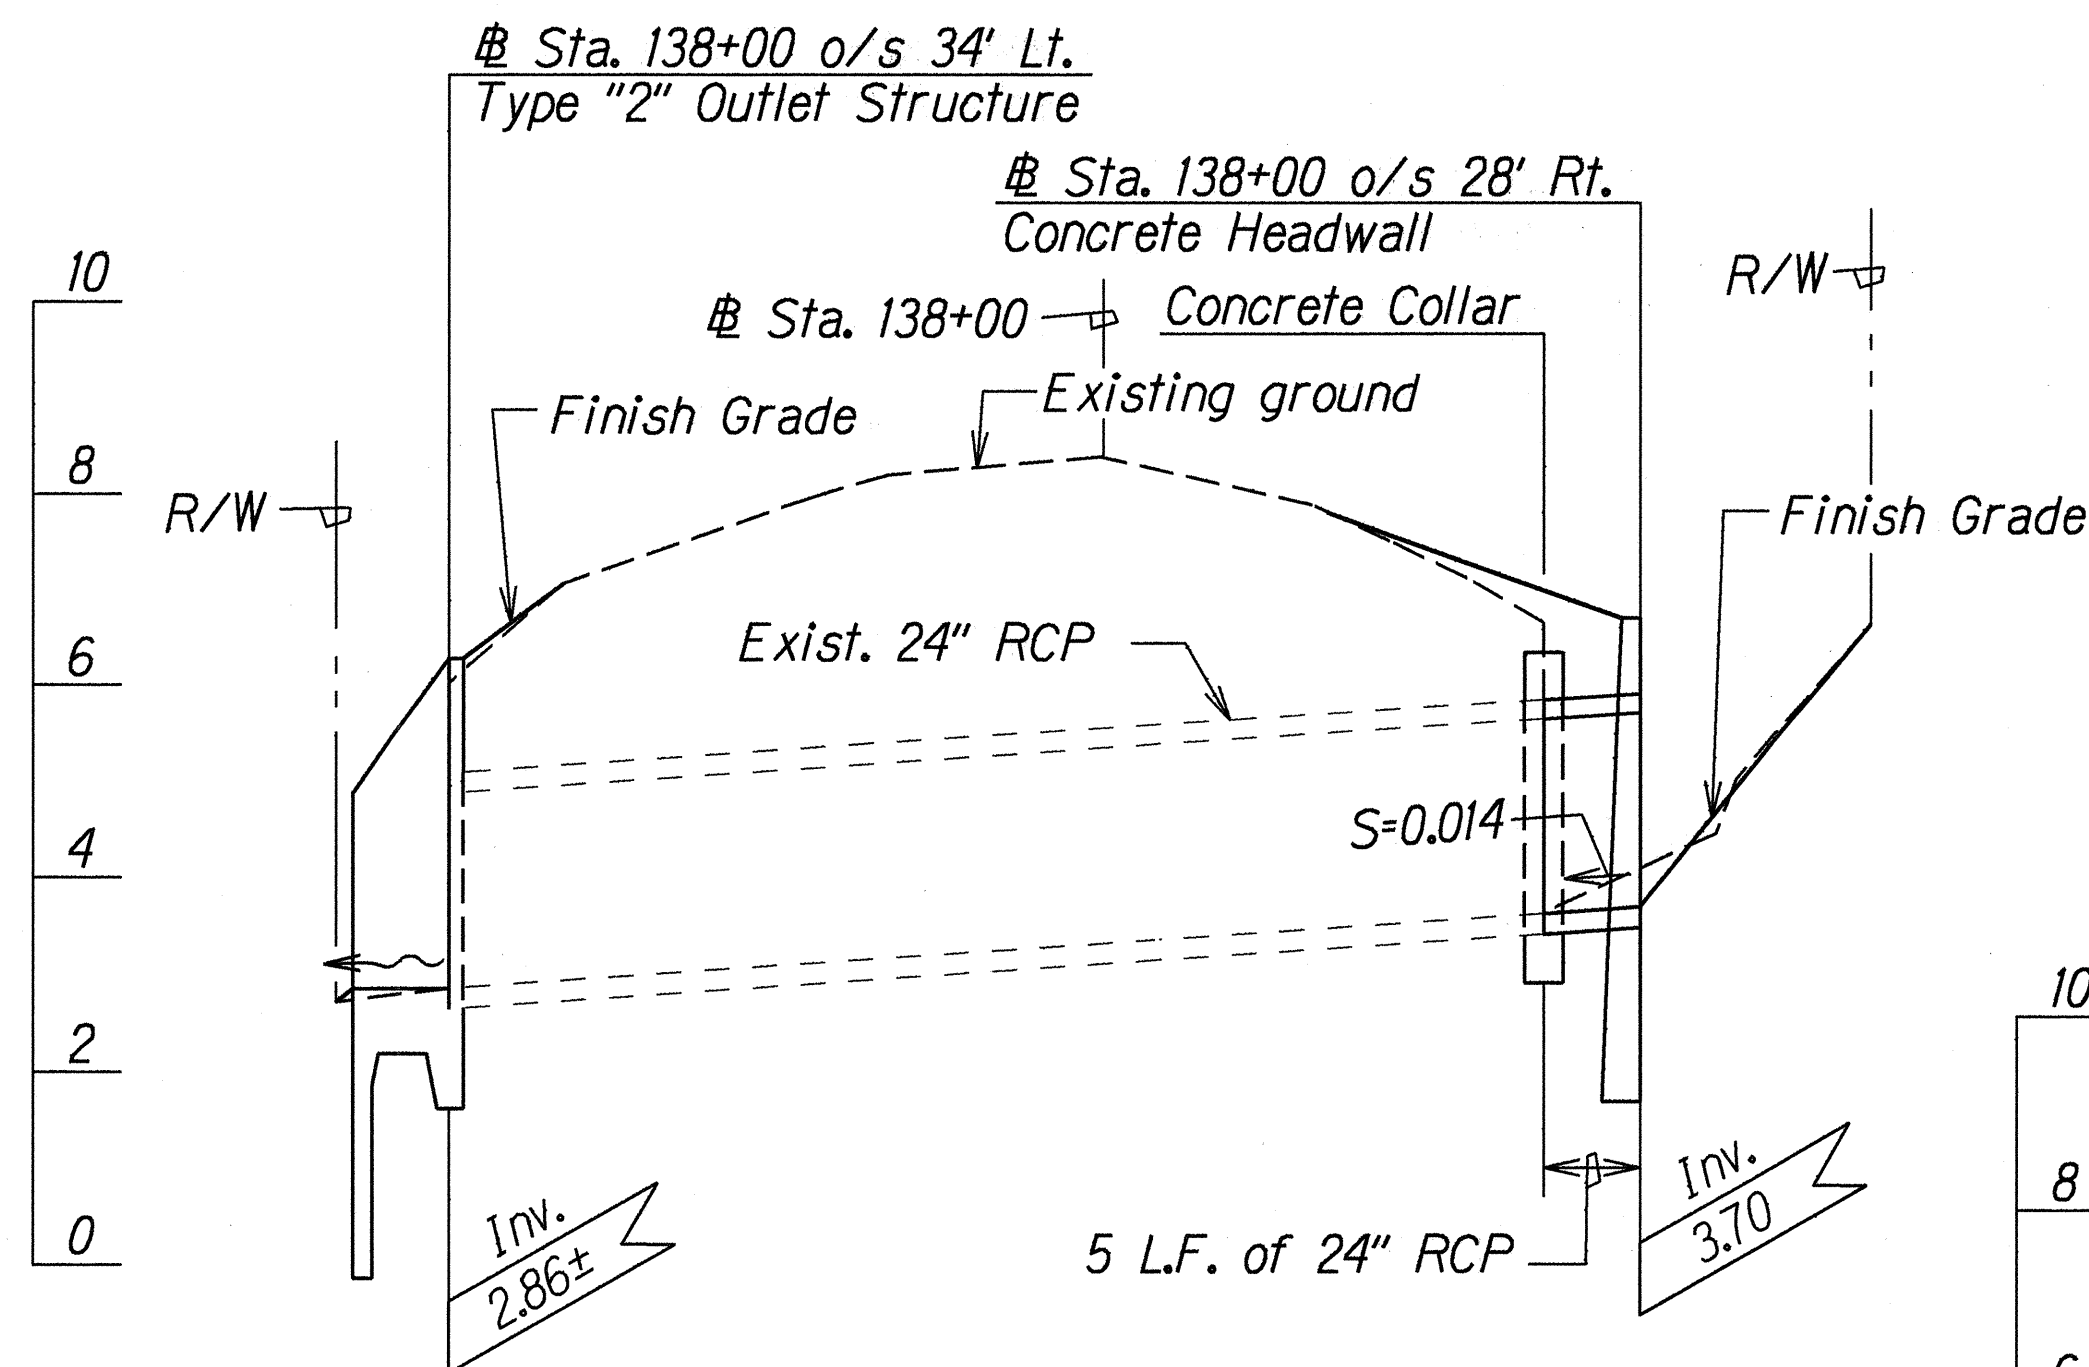


PROFILE-# STA. 138+00
Scale: Horiz. 1"=10'
Vert. 1"=2'

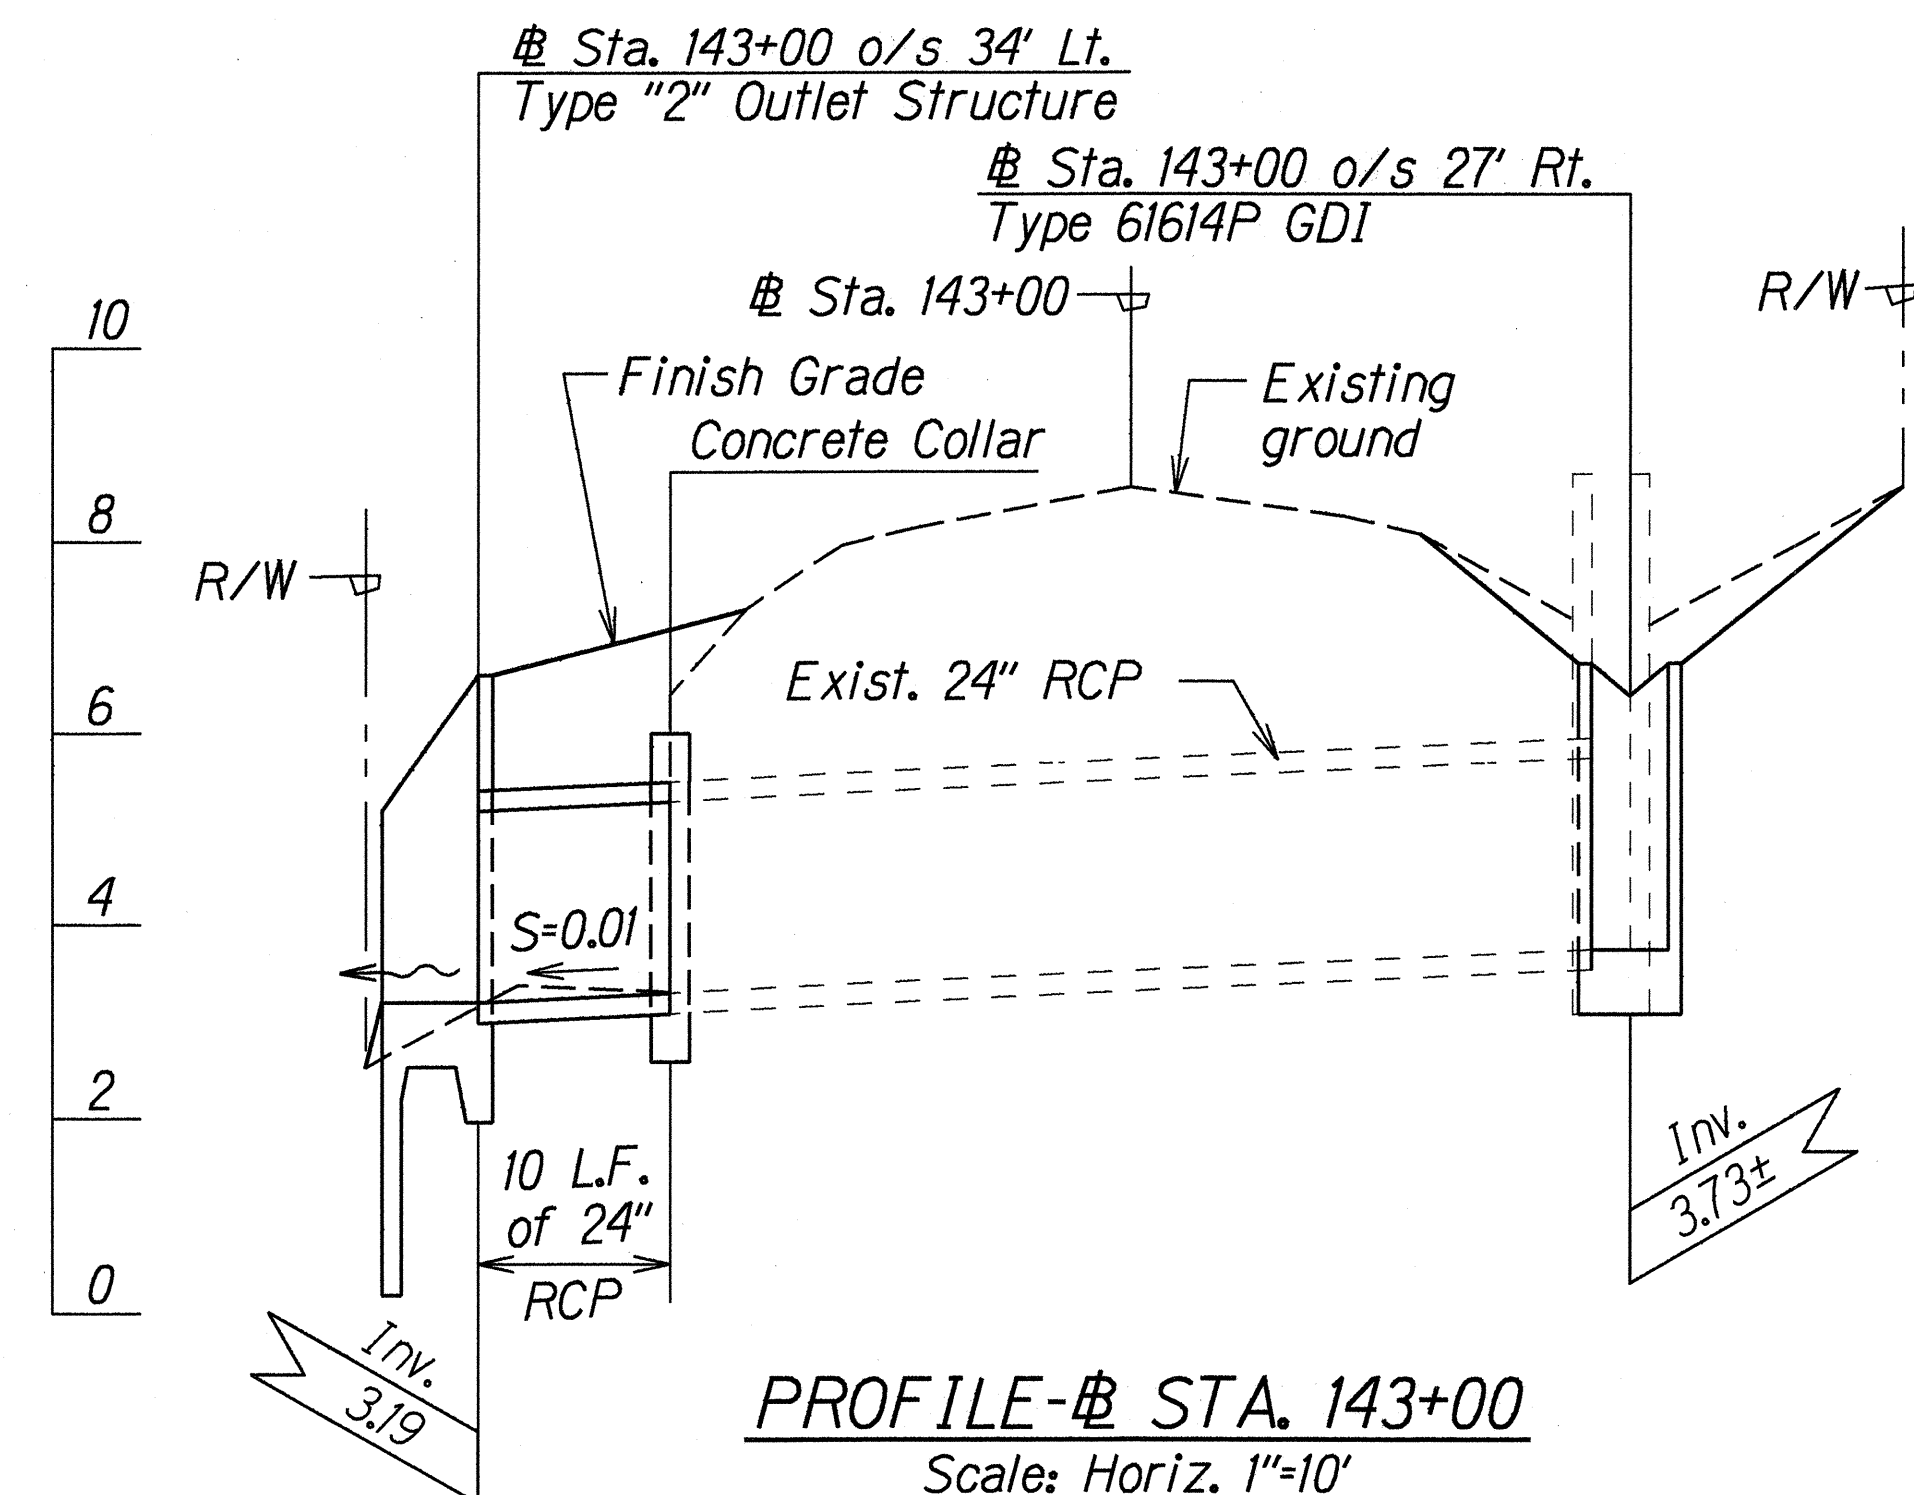

PROFILE-# STA. 143+00
Scale: Horiz. 1"=10'
Vert. 1"=2'

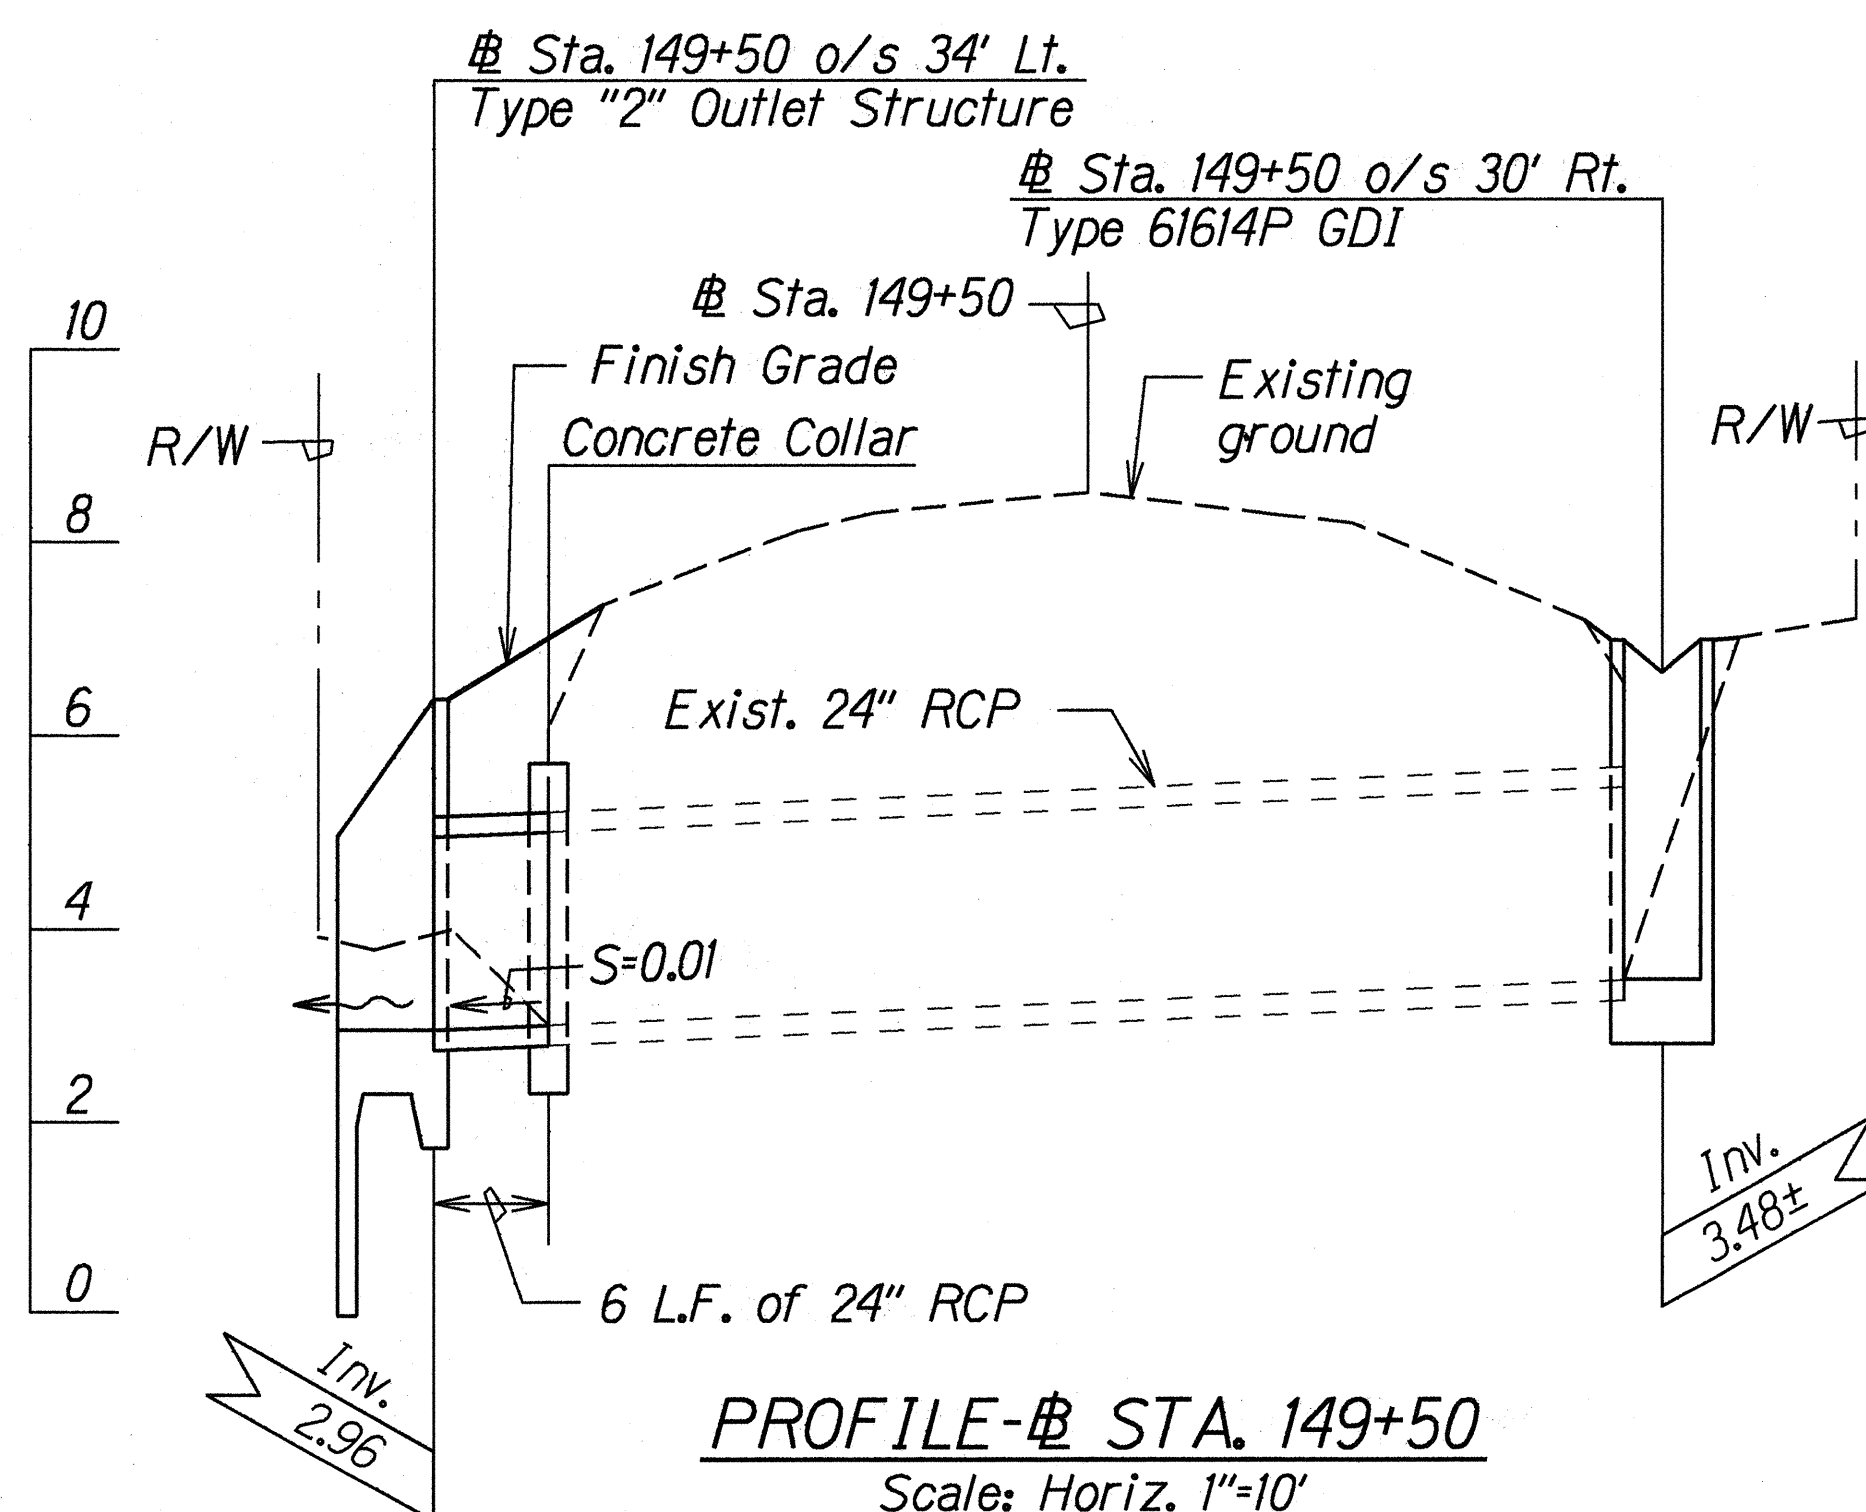

PROFILE-# STA. 149+50
Scale: Horiz. 1"=10'
Vert. 1"=2'

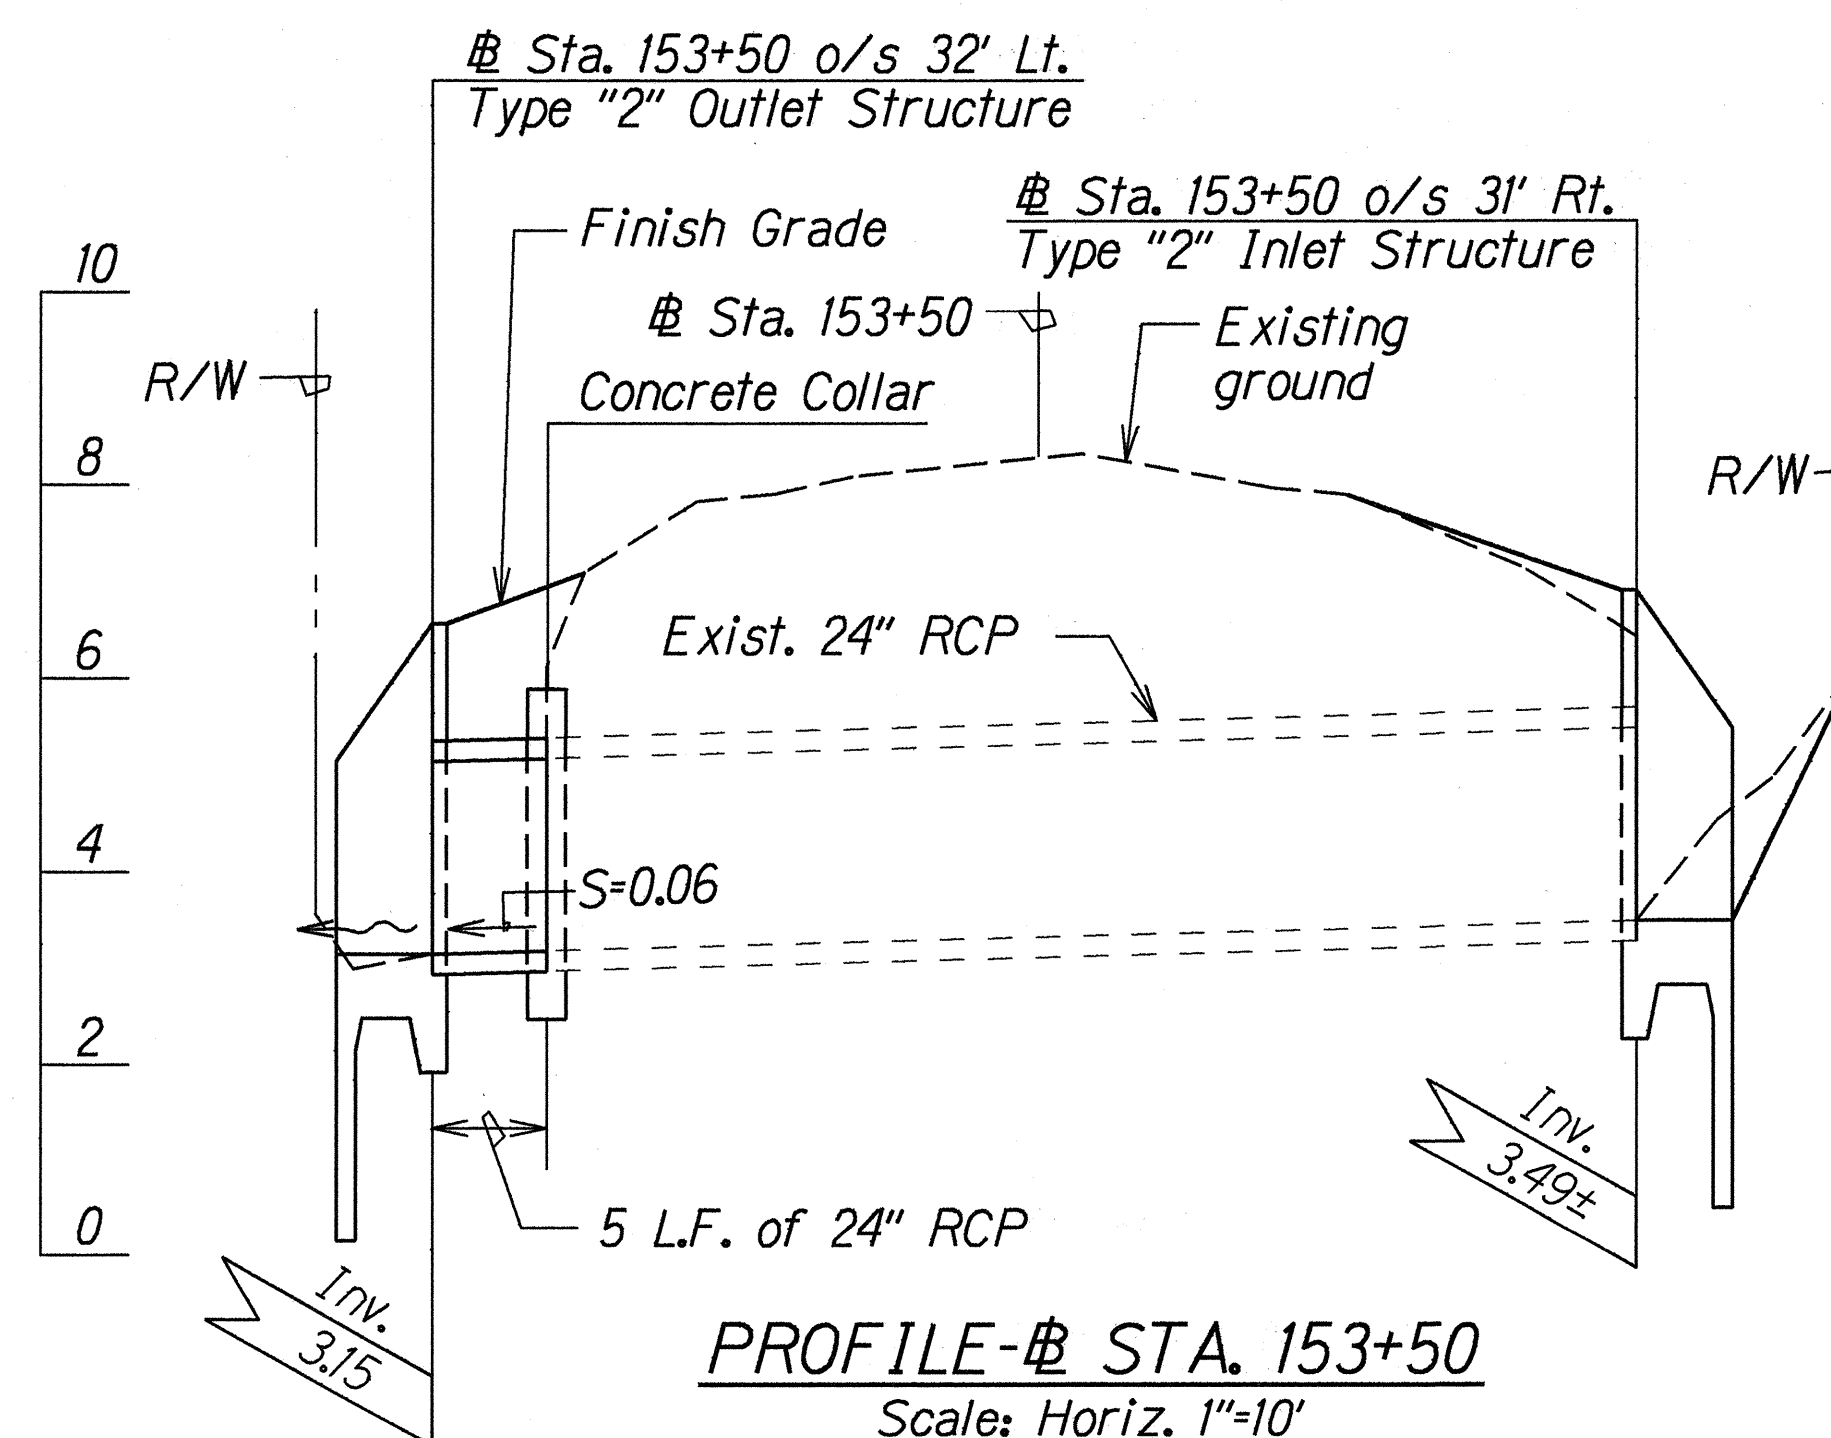

PROFILE-# STA. 153+50
Scale: Horiz. 1"=10'
Vert. 1"=2'

DESIGNED BY	DATE
TRACED BY	9/24/99
DESIGNED BY	
TRACED BY	
DESIGNED BY	
TRACED BY	
DESIGNED BY	
TRACED BY	
DESIGNED BY	
TRACED BY	

STATE OF HAWAII
DEPARTMENT OF TRANSPORTATION
HIGHWAYS DIVISION

DRAINAGE PROFILES

KAUMUALII HWY. DRAINAGE IMPROVEMENTS
Vicinity of Kikiaola Boat Harbor
Project No. 50B-01-99

Scale: As Shown Date: Sept. 1999

SHEET No. H4 OF 8 SHEETS