

INDEX TO DRAWINGS	
SHEET NO.	DESCRIPTION
1	TITLE SHEET
2	STANDARD PLANS SUMMARY
3	GENERAL NOTES AND LEGEND
4-6	DRAINAGE PLAN
7	DRAINAGE PROFILE
8-11	DRAINAGE DETAILS

STATE OF HAWAII

DEPARTMENT OF TRANSPORTATION

HIGHWAYS DIVISION

HONOLULU, HAWAII

"AS-BUILT"

PLANS FOR

KAUMUALII HIGHWAY


DRAINAGE IMPROVEMENTS

VICINITY OF KIKIAOLA BOAT HARBOR



PROJECT NO. 50B-01-99

DISTRICT OF WAIMEA

ISLAND OF KAUAI

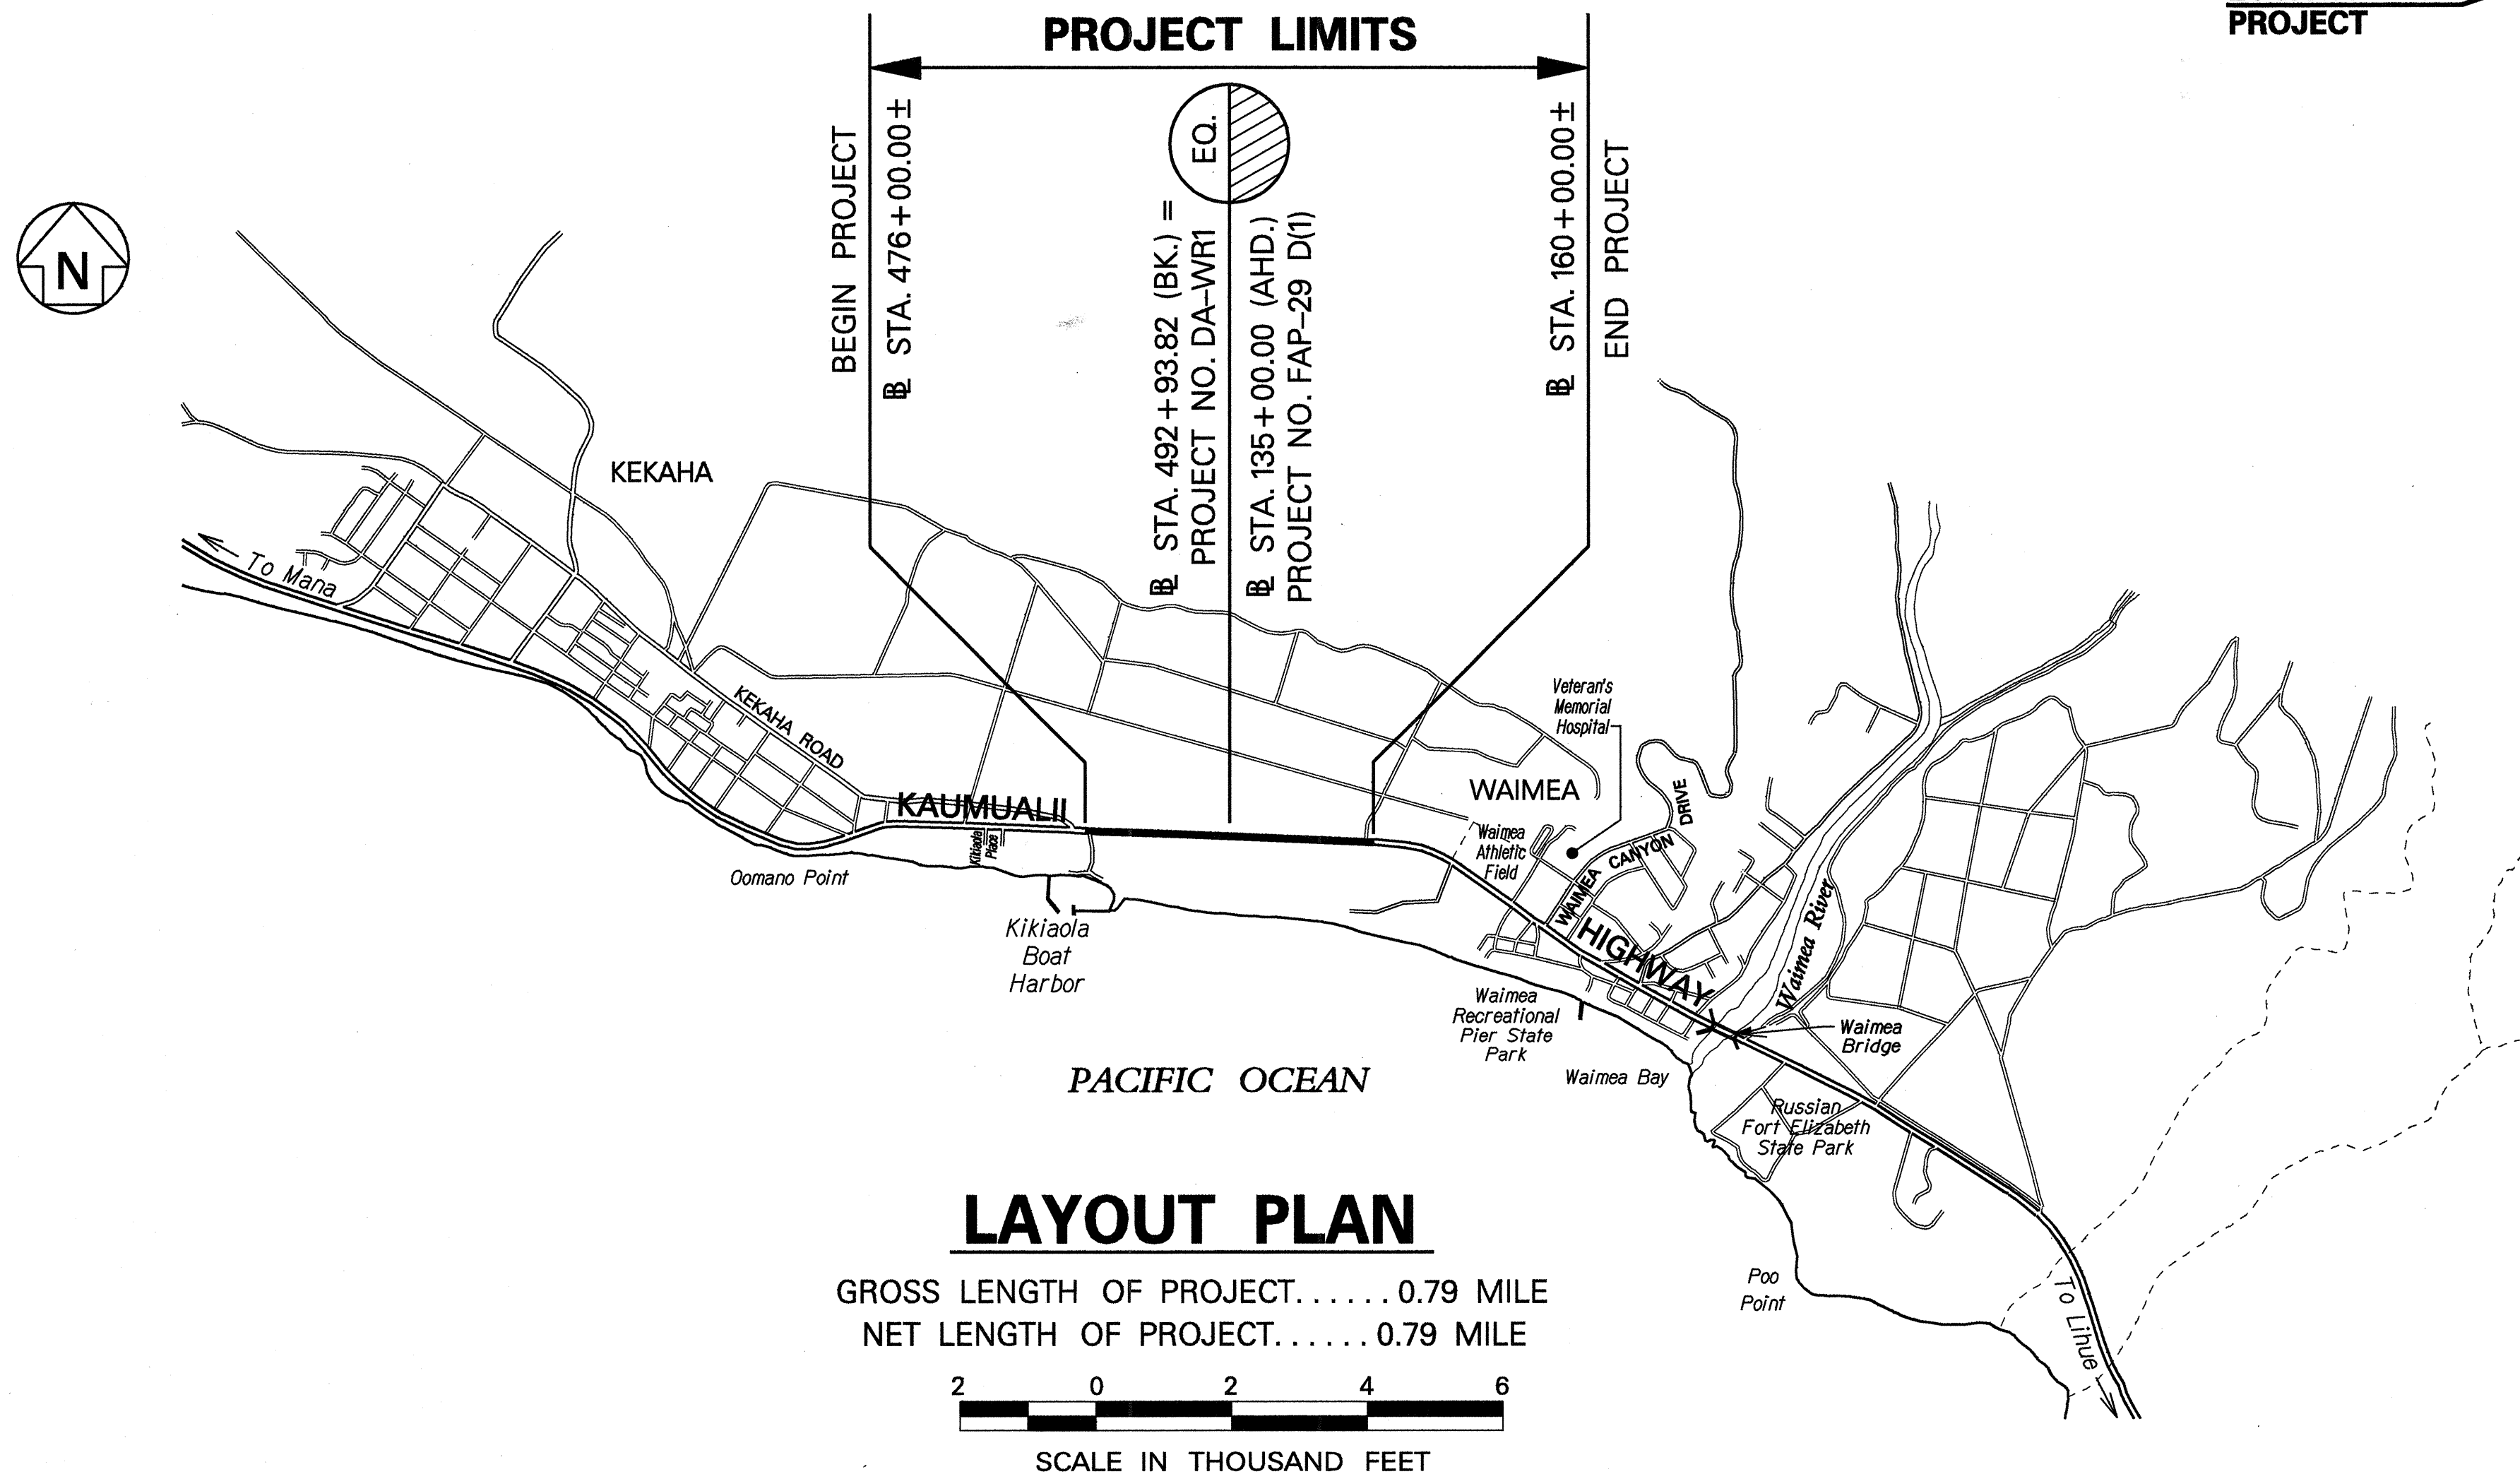

FED. ROAD DIST. NO.	STATE	PROJ. NO.	FISCAL YEAR	SHEET NO.	TOTAL SHEETS
HAWAII	HAW.	50B-01-99	2000	1	11

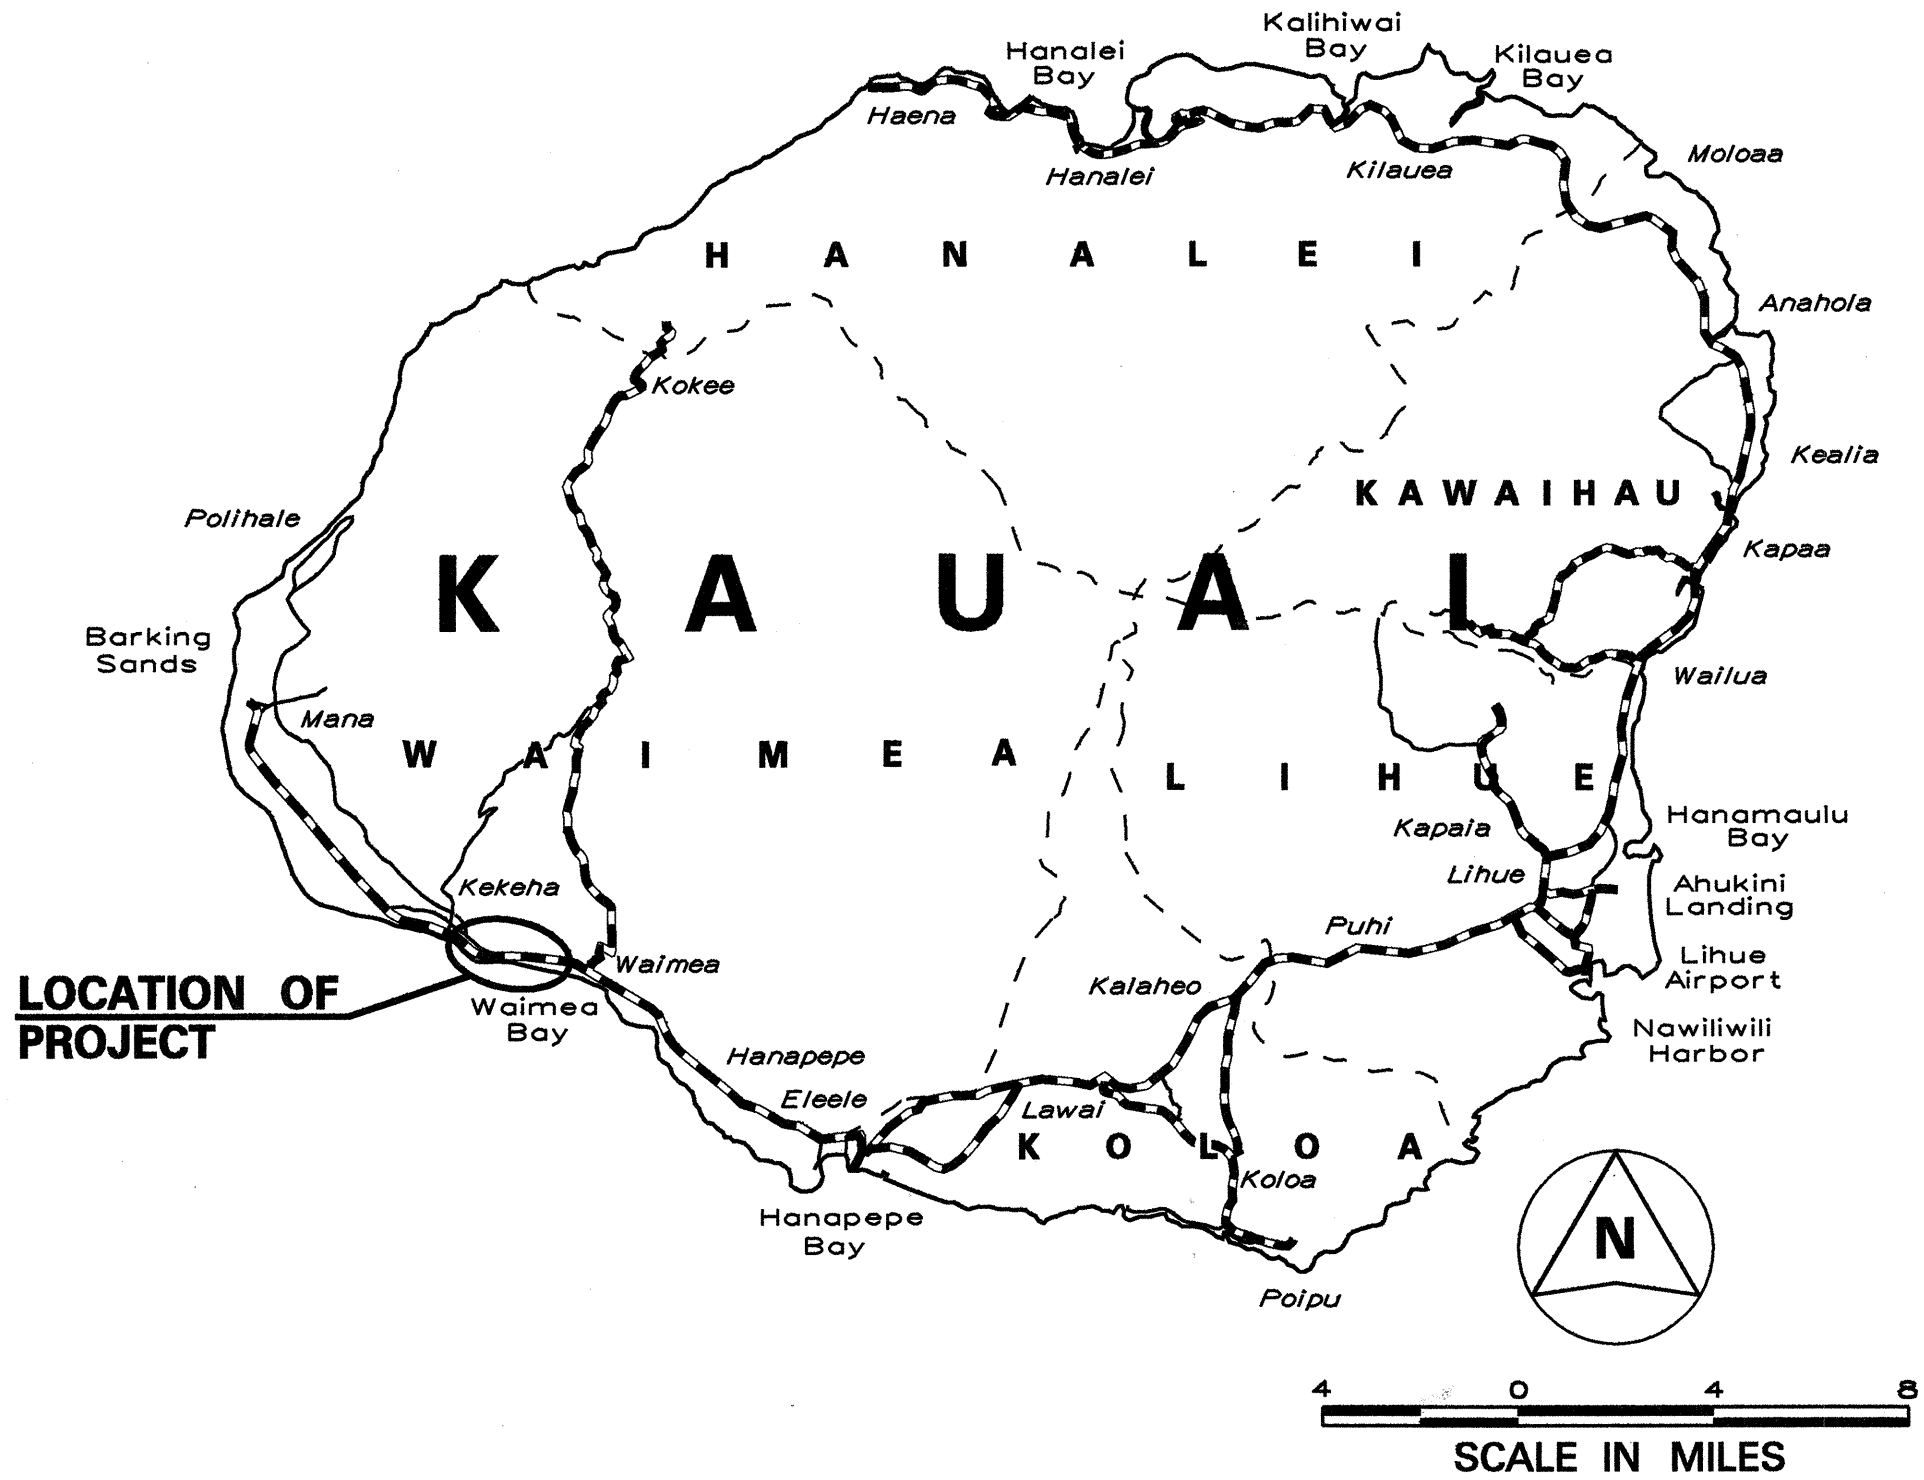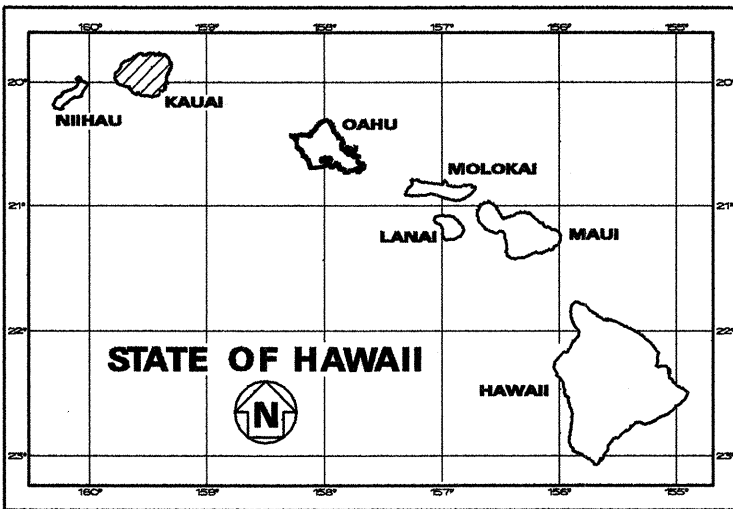

----- FEDERAL AID PROJECTS PREVIOUSLY CONSTRUCTED OR UNDER CONSTRUCTION

MILE POST 24.44 TO MILE POST 23.65

NO SIGNIFICANT CHANGES WERE MADE DURING CONSTRUCTION ON THESE PLANS EXCEPT CHANGES IN THE ORIGINAL THEORETICAL QUANTITIES. FOR ACTUAL QUANTITIES, REFER TO PROJECT LEDGER AND/OR COMPUTATION BOOK.

[Signature] 9-29-2000
RESIDENT ENGINEER DATE

DEPARTMENT OF TRANSPORTATION STATE OF HAWAII	
APPROVED:	
<i>[Signature]</i>	11/2/99
DIR. OF TRANSPORTATION	DATE

HWY-DH

DESIGNED BY

R. HIRONAKA

P. S. & E. BY

692-7575

PHONE

OCT. 1999

DATE