




FED. ROAD DIST. NO.	STATE	PROJ. NO.	FISCAL YEAR	SHEET NO.	TOTAL SHEETS
HAWAII	HAW.	50D-01-99M	1999	6	29

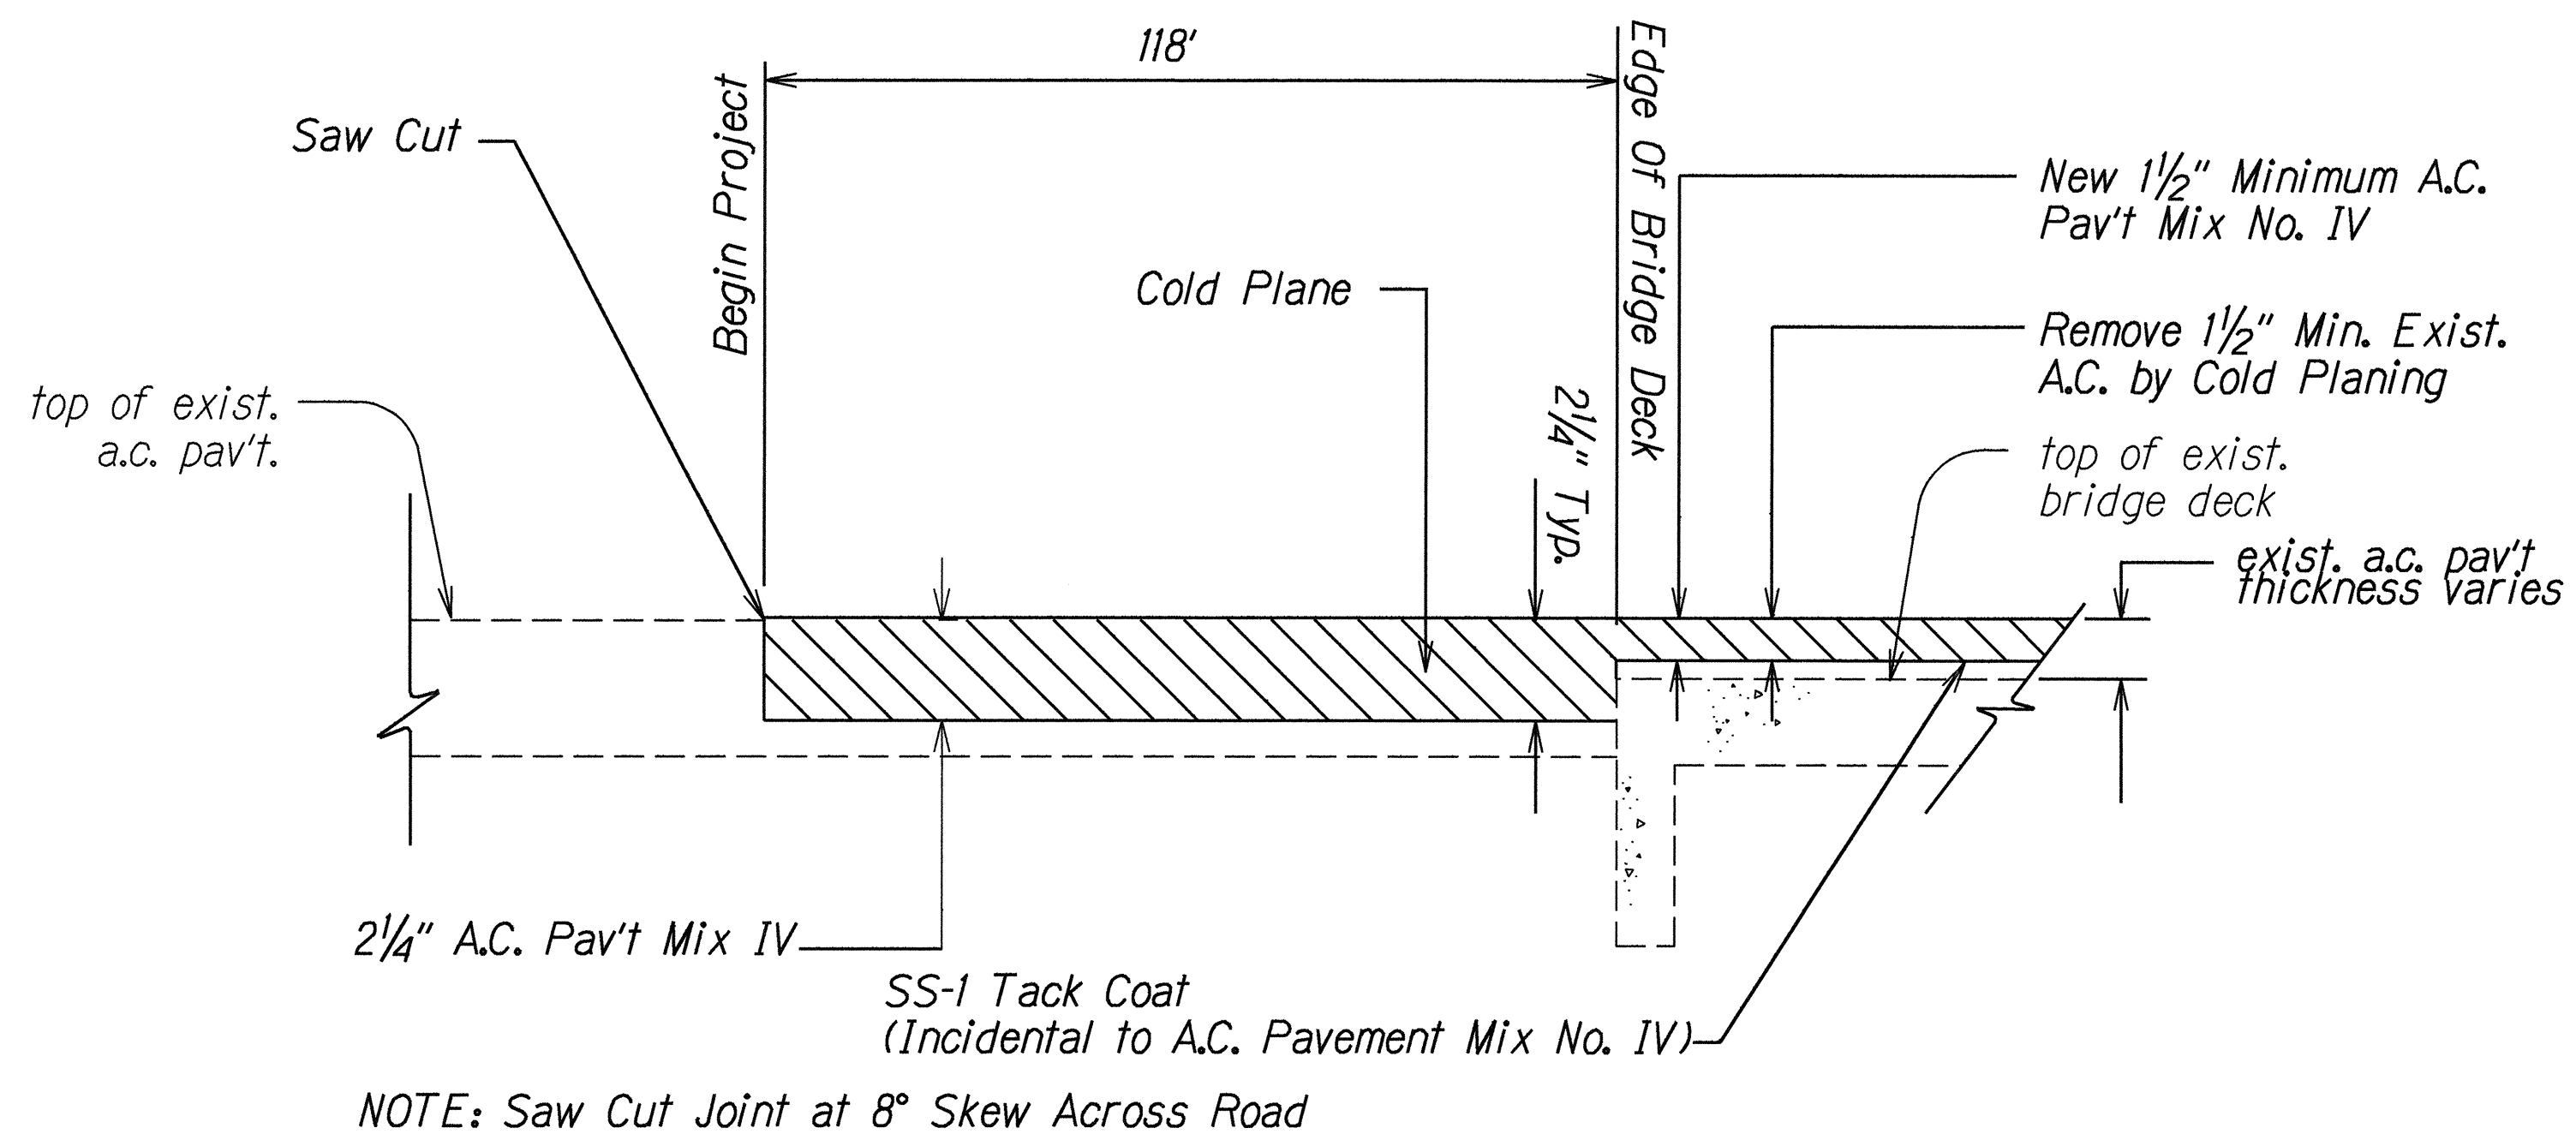


**TYPICAL TRANSITION AT BEGINNING OF PROJECT**  
**WAIHOHONU BRIDGE - (WEST END)**  
 Not to Scale

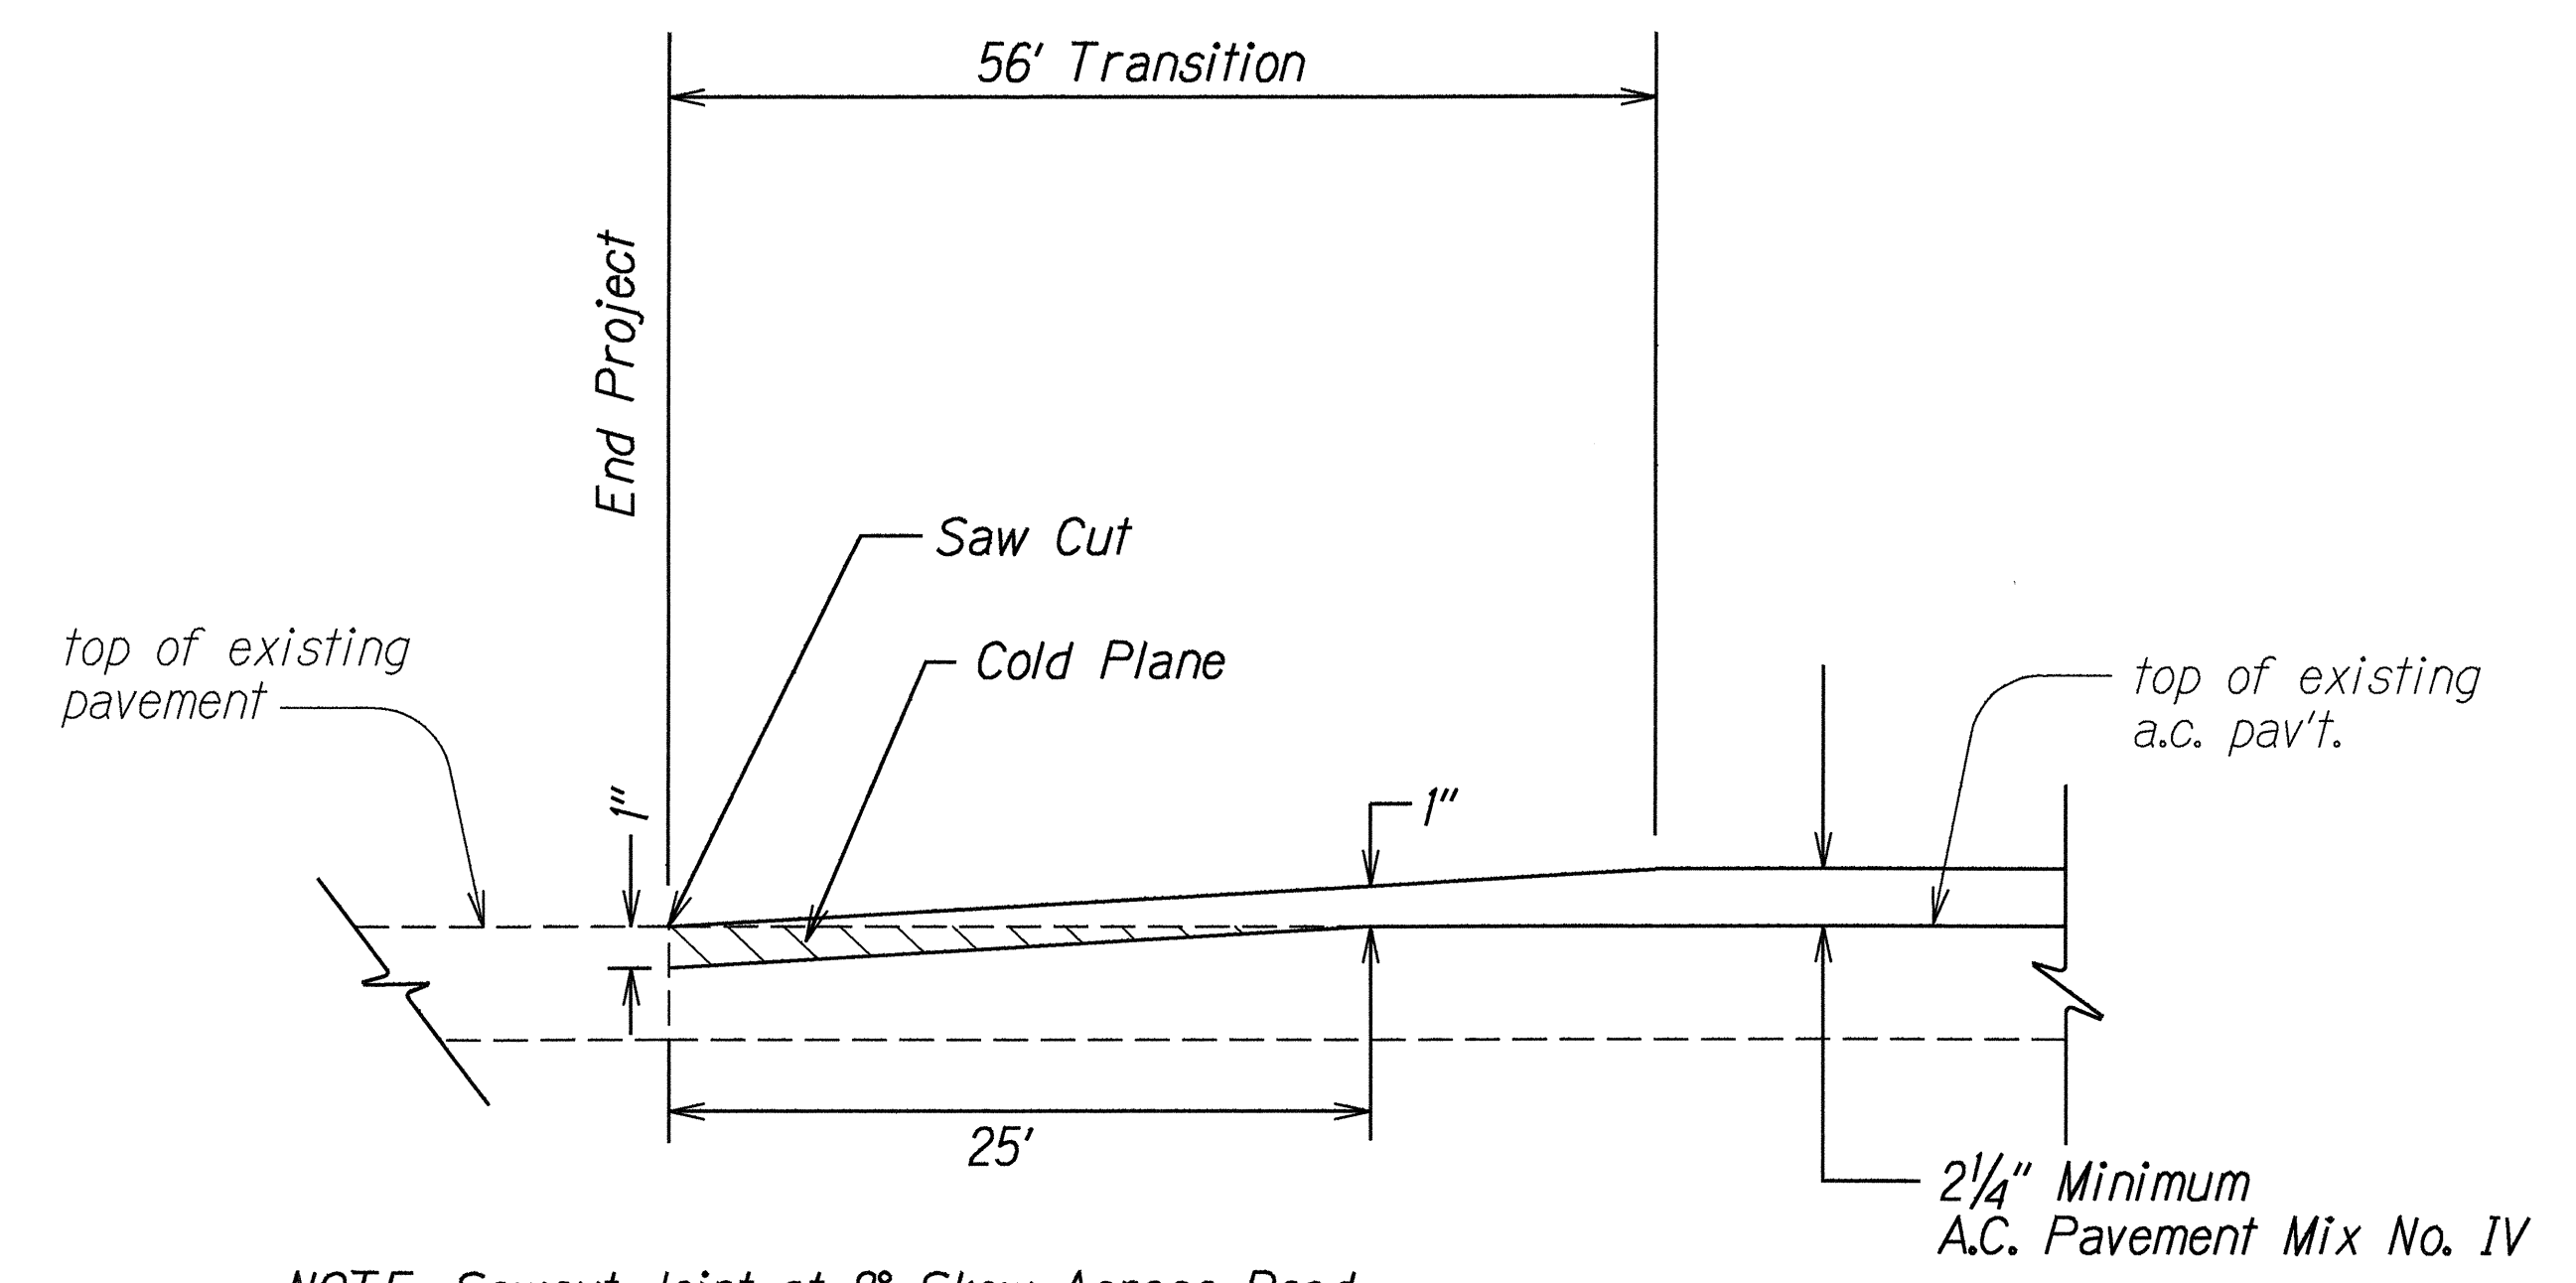

**TYPICAL TRANSITION AT END OF PROJECT**  
 Not to Scale

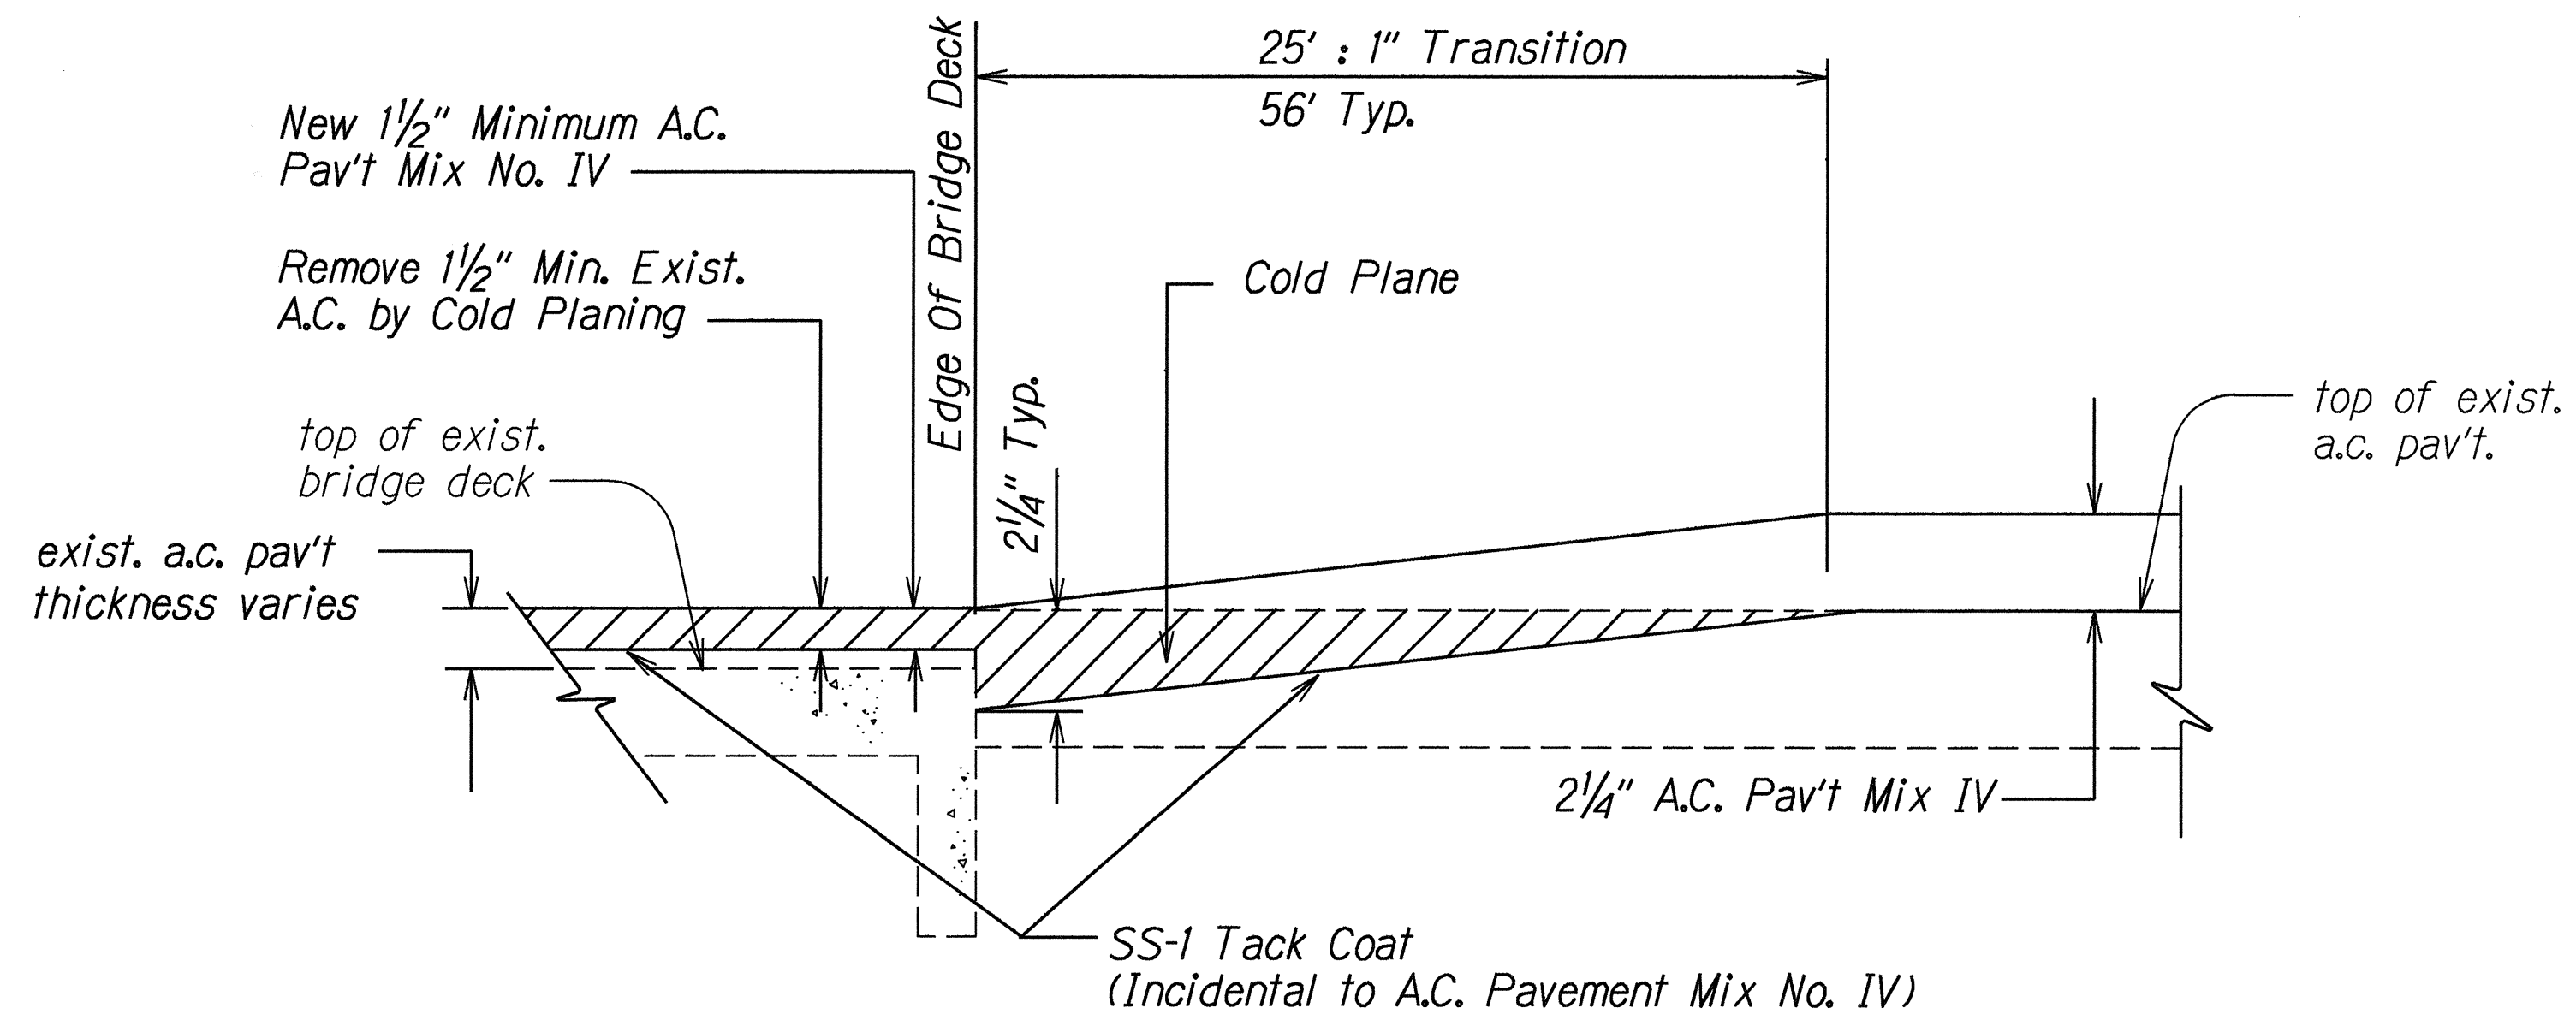

**TYPICAL TRANSITION AT WEOWEOPILAU BRIDGE & WAIHOHONU BRIDGE (EAST END)**  
 Not to Scale

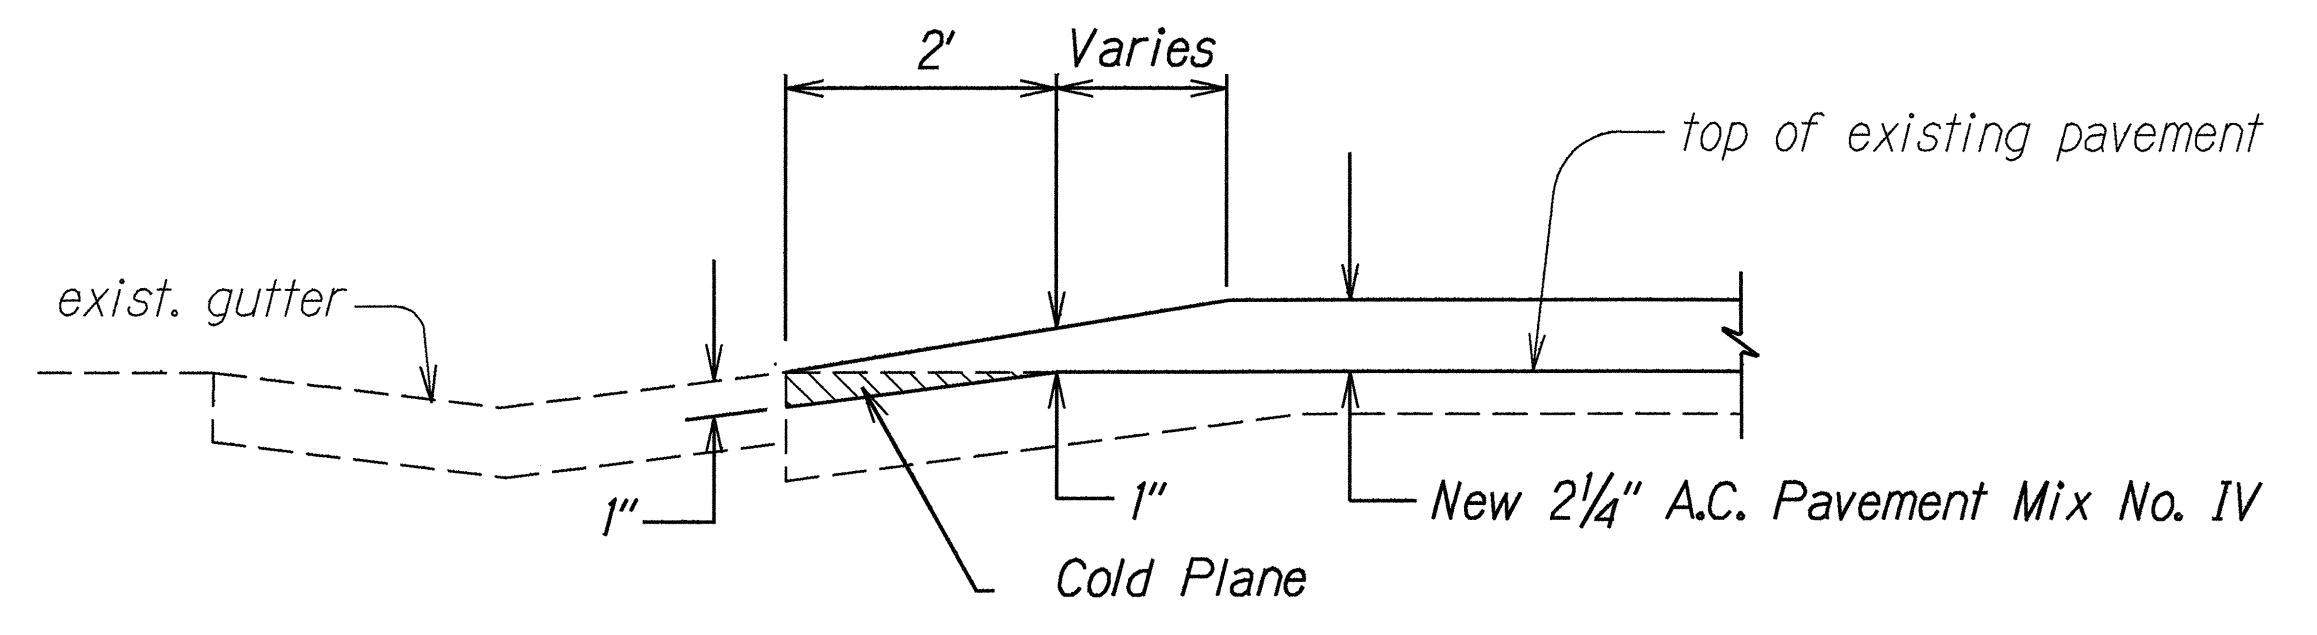


**RESURFACING AT GUTTER**  
**WITH TAPER ENDING AT EDGE OF GUTTER**  
 Not To Scale


ORIGINAL PLAN	DATE
DESIGNED BY	
DRAWN BY	
CHECKED BY	
NOTES	
QUANTITIES BY	
CHECKED BY	

STATE OF HAWAII  
 DEPARTMENT OF TRANSPORTATION  
 HIGHWAYS DIVISION  
**TYPICAL PLANS**  
**SECTIONS & DETAILS**  
 KAUMUALII HIGHWAY RESURFACING  
 HULEIA BRIDGE TO MALUHIA ROAD  
 Project No. 50D-01-99M  
 Scale: None Date: May, 1999  
 SHEET No. 1 OF 3 SHEETS


FED. ROAD DIST. NO.	STATE	PROJ. NO.	FISCAL YEAR	SHEET NO.	TOTAL SHEETS
HAWAII	HAW.	50D-01-99M	1999	7	29

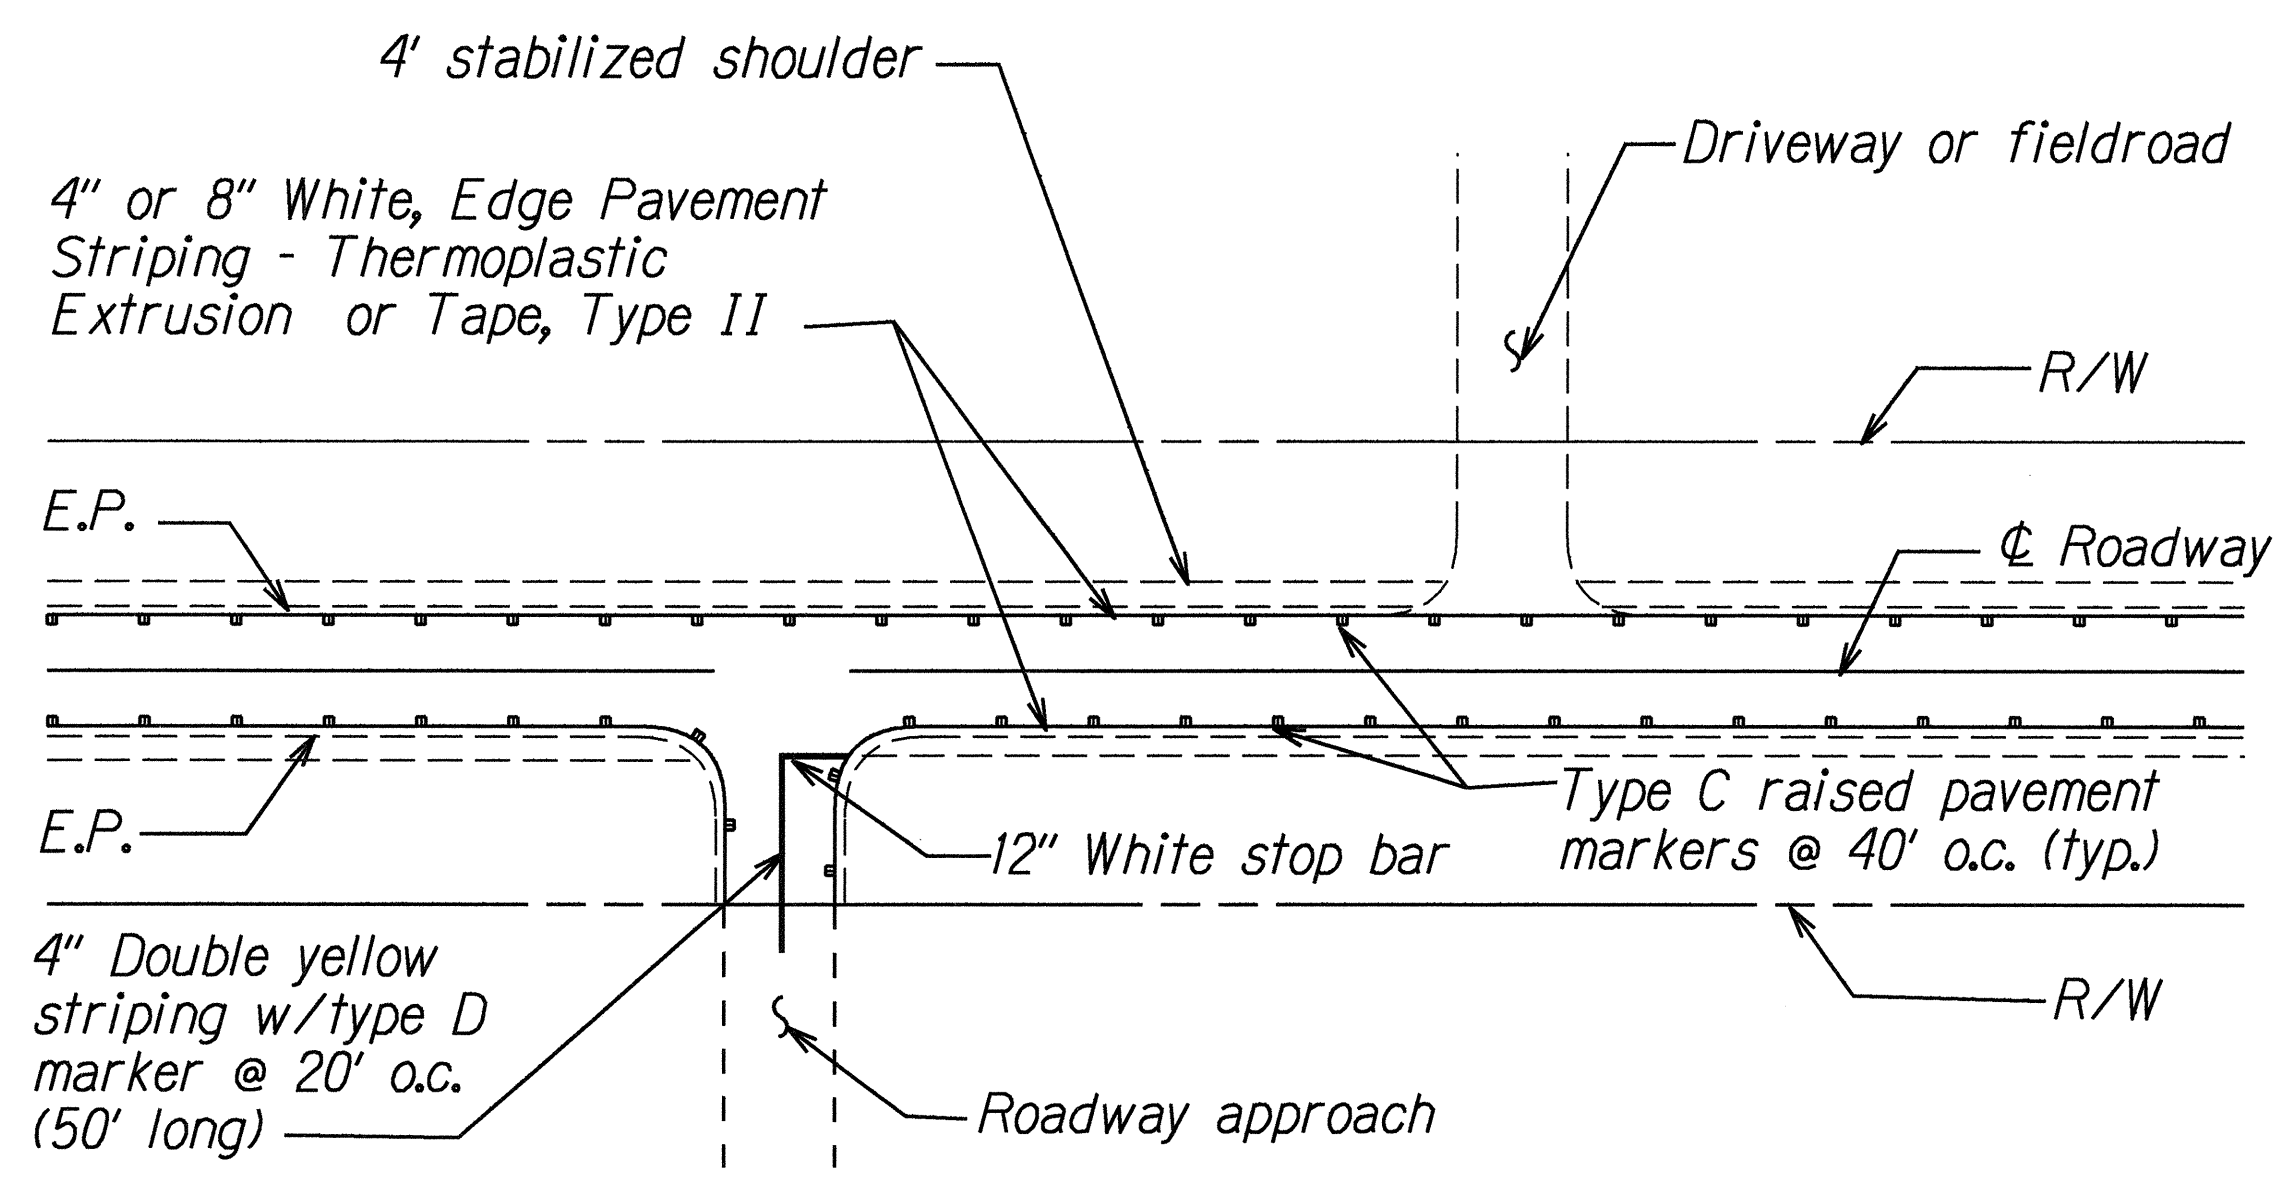


**PLAN**  
**TYPICAL EDGE LINE WITH**  
**RAISED PAVEMENT MARKERS**  
Not To Scale

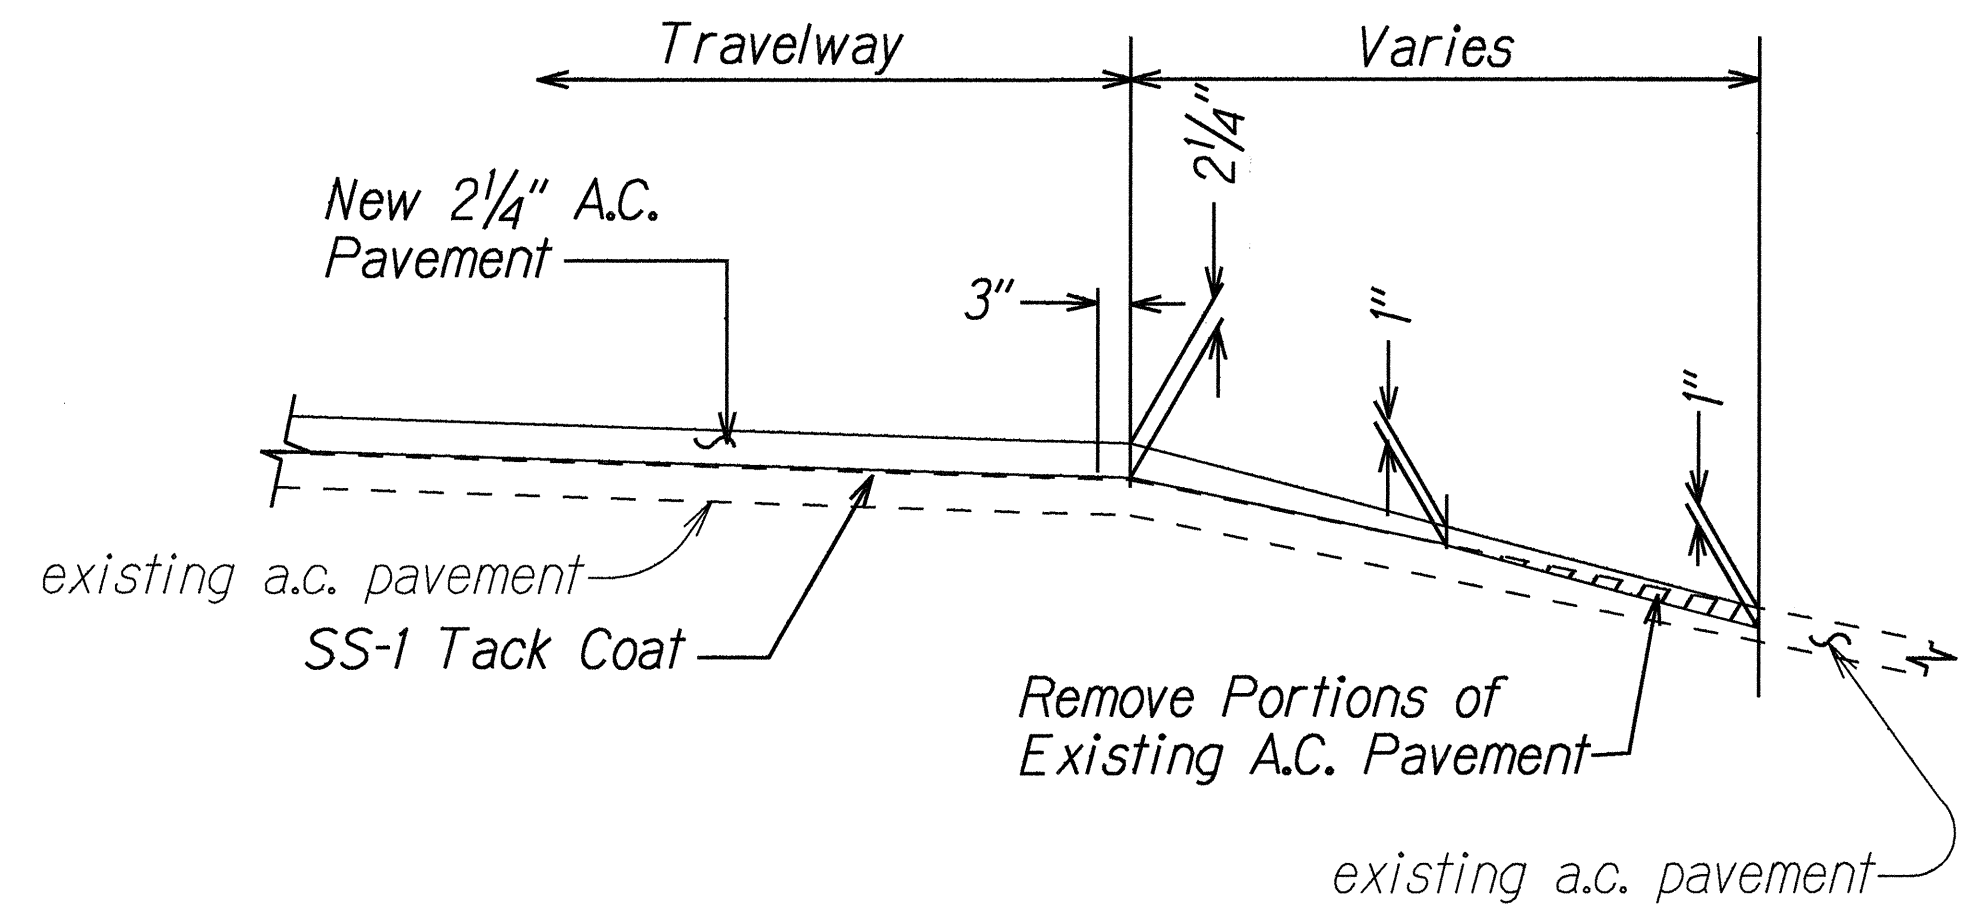


**TYPICAL PAVEMENT TRANSITION**  
**AT INTERSECTIONS**  
Not To Scale

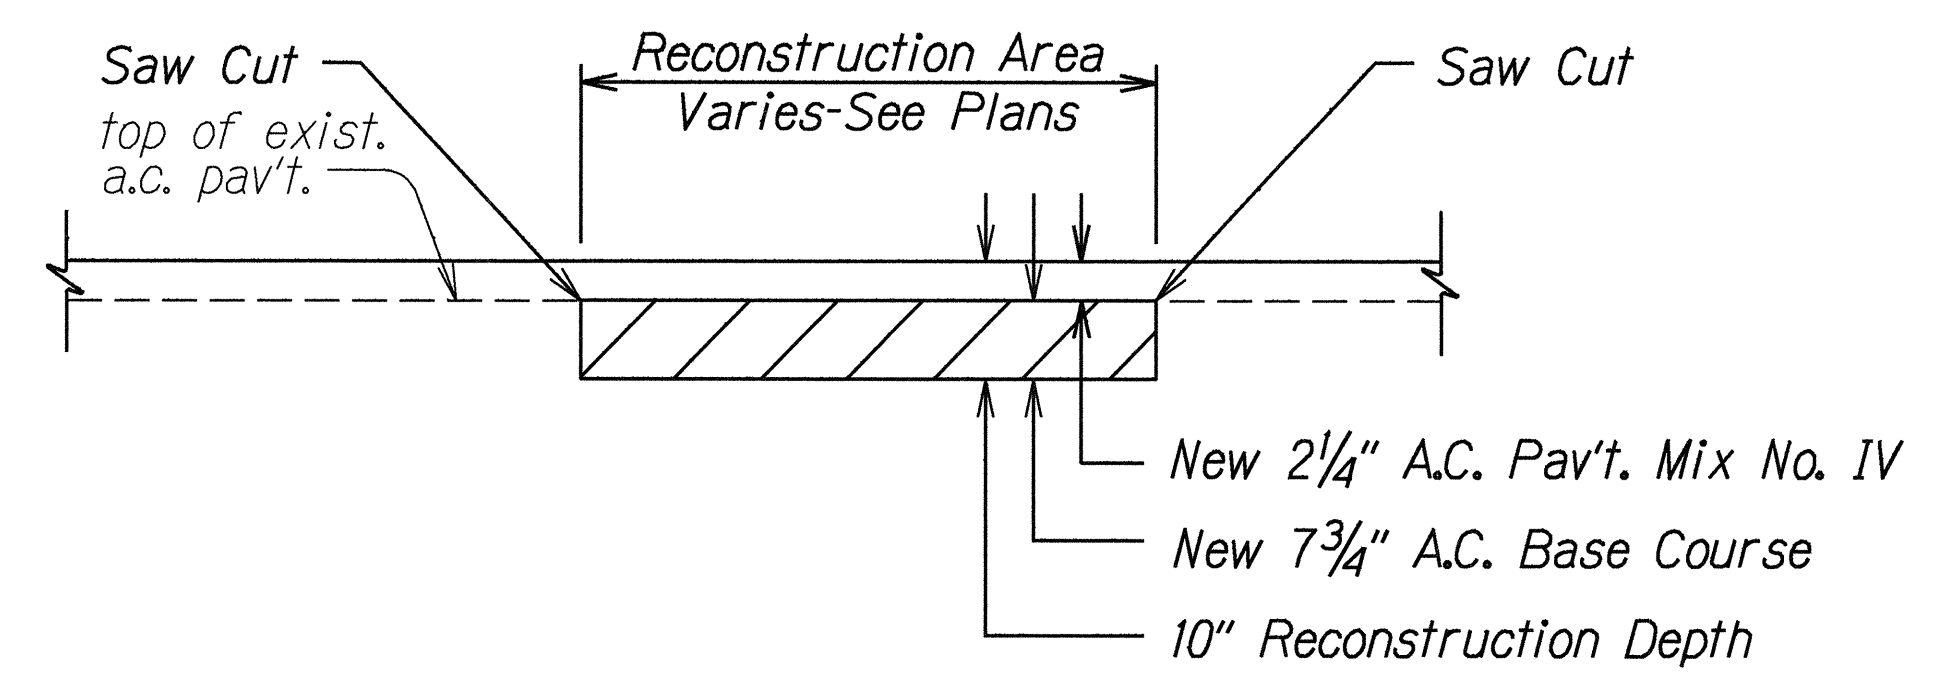


**A.C. PAVEMENT RECONSTRUCTION DETAIL**  
Not To Scale

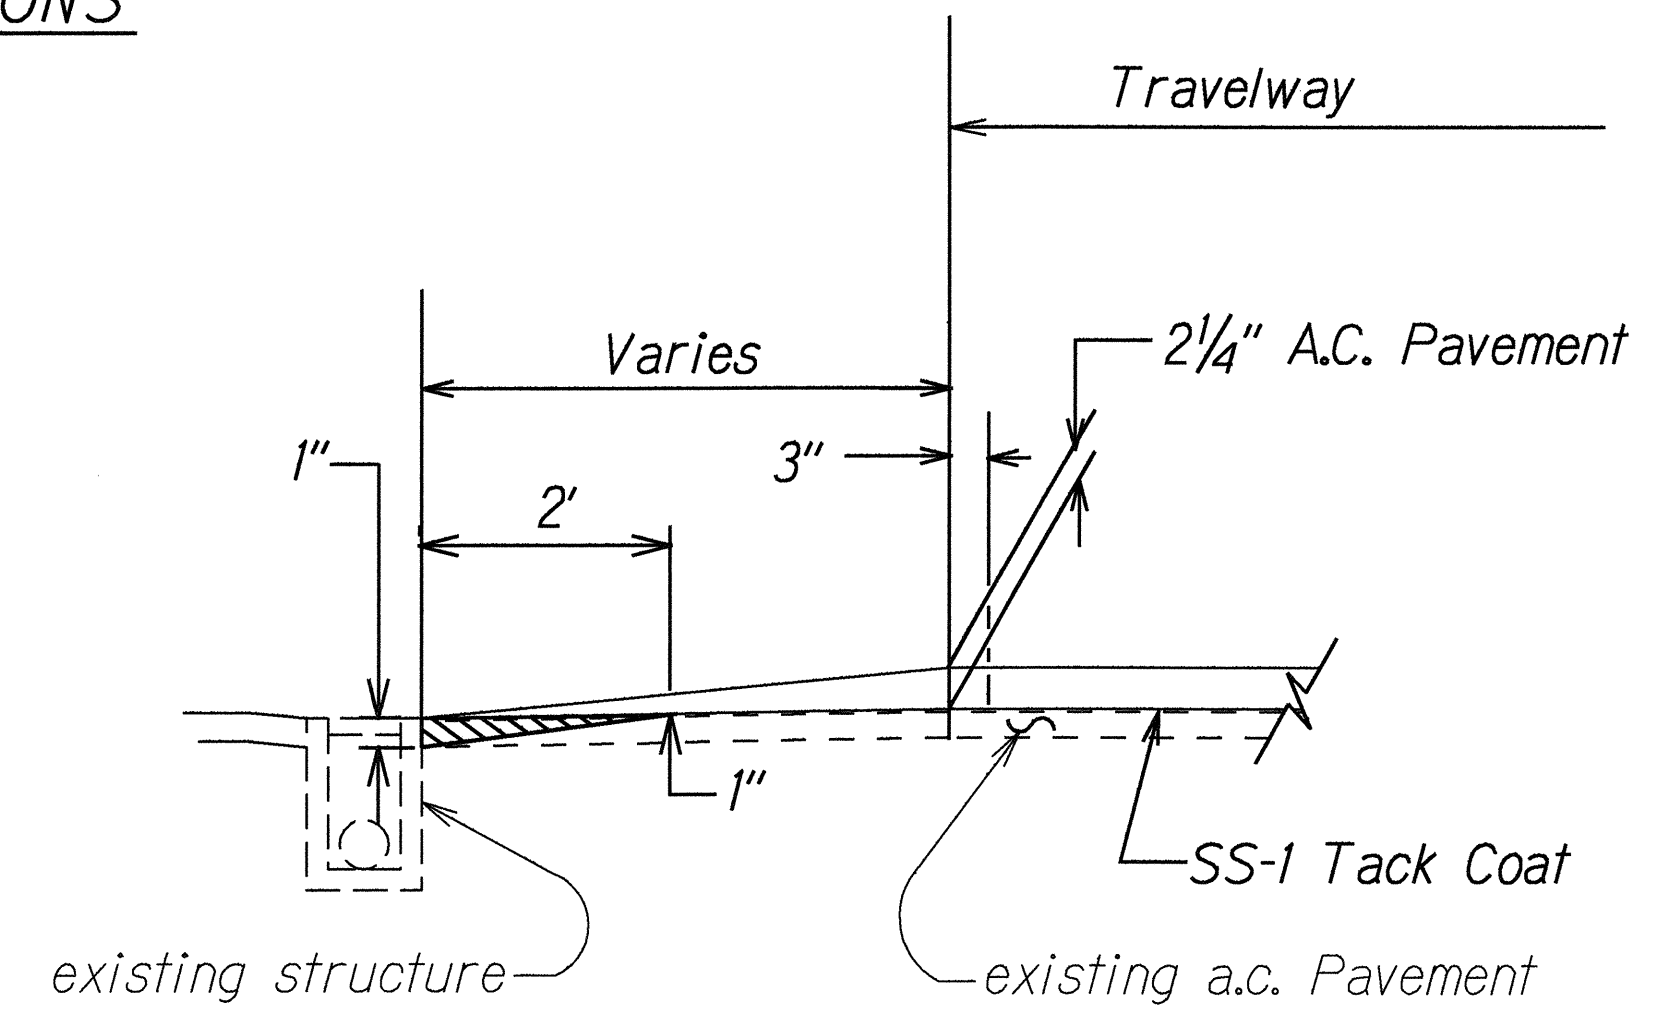

**TYPICAL TRANSITION**  
**AT STRUCTURES**  
Not To Scale

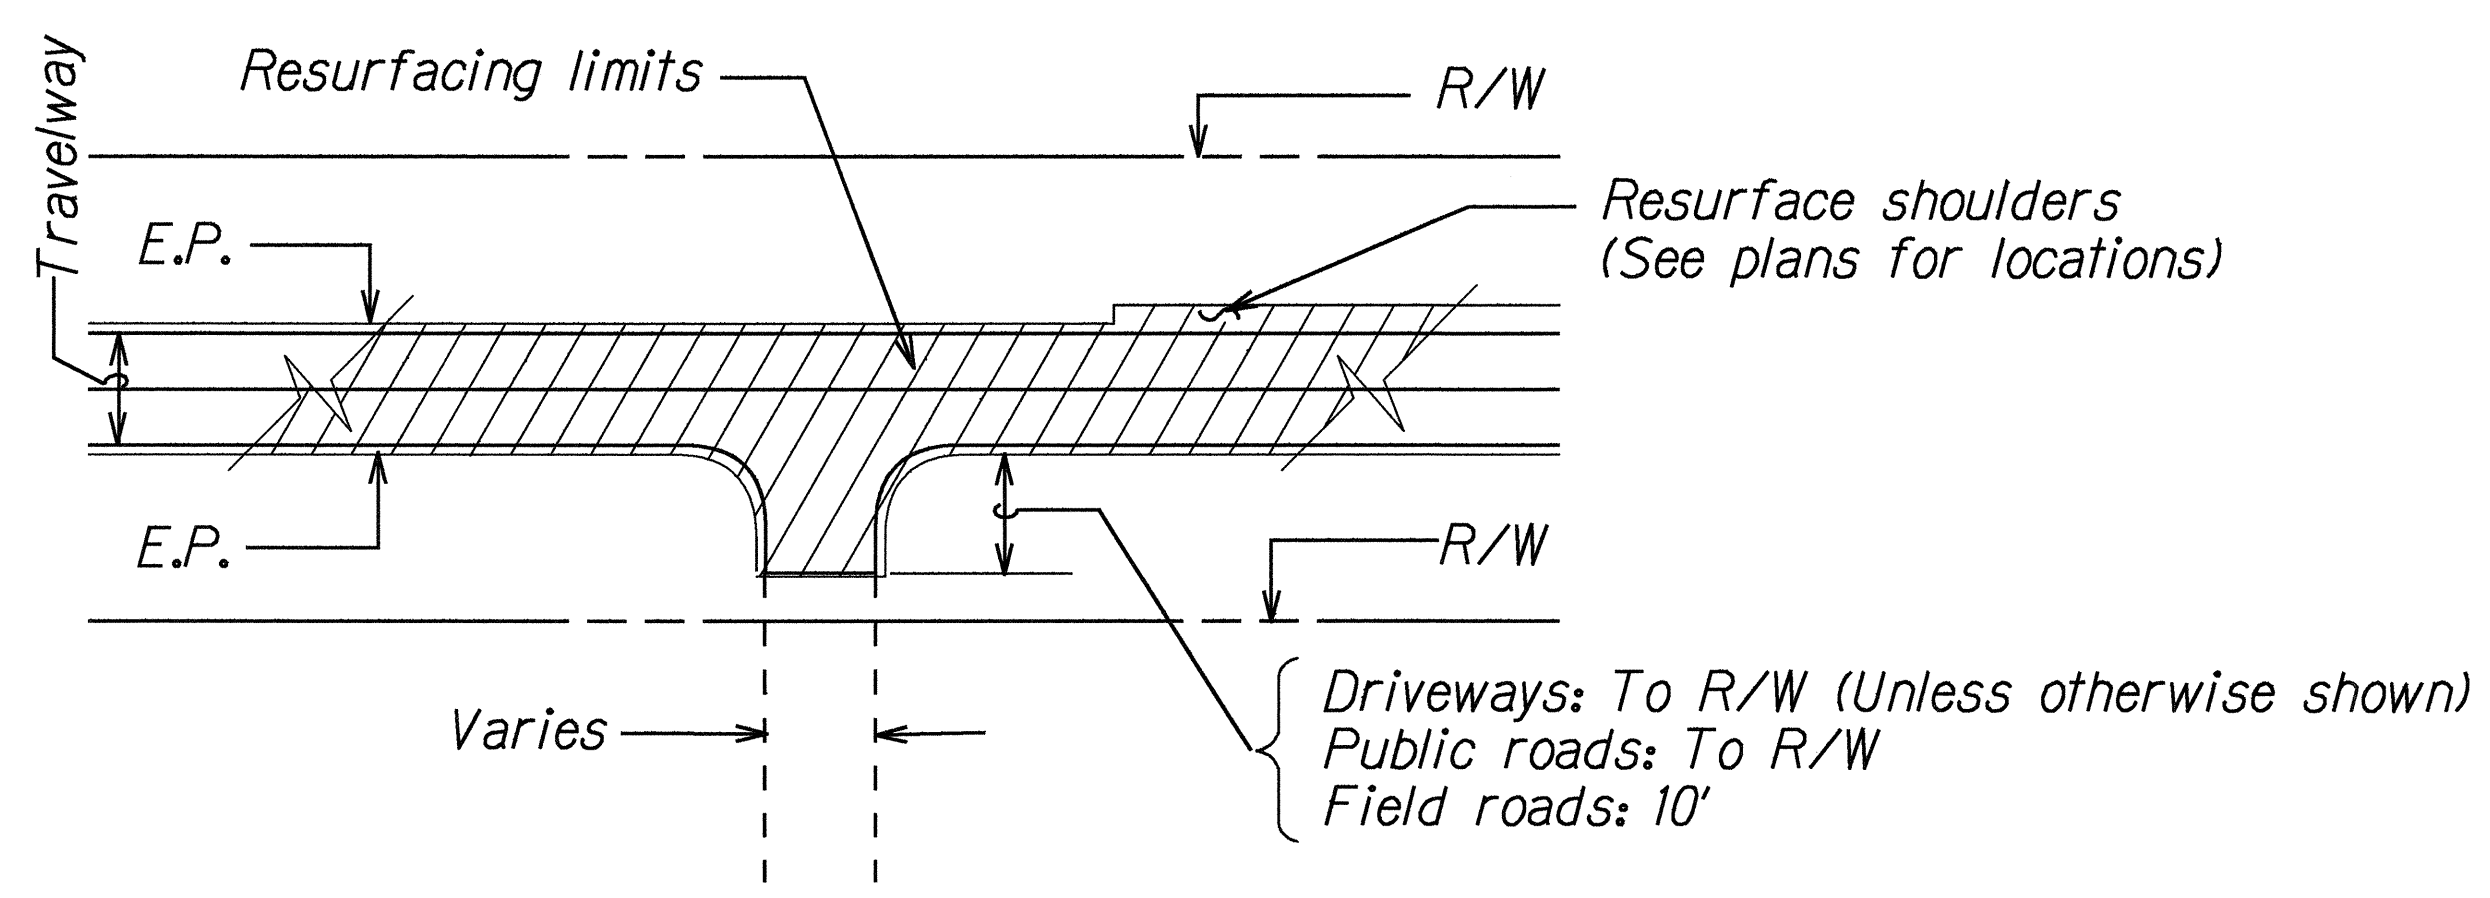

**PLAN**  
**TYPICAL RESURFACING LIMITS**  
Not To Scale

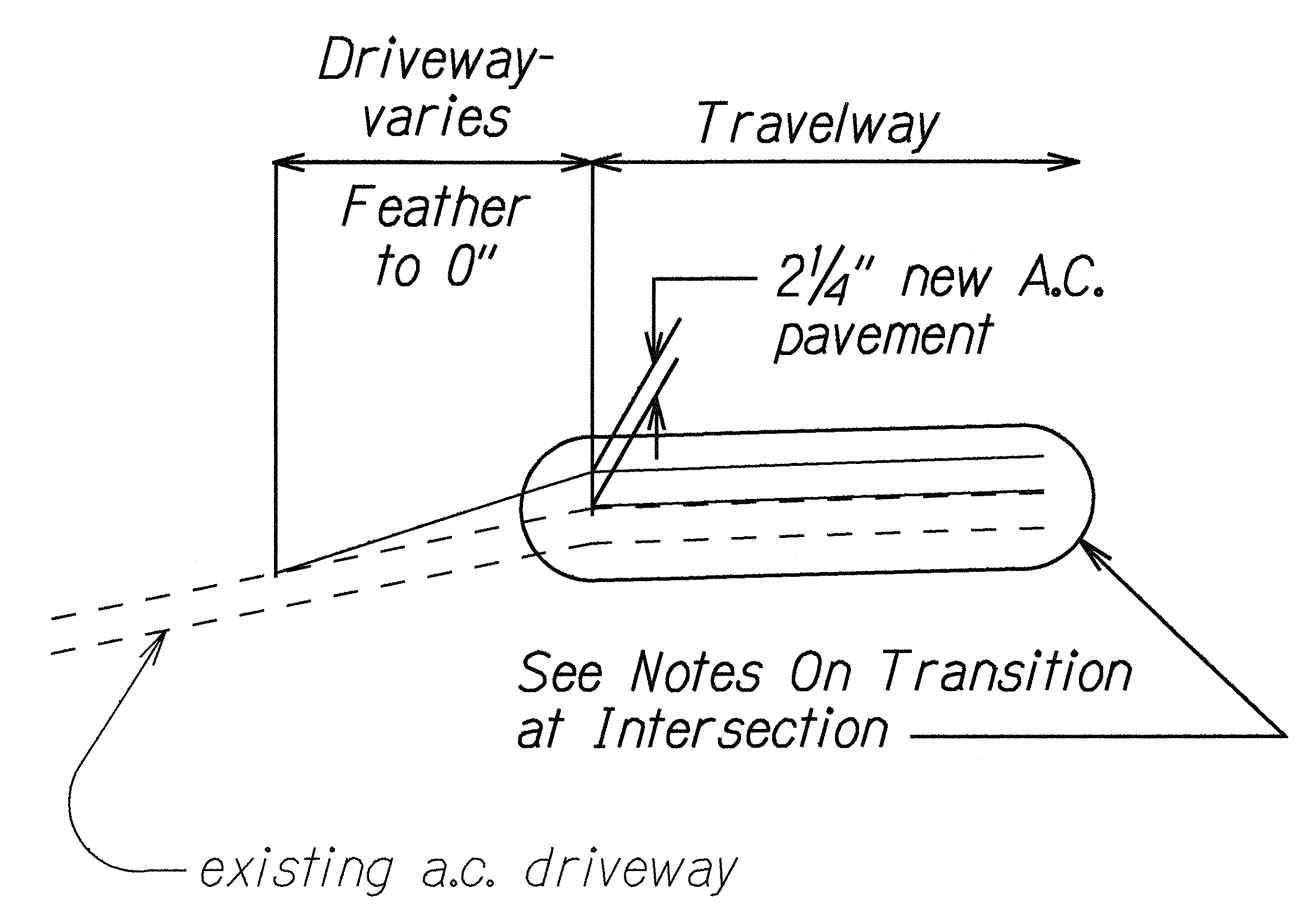

**TYPICAL PAVEMENT TRANSITION**  
**AT DRIVEWAYS**  
Not To Scale

ORIGINAL PLAN	DATE	BY
SURVEY PLANNED BY		
DESIGNED BY		
CHECKED BY		
NOTED BY		
QUANTITIES BY		
CHECKED BY		

STATE OF HAWAII  
DEPARTMENT OF TRANSPORTATION  
HIGHWAYS DIVISION

**TYPICAL PLANS**  
**SECTIONS & DETAILS**  
HAUMUALII HIGHWAY RESURFACING  
HULEIA BRIDGE TO MALUHIA ROAD  
Project No. 50D-01-99M  
Scale: None      Date: May, 1999

SHEET No. 2 OF 3 SHEETS

