


FED. ROAD DIST. NO.	STATE	PROJ. NO.	FISCAL YEAR	SHEET NO.	TOTAL SHEETS
HAWAII	HAW.	50D-01-00M	2001	18	23



SURVEY PLOTTED BY	DATE
DRAWN BY	
DESIGNED BY	
QUANTITIES BY	
CHECKED BY	
ORIGINAL PLAN	
NOTE BOOK	

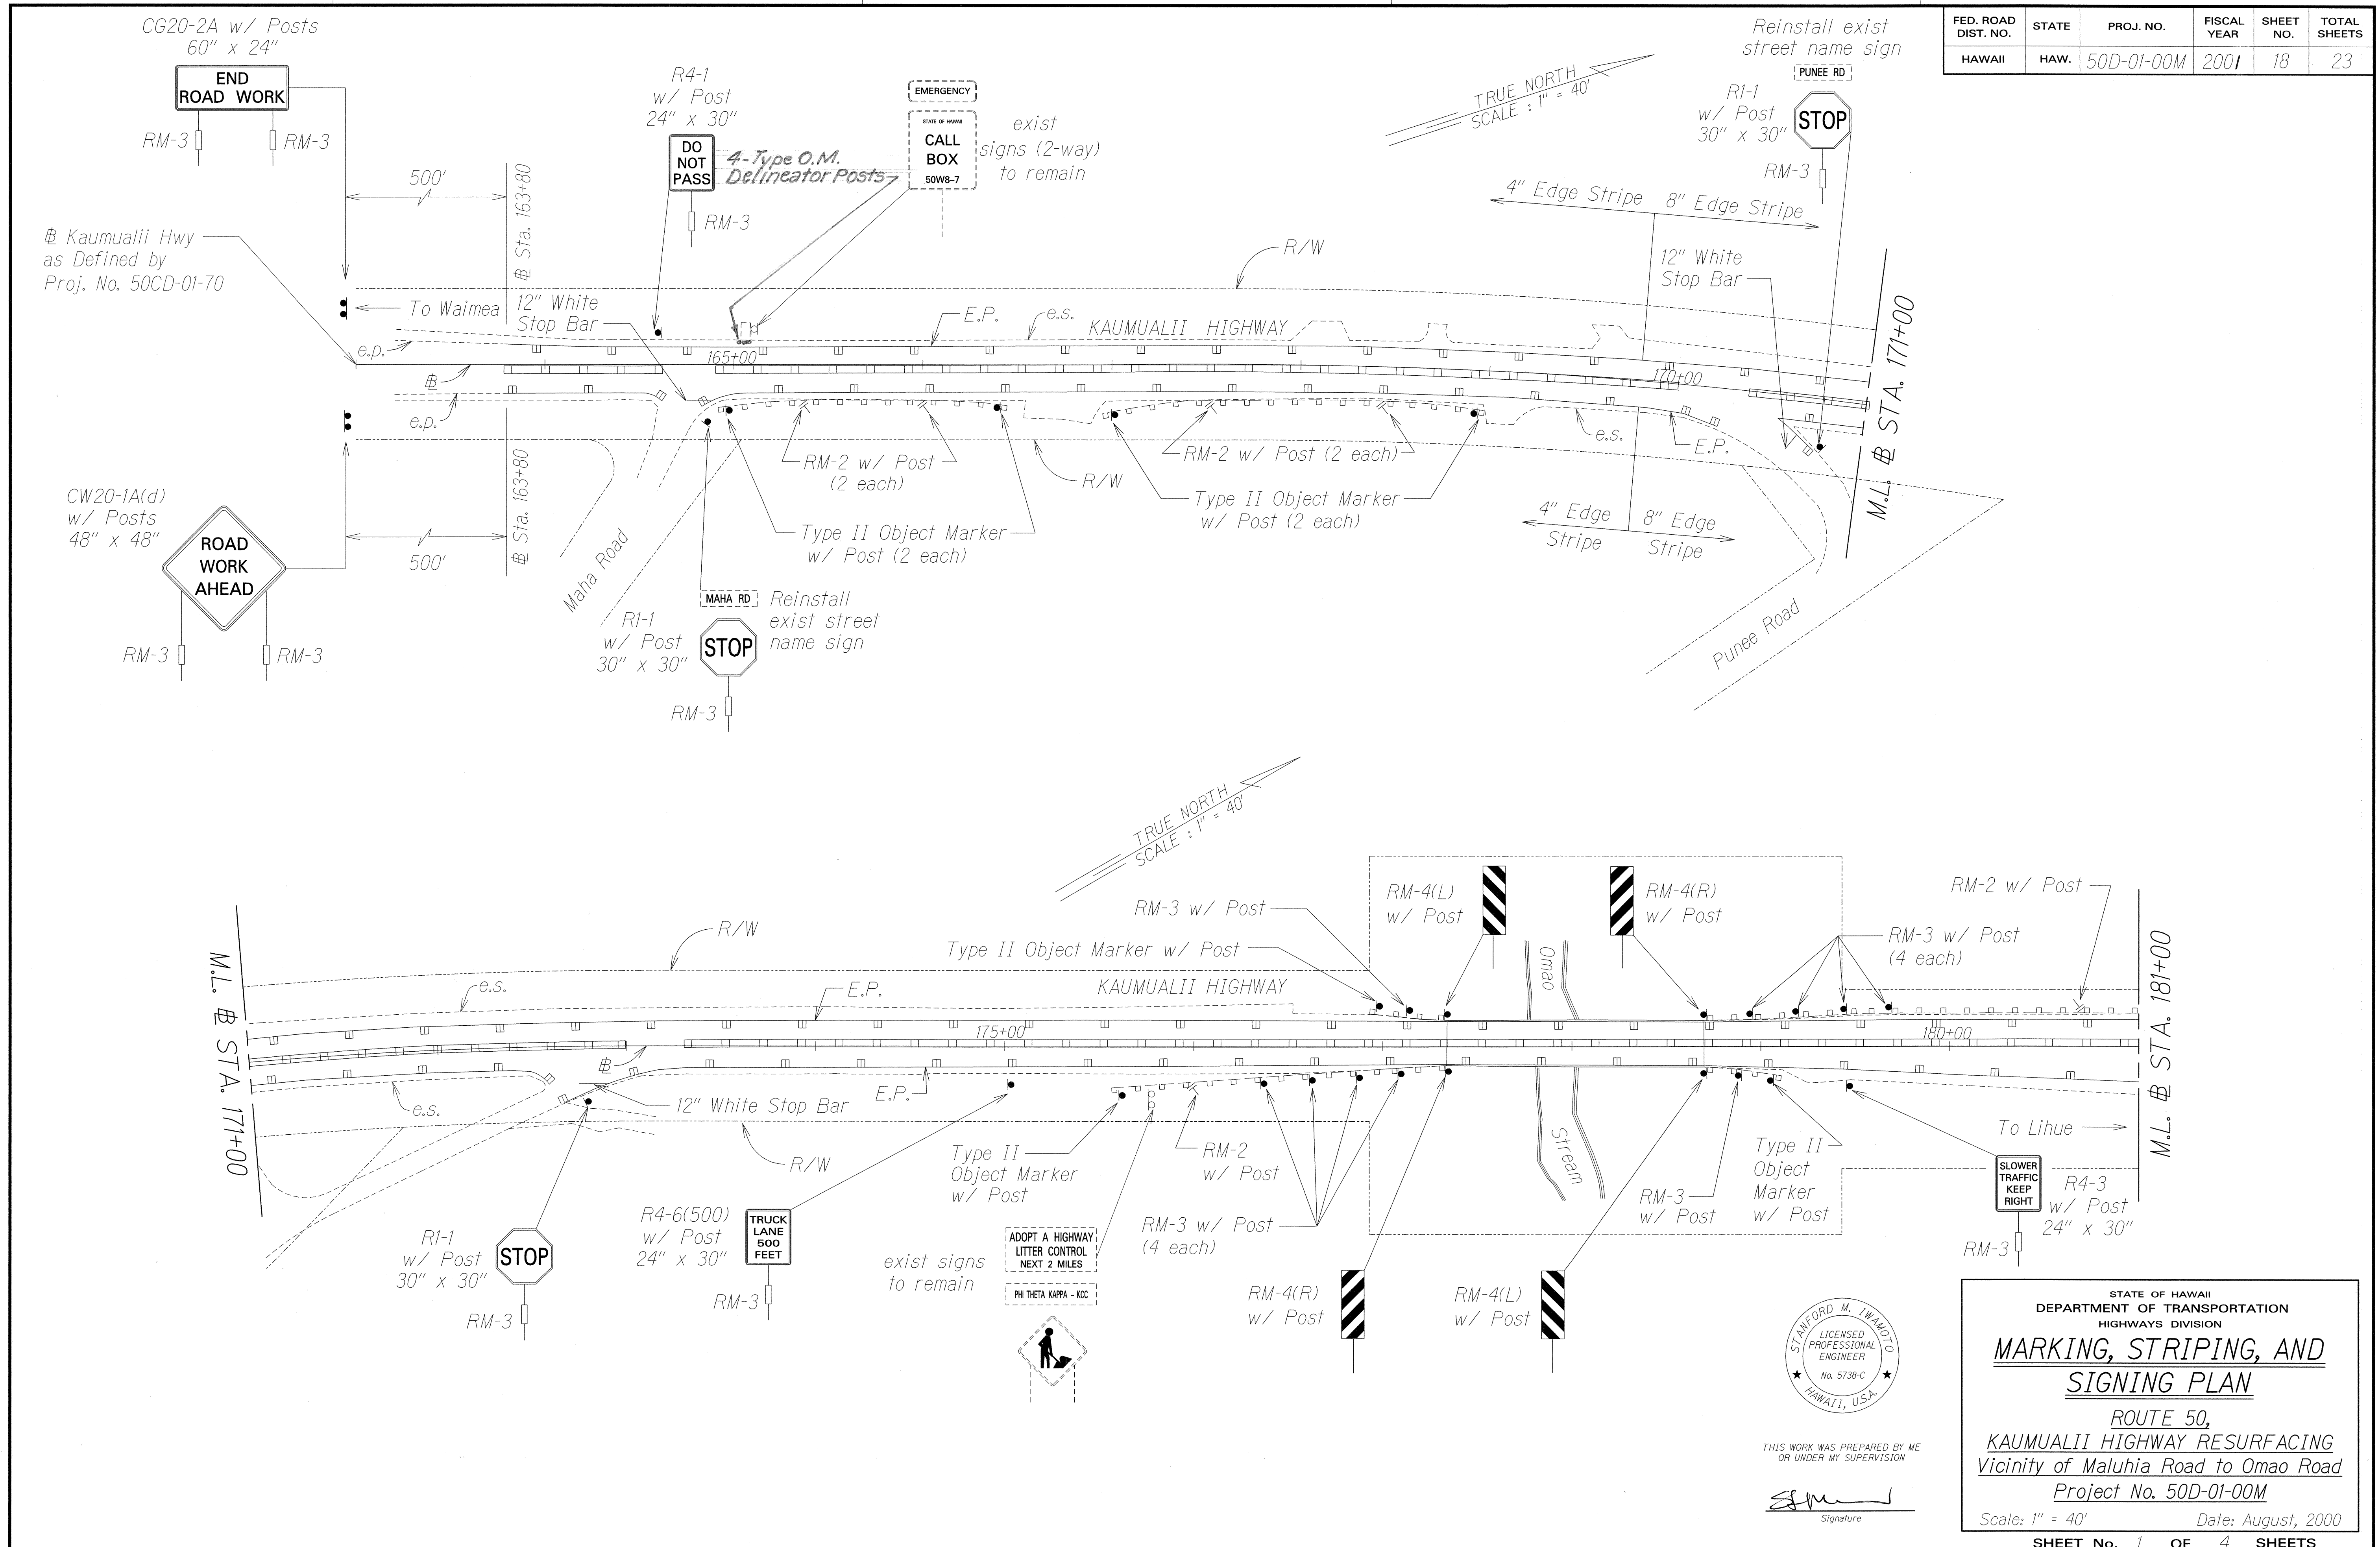

THIS WORK WAS PREPARED BY ME OR UNDER MY SUPERVISION

Stanford M. Iwamoto
Signature

STATE OF HAWAII
DEPARTMENT OF TRANSPORTATION
HIGHWAYS DIVISION



MARKING, STRIPING, AND SIGNING PLAN

ROUTE 50,
KAUMUALII HIGHWAY RESURFACING
Vicinity of Maluhia Road to Omao Road
Project No. 50D-01-00M


Scale: 1" = 40' Date: August, 2000


"AS-BUILT"

FED. ROAD DIST. NO.	STATE	PROJ. NO.	FISCAL YEAR	SHEET NO.	TOTAL SHEETS
HAWAII	HAW.	50D-01-00M	2001	19	23

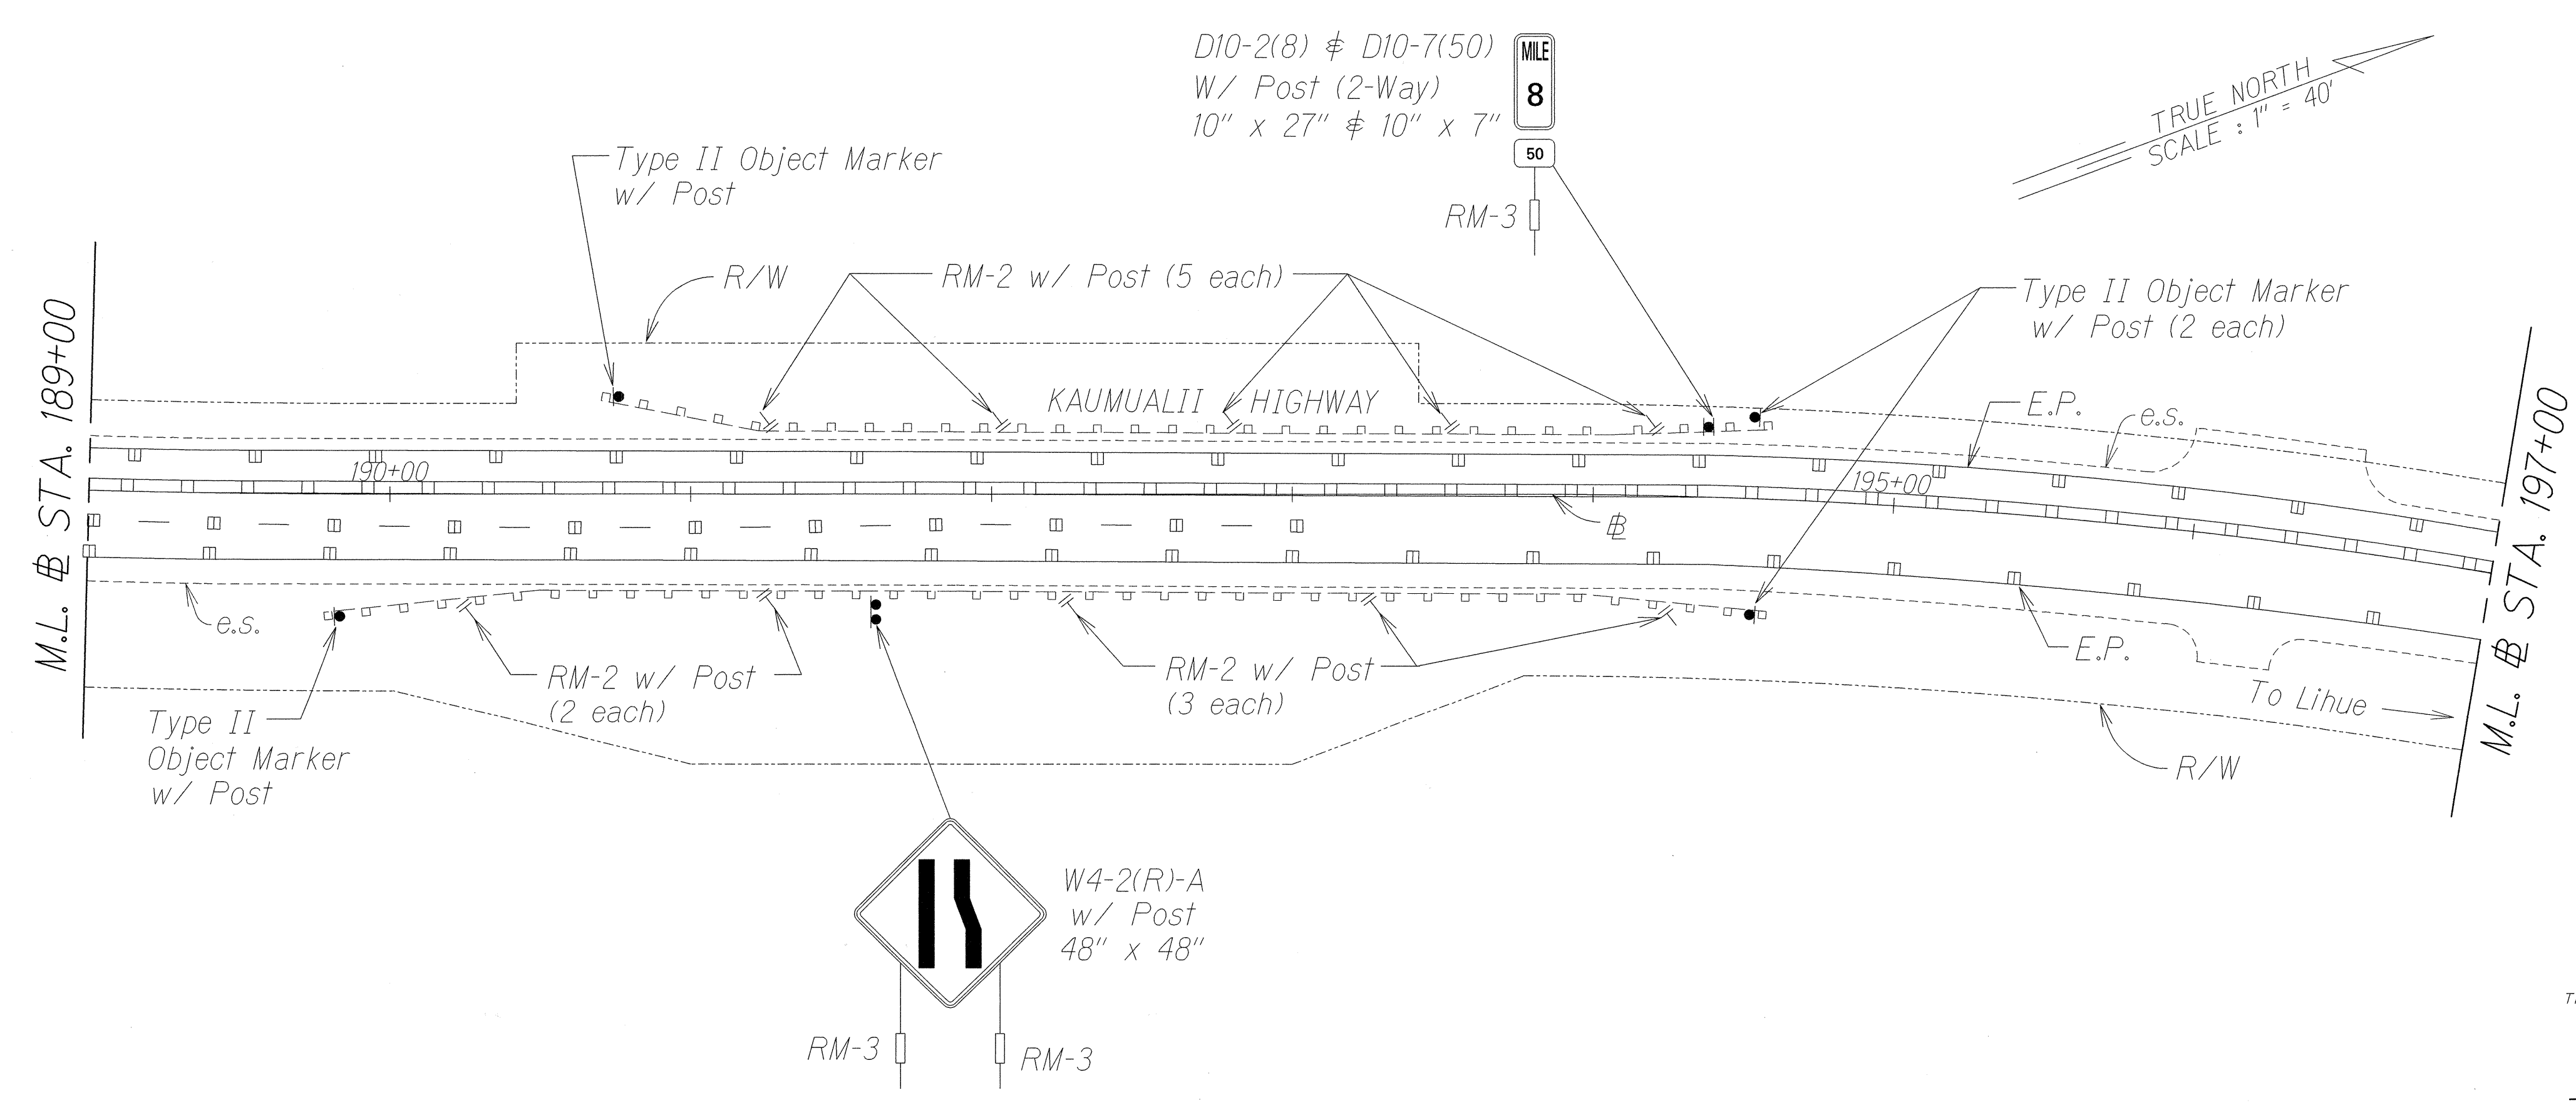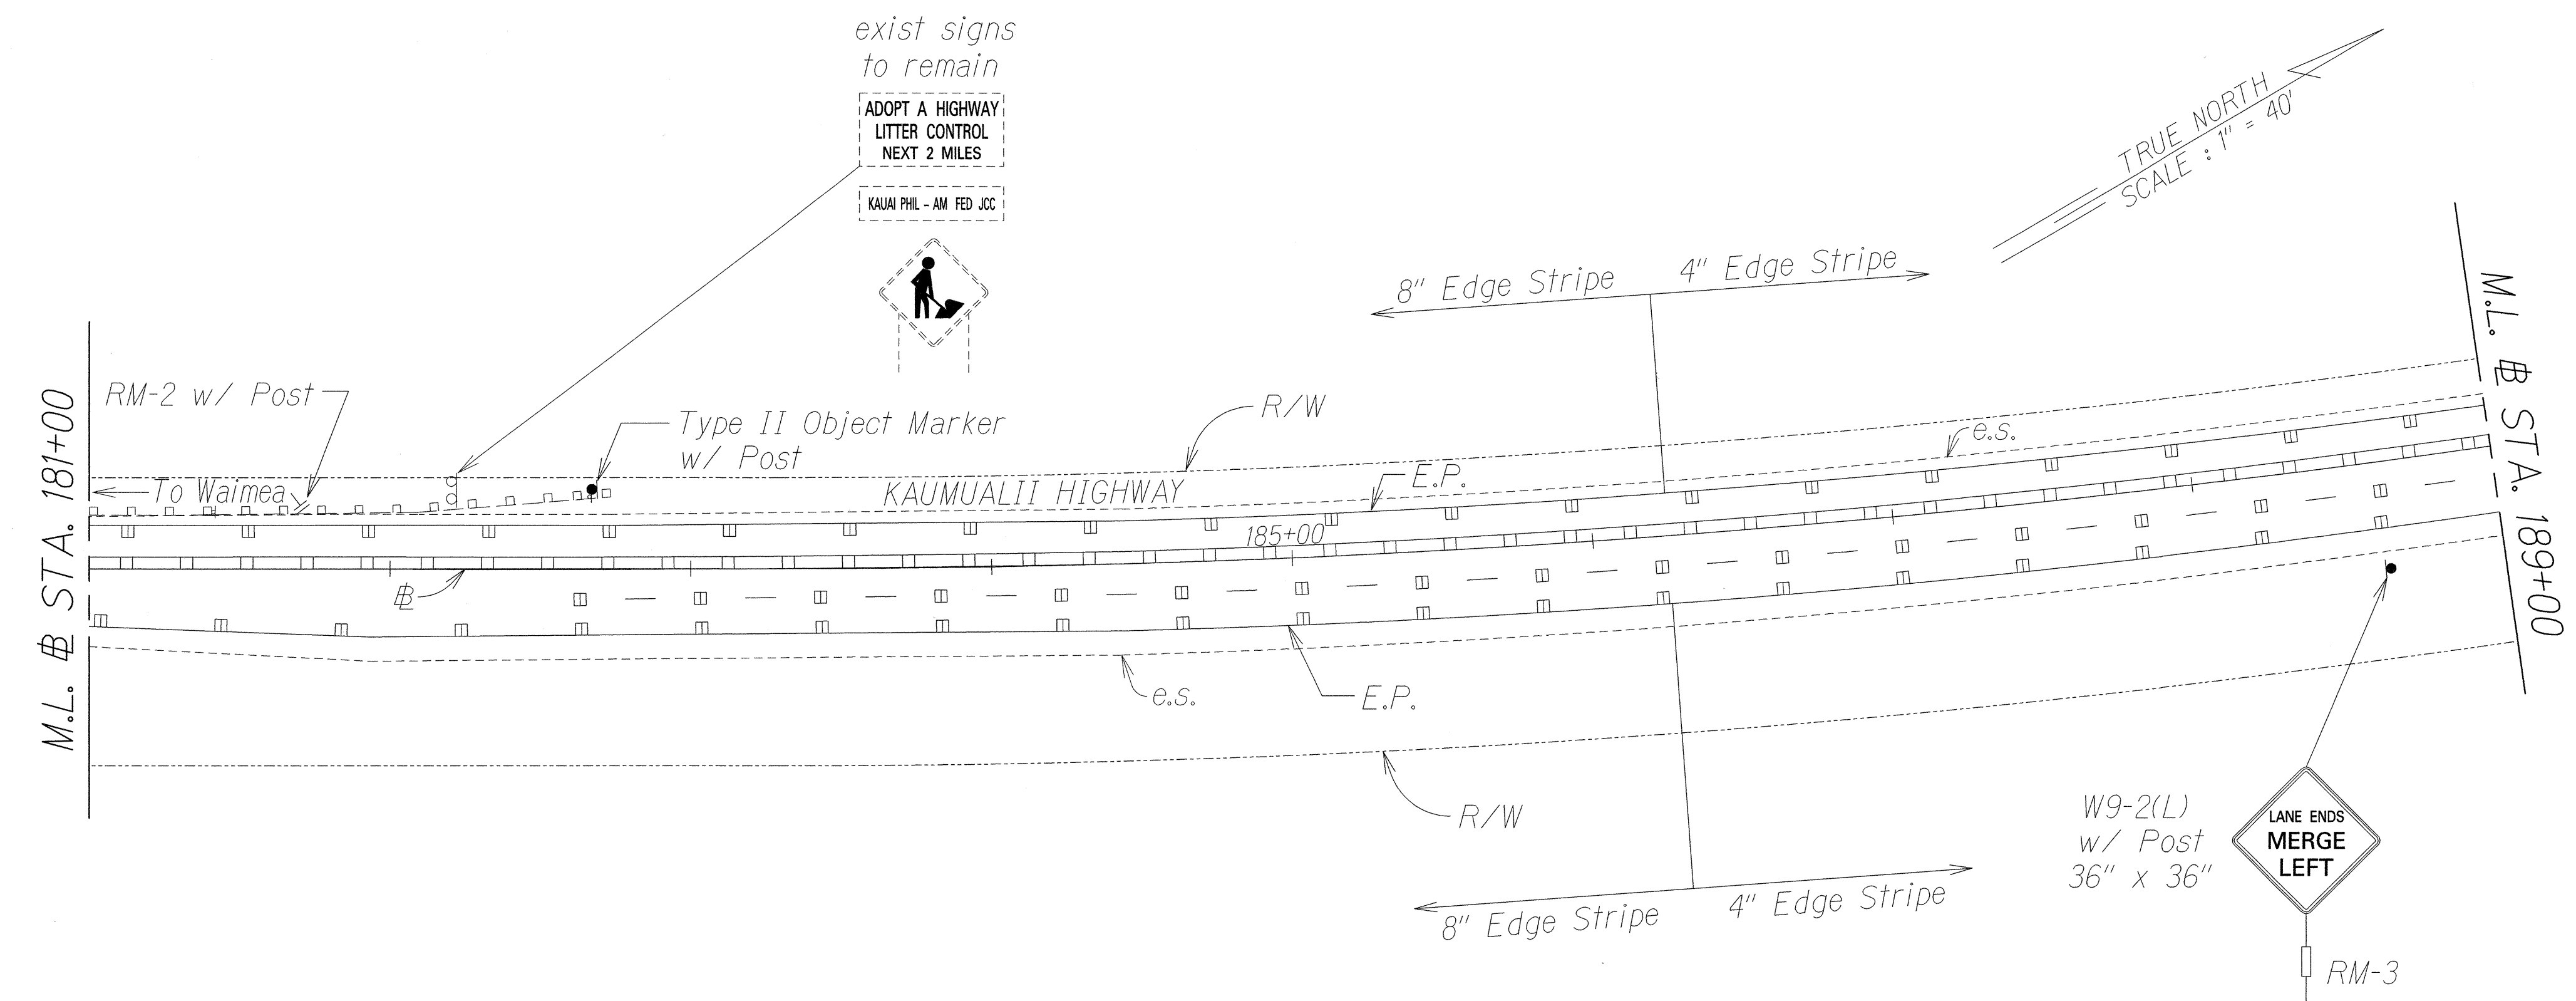



SURVEY PLOTTED BY: _____ DATE: _____
 DRAWN BY: _____
 DESIGNED BY: _____
 CHECKED BY: _____
 ORIGINAL PLAN: _____
 NOTE BOOK: _____
 No. _____
 jkmuk1p02.dgn

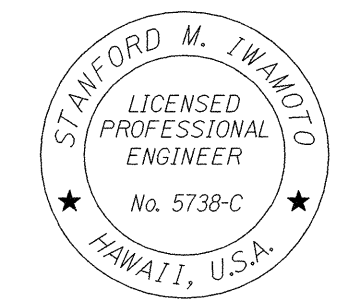

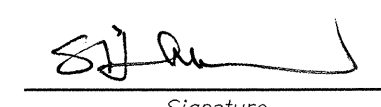THIS WORK WAS PREPARED BY ME
 OR UNDER MY SUPERVISION

 Signature


STATE OF HAWAII
 DEPARTMENT OF TRANSPORTATION
 HIGHWAYS DIVISION
MARKING, STRIPING, AND SIGNING PLAN
 ROUTE 50,
 KAUMUALII HIGHWAY RESURFACING
 Vicinity of Maluhia Road to Omao Road
 Project No. 50D-01-00M
 Scale: 1" = 40' Date: August, 2000
 SHEET No. 2 OF 4 SHEETS

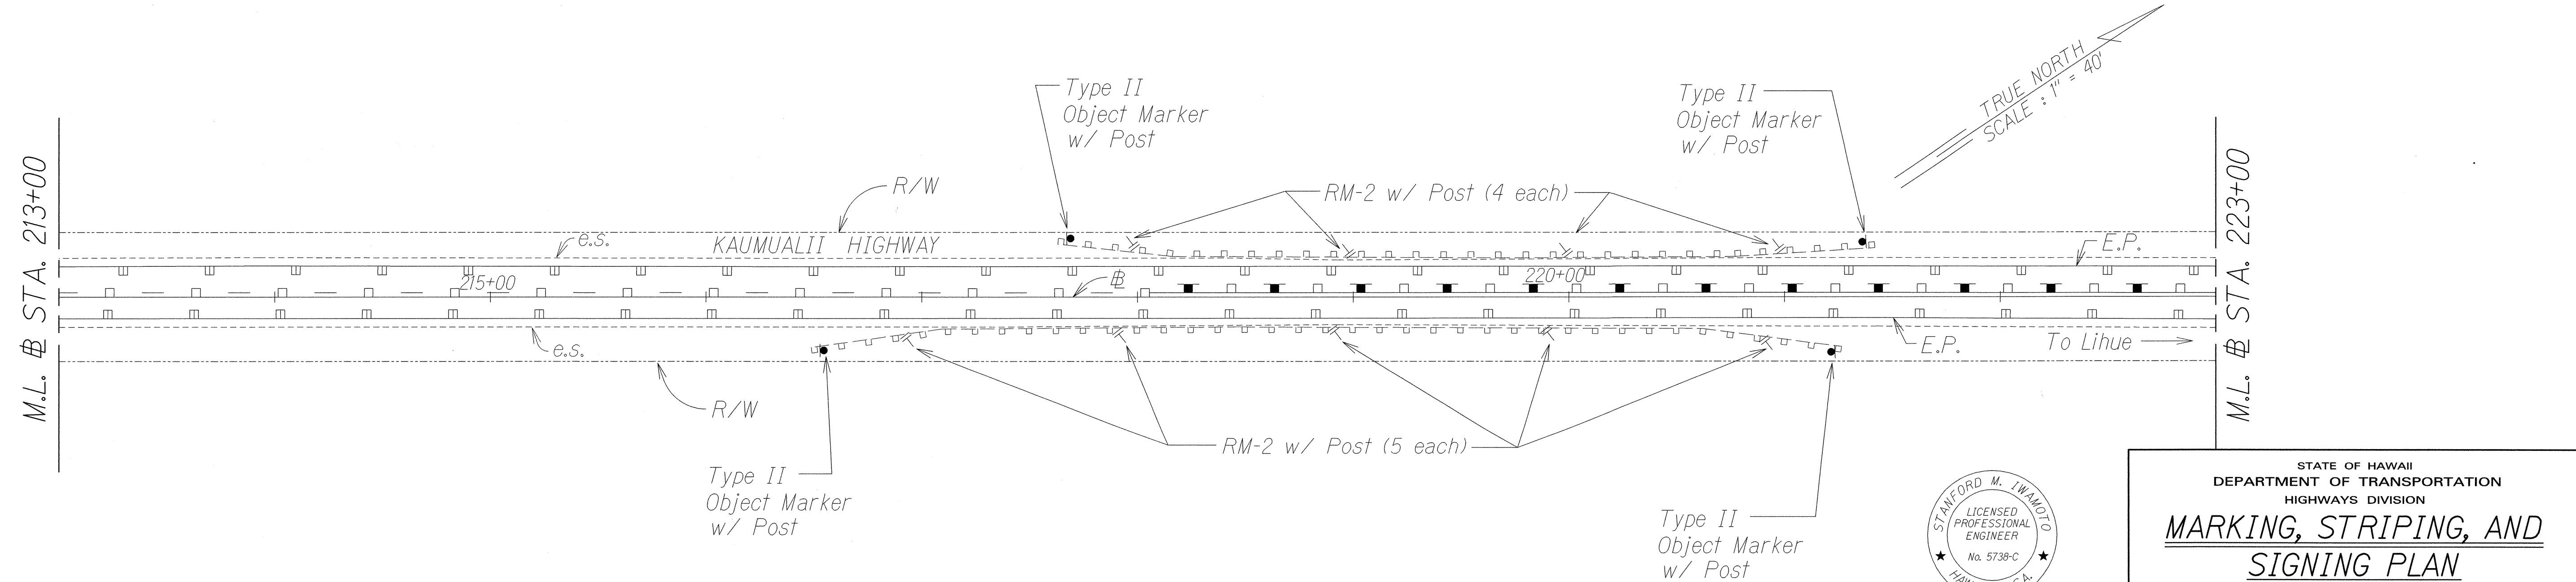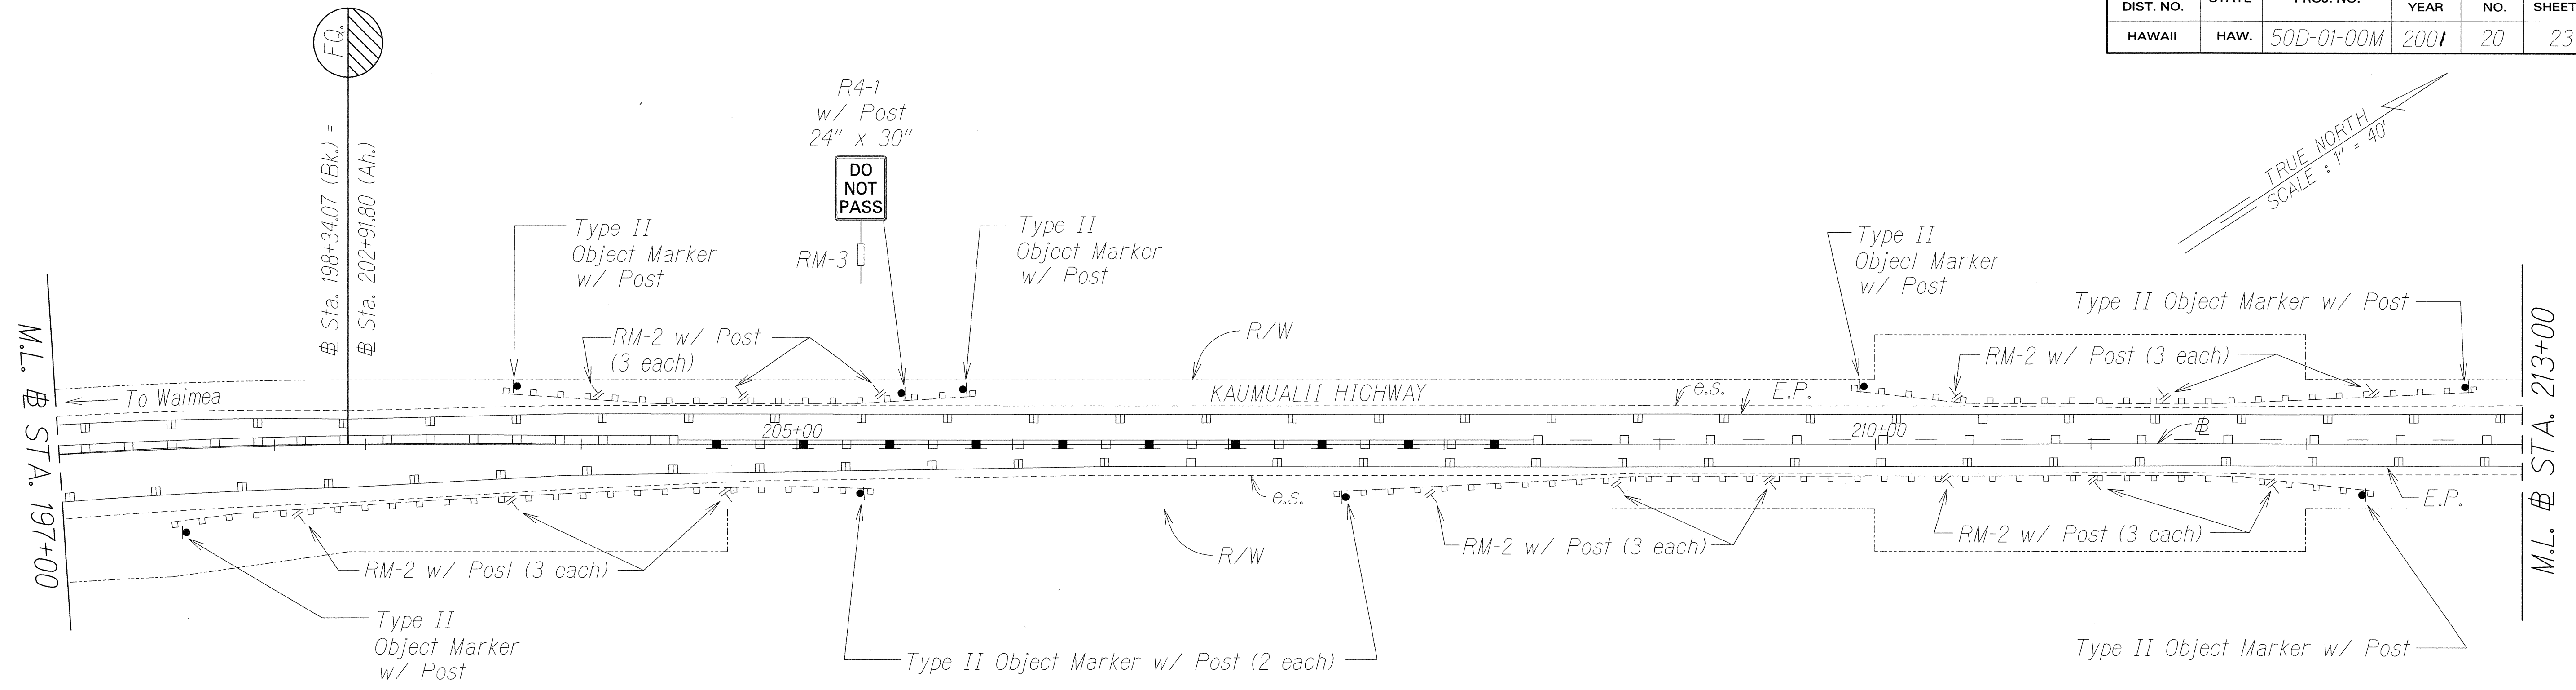FED. ROAD DIST. NO.	STATE	PROJ. NO.	FISCAL YEAR	SHEET NO.	TOTAL SHEETS
HAWAII	HAW.	50D-01-00M	2001	20	23



SURVEY PLOTTED BY	DATE
DRAWN BY	
DESIGNED BY	
CHECKED BY	
ORIGINAL PLAN	
NOTE BOOK	
DATE	

jkmutp03.dgn

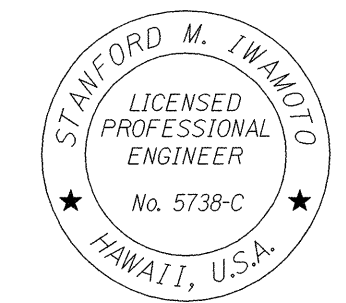

THIS WORK WAS PREPARED BY ME OR UNDER MY SUPERVISION

[Signature]
Signature



STATE OF HAWAII
DEPARTMENT OF TRANSPORTATION
HIGHWAYS DIVISION

MARKING, STRIPING, AND SIGNING PLAN


ROUTE 50,
KAUMUALII HIGHWAY RESURFACING
Vicinity of Maluhia Road to Omao Road
Project No. 50D-01-00M

Scale: 1" = 40' Date: August, 2000

FED. ROAD DIST. NO.	STATE	PROJ. NO.	FISCAL YEAR	SHEET NO.	TOTAL SHEETS
HAWAII	HAW.	50D-01-00M	2001	21	23

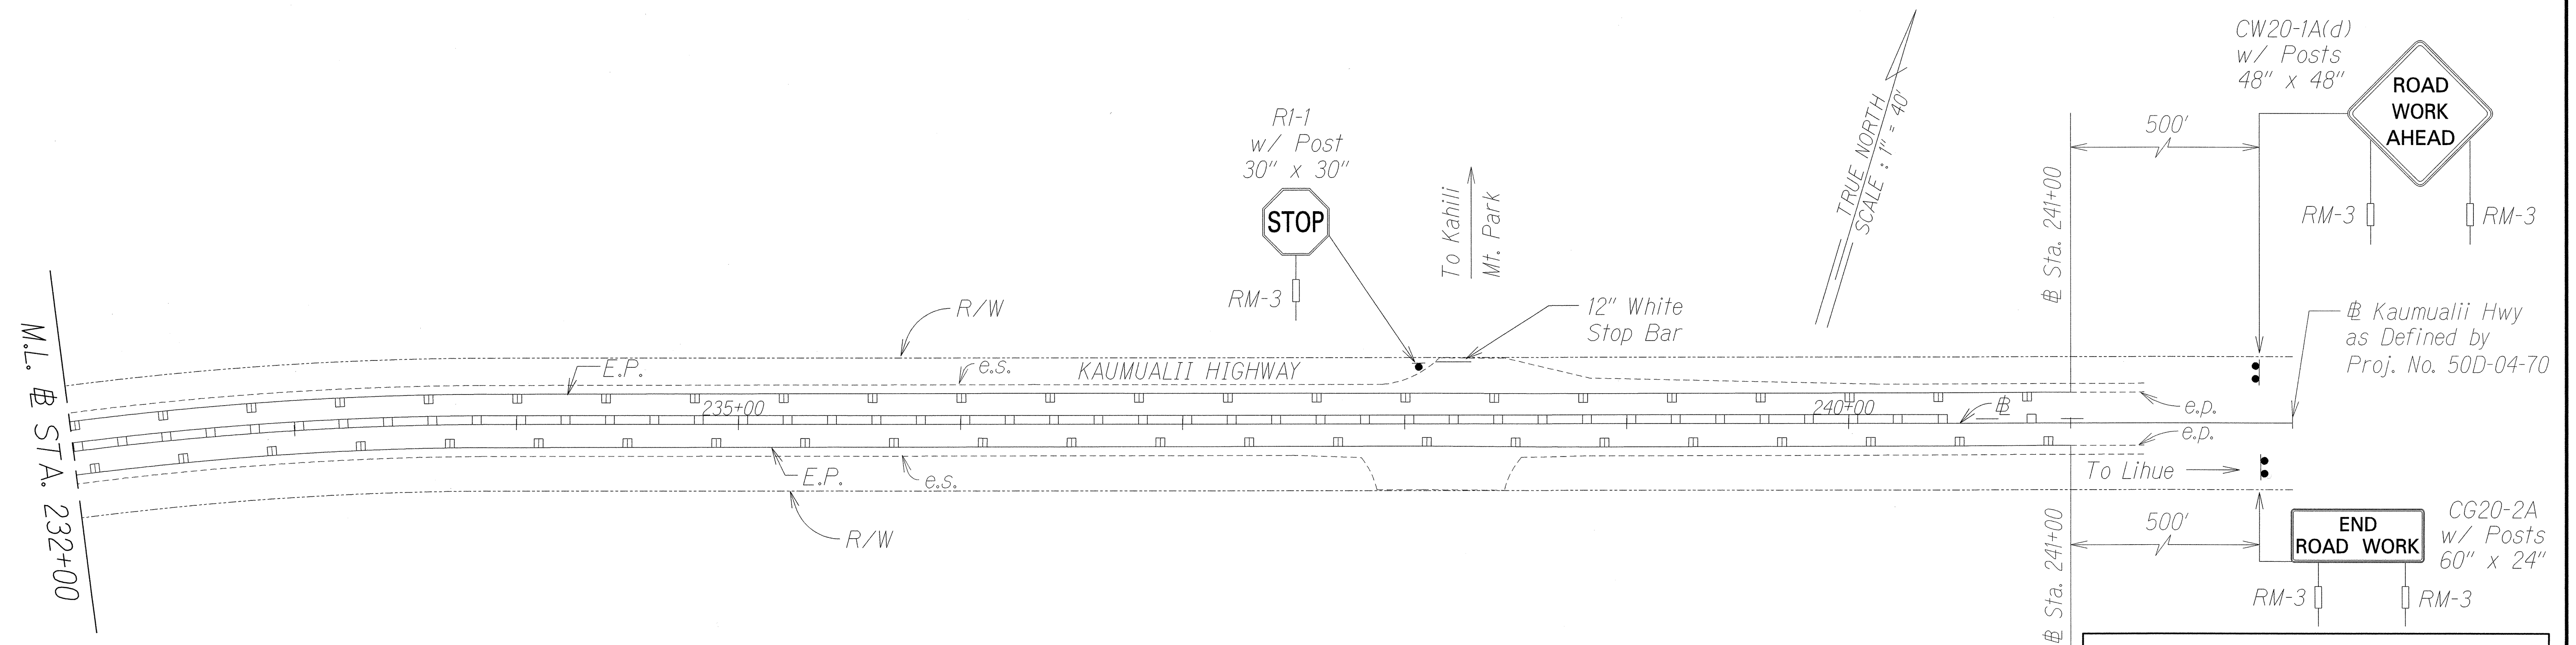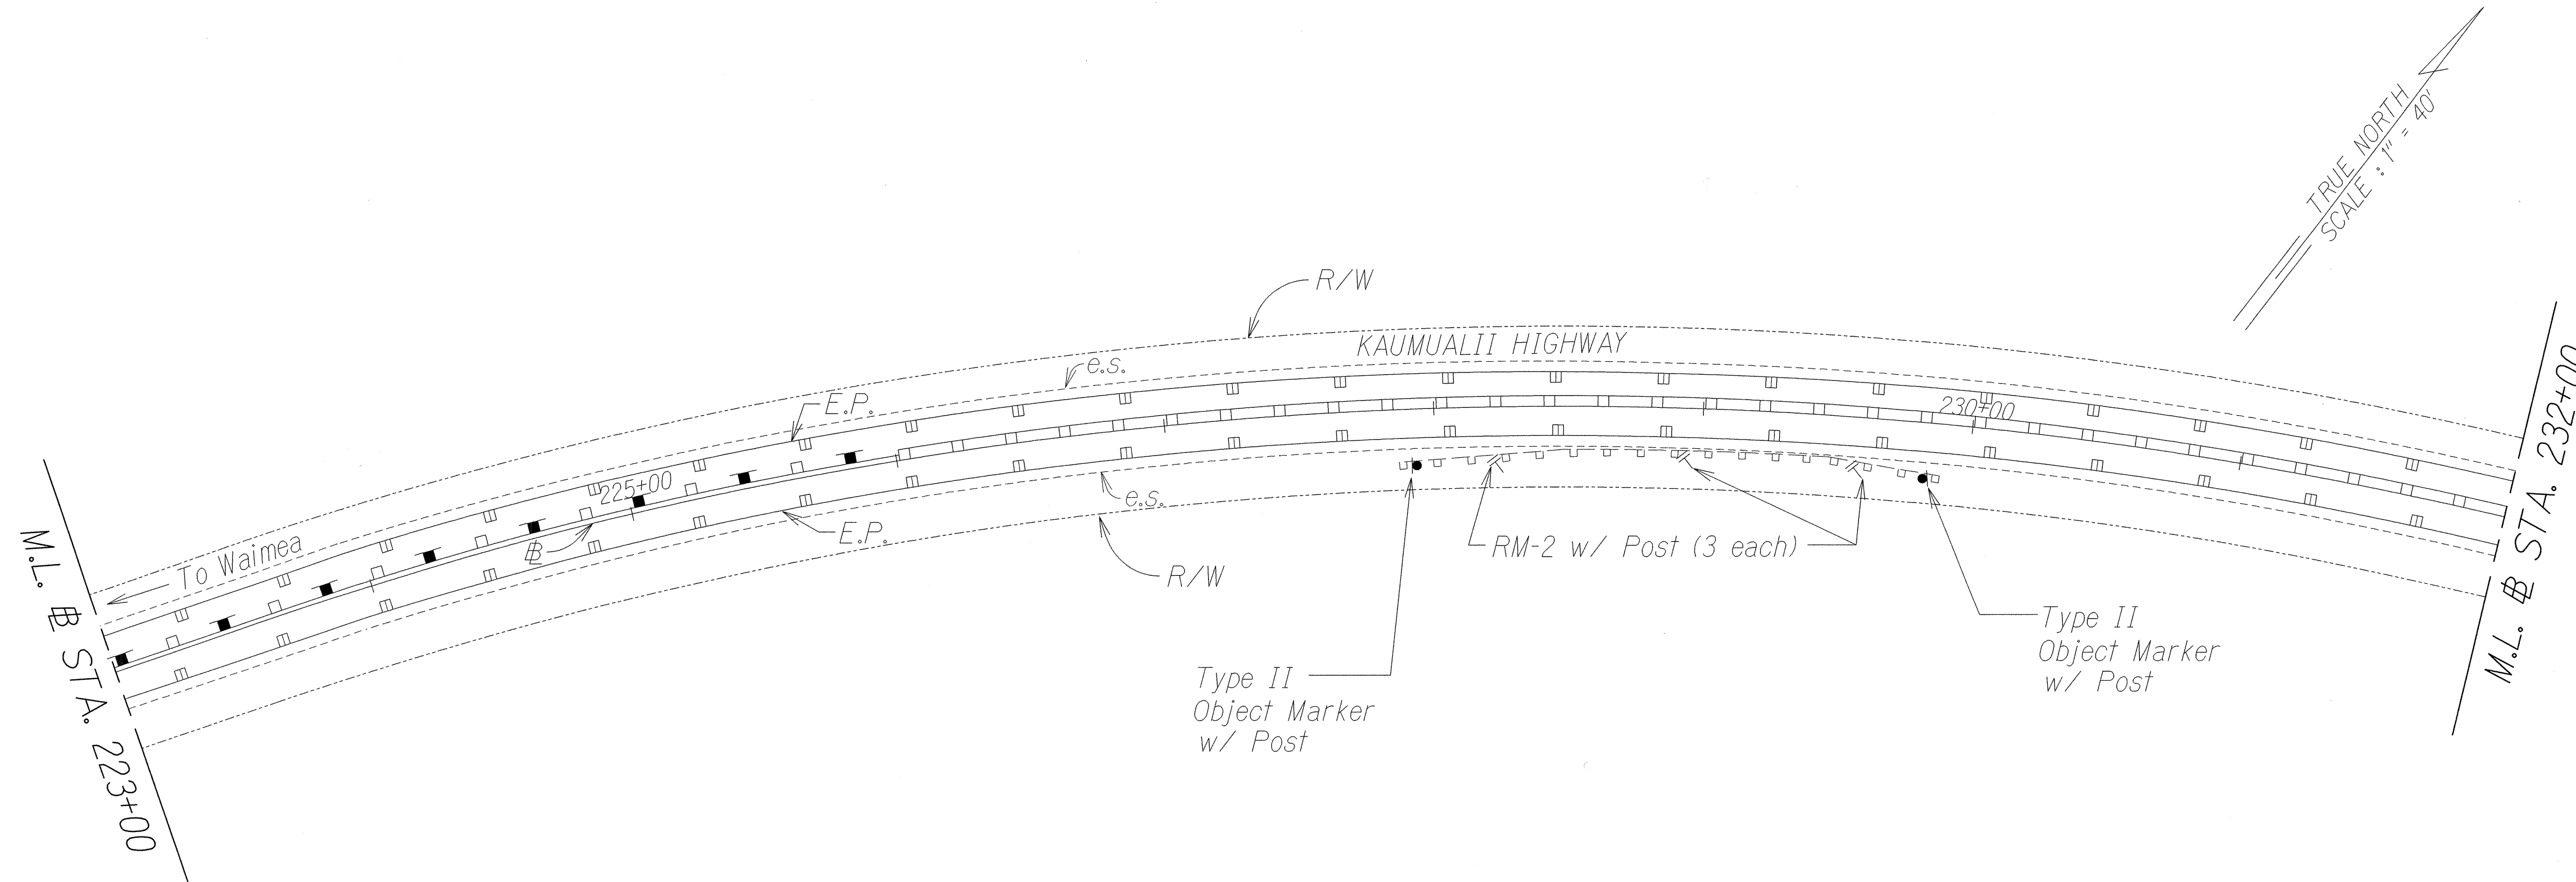

SURVEY PLOTTED BY _____ DATE _____
 DRAWN BY _____
 DESIGNED BY _____
 CHECKED BY _____
 ORIGINAL PLAN NOTE BOOK NO. _____
 jkmuktp04.dgn

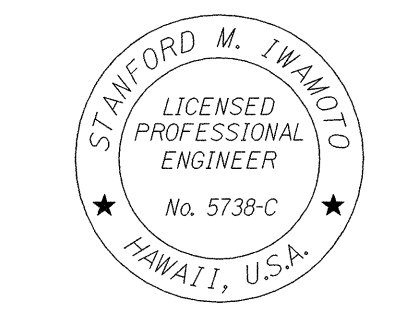

THIS WORK WAS PREPARED BY ME OR UNDER MY SUPERVISION

Stanford M. Iwamoto
Signature

STATE OF HAWAII
 DEPARTMENT OF TRANSPORTATION
 HIGHWAYS DIVISION
MARKING, STRIPING, AND SIGNING PLAN
 ROUTE 50,
 KAUMUALII HIGHWAY RESURFACING
 Vicinity of Maluhia Road to Omao Road
 Project No. 50D-01-00M
 Scale: 1" = 40' Date: August, 2000
 SHEET No. 4 OF 4 SHEETS