INDEX TO DRAWINGS	
SHEET NO.	DESCRIPTION
1	TITLE SHEET
2	STANDARD PLANS SUMMARY
3	GENERAL NOTES AND LEGEND
4	TYPICAL SECTIONS
5 – 7	TYPICAL PLANS, SECTIONS, AND DETAILS
8 – 9	DRAINAGE DETAILS
10	FLEAT-350 FLARED ENERGY ABSORBING TERMINAL
11	STRONG POST W-BEAM GUARDRAIL
12	GUARDRAIL DETAILS AND NOTES
13 – 16	ROADWAY PLAN
17	PAVEMENT MARKING LEGEND AND NOTES
18 – 21	MARKING, STRIPING, AND SIGNING PLAN
22	TRAFFIC AND PAVEMENT MARKING SUMMARIES
23	TRAFFIC CONTROL PLAN WITHIN COUNTY RIGHT-OF-WAY

STATE OF HAWAII

## DEPARTMENT OF TRANSPORTATION

HIGHWAYS DIVISION
HONOLULU, HAWAII


PLANS FOR


## ROUTE 50,

## KAUMUALII HIGHWAY RESURFACING


VICINITY OF MALUHIA ROAD TO OMAO ROAD PROJECT NO. 50D-01-00M


DISTRICT OF KOLOA ISLAND OF KAUAI

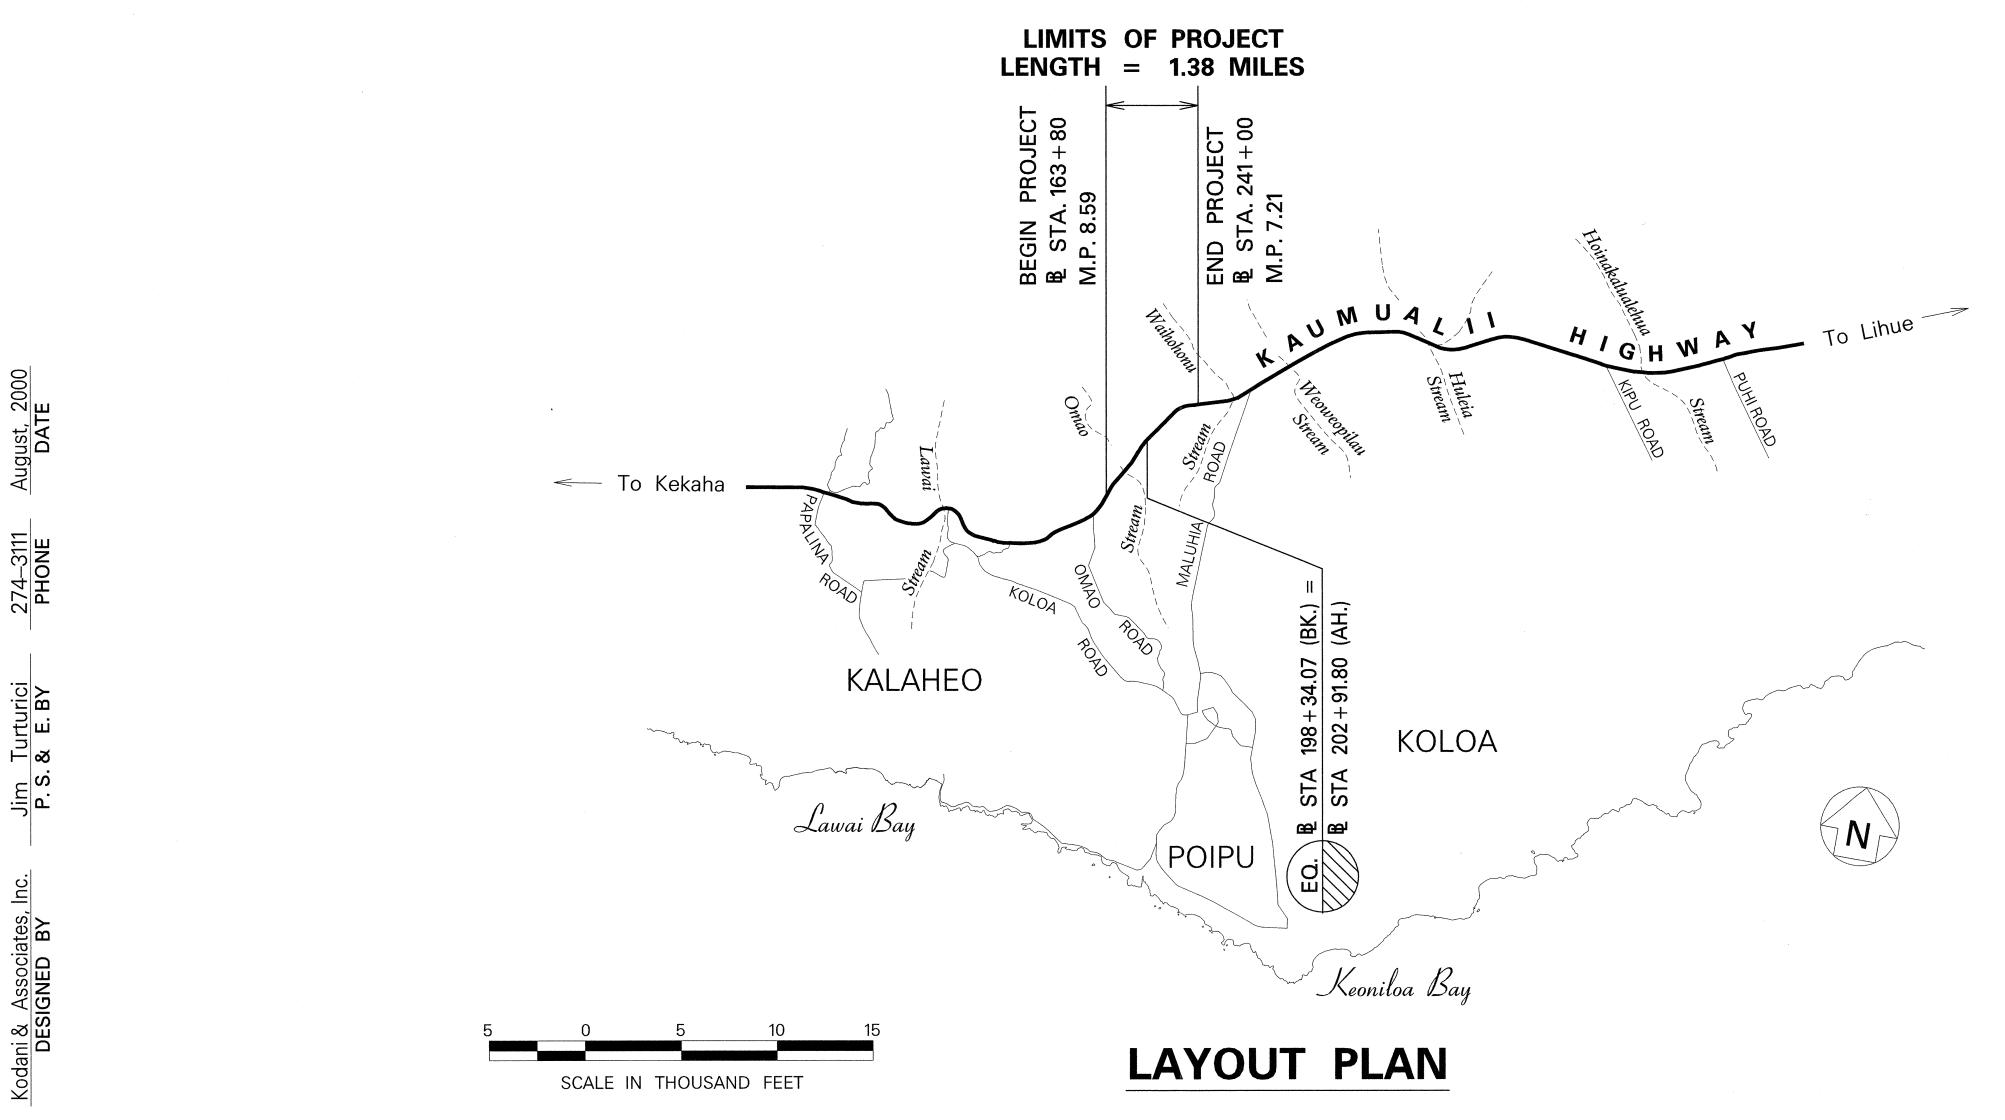

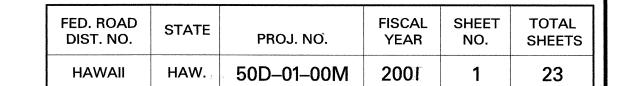



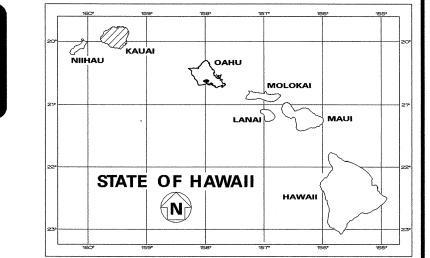

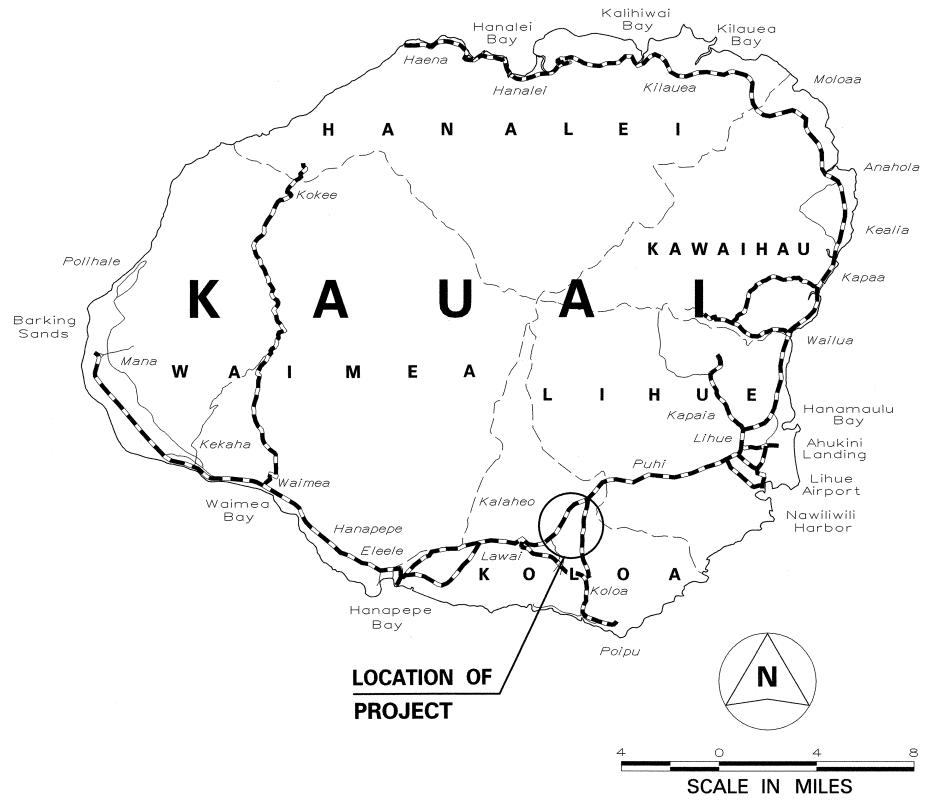

 FEDERAL AID PROJECTS PREVIOUSLY CONSTRUCTED OR UNDER CONSTRUCTION

MILE POST 7.21 TO MILE POST 8.59



CHANGES MADE DURING CONSTRUCTION HAVE BEEN INCORPORATED ON THESE PLANS EXCEPT CHANGES IN THE ORIGINAL THEORETICAL QUANTITIES. FOR ACTUAL QUANTITIES, REFER TO PROJECT LEDGER AND/OR COMPYTION BOOK.

2-23-04

RESIDENT ENGINEER DATE

THIS WORK WAS PREPARED BY ME OR UNDER MY SUPERVISION

DEPARTMENT OF TRANSPORTATION STATE OF HAWAII

Signature

APPROVED: Mern Mohnut

DIR. OF TRANSPORTATION DATE