



FED. ROAD DIST. NO.	STATE	FED. AID PROJ. NO.	FISCAL YEAR	SHEET NO.	TOTAL SHEETS
HAWAII	HAW.	STP-050-1(20)	2000	12	28

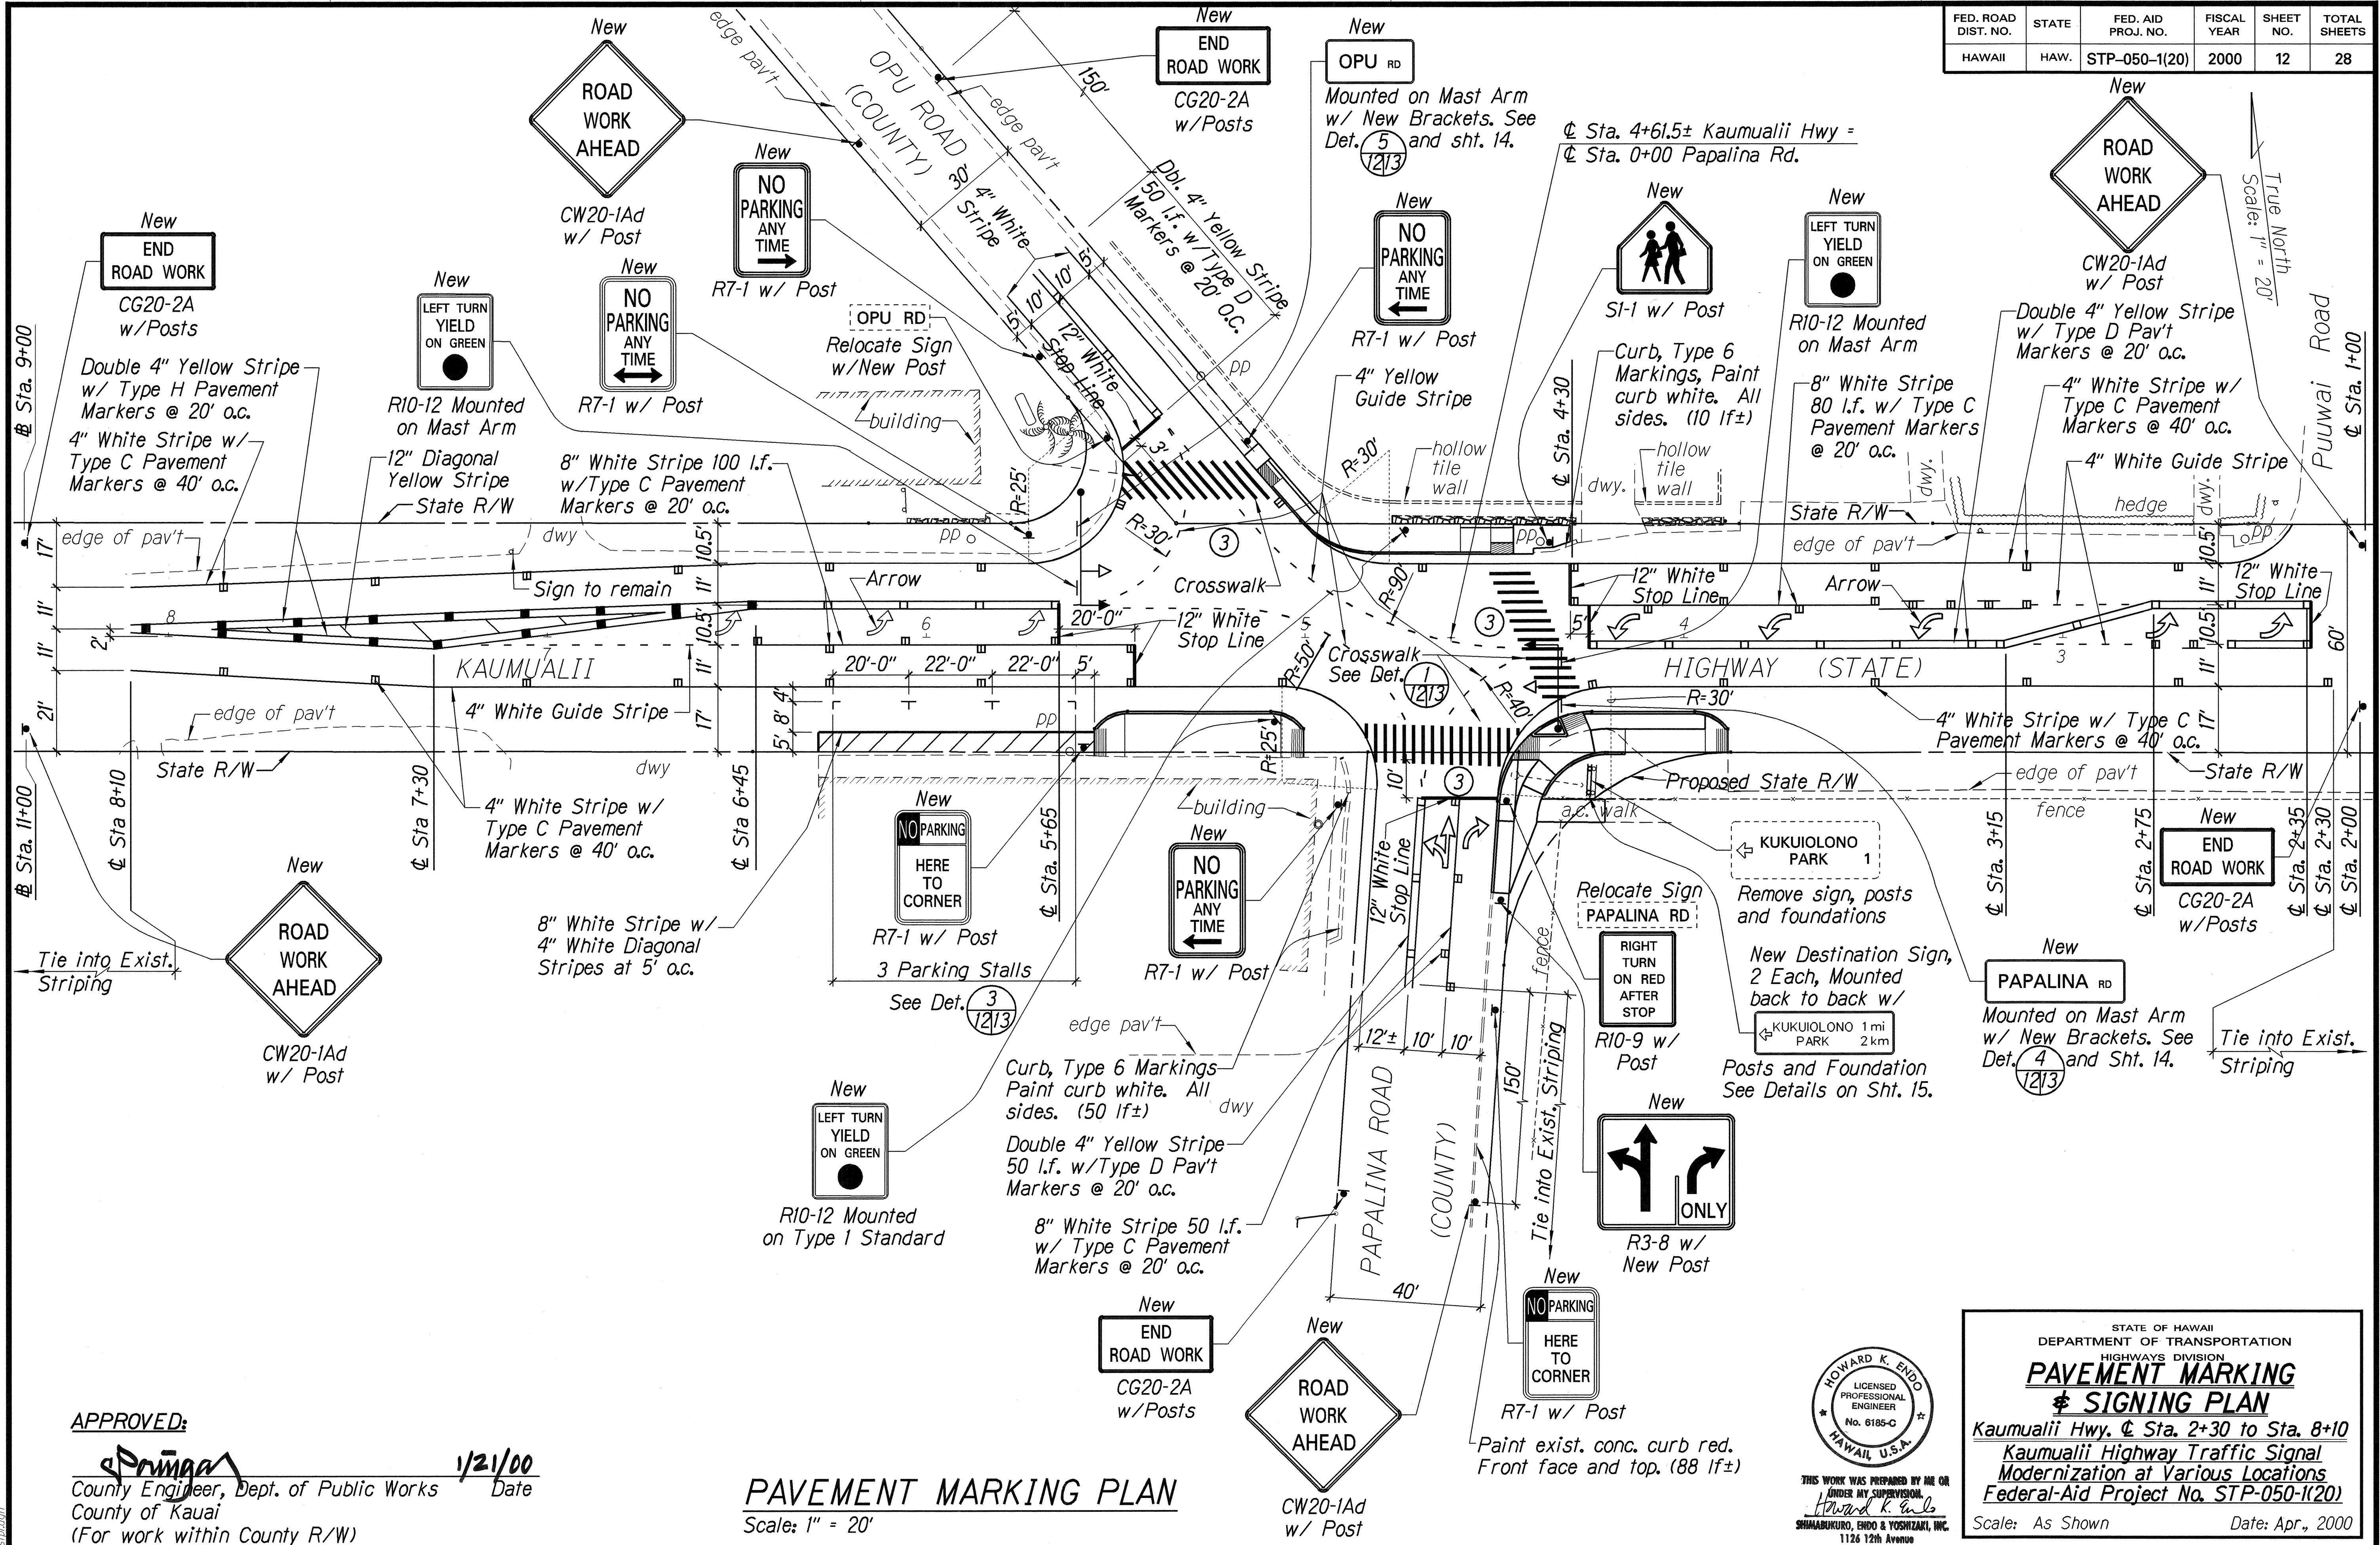

APPROVED: *[Signature]* 1/21/00
 County Engineer, Dept. of Public Works
 County of Kauai
 (For work within County R/W)

PAVEMENT MARKING PLAN
 Scale: 1" = 20'

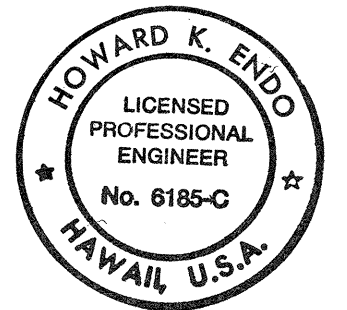

STATE OF HAWAII
 DEPARTMENT OF TRANSPORTATION
 HIGHWAYS DIVISION
PAVEMENT MARKING & SIGNING PLAN
 Kaumualii Hwy. & Sta. 2+30 to Sta. 8+10
 Kaumualii Highway Traffic Signal
 Modernization at Various Locations
 Federal-Aid Project No. STP-050-1(20)
 Scale: As Shown Date: Apr., 2000
 SHEET No. 1 OF 1 SHEETS

ORIGINAL PLAN	DATE
DRAWN BY	
CHECKED BY	
NOTED BY	
QUANTITIES BY	
CHECKED BY	