
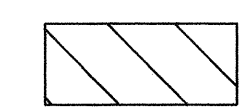
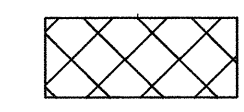


FED. ROAD DIST. NO.	STATE	FED. AID PROJ. NO.	FISCAL YEAR	SHEET NO.	TOTAL SHEETS
HAWAII	HAW.	STP-050-1(20)	2000	6	28

LEGEND

-  Demolish and dispose of asphalt concrete pavement. Fill area and grade, with imported planting soil (6" min. thickness) and grassed surface.
-  Fill and grade, w/imported planting soil (6" min. thickness) and grassed surface.
-  Demolish and dispose of asphalt concrete pavement. Construct Asphalt Concrete Pavement, Mix No. IV.

True North
Scale: 1" = 10'

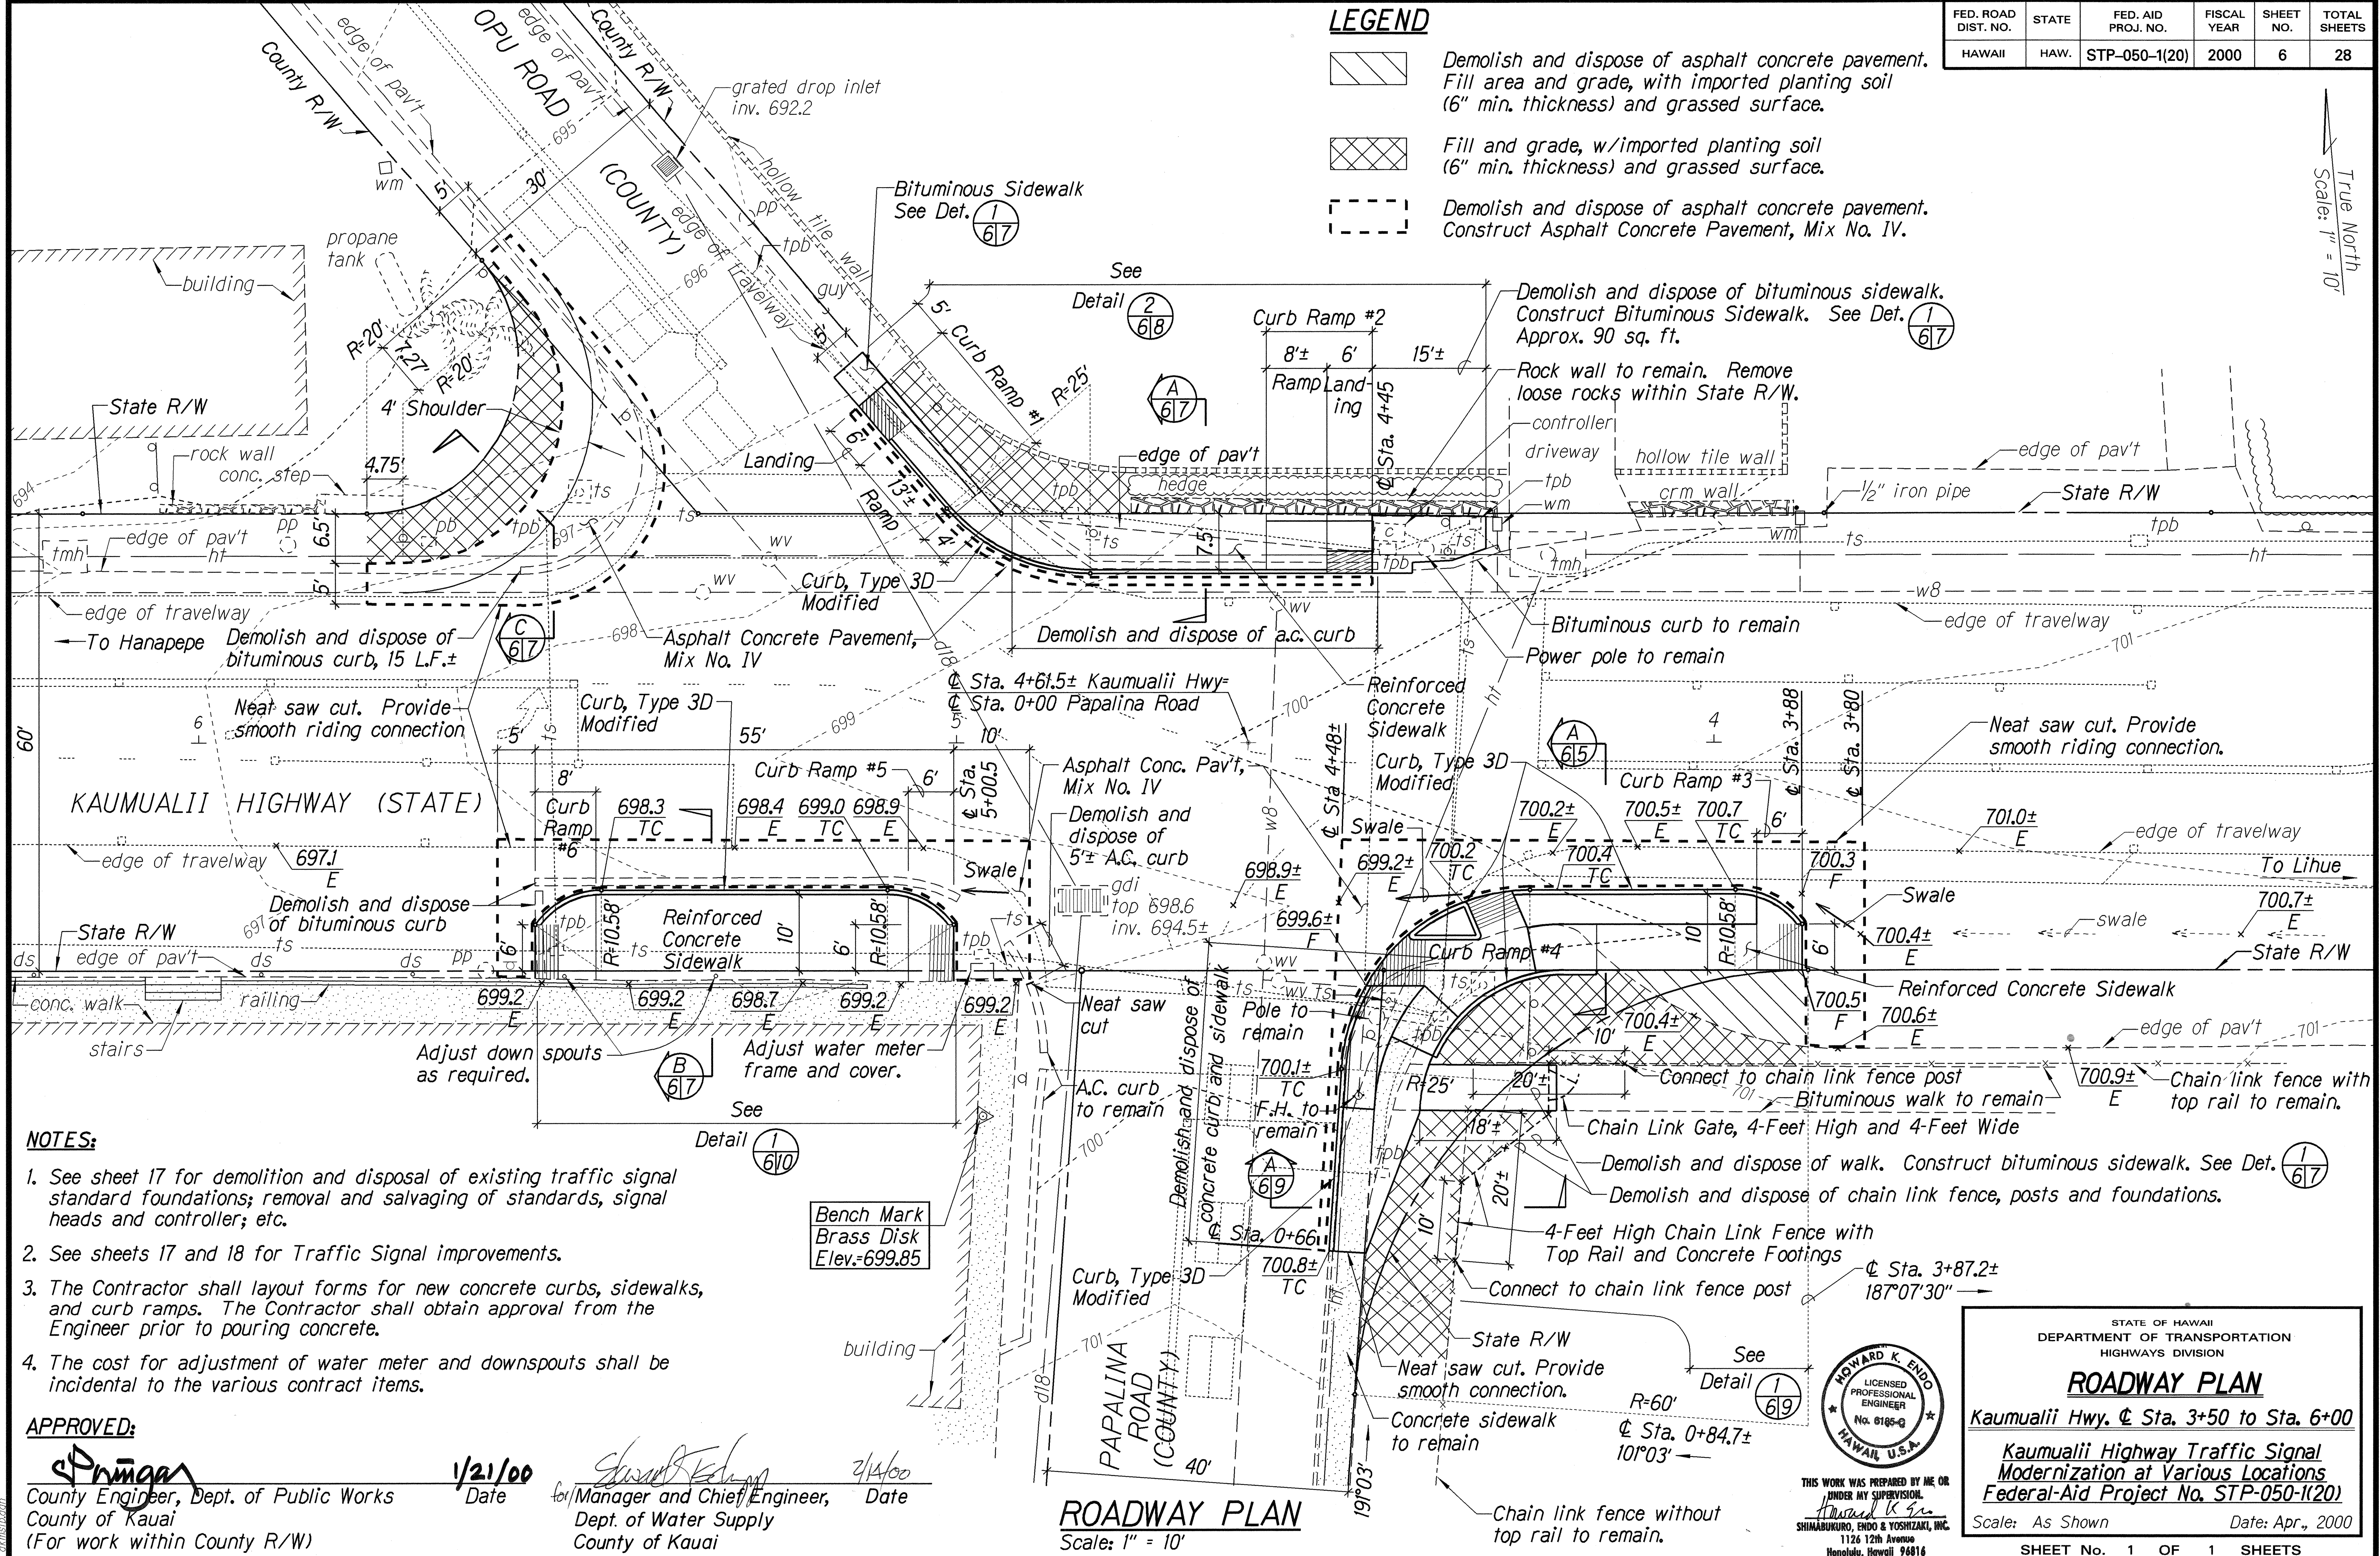

NOTES:

- See sheet 17 for demolition and disposal of existing traffic signal standard foundations; removal and salvaging of standards, signal heads and controller; etc.
- See sheets 17 and 18 for Traffic Signal improvements.
- The Contractor shall layout forms for new concrete curbs, sidewalks, and curb ramps. The Contractor shall obtain approval from the Engineer prior to pouring concrete.
- The cost for adjustment of water meter and downspouts shall be incidental to the various contract items.


APPROVED:

County Engineer, Dept. of Public Works
County of Kauai
(For work within County R/W)

Date 1/21/00
for Manager and Chief Engineer,
Dept. of Water Supply
County of Kauai

ROADWAY PLAN

Scale: 1" = 10'

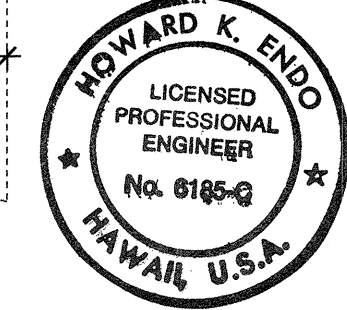

THIS WORK WAS PREPARED BY ME OR UNDER MY SUPERVISION.
SHINABUKURO, ENDO & YOSHIZAKI, INC.
1124 12th Avenue
Honolulu, Hawaii 96816

STATE OF HAWAII
DEPARTMENT OF TRANSPORTATION
HIGHWAYS DIVISION

ROADWAY PLAN

Kaumualii Hwy. & Sta. 3+50 to Sta. 6+00

Kaumualii Highway Traffic Signal
Modernization at Various Locations
Federal-Aid Project No. STP-050-1(20)

Scale: As Shown Date: Apr., 2000

SHEET No. 1 OF 1 SHEETS