

SHEET NO.	INDEX TO DRAWINGS
1	TITLE SHEET
2	STANDARD PLANS SUMMARY
3	GENERAL NOTES & LEGEND
4 - 14	ROADWAY PLANS (PHASE 1)
15	PORTABLE PHYSICAL BARRIER DETAILS
16	AC PAVEMENT UNDER FLEAT-350
17	GUARDRAIL DETAILS & NOTES
18	GUARDRAIL DETAILS
19	STRONG POST W-BEAM GUARDRAIL
20	STRONG POST MODIFIED THRIE-BEAM GUARDRAIL
21	FLEAT-350
22	THRIE BEAM INSTALLATION
23 - 24	QUANTITY SUMMARIES
25 - 32 ^①	ROADWAY PLANS (PHASE 2)

SHEETS NO. ②5-32 ARE SUPPLEMENTAL SHEETS TO THIS PROJECT. TOTAL SHEET COUNT AFTER "AS-BUILT" POSTING IS 32 SHEETS.

STATE OF HAWAII

DEPARTMENT OF TRANSPORTATION

HIGHWAYS DIVISION

HONOLULU, HAWAII

"AS-BUILT" PLANS FOR


KAUMUALII HIGHWAY

GUARDRAIL AND SHOULDER IMPROVEMENTS

AT VARIOUS LOCATIONS

FEDERAL AID PROJECT NO. STP-050-1(22)

DISTRICTS OF LIHUE AND KOLOA
ISLAND OF KAUAI


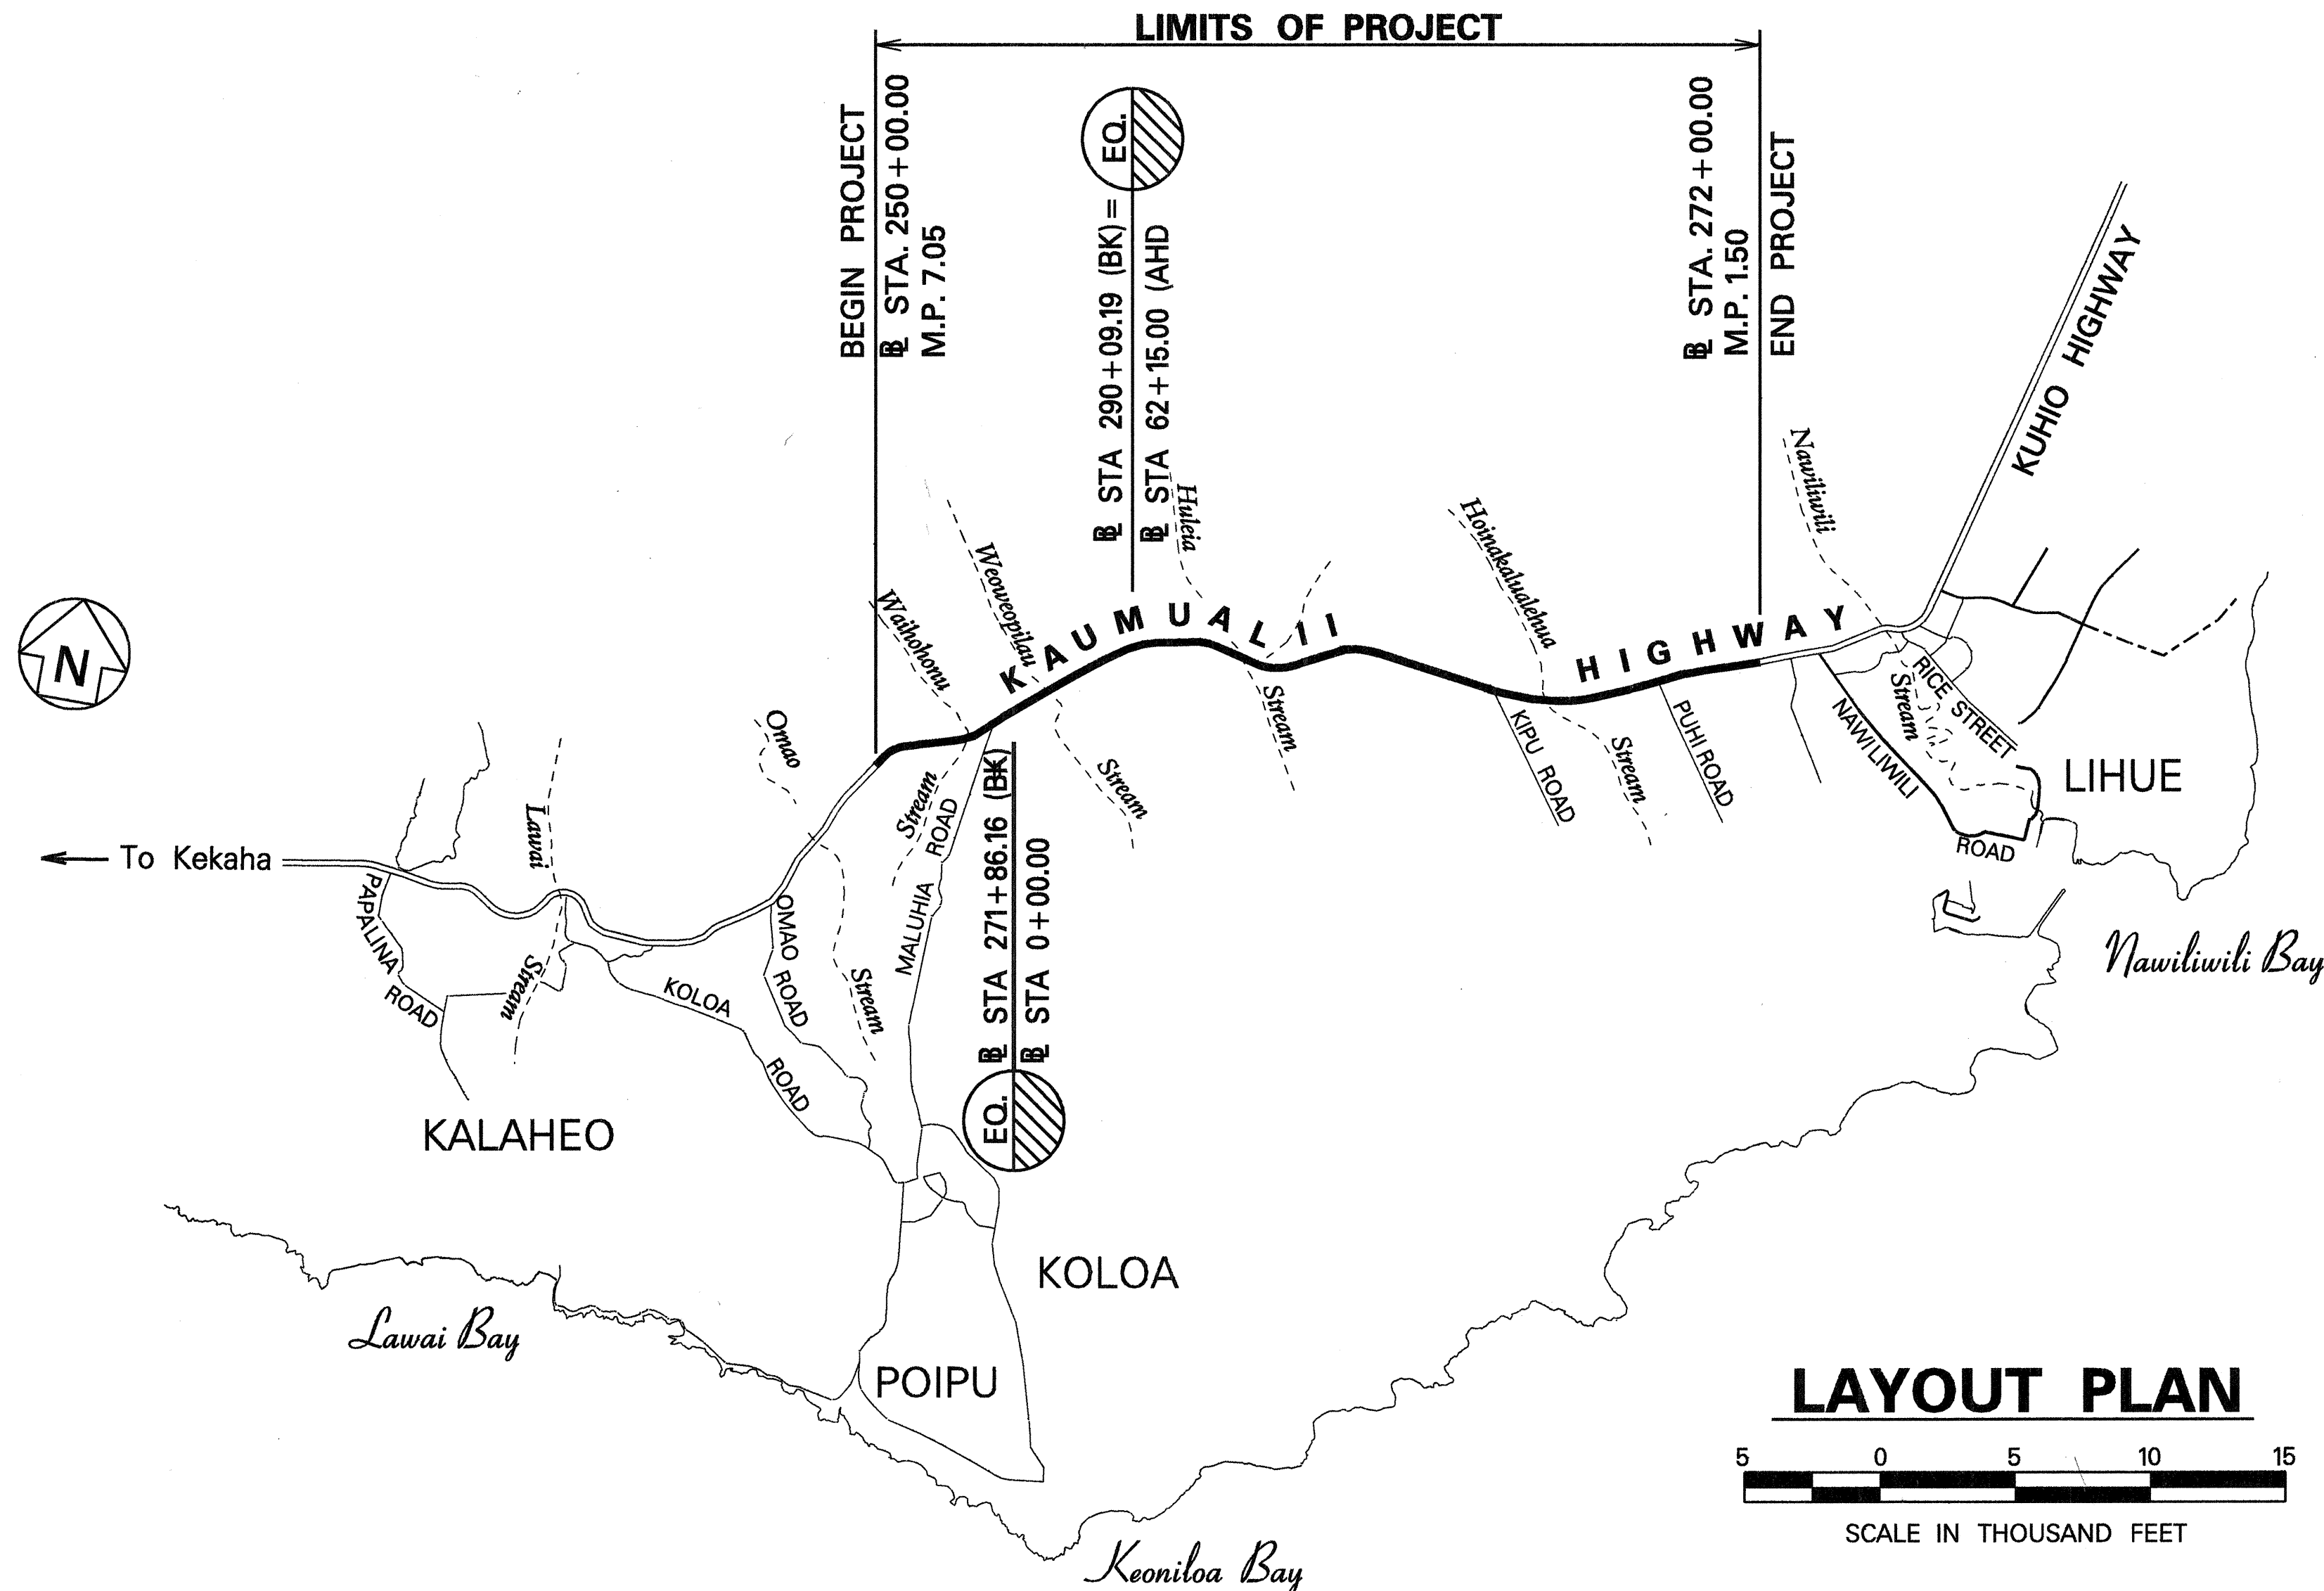


LAYOUT PLAN

5 0 5 10 15

SCALE IN THOUSAND FEET

FED. ROAD DIST. NO.	STATE	FEDERAL AID PROJ. NO.	FISCAL YEAR	SHEET NO.	TOTAL SHEETS
HAWAII	HAW.	STP-050-1(22)	2001	1	24

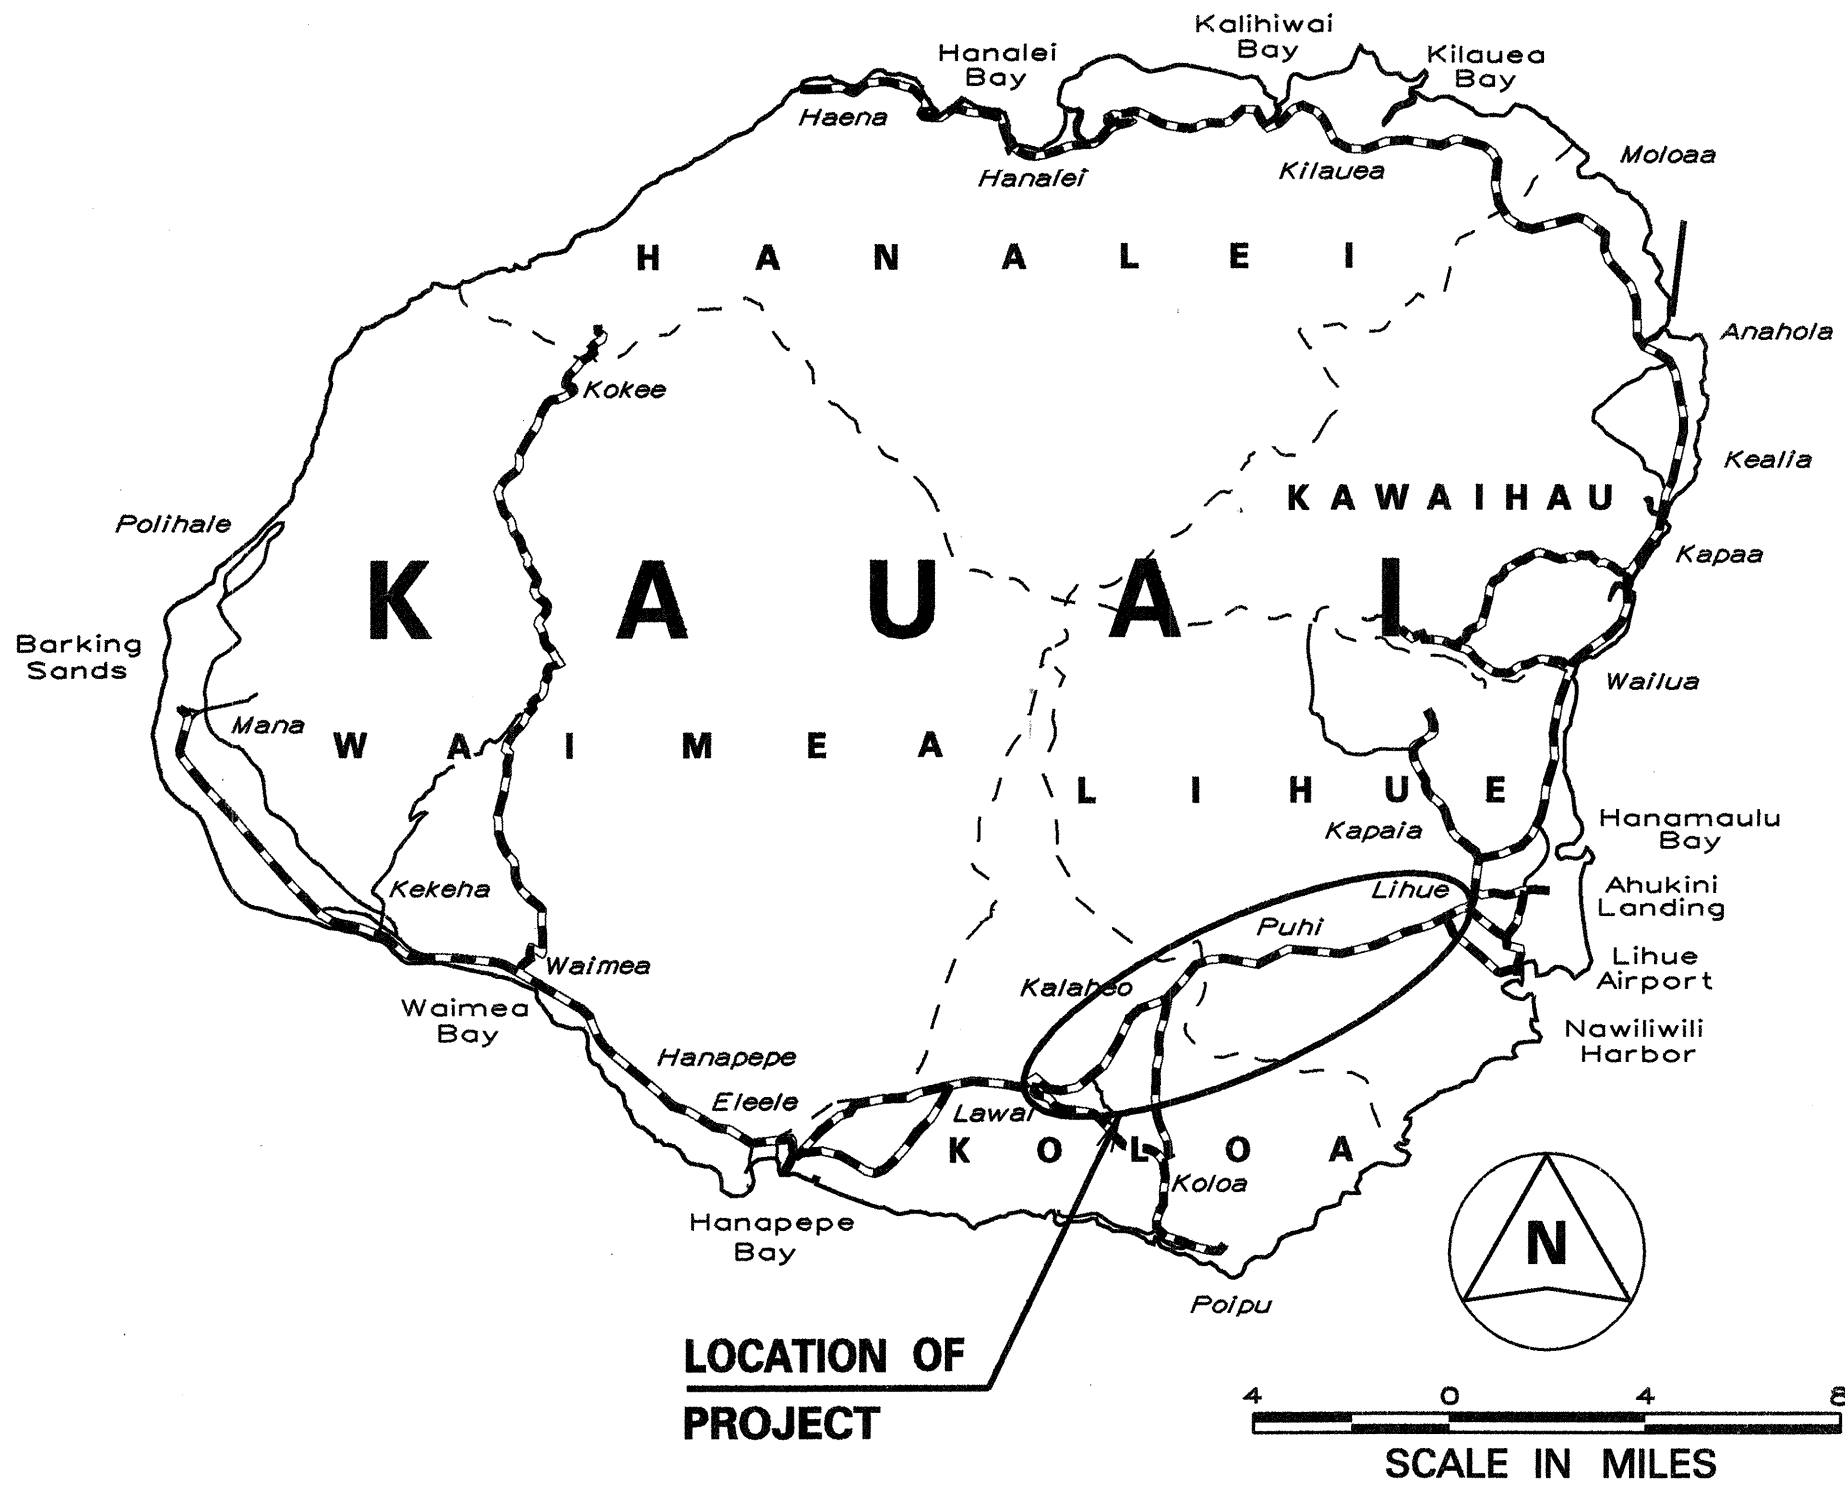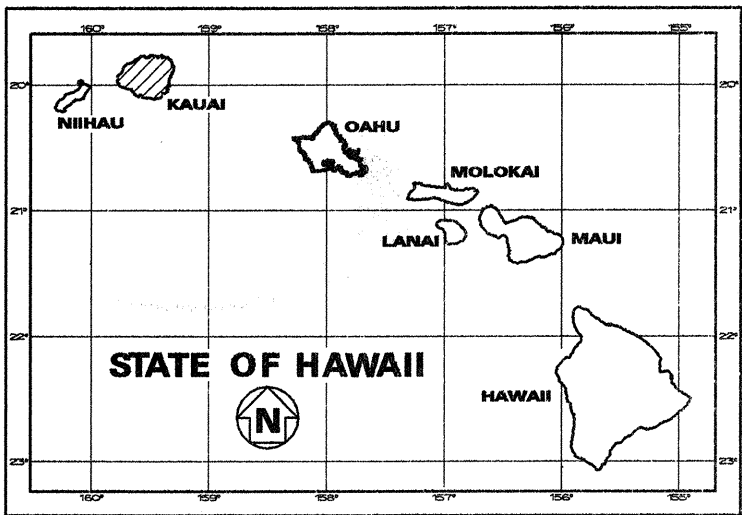

FEDERAL AID PROJECTS PREVIOUSLY CONSTRUCTED OR UNDER CONSTRUCTION

MILE POST 1.50 TO MILE POST 7.05

DESIGN	DESIGNATION	MILE POST 1.50 TO MALUHIA ROAD	MALUHIA ROAD TO MILE POST 7.05
ADT (2001)		22,300	13,280
ADT (2021)		25,270	16,900
DHV		2,150	1,440
D		60/40	75/25
T		2.5%	3.5%
V		50 MPH	50MPH

CHANGES MADE DURING CONSTRUCTION HAVE BEEN INCORPORATED ON THESE PLANS EXCEPT CHANGES IN THE ORIGINAL THEORETICAL QUANTITIES. FOR ACTUAL QUANTITIES, REFER TO PROJECT LEDGER AND/OR COMPUTATION BOOK.

5/11/2005

DATE

DEPARTMENT OF TRANSPORTATION
STATE OF HAWAII

APPROVED:

10-4-00

DIR. OF TRANSPORTATION

DATE

HWY-KE
DESIGNED BY

Steve Morikawa
P. S. & E. BY

274-3111
PHONE

August 2000
DATE