




FED. ROAD DIST. NO.	STATE	PROJ. NO.	FISCAL YEAR	SHEET NO.	TOTAL SHEETS
HAWAII	HAW.	50B-01-00M	2002	15	40

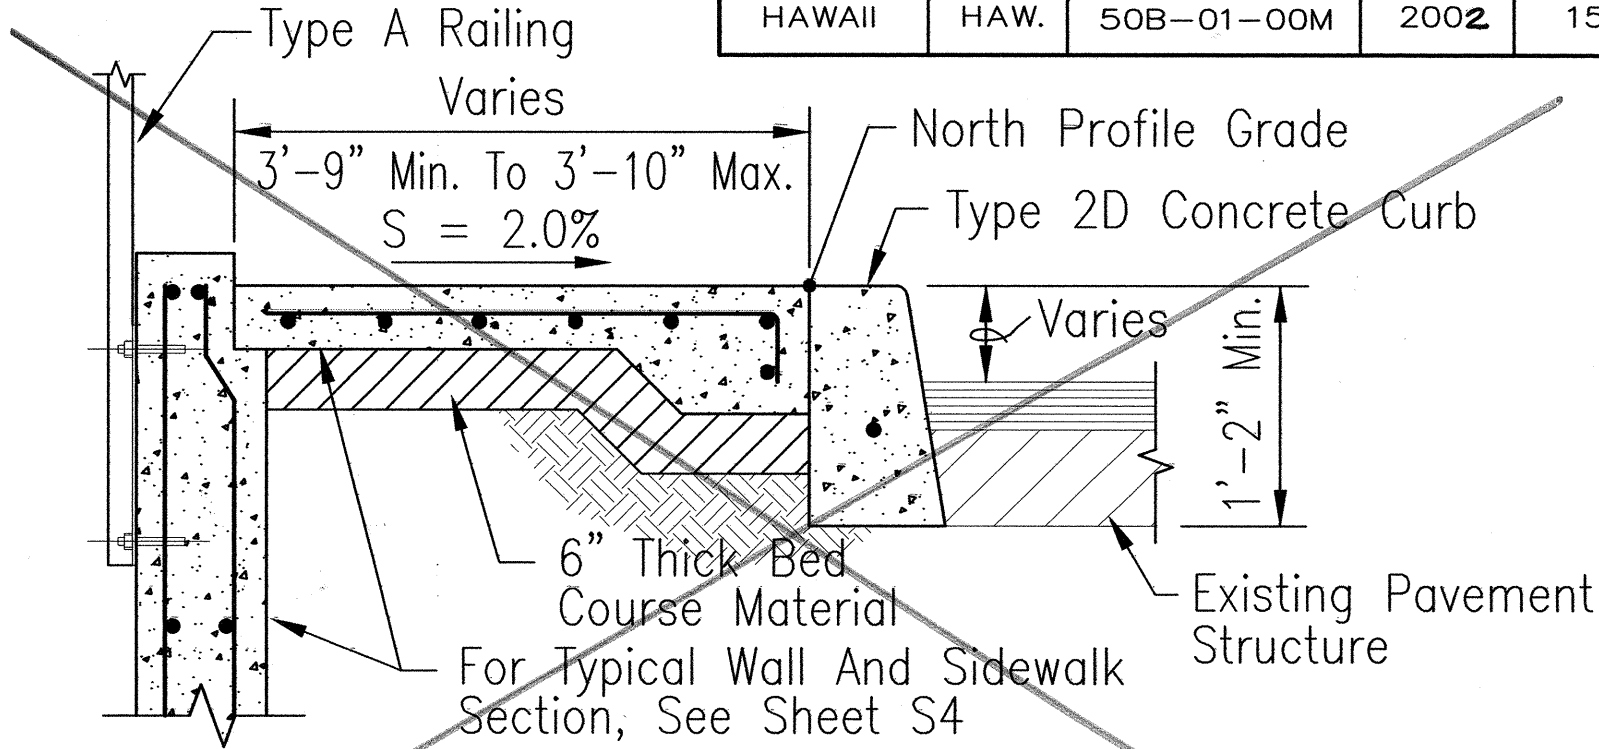

TYPICAL SECTION A
SCALE: 1" = 1'-0"

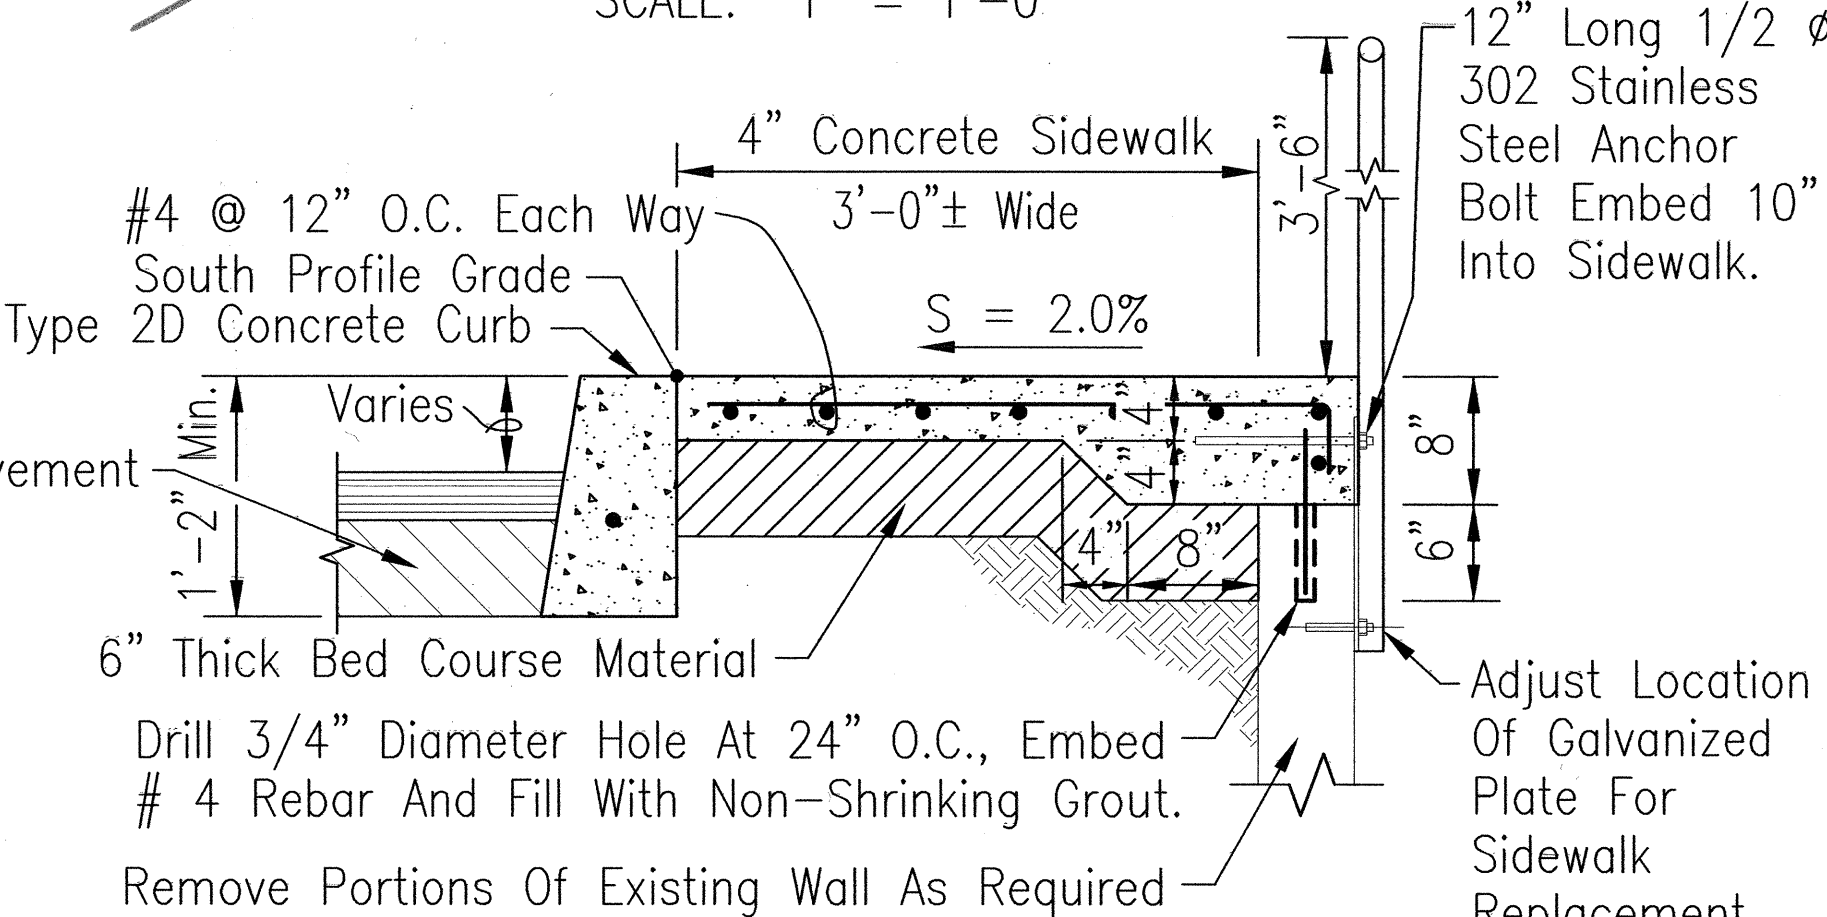


TYPICAL SECTION B
SCALE: 1" = 1'-0"

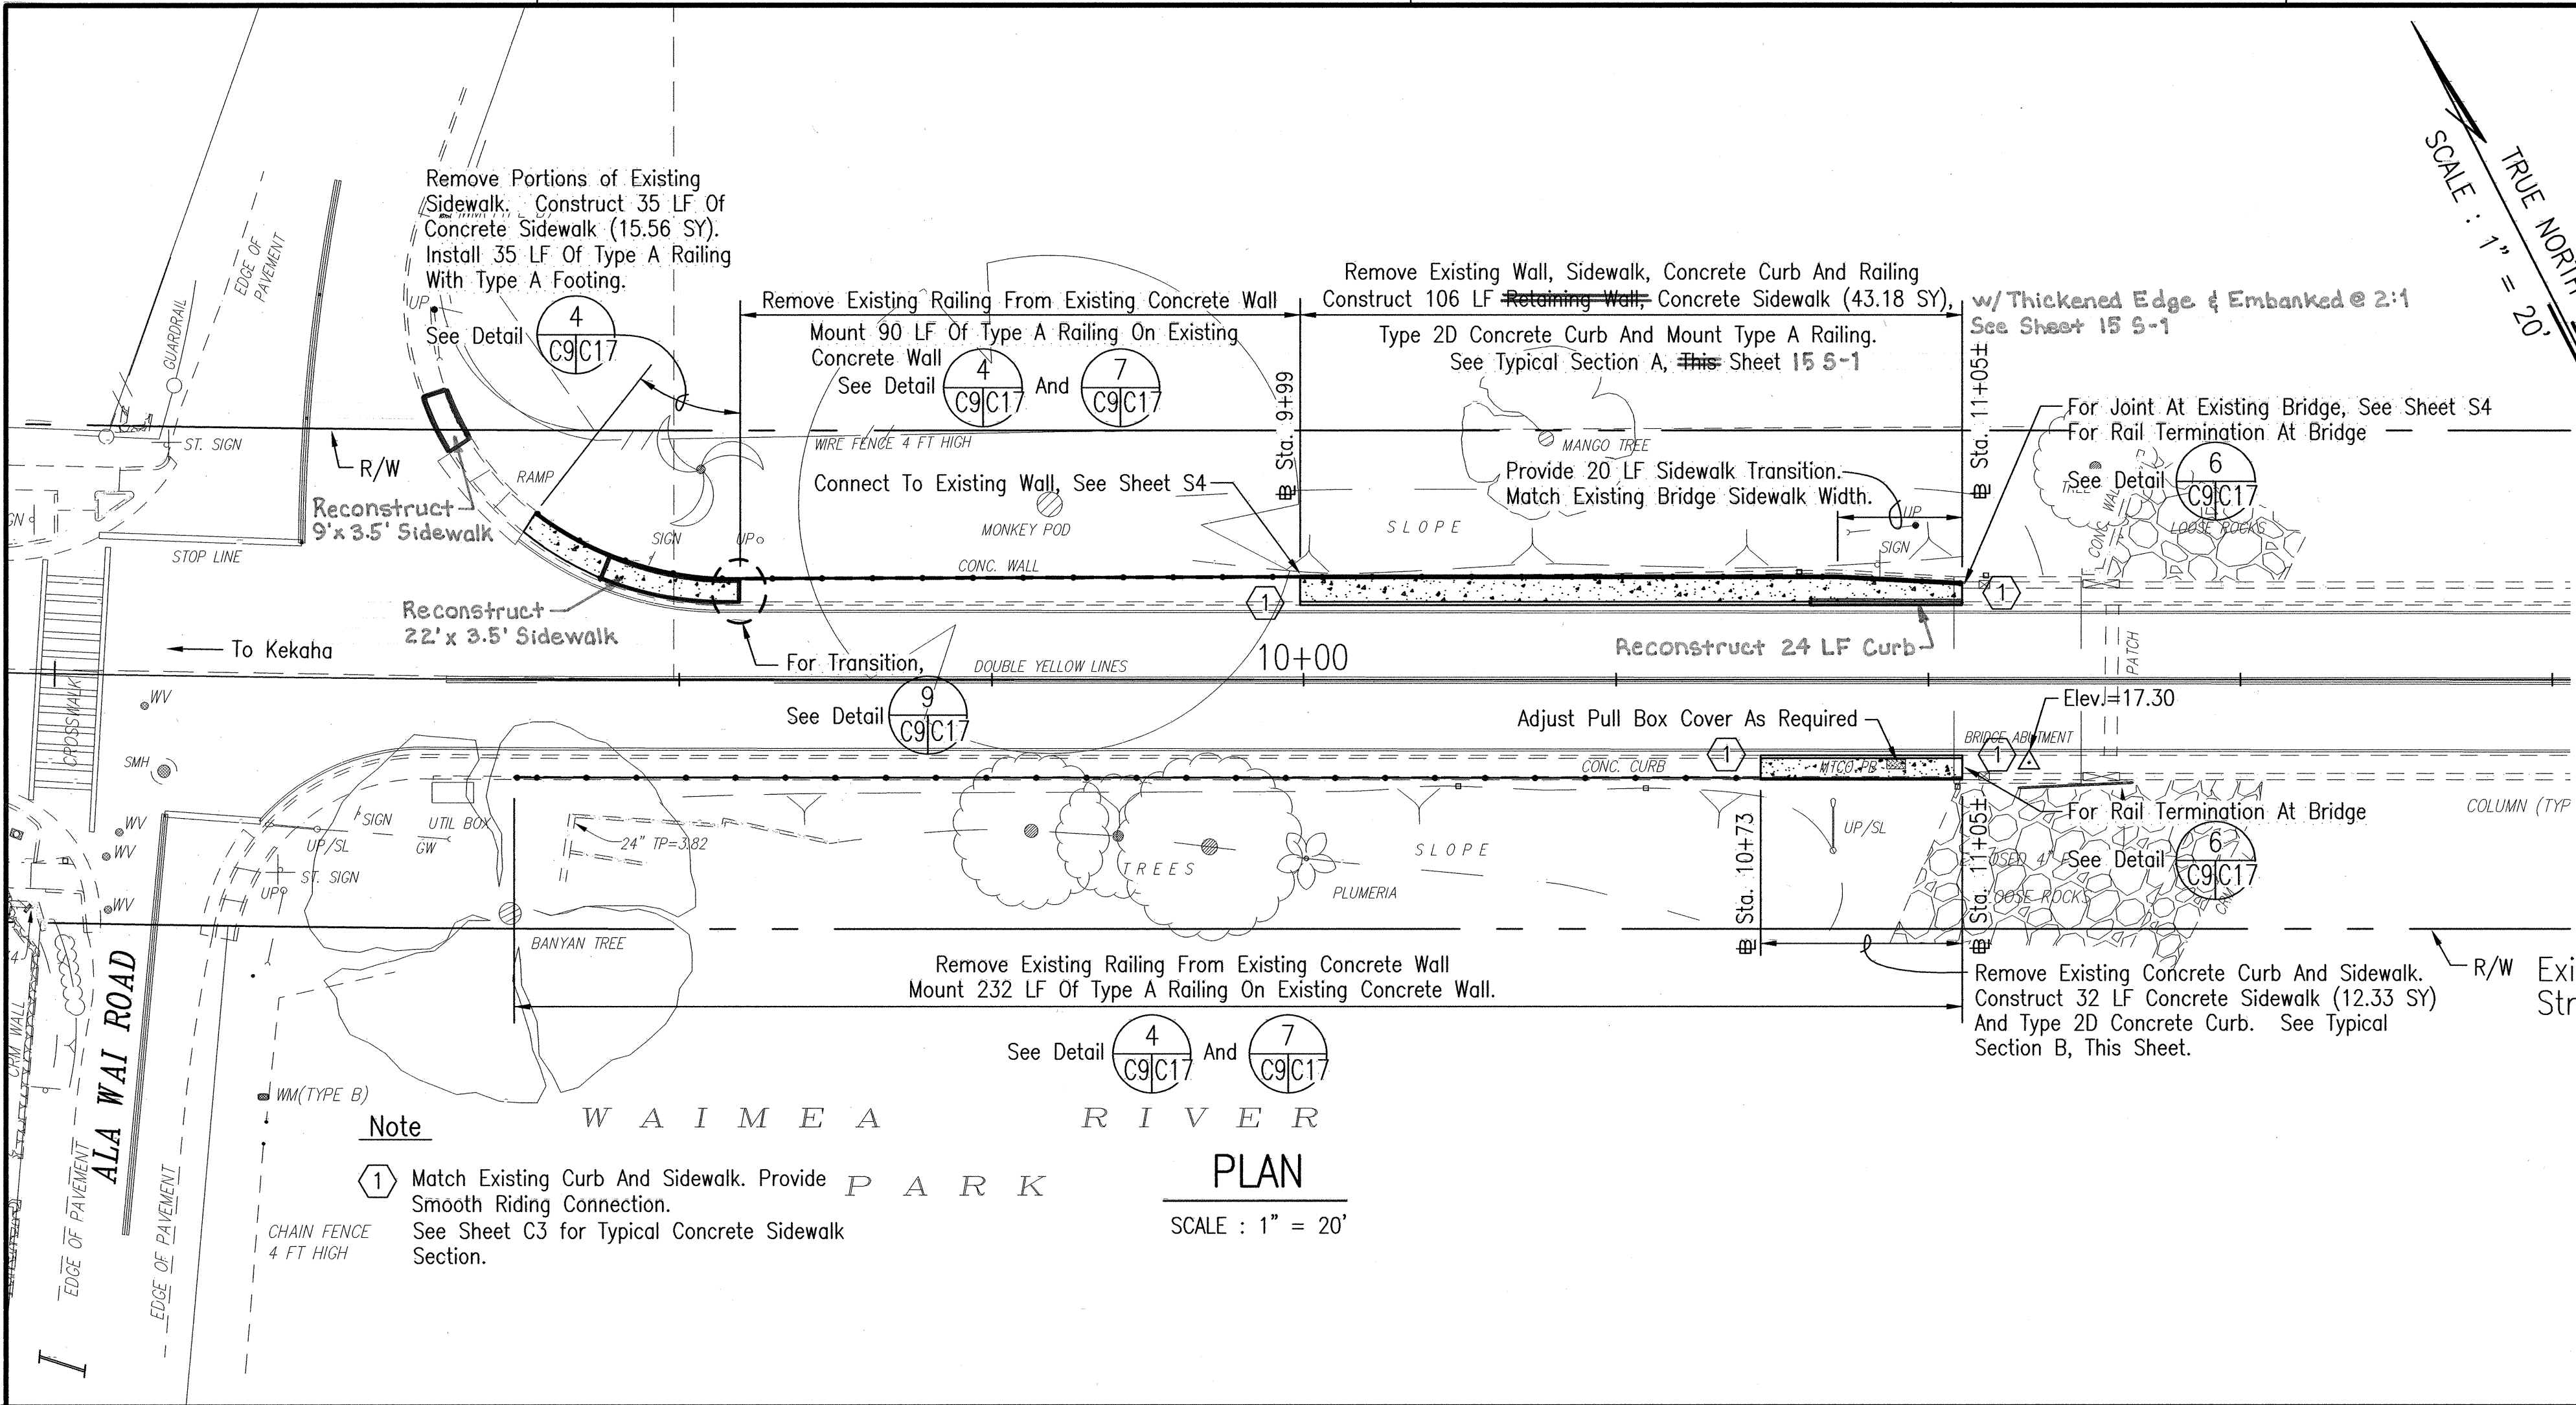

Note
1 Match Existing Curb And Sidewalk. Provide Smooth Riding Connection. See Sheet C3 for Typical Concrete Sidewalk Section.

PLAN
SCALE : 1" = 20'

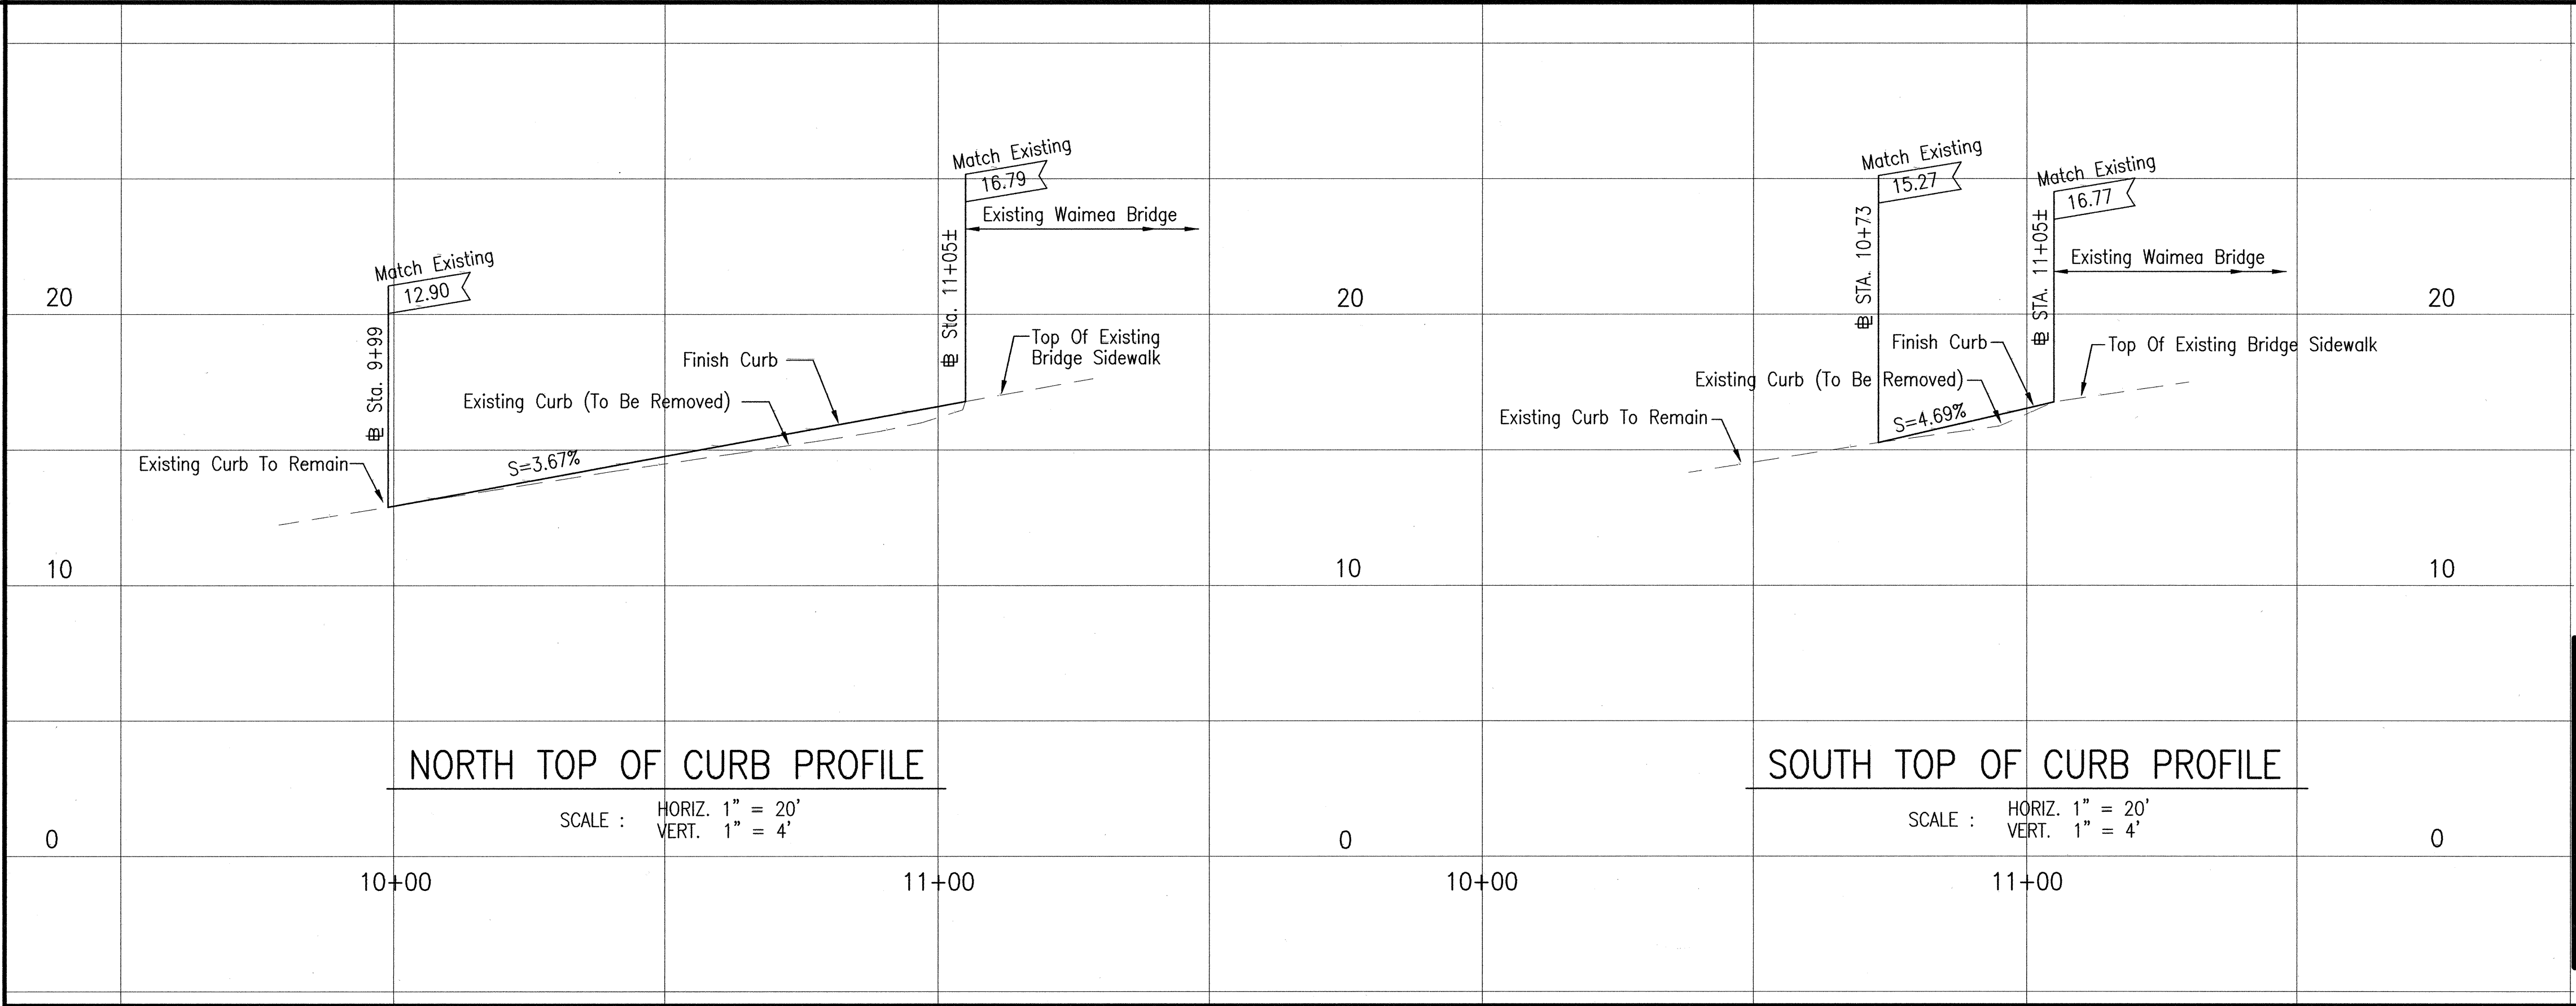

NORTH TOP OF CURB PROFILE
SCALE : HORIZ. 1" = 20'
VERT. 1" = 4'

SOUTH TOP OF CURB PROFILE
SCALE : HORIZ. 1" = 20'
VERT. 1" = 4'

THIS WORK WAS PREPARED BY ME OR UNDER MY SUPERVISION
BY: *June J. Nakamura*
DATE: 12/14/00

STATE OF HAWAII
DEPARTMENT OF TRANSPORTATION
HIGHWAYS DIVISION

SIDEWALK PLAN/PROFILE AND DETAILS

KAUMUALII HIGHWAY RESURFACING
Mahaikona Bridge To Waimea Canyon Drive
Project No. 50B-01-00M

Scale: As Noted Date: 12/13/00
SHEET NO. C9 OF C23 SHEETS





PM : GKC
OPER : LSA/GKC/PT*
REVISED : 12/14/00

DATE : 06/27/00
PLOT SCALE : 1" = 1'
FILE: 9930-C9.DWG
JOB NO. : 9930




SURVEY PLOTTED BY	DATE
ORIGINAL PLAN	
DRAWN BY	
DESIGNED BY	
CHECKED BY	
NOTED BY	
NO.	

"AS-BUILT"

FED. ROAD DIST. NO.	STATE	PROJ. NO.	FISCAL YEAR	SHEET NO.	TOTAL SHEETS
HAWAII	HAW.	50B-01-00M	2002	15 S-1	

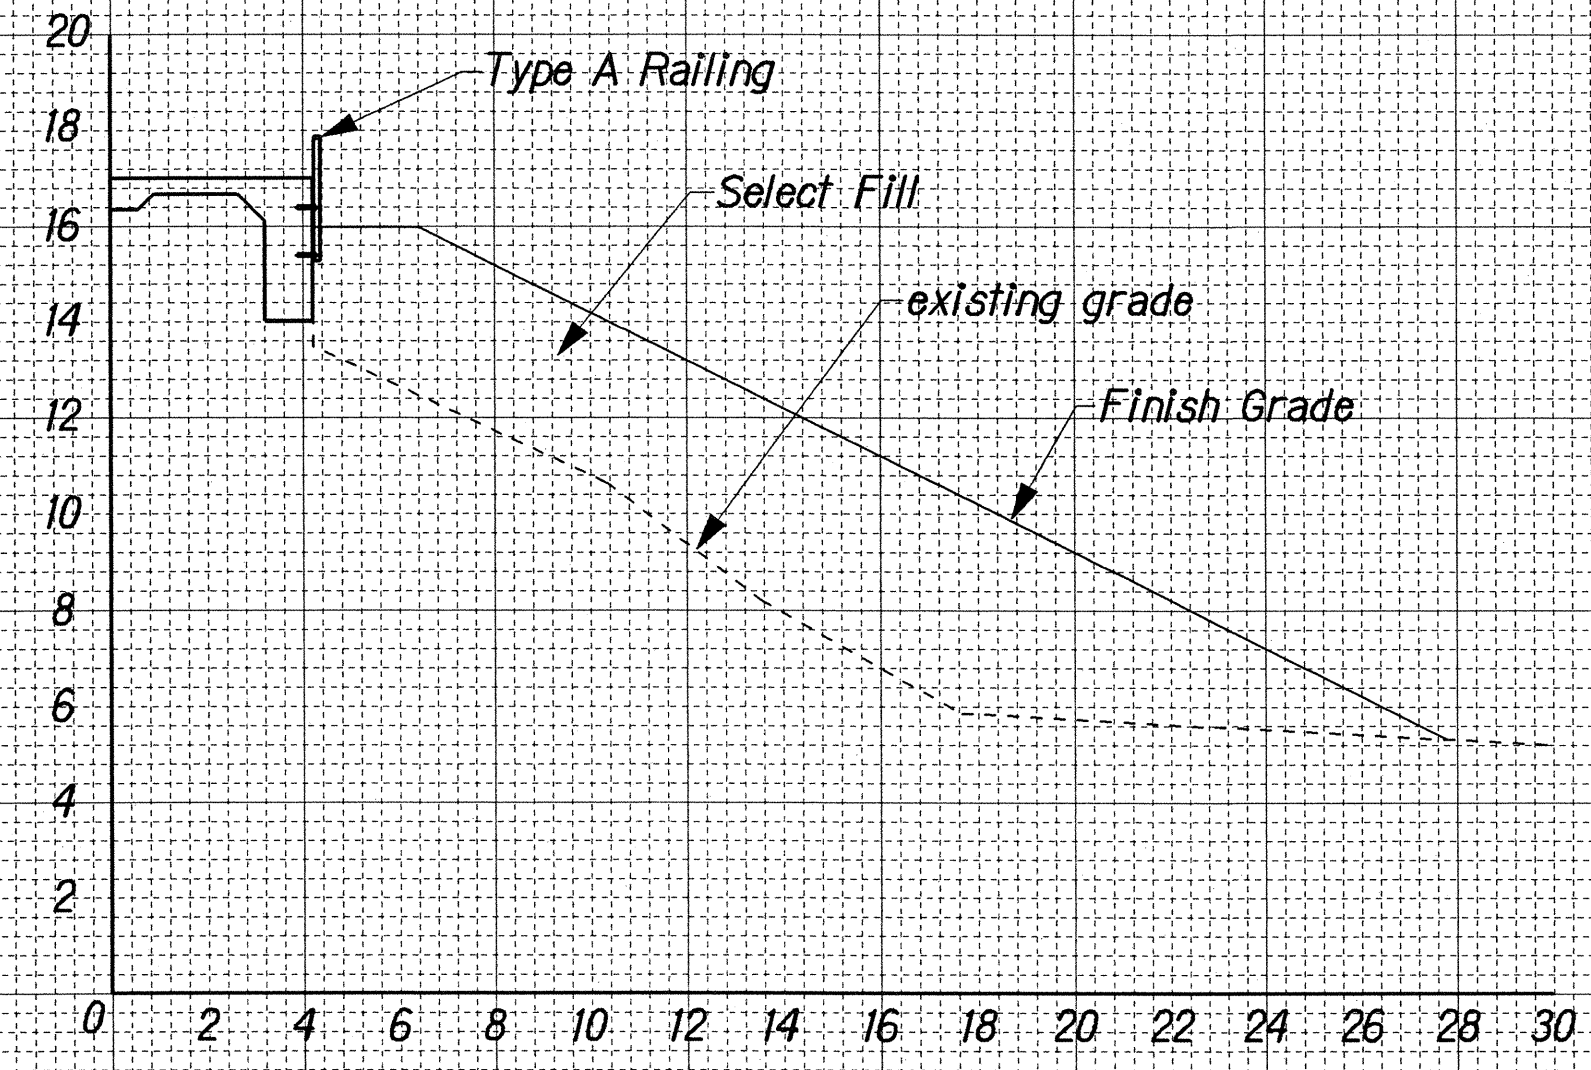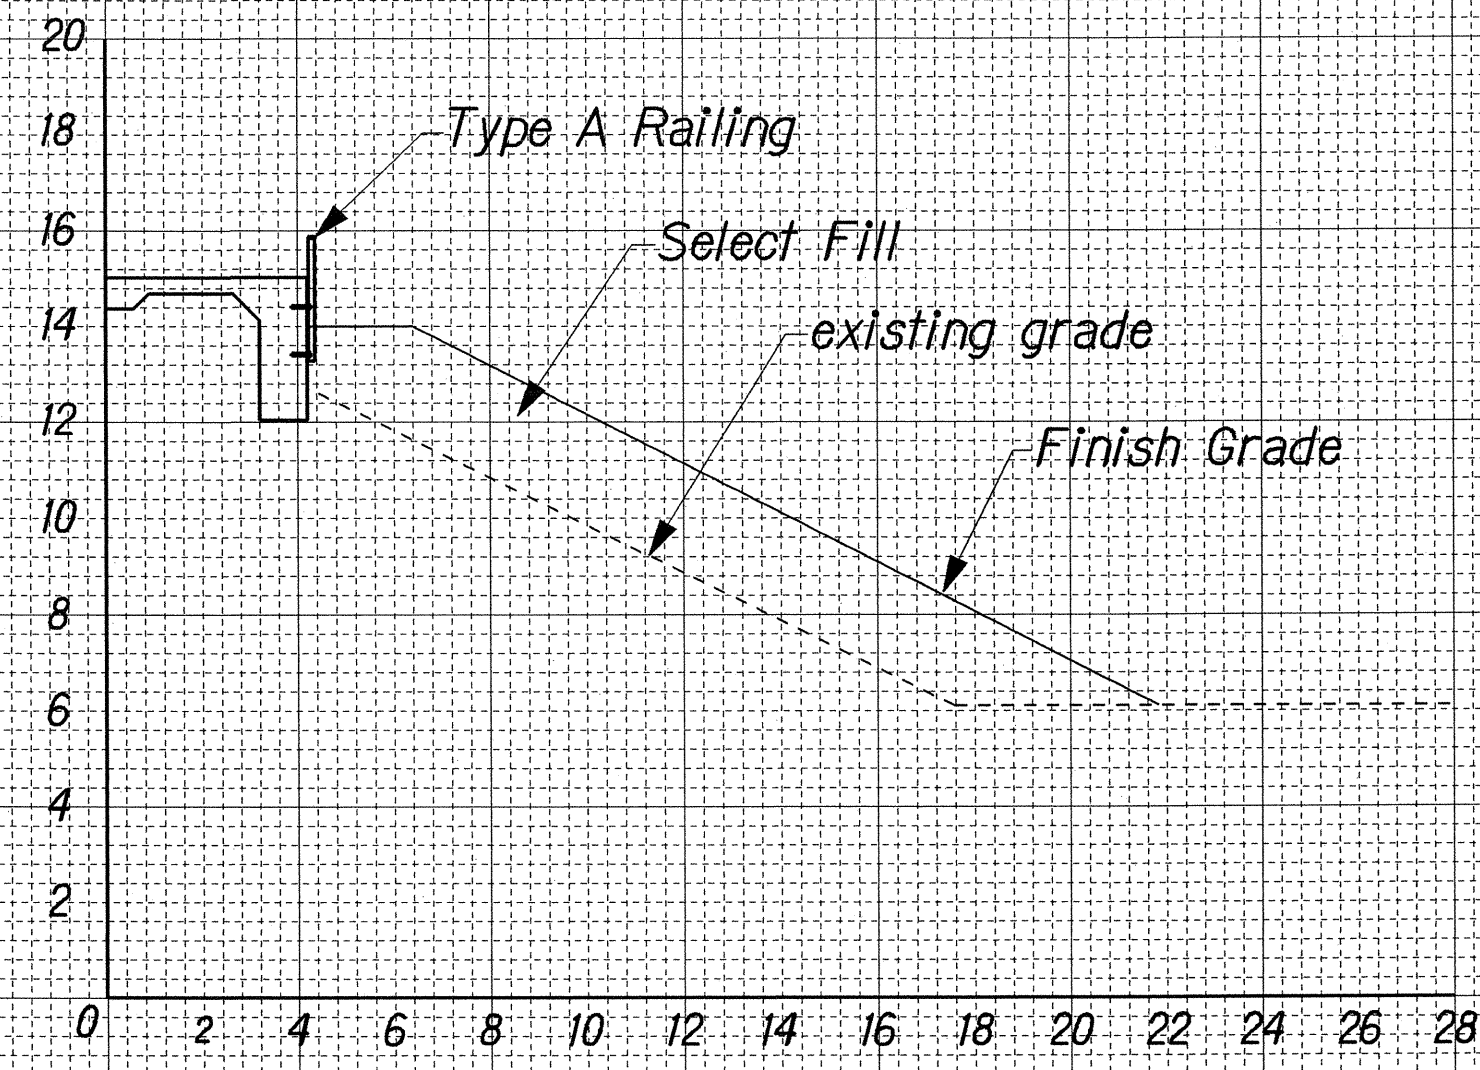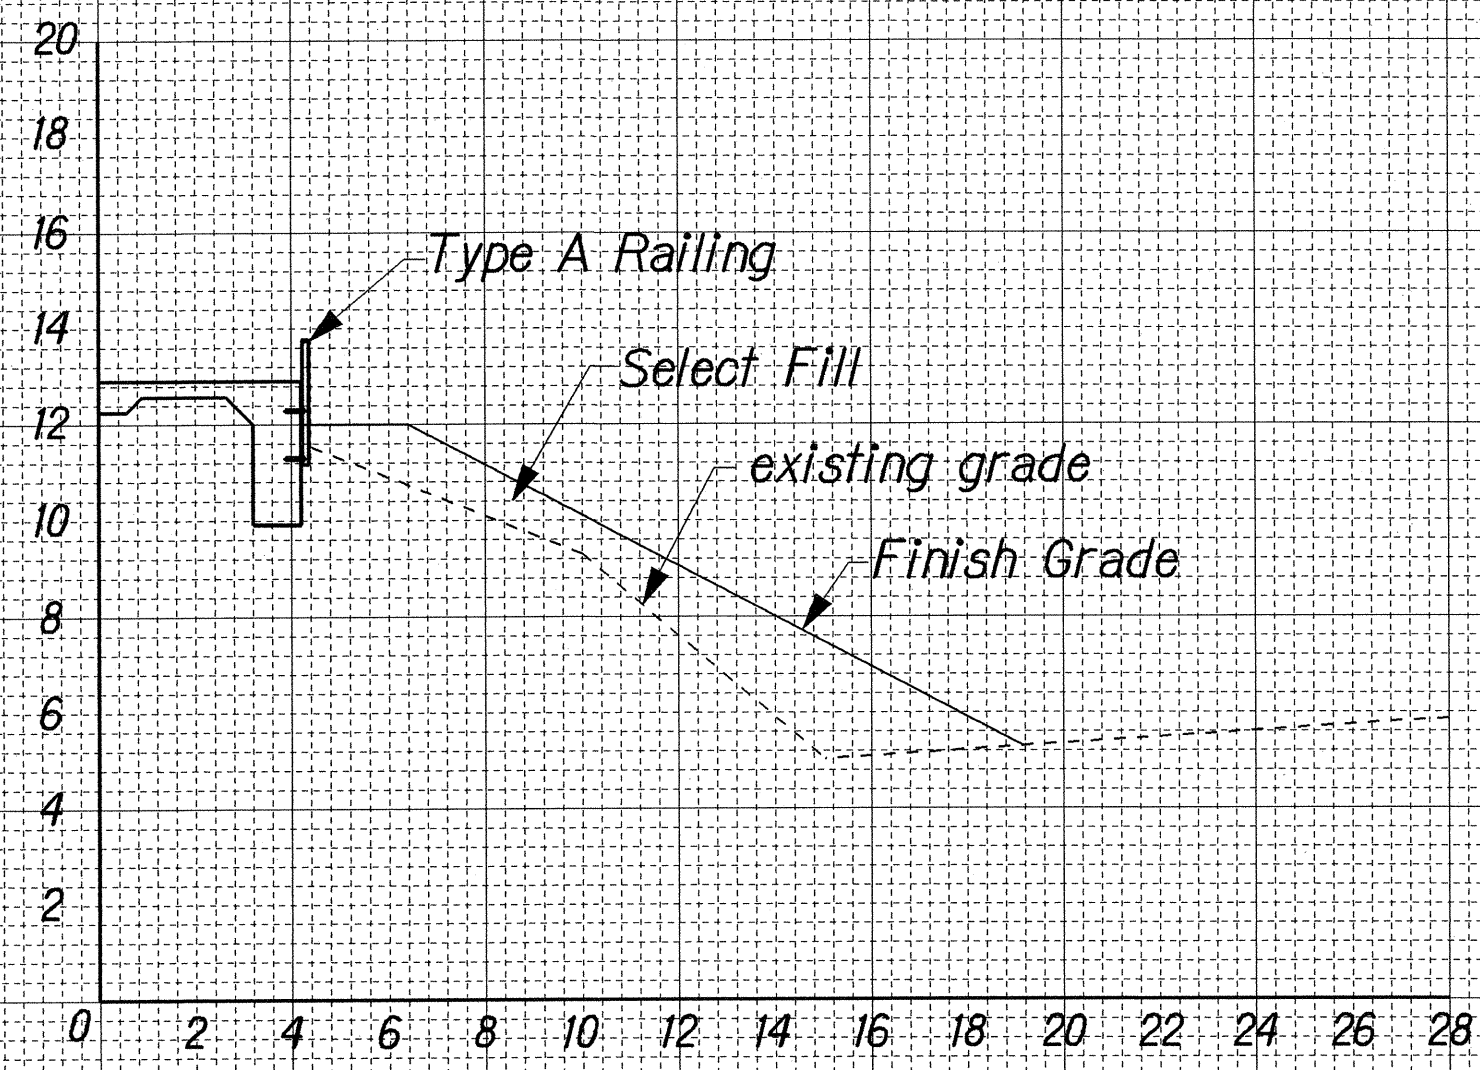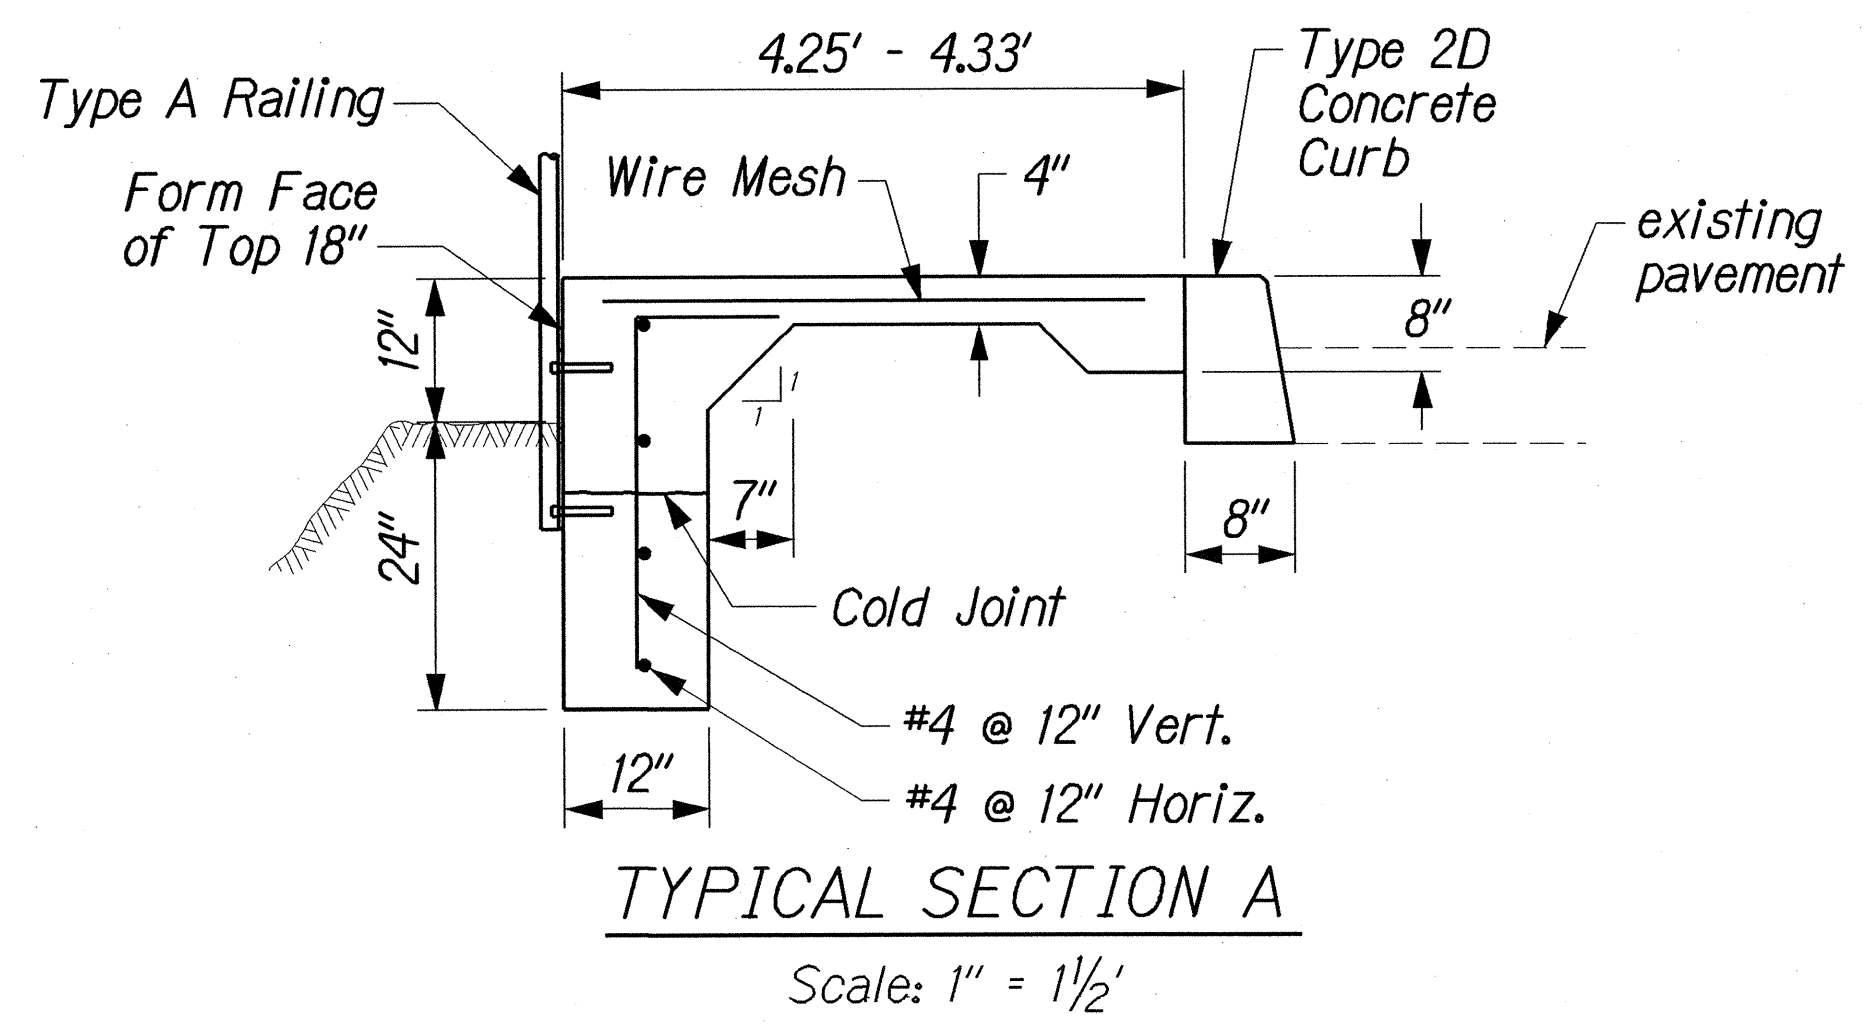

SCALE:
Horiz.: 1" = 4'
Vert.: 1" = 4'

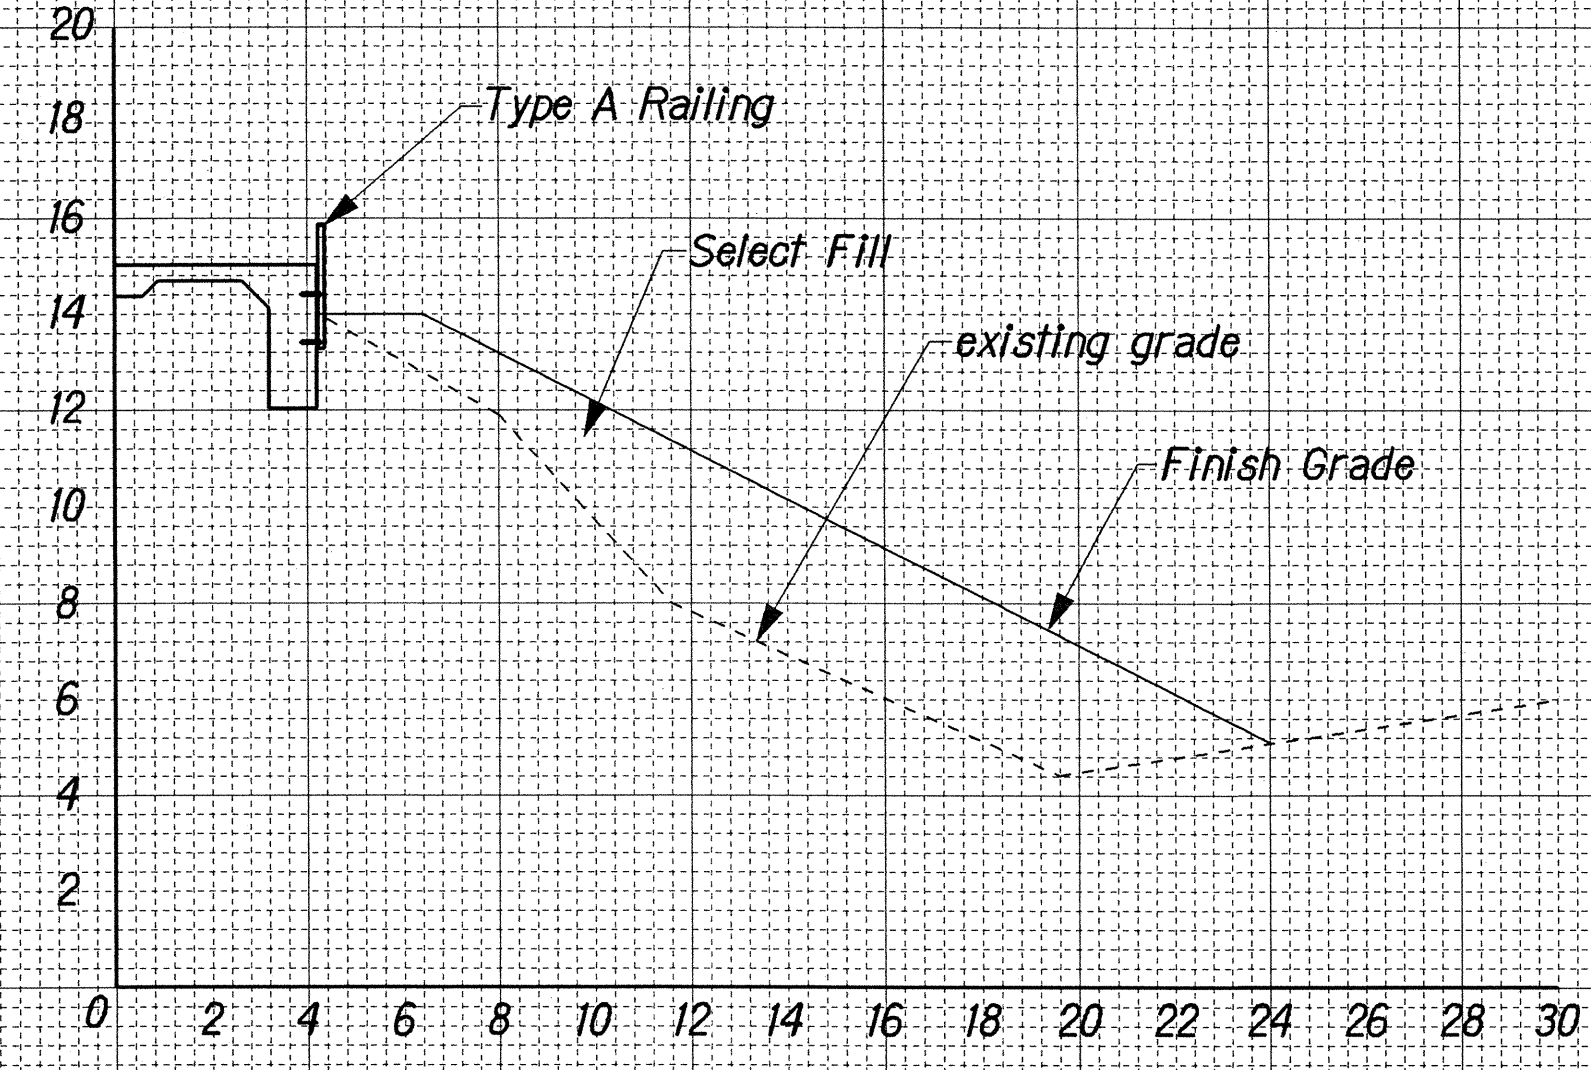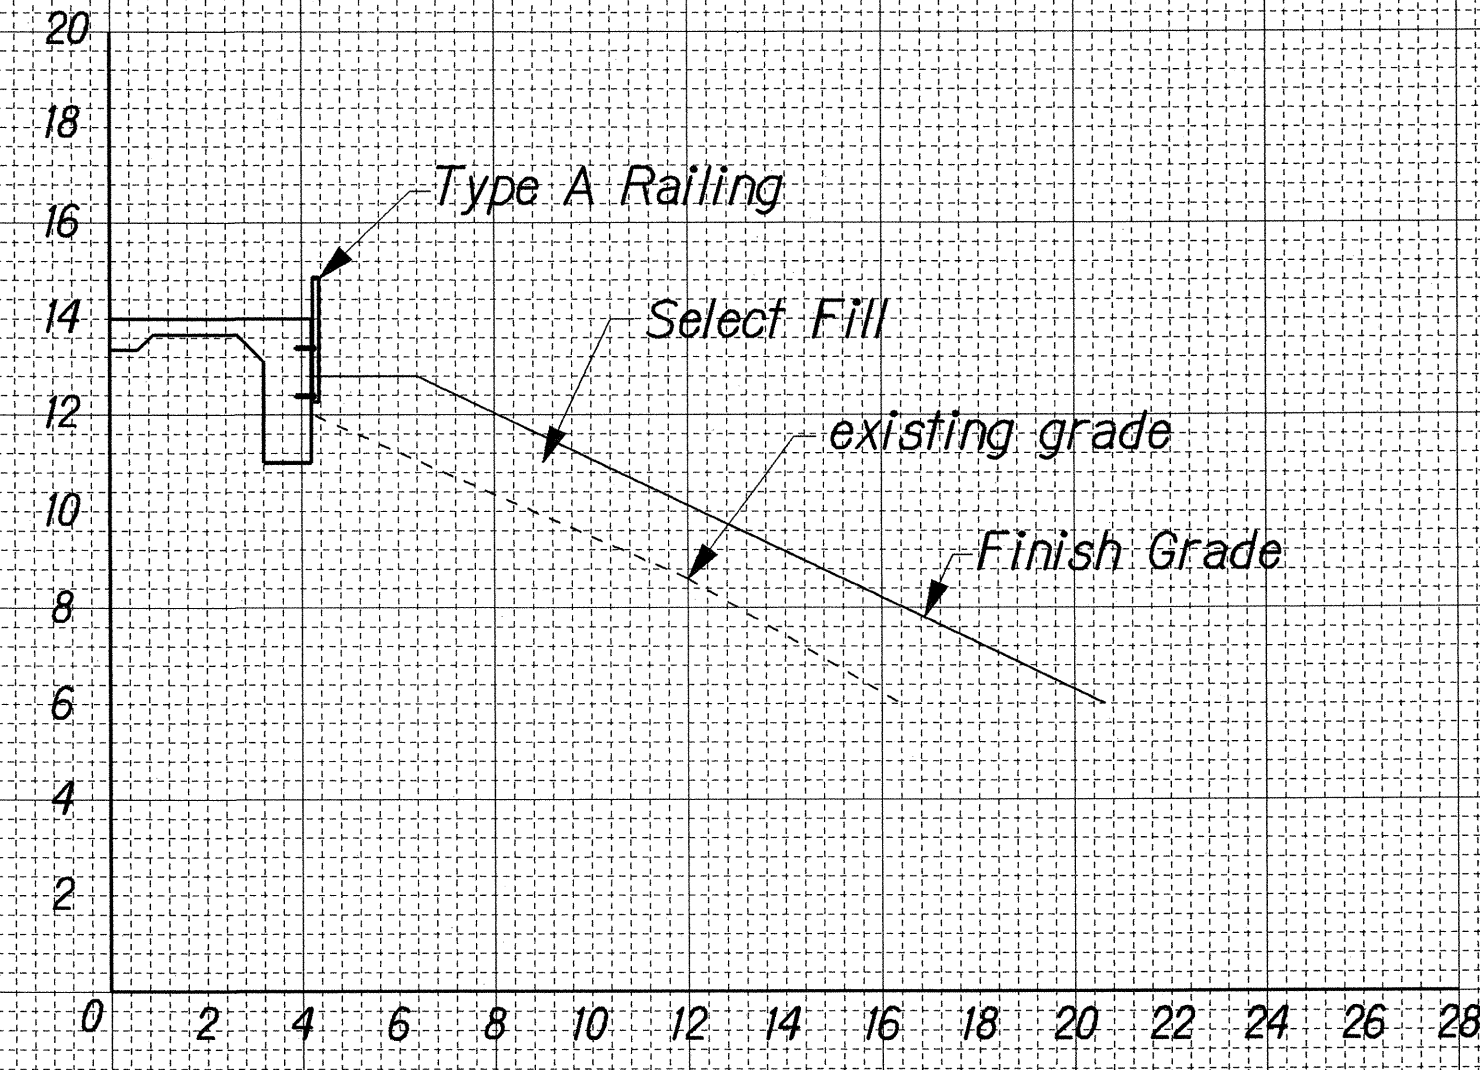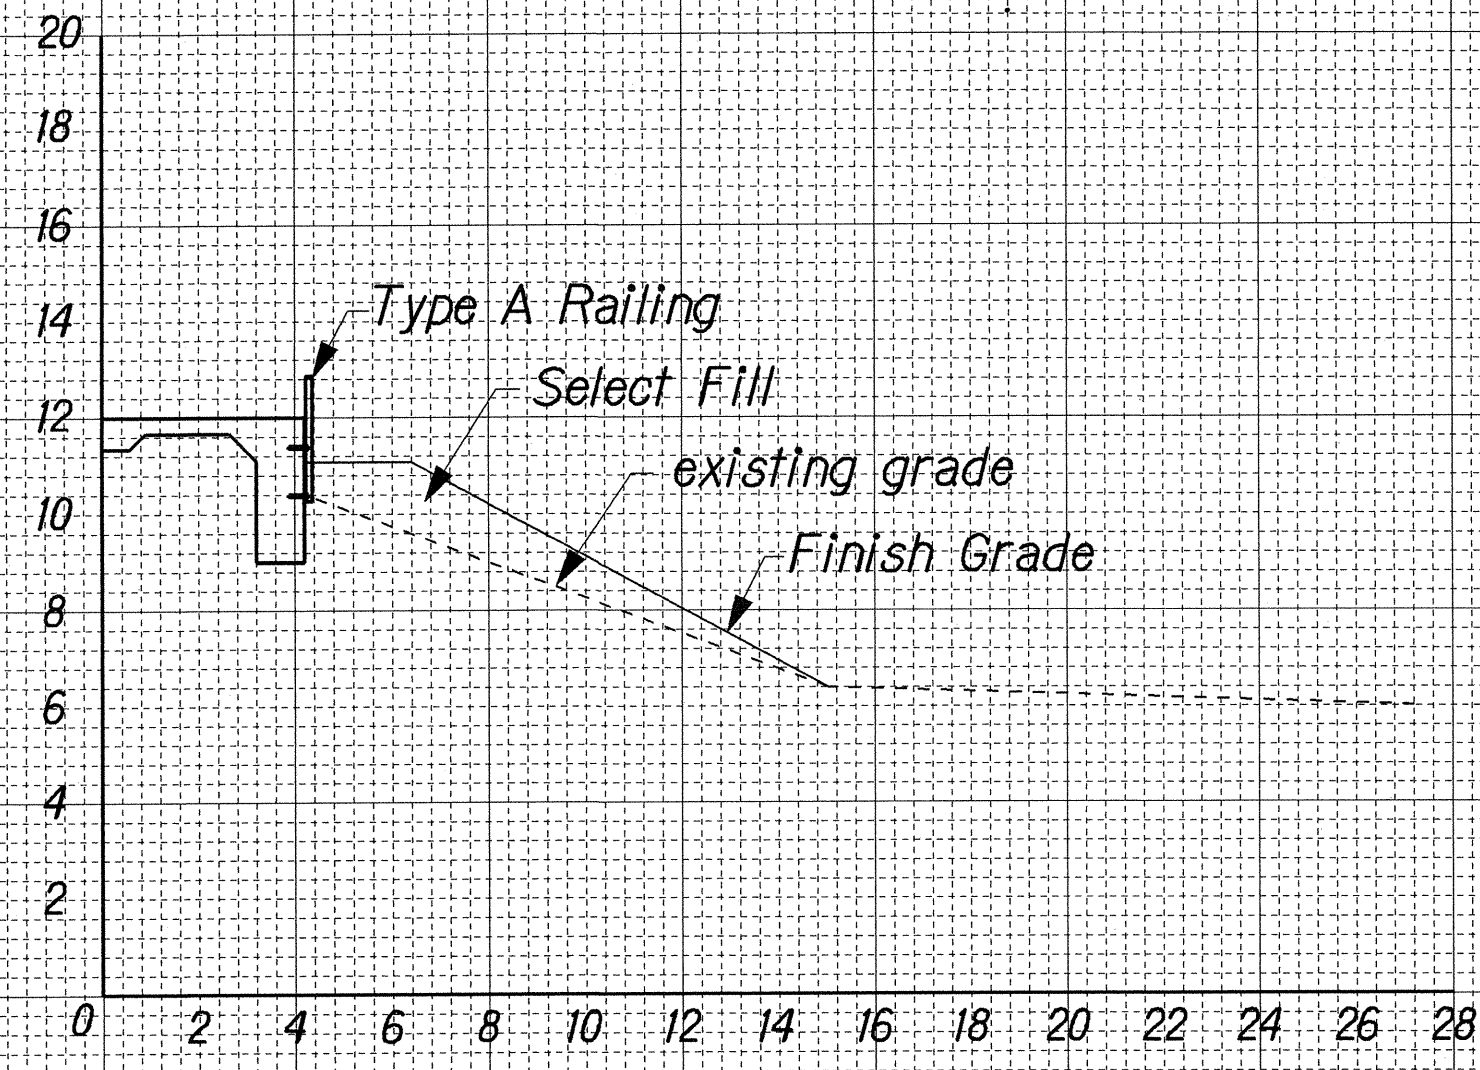

This Sheet Prepared
During As-Built
Posting

ORIGINAL PLAN	SURVEY PLOTTED BY	DATE
DRAWN BY		
DESIGNED BY		
CHECKED BY		
50B-01-00M		
Cross-section		