


INDEX TO DRAWINGS	
SHEET NO.	DESCRIPTION
1	TITLE SHEET
2	STANDARD PLANS SUMMARY
3-6	MISCELLANEOUS NOTES, LEGEND AND ABBREVIATIONS
7-14	ROADWAY PLANS, SECTIONS AND DETAILS
15 ^①	SIDEWALK PLAN/PROFILE AND DETAILS
16-21	CURB RAMP SCHEDULE, NOTES AND DETAILS
22	DRAINAGE DETAILS
23	RAILING DETAILS
24-29	GUARDRAIL DETAILS AND NOTES
30-33	BRIDGE STRUCTURAL DETAILS
34-40	SIGNING & PAVEMENT MARKING PLANS, NOTES AND LEGEND

SHEET NO. ① 15 S-1 IS A SUPPLEMENTAL SHEET TO THIS PROJECT. TOTAL SHEET COUNT AFTER "AS-BUILT" POSTING IS 41 SHEETS.




STATE OF HAWAII
DEPARTMENT OF TRANSPORTATION
HIGHWAYS DIVISION
HONOLULU, HAWAII
"AS-BUILT" PLANS FOR
KAUMUALII HIGHWAY RESURFACING
MAHAIKONA BRIDGE TO WAIMEA CANYON DRIVE
PROJECT NO. 50B-01-00M

DISTRICT OF WAIMEA
ISLAND OF KAUAI

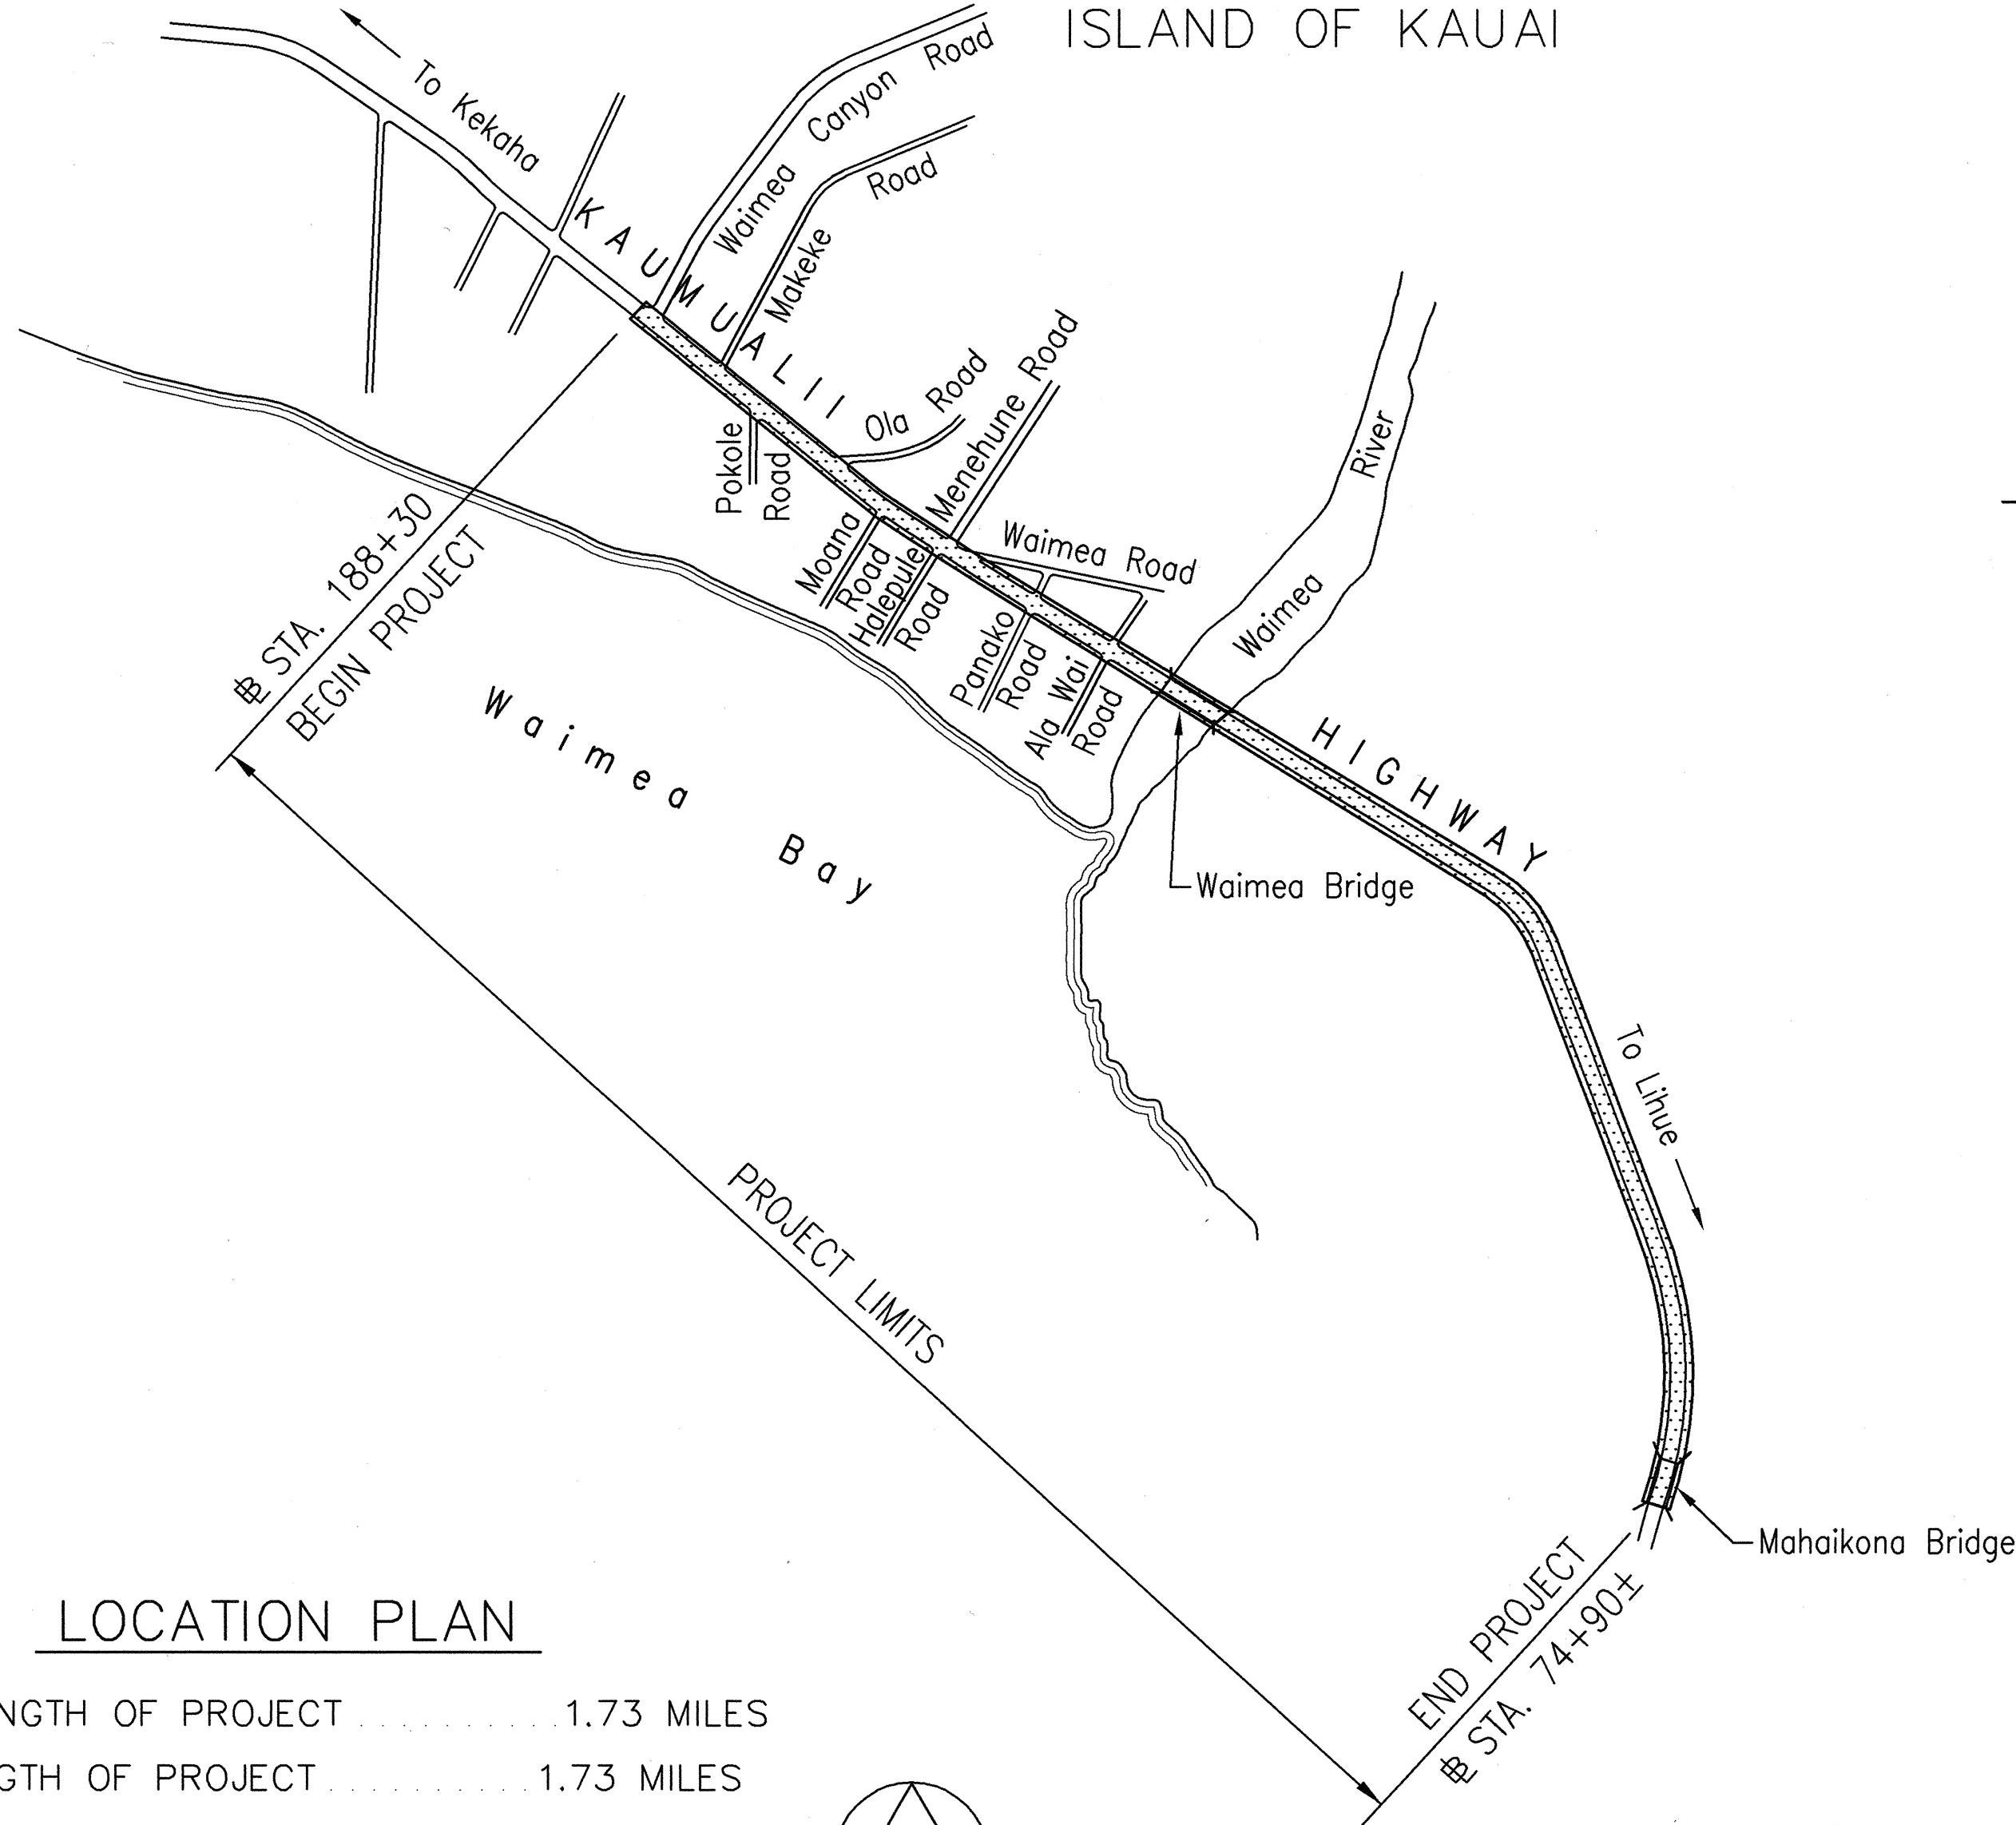


LOCATION PLAN

GROSS LENGTH OF PROJECT 1.73 MILES
NET LENGTH OF PROJECT 1.73 MILES

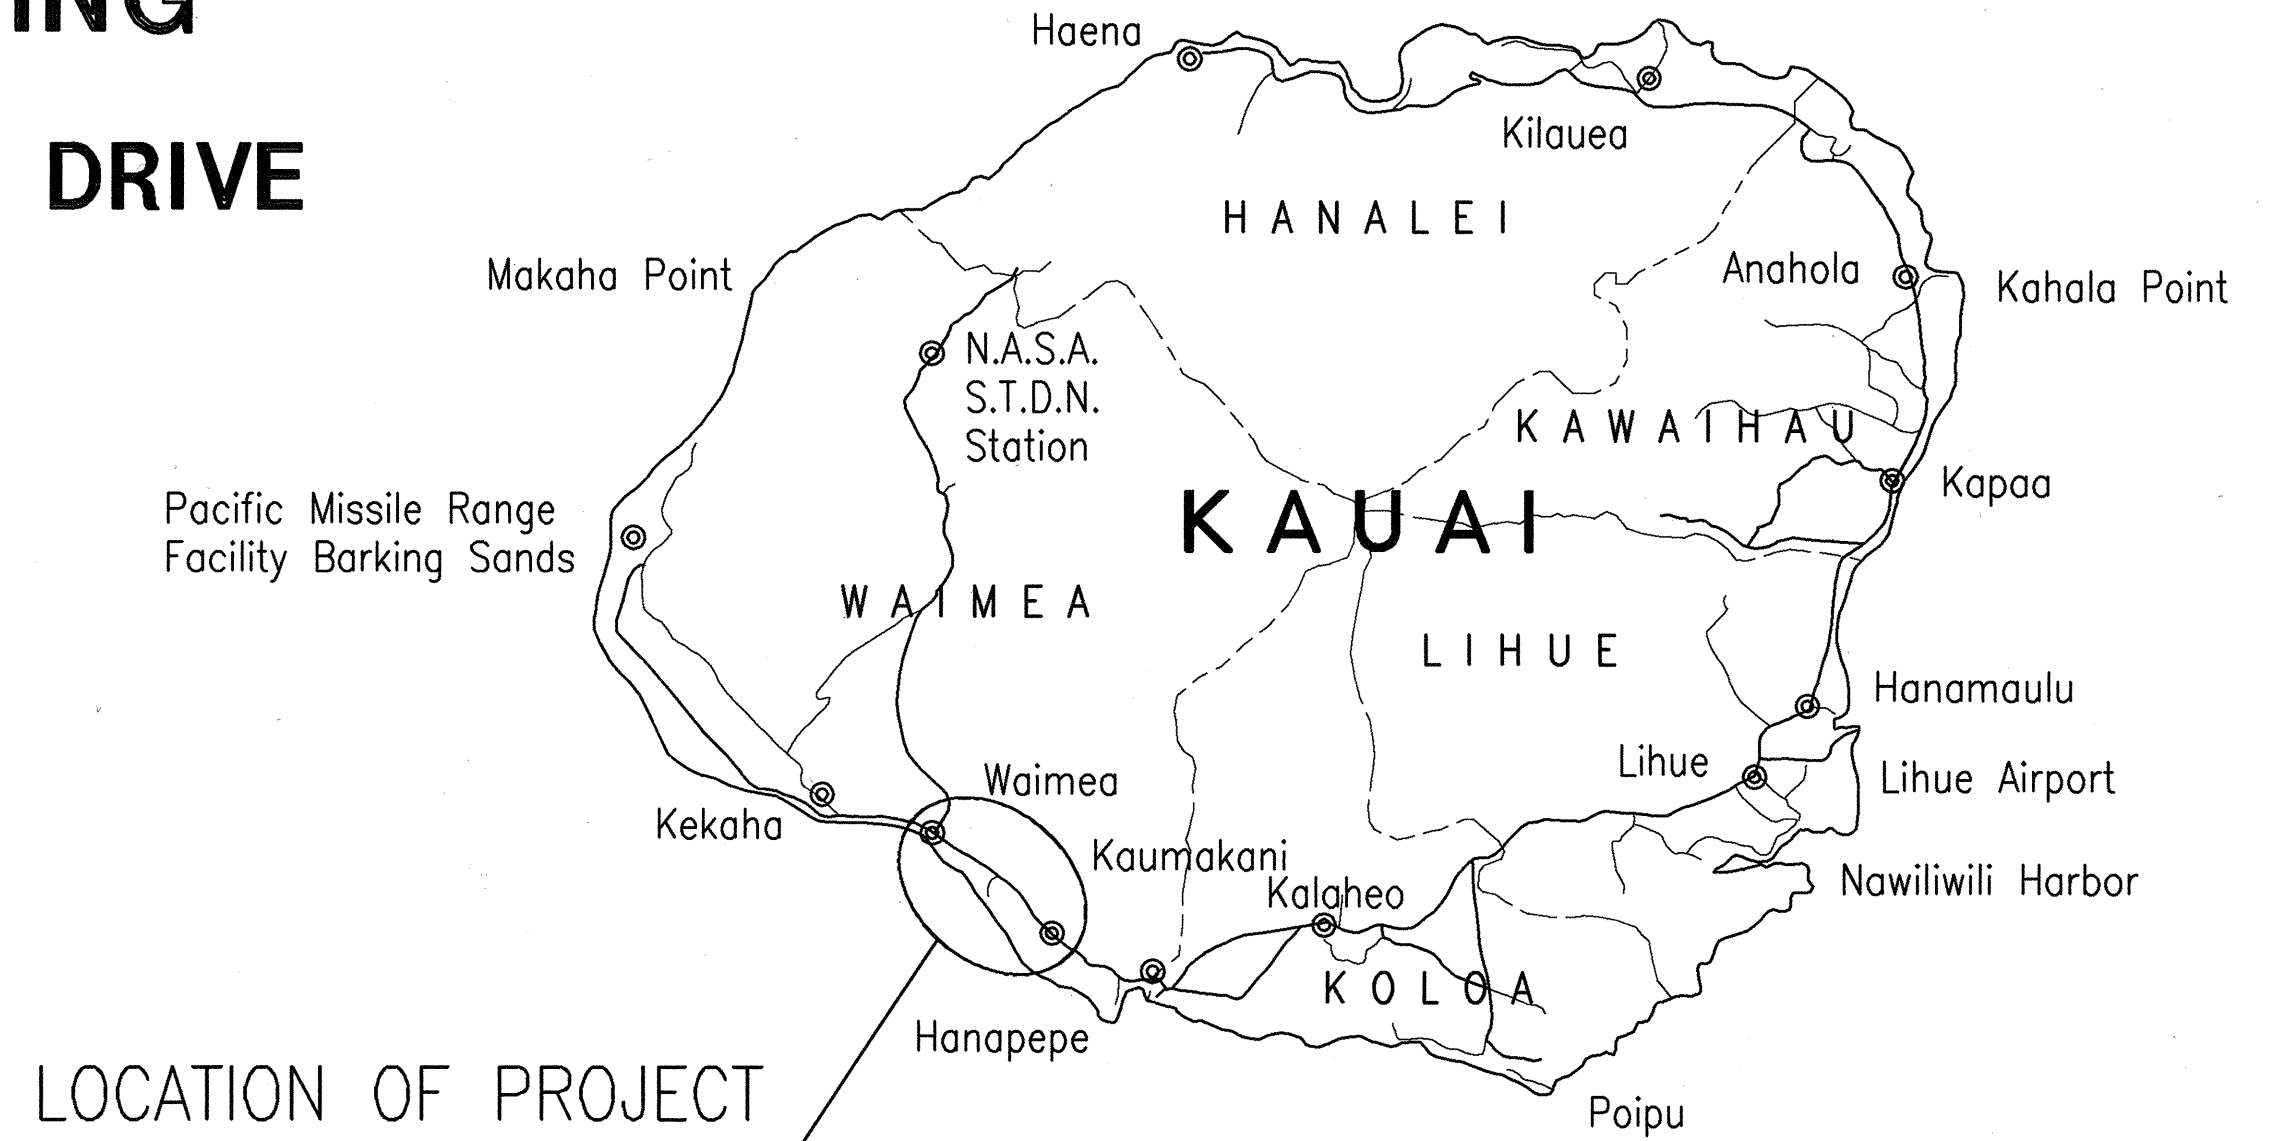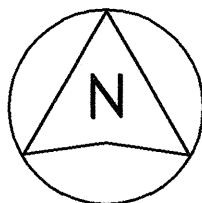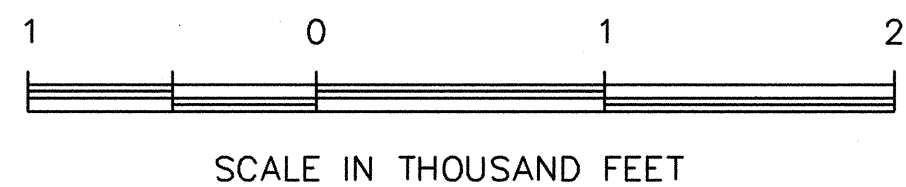

LOCATION OF PROJECT

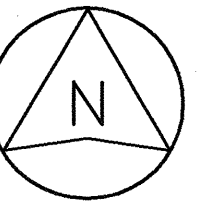

SCALE IN MILES

FEDERAL AID PROJECTS PREVIOUSLY
CONSTRUCTED OR UNDER CONSTRUCTION
MILE POST 21.38 TO MILE POST 23.11

CHANGES MADE DURING CONSTRUCTION HAVE BEEN
INCORPORATED ON THESE PLANS EXCEPT CHANGES
IN THE ORIGINAL THEORETICAL QUANTITIES. FOR
ACTUAL QUANTITIES, REFER TO PROJECT LEDGER
AND/OR CONSTRUCTION RECORDS.

DEPARTMENT OF TRANSPORTATION
STATE OF HAWAII
APPROVED: *Pat M. ...* 5-29-01
DIR. OF TRANSPORTATION DATE

PM: JJN
OPER: GKC, LSA*, MAM
REVISED: 04/09/01

DATE: 12/18/98
SCALE: 1" = 1 MILE
FILE: 9930-T1.DWG
JOB NO: 9930

ORIGINAL PLAN	DATE
DESIGNED BY	
DRAWN BY	
CHECKED BY	
QUANTITIES BY	
NO.	

ENGINEERING SOLUTIONS, INC. STEVE MORIKAWA (808) 274-3111 MARCH, 2001
DESIGNED BY P. S. & E. BY PHONE DATE