



FED. ROAD DIST. NO.	STATE	PROJ. NO.	FISCAL YEAR	SHEET NO.	TOTAL SHEETS
HAWAII	HAW.	50CD-02-00M	2001	19	33

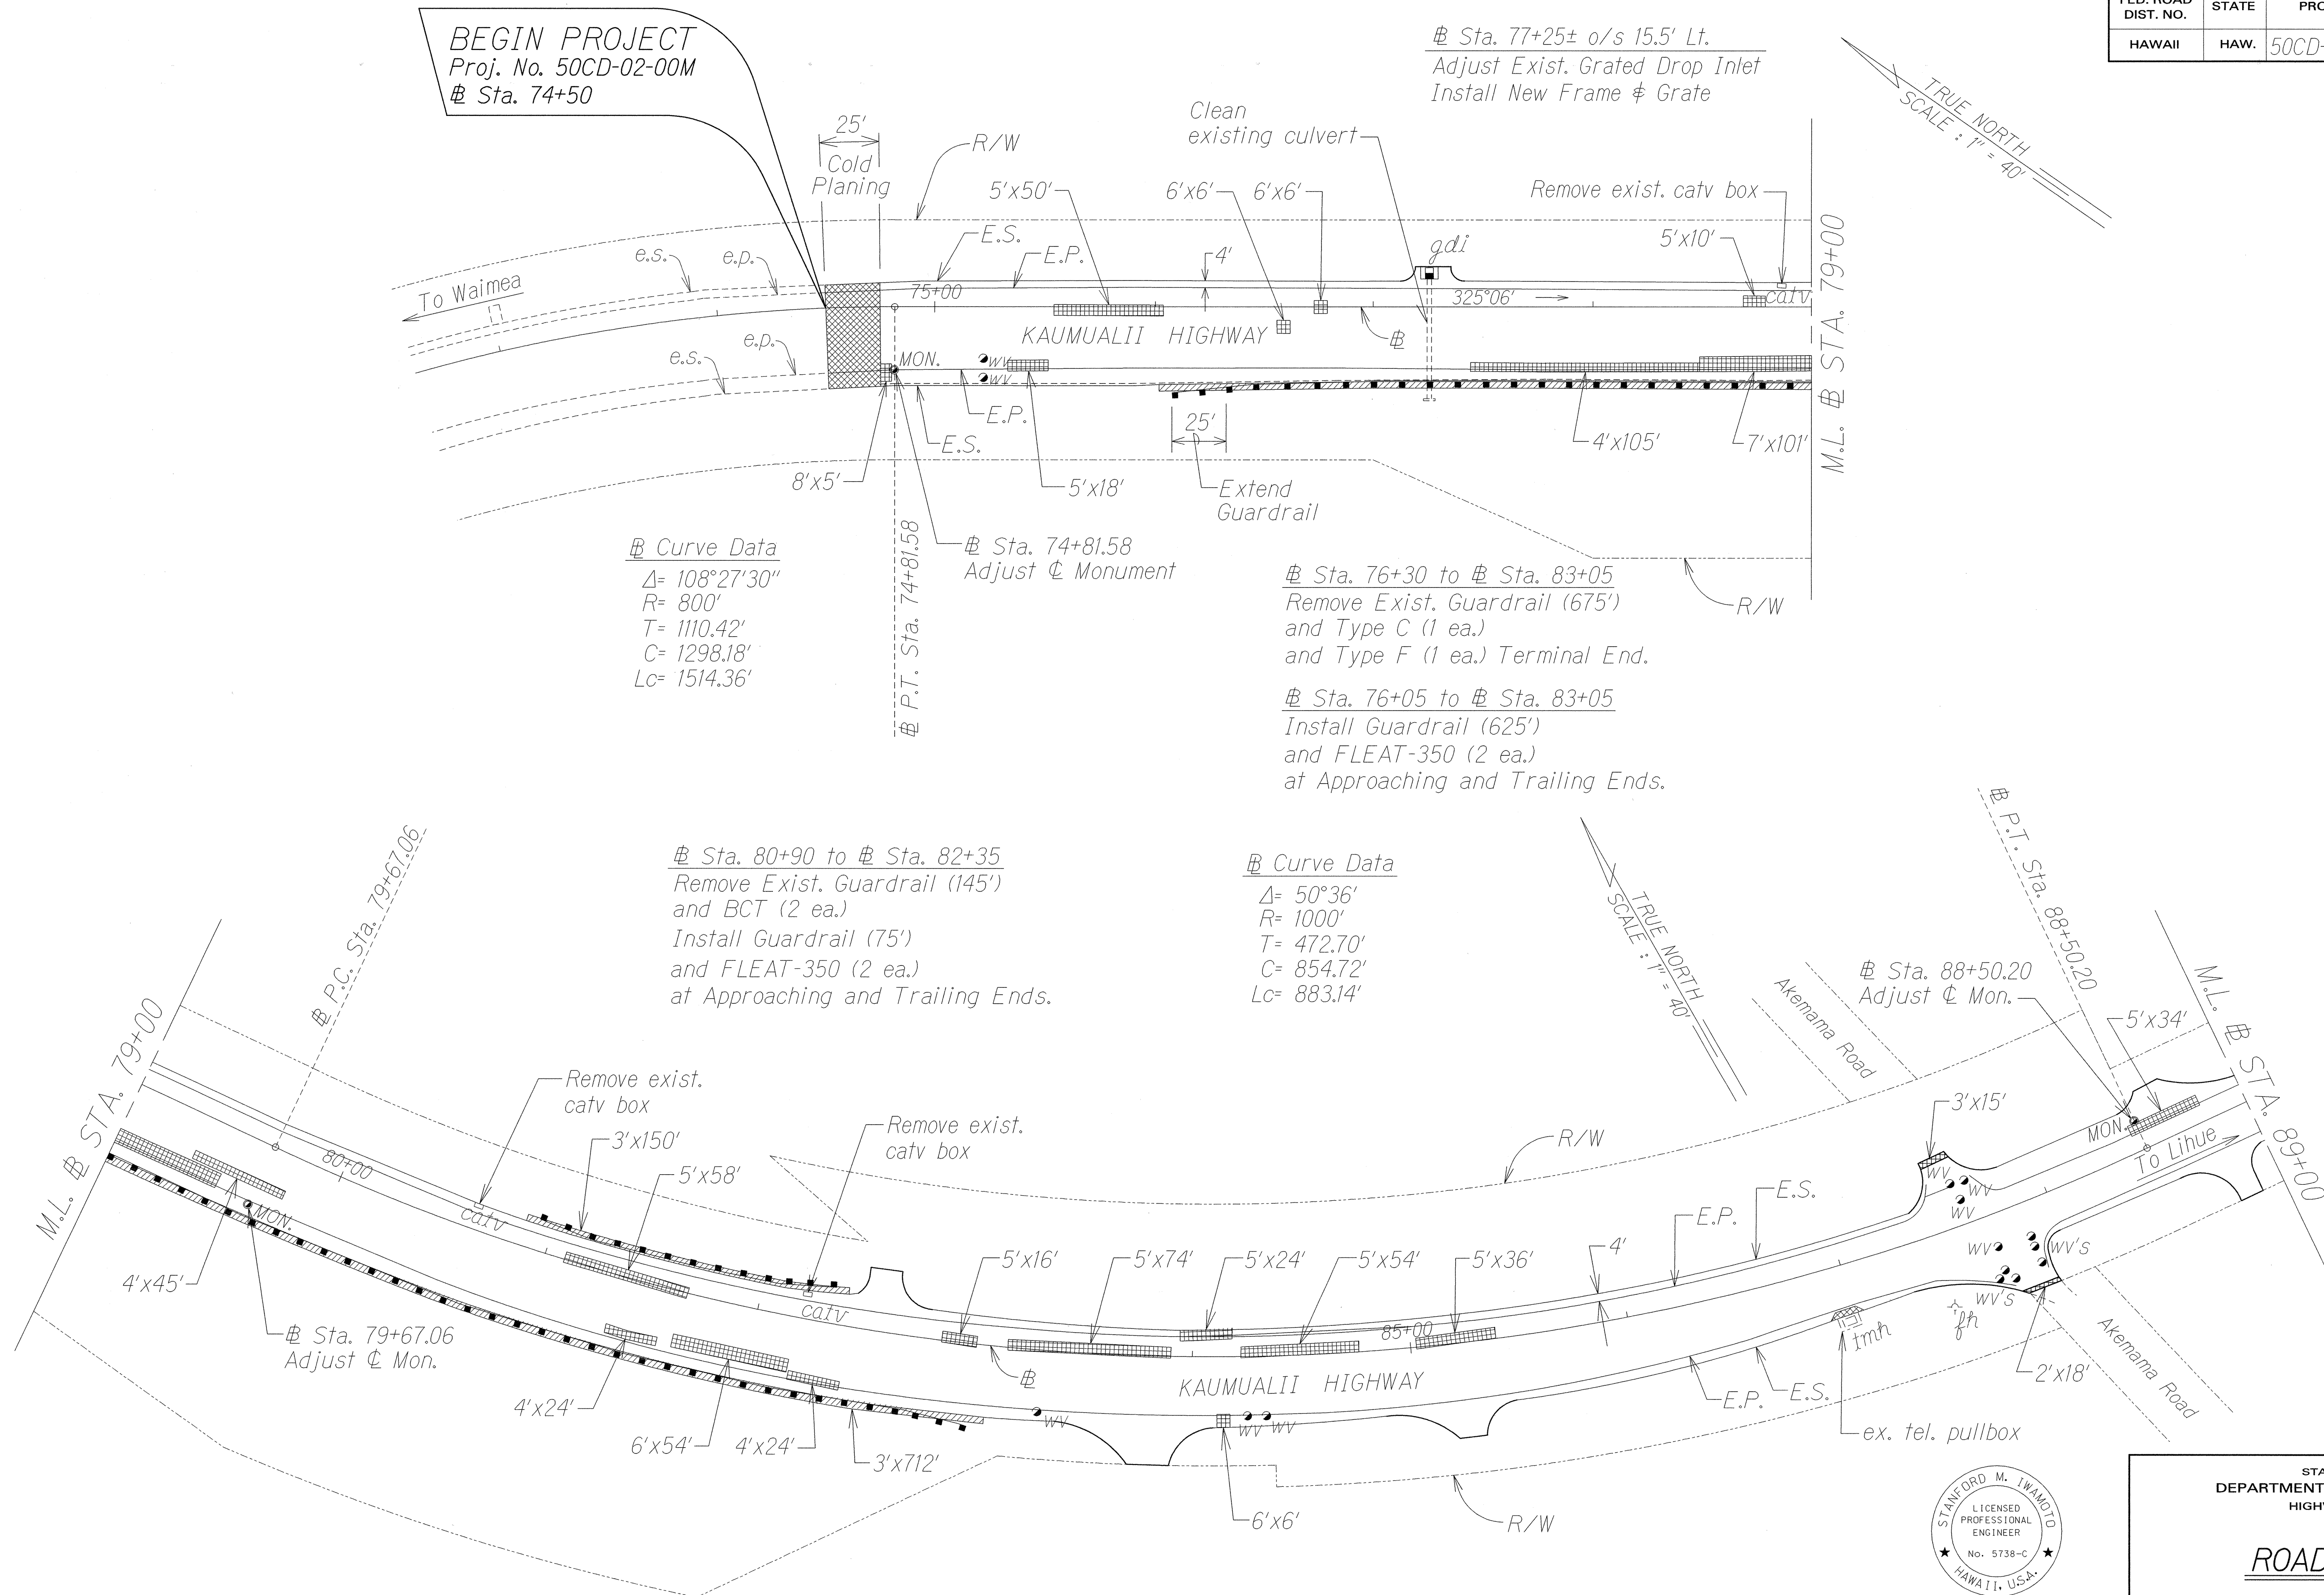

DATE	_____
SURVEY PLOTTED BY	_____
DRAWN BY	_____
TRACED BY	_____
NOTE BOOK	_____
DESIGNED BY	_____
QUANTITIES BY	_____
CHECKED BY	_____
ORIGINAL PLAN	_____
NOTE BOOK	_____
DESIGNED BY	_____
QUANTITIES BY	_____
CHECKED BY	_____

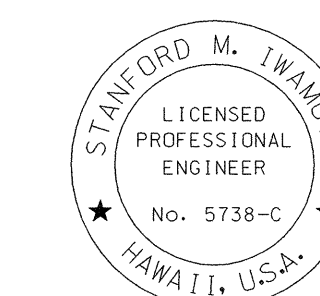

THIS WORK WAS PREPARED BY ME
OR UNDER MY SUPERVISION

[Signature]
Signature

STATE OF HAWAII
DEPARTMENT OF TRANSPORTATION
HIGHWAYS DIVISION



ROADWAY PLAN

KAUMUALII HIGHWAY RESURFACING
Vicinity of Omao Road to Koloa Road
Project No. 50CD-02-00M


Scale: 1" = 40' Date: August, 2000

SHEET No. 1 OF 5 SHEETS

FED. ROAD DIST. NO.	STATE	PROJ. NO.	FISCAL YEAR	SHEET NO.	TOTAL SHEETS
HAWAII	HAW.	50CD-02-00M	2001	21	33

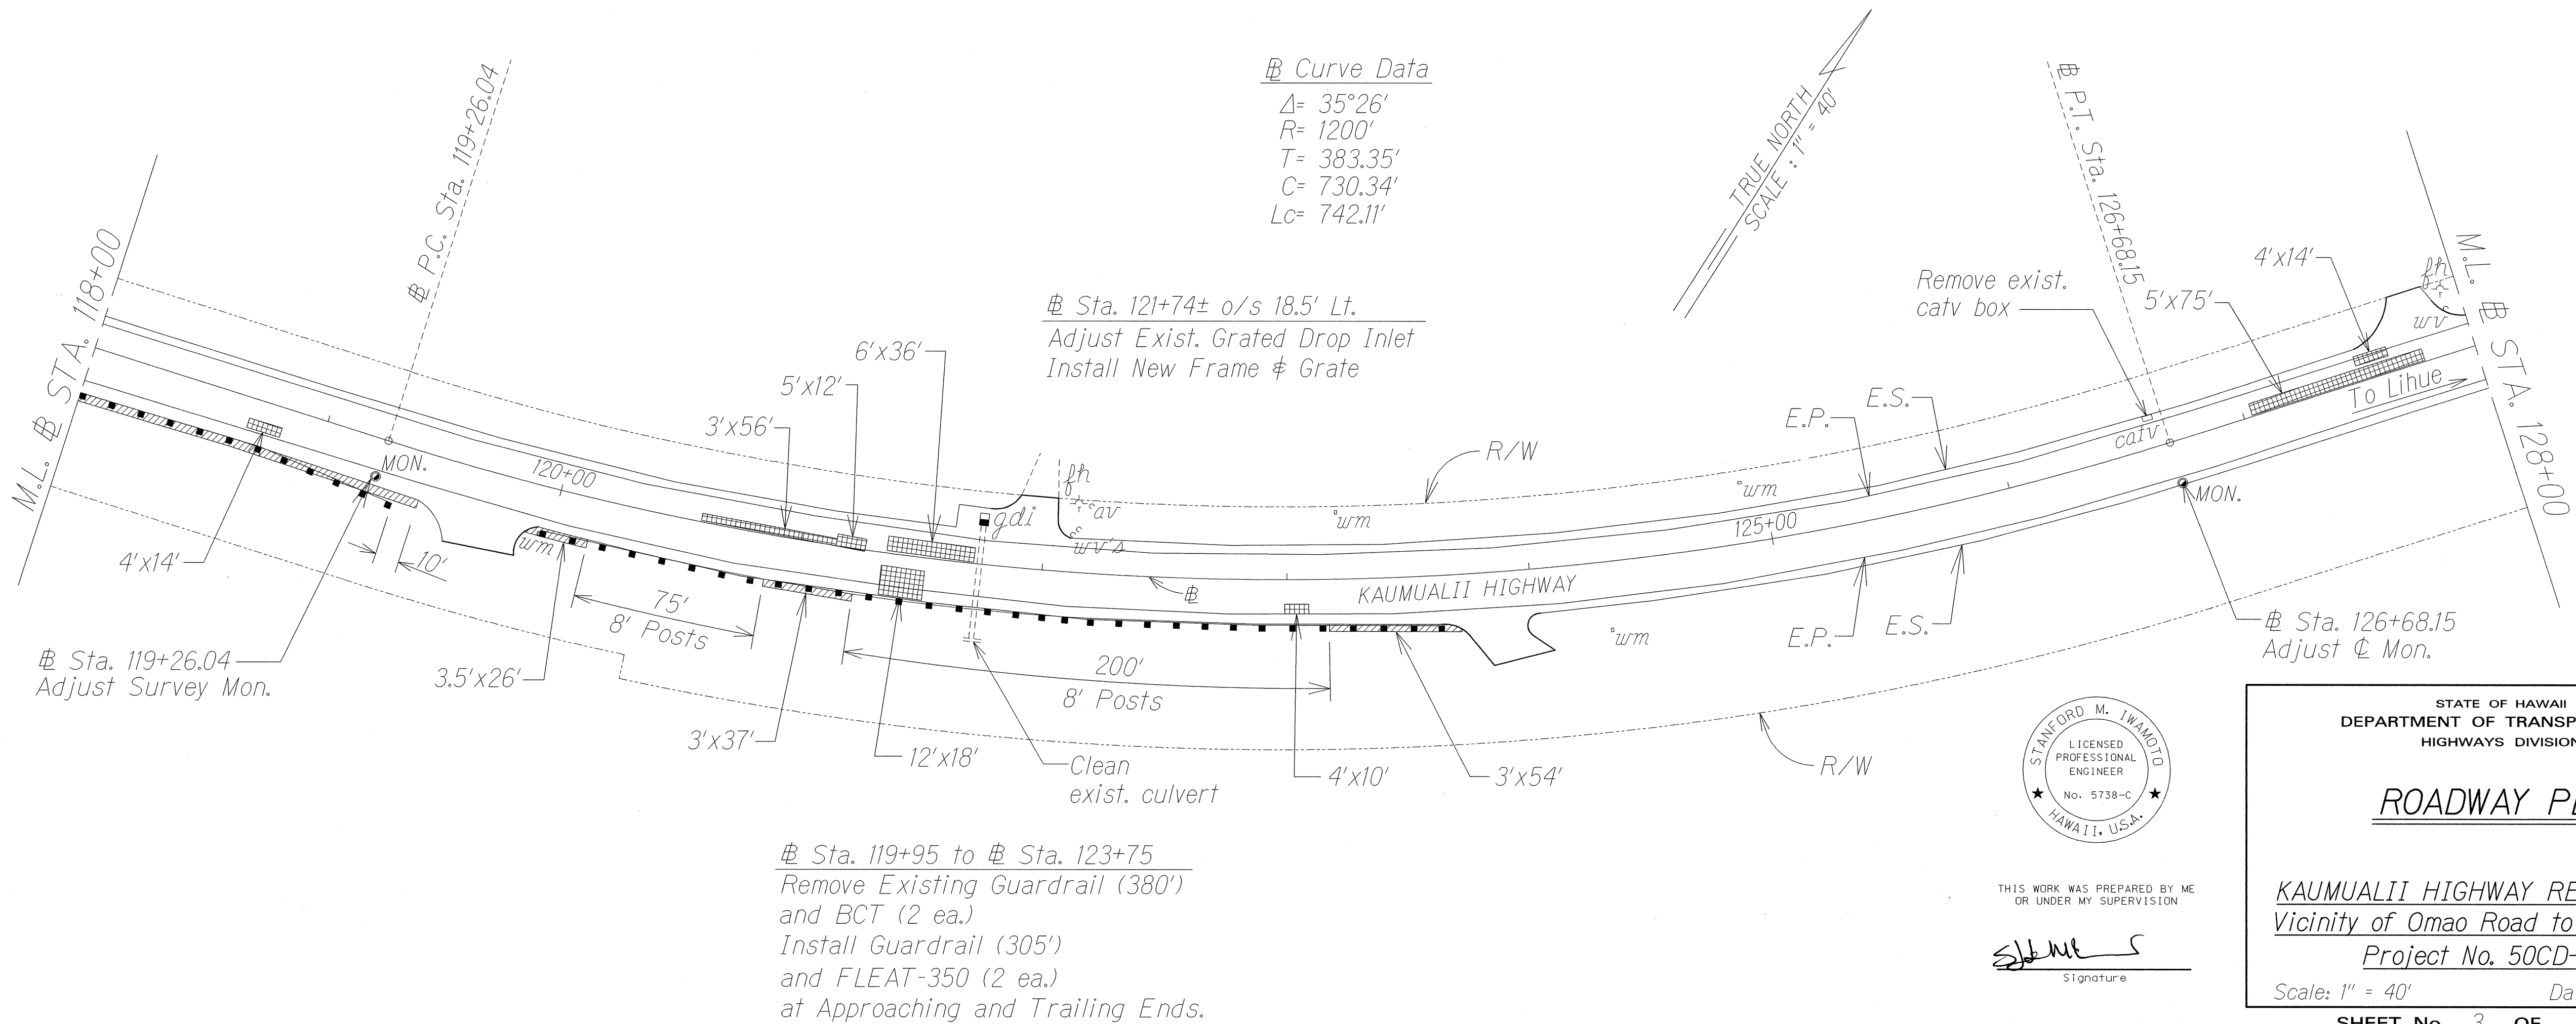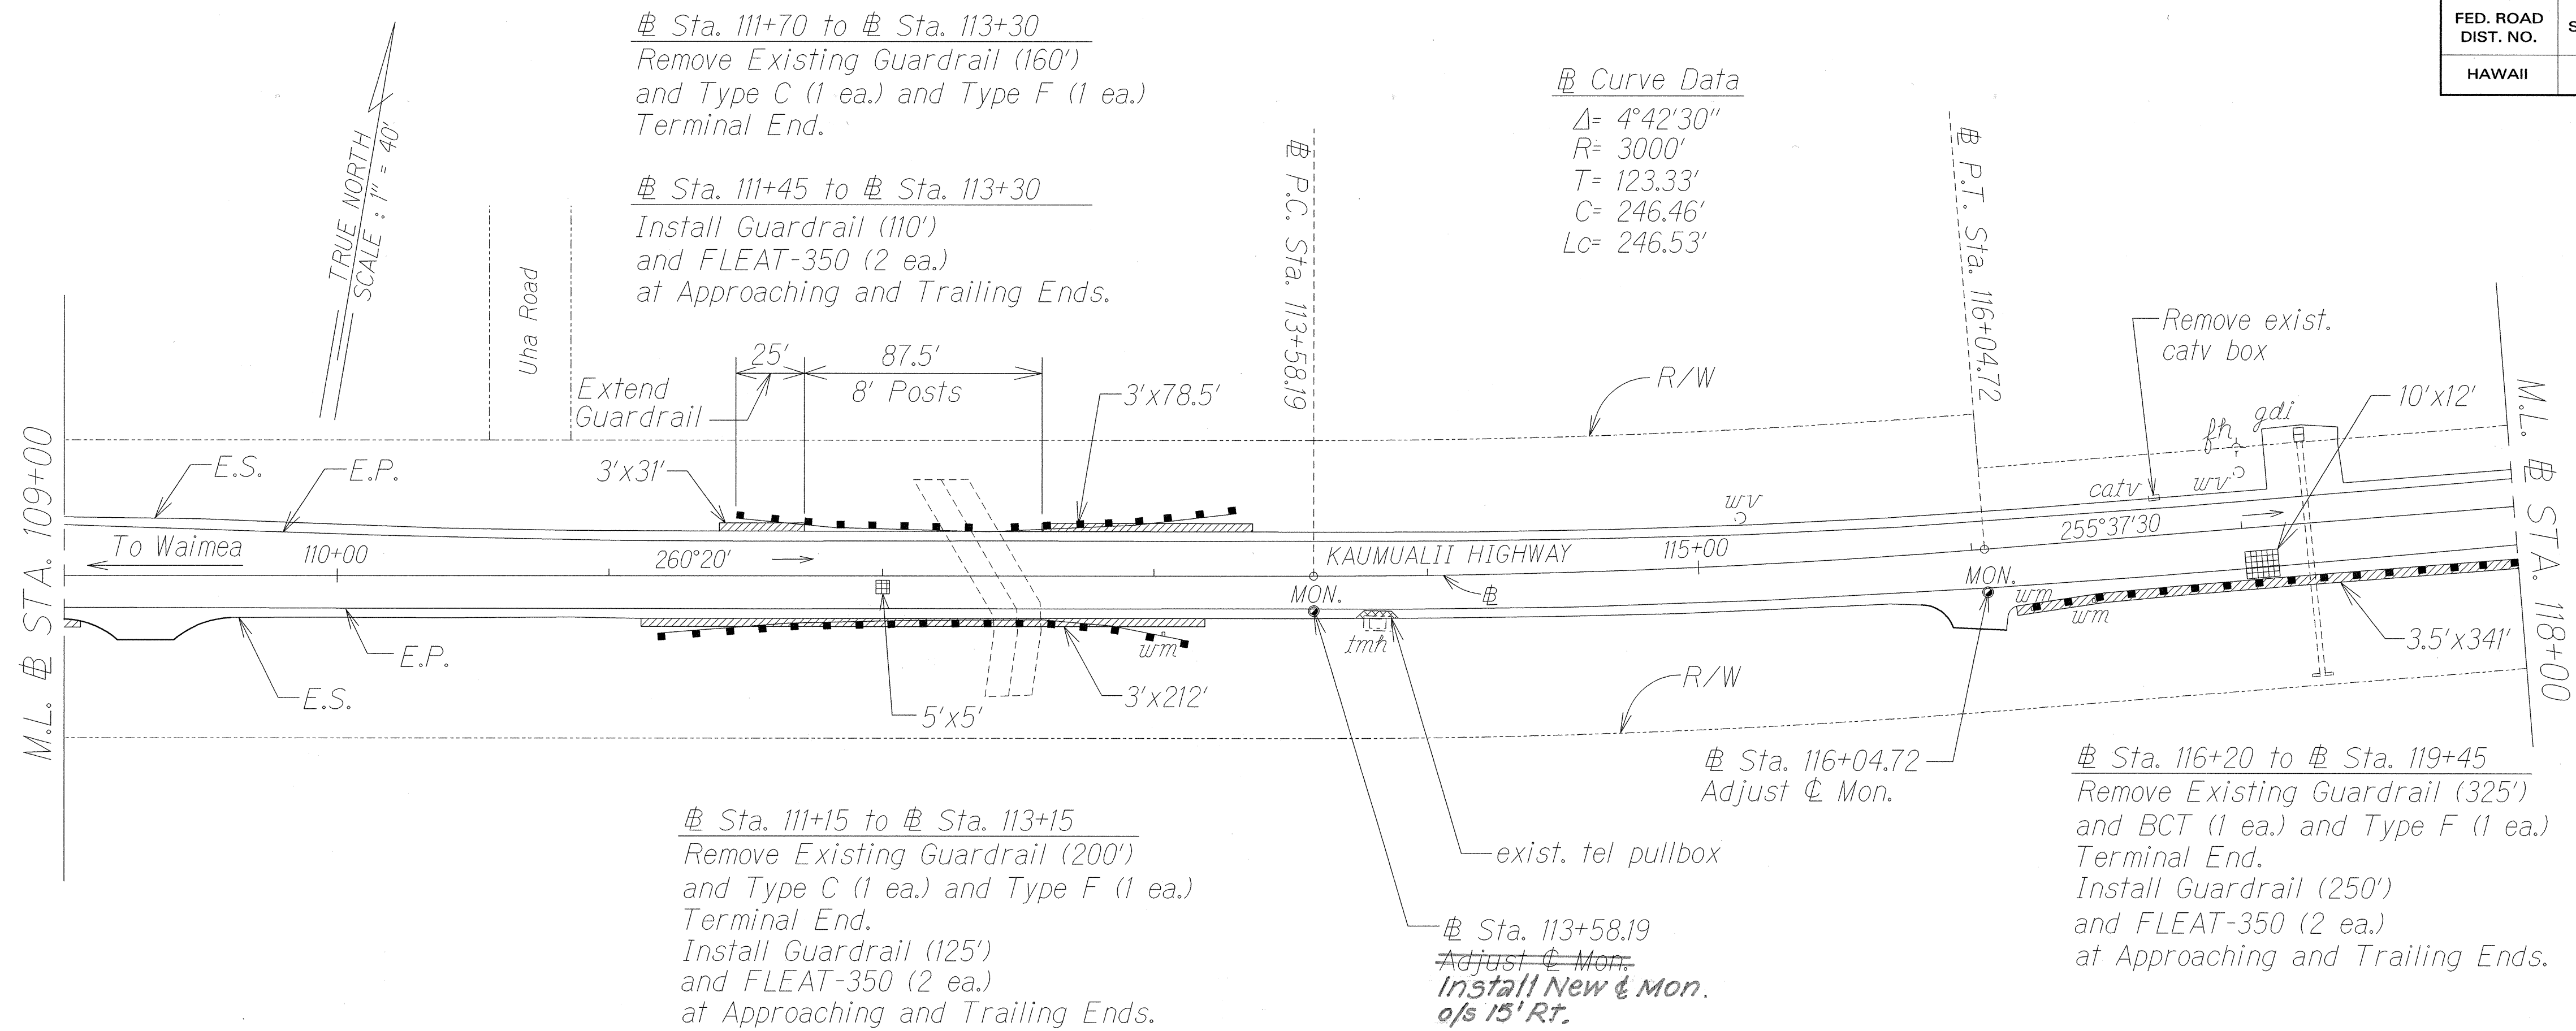

DATE	_____
DESIGNED BY	_____
DRAWN BY	_____
CHECKED BY	_____
NOTED BY	_____
QUANTITIES BY	_____
REVISIONS	_____

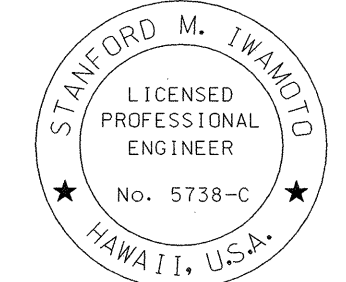

THIS WORK WAS PREPARED BY ME
OR UNDER MY SUPERVISION
Stanford M. Iwamoto
Signature

STATE OF HAWAII
DEPARTMENT OF TRANSPORTATION
HIGHWAYS DIVISION

ROADWAY PLAN


KAUMUALII HIGHWAY RESURFACING
Vicinity of O'ao Road to Koloa Road
Project No. 50CD-02-00M

Scale: 1" = 40' Date: August, 2000

SHEET No. 3 OF 5 SHEETS

"AS-BUILT"

FED. ROAD DIST. NO.	STATE	PROJ. NO.	FISCAL YEAR	SHEET NO.	TOTAL SHEETS
HAWAII	HAW.	50CD-02-00M	2001	22	33

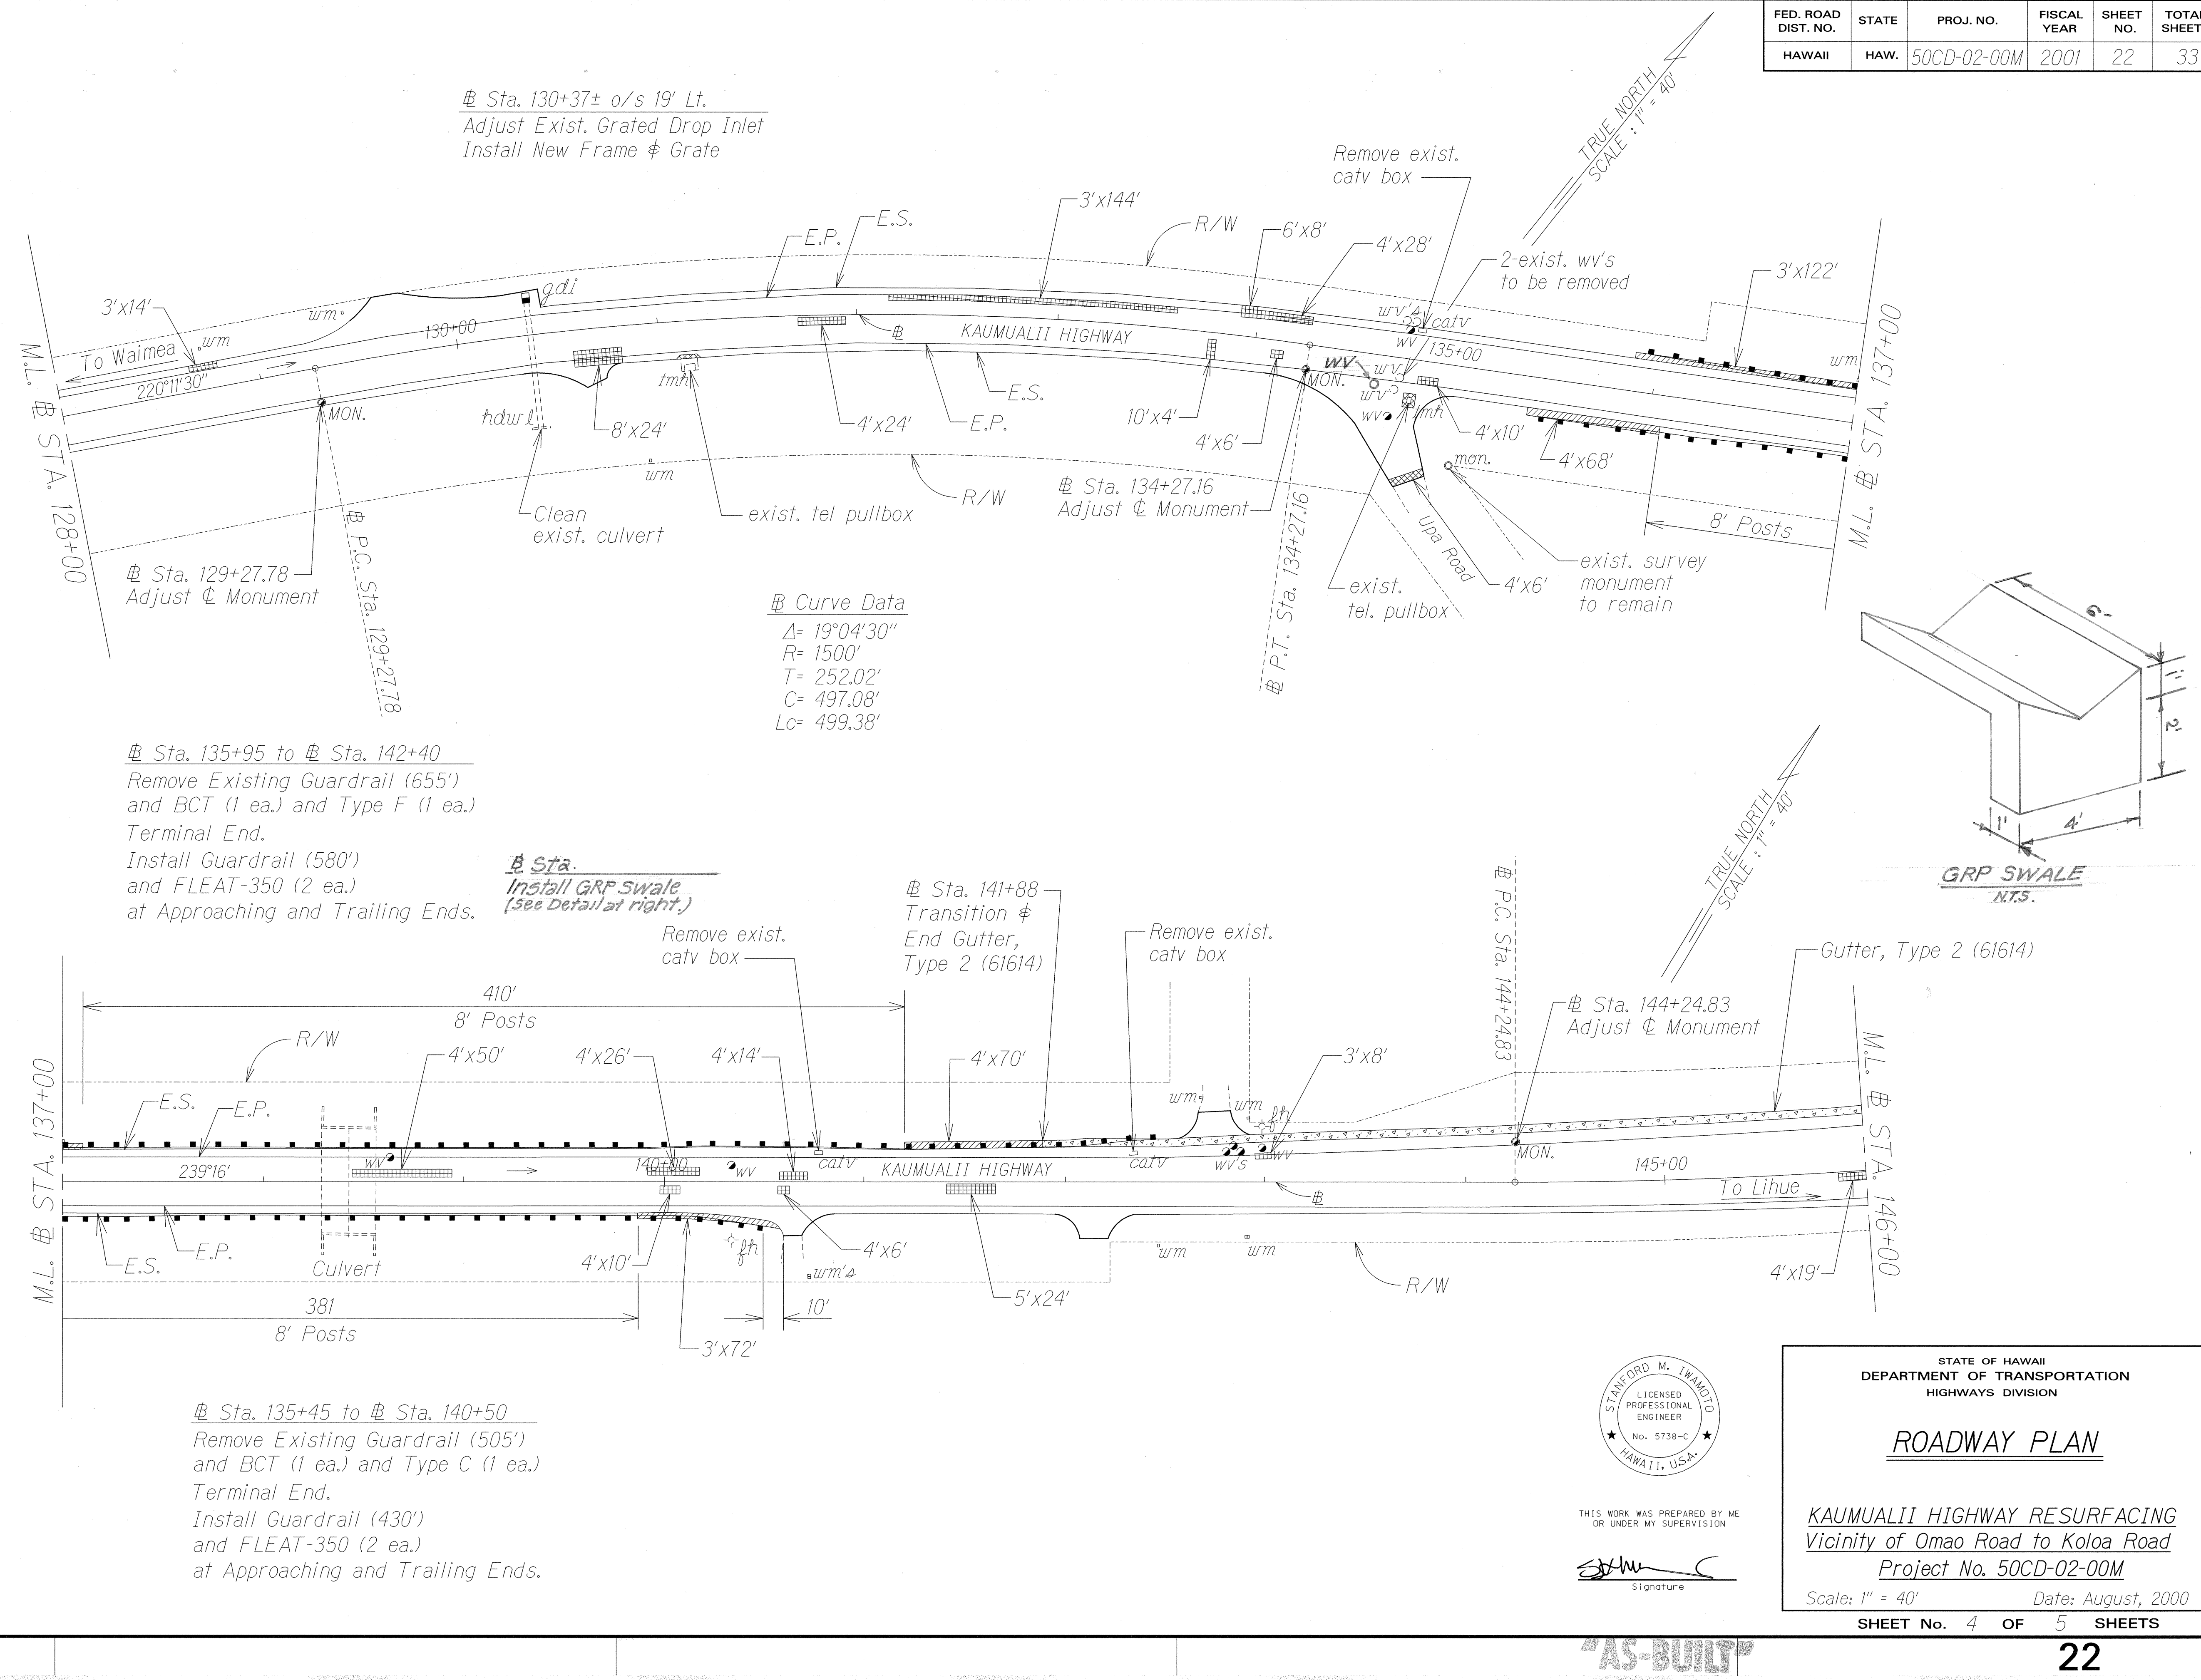

SURVEY PLOTTED BY	DATE
DRAWN BY	
DESIGNED BY	
QUANTITIES BY	
CHECKED BY	
ORIGINAL PLAN	
NOTE BOOK	
FILED	
DATE	
BY	

STANFORD M. IWAMOTO
LICENSED PROFESSIONAL ENGINEER
No. 5738-C
HAWAII, U.S.A.

THIS WORK WAS PREPARED BY ME
OR UNDER MY SUPERVISION

Stanford M. Iwamoto
Signature

STATE OF HAWAII
DEPARTMENT OF TRANSPORTATION
HIGHWAYS DIVISION




ROADWAY PLAN

KAUMUALII HIGHWAY RESURFACING
Vicinity of Omao Road to Koloa Road
Project No. 50CD-02-00M

Scale: 1" = 40' Date: August, 2000

SHEET No. 4 OF 5 SHEETS

FED. ROAD DIST. NO.	STATE	PROJ. NO.	FISCAL YEAR	SHEET NO.	TOTAL SHEETS
HAWAII	HAW.	50CD-02-00M	2001	23	33

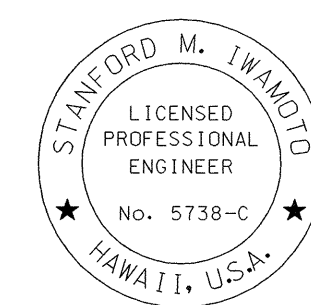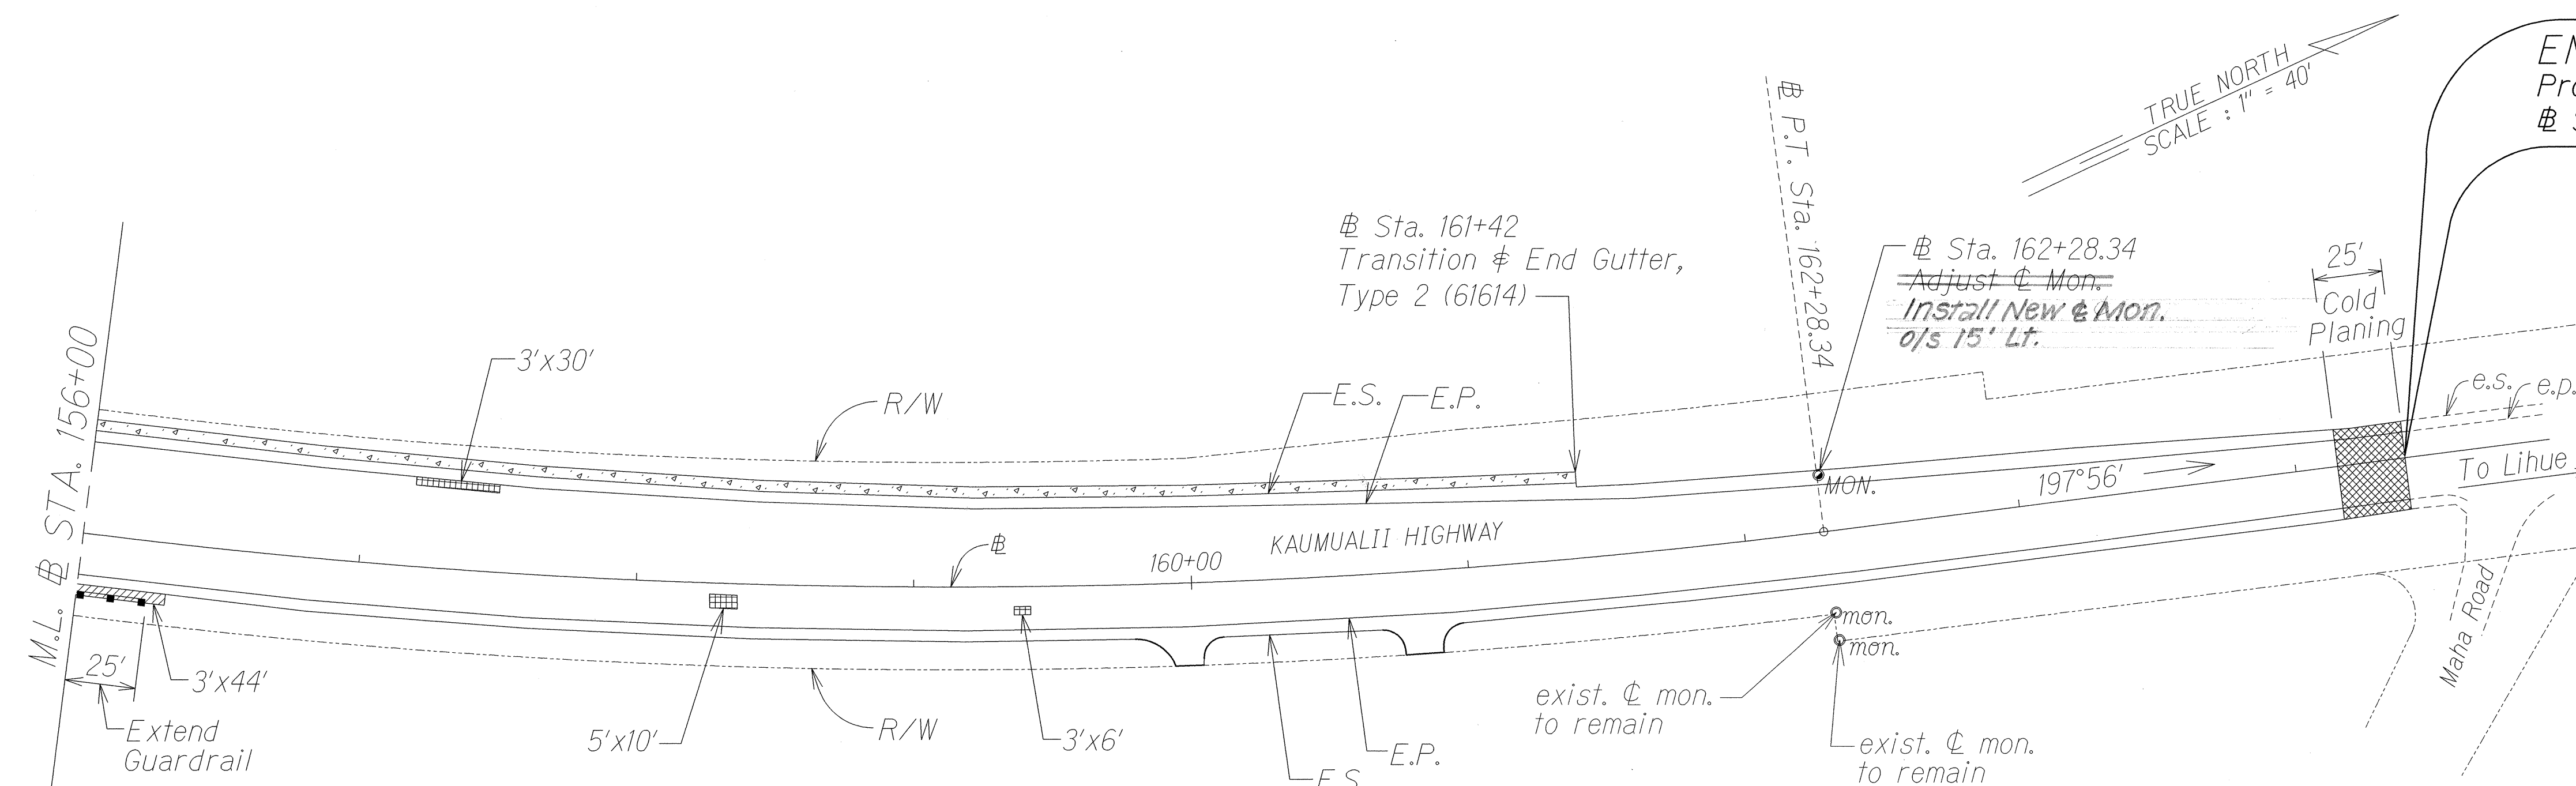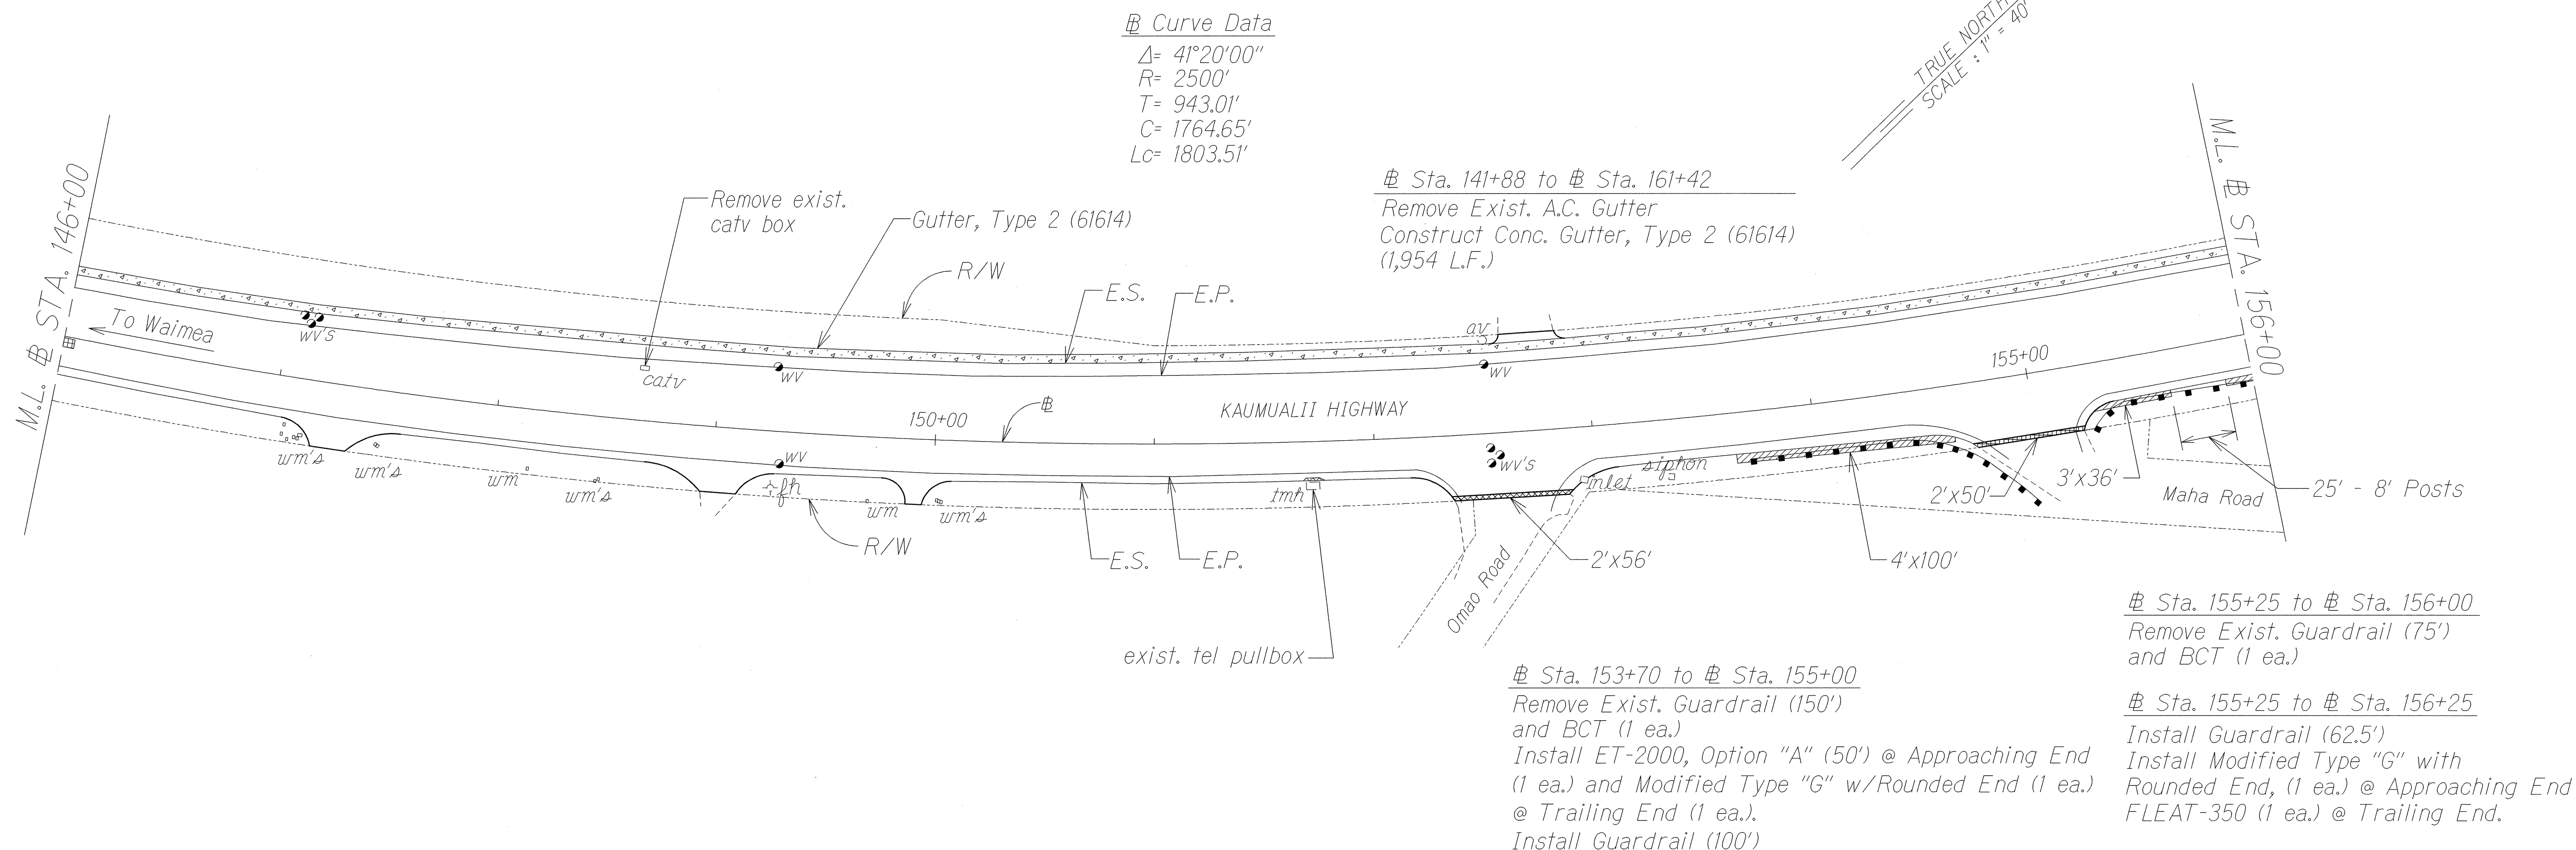

THIS WORK WAS PREPARED BY ME
 OR UNDER MY SUPERVISION

Signature

STATE OF HAWAII
 DEPARTMENT OF TRANSPORTATION
 HIGHWAYS DIVISION

ROADWAY PLAN

KAUMUALII HIGHWAY RESURFACING
Vicinity of Omao Road to Koloa Road
Project No. 50CD-02-00M

Scale: 1" = 40' Date: August, 2000

SHEET No. 5 OF 5 SHEETS

APPROVAL:

 County Engineer, County of Kauai Date 10/20/00
 (For Work Within County Right-of-Way Only)

ORIGINAL PLAN	DATE
NOTED BY	
DESIGNED BY	
CHECKED BY	
IN CHARGE	