

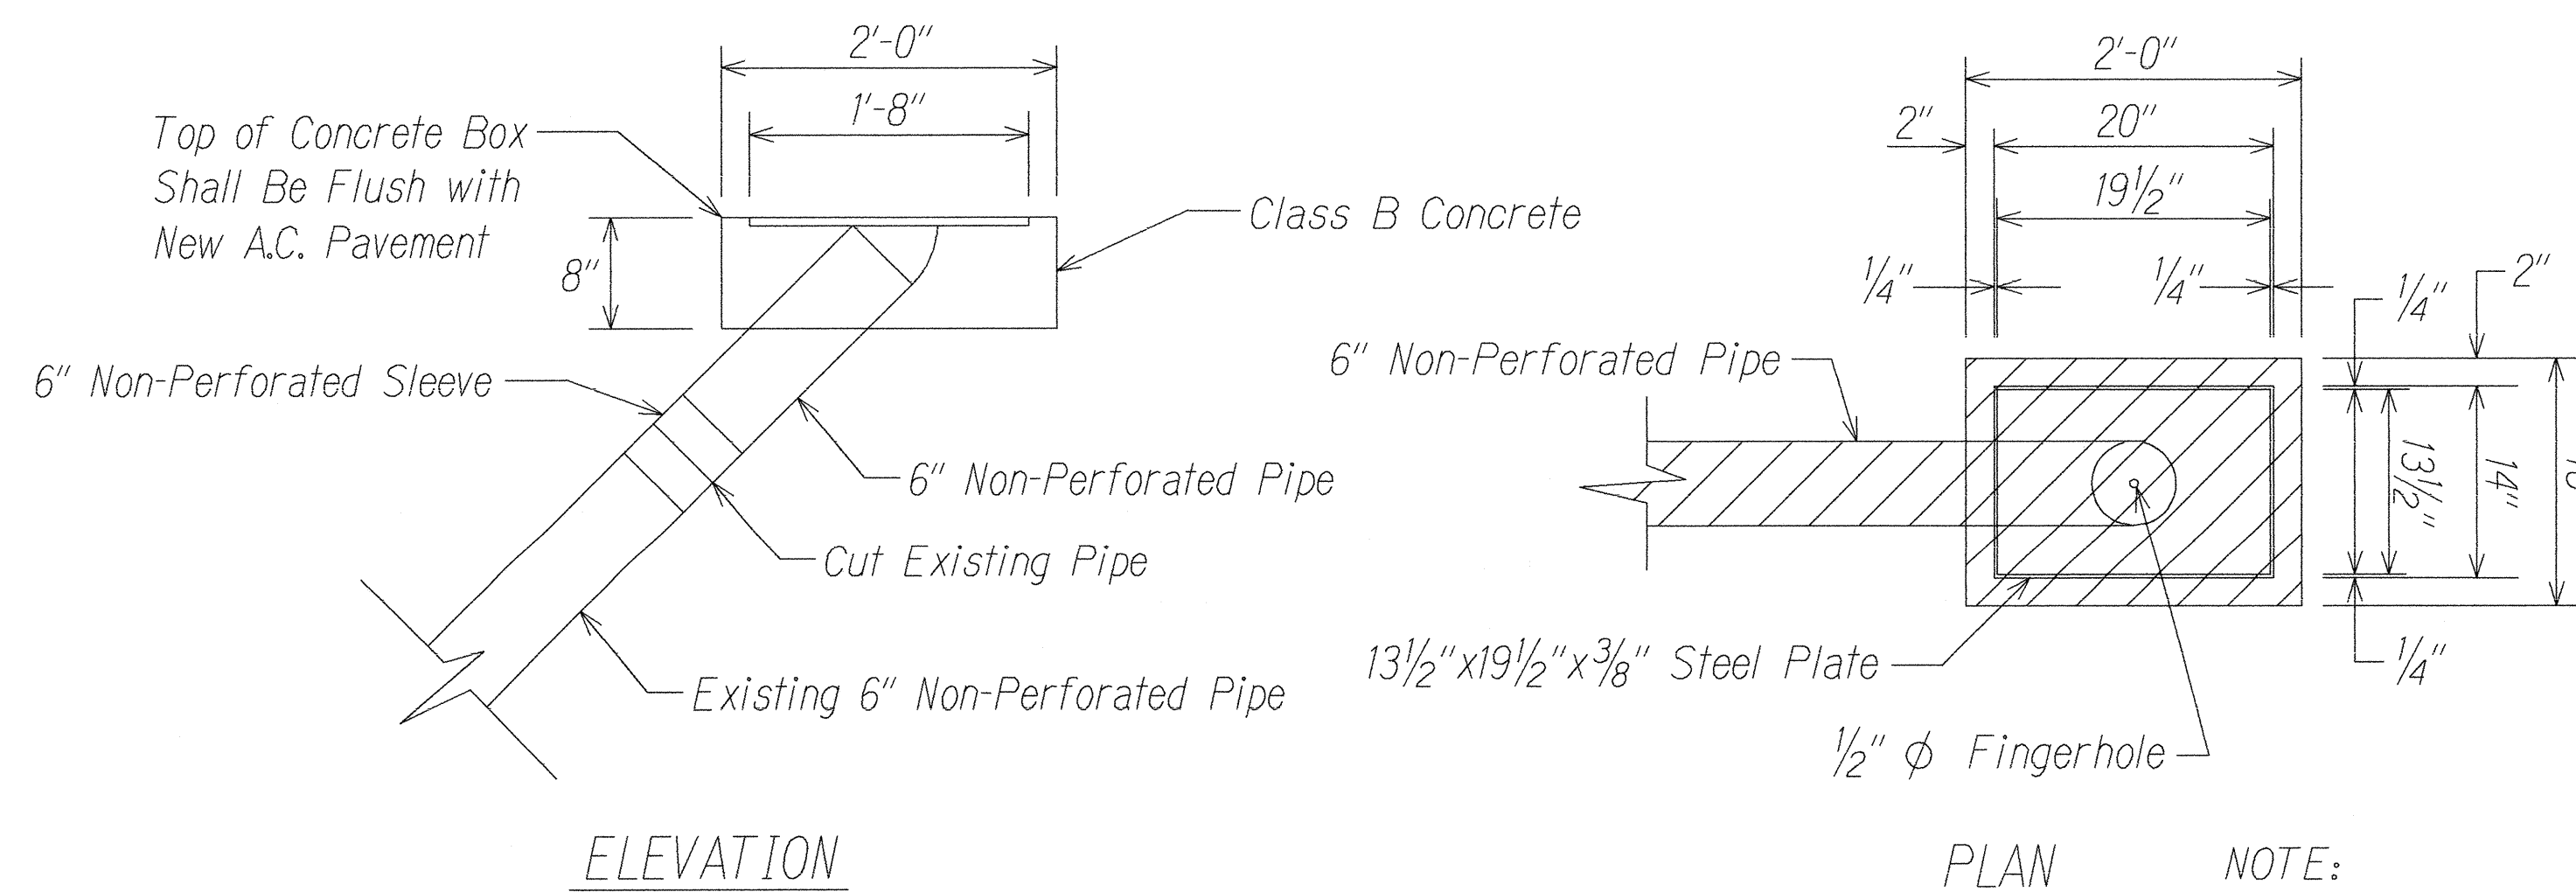


FED. ROAD DIST. NO.	STATE	PROJ. NO.	FISCAL YEAR	SHEET NO.	TOTAL SHEETS
HAWAII	HAW.	HWY-K-02-98	2000	48	53

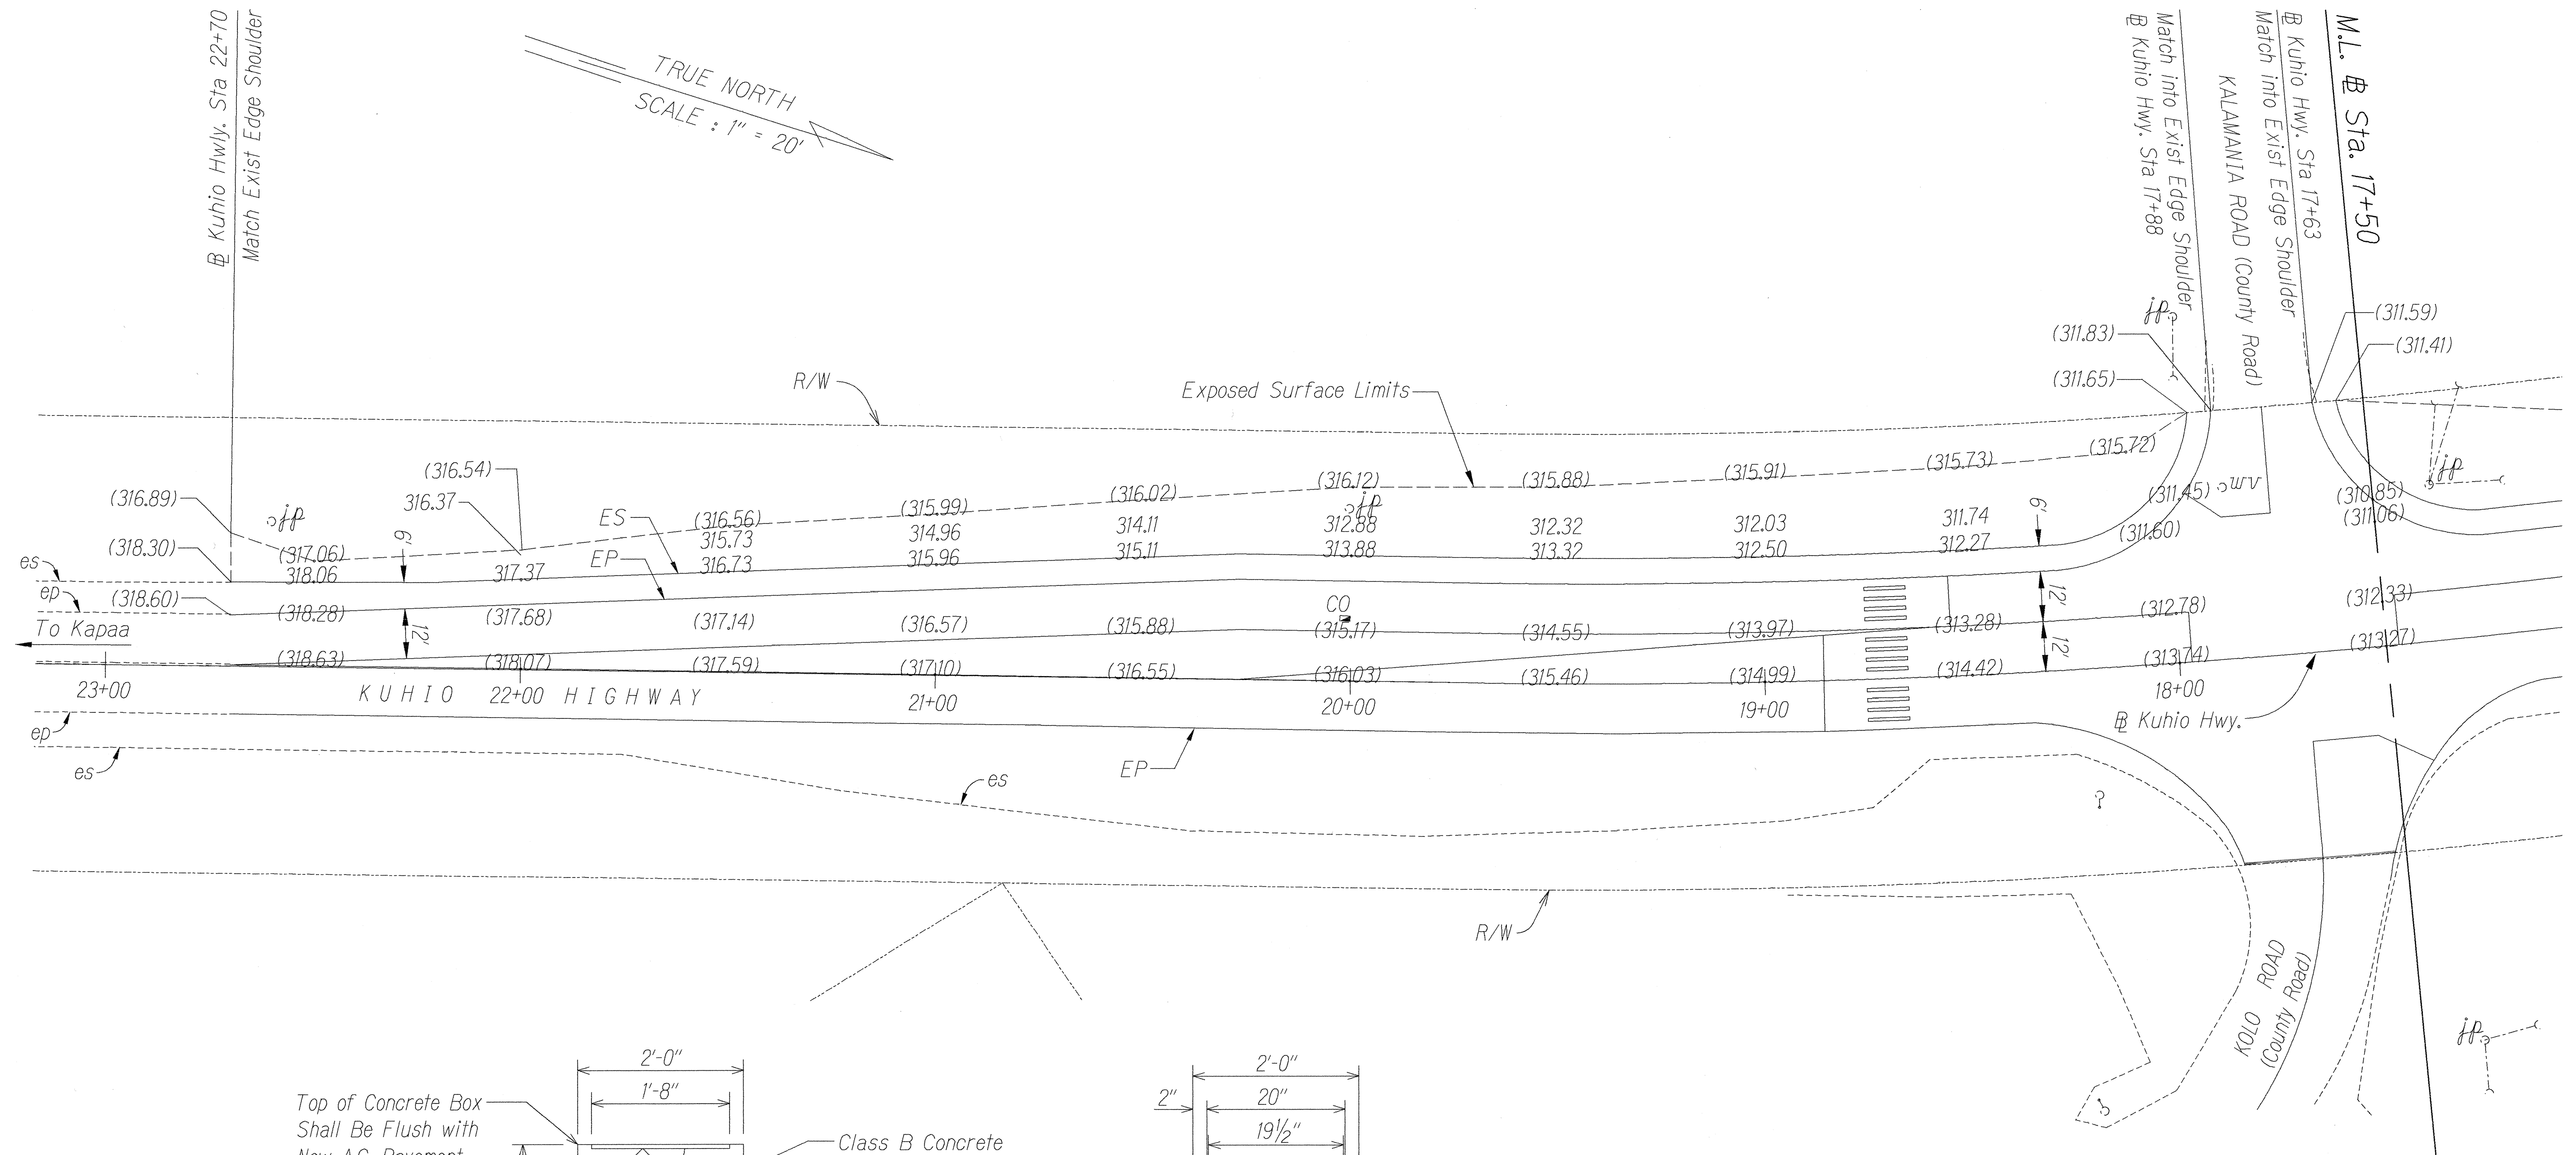

CLEANOUT ALONG KUHIO HWY.
Scale: 1" = 1'-0"

NOTE:
All Steel Parts shall be galvanized in accordance with the requirements of ASTM A123.

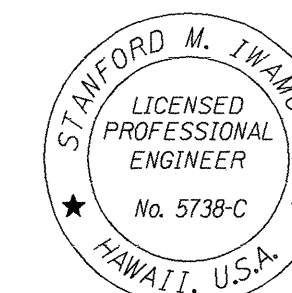

THIS WORK WAS PREPARED BY ME OR UNDER MY SUPERVISION

Signature

STATE OF HAWAII
DEPARTMENT OF TRANSPORTATION
HIGHWAYS DIVISION
ROADWAY GRADES - KOLO ROAD
KUHIO HIGHWAY
STA. 17+50 TO STA. 22+70
MISCELLANEOUS TRAFFIC OPERATIONAL AND
SAFETY IMPROVEMENTS TO EXISTING
INTERSECTIONS AND HIGHWAY FACILITIES
Project No. HWY-K-02-98
Scale: As Shown Date: August, 1999
SHEET No. 2 OF 2 SHEETS

ORIGINAL PLAN	SURVEY PLOTTED BY	DATE
	DRAWN BY	DATE
	DESIGNED BY	DATE
	CHECKED BY	DATE
NOTE BOOK	NO.	

"AS-BUILT"