




FED. ROAD DIST. NO.	STATE	PROJ. NO.	FISCAL YEAR	SHEET NO.	TOTAL SHEETS
HAWAII	HAW.	HWY-K-02-98	2000	46	53

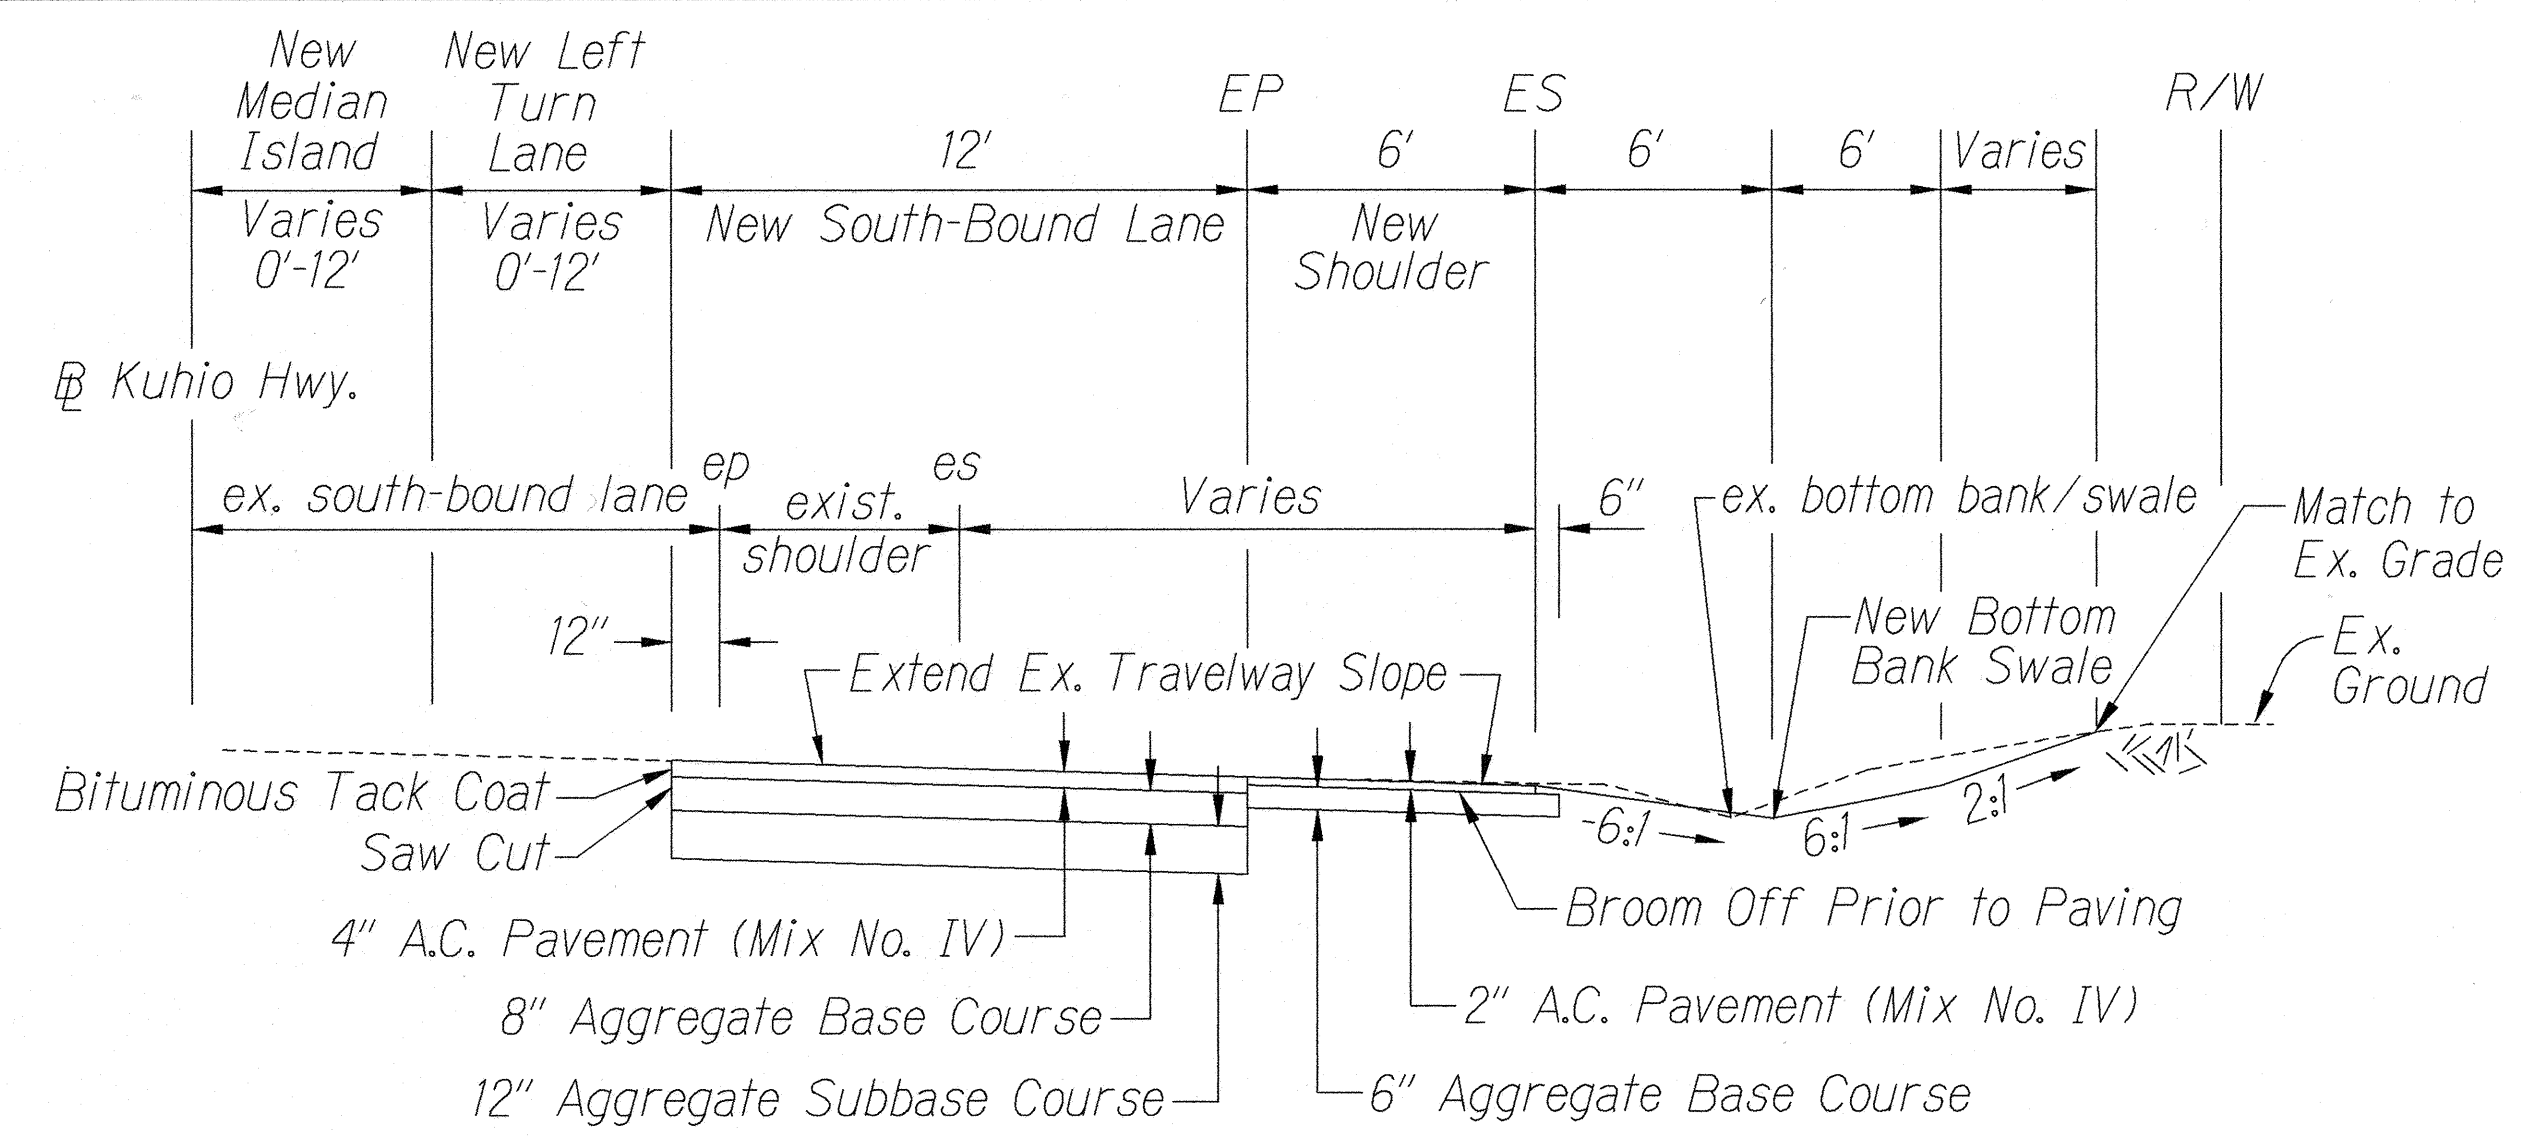


TYPICAL SECTION - KUHIO HIGHWAY
 @ STA. 11+65 TO @ STA. 17+22 AND @ STA. 18+29 TO @ STA. 21+00
 Scale: 1/4" = 1'

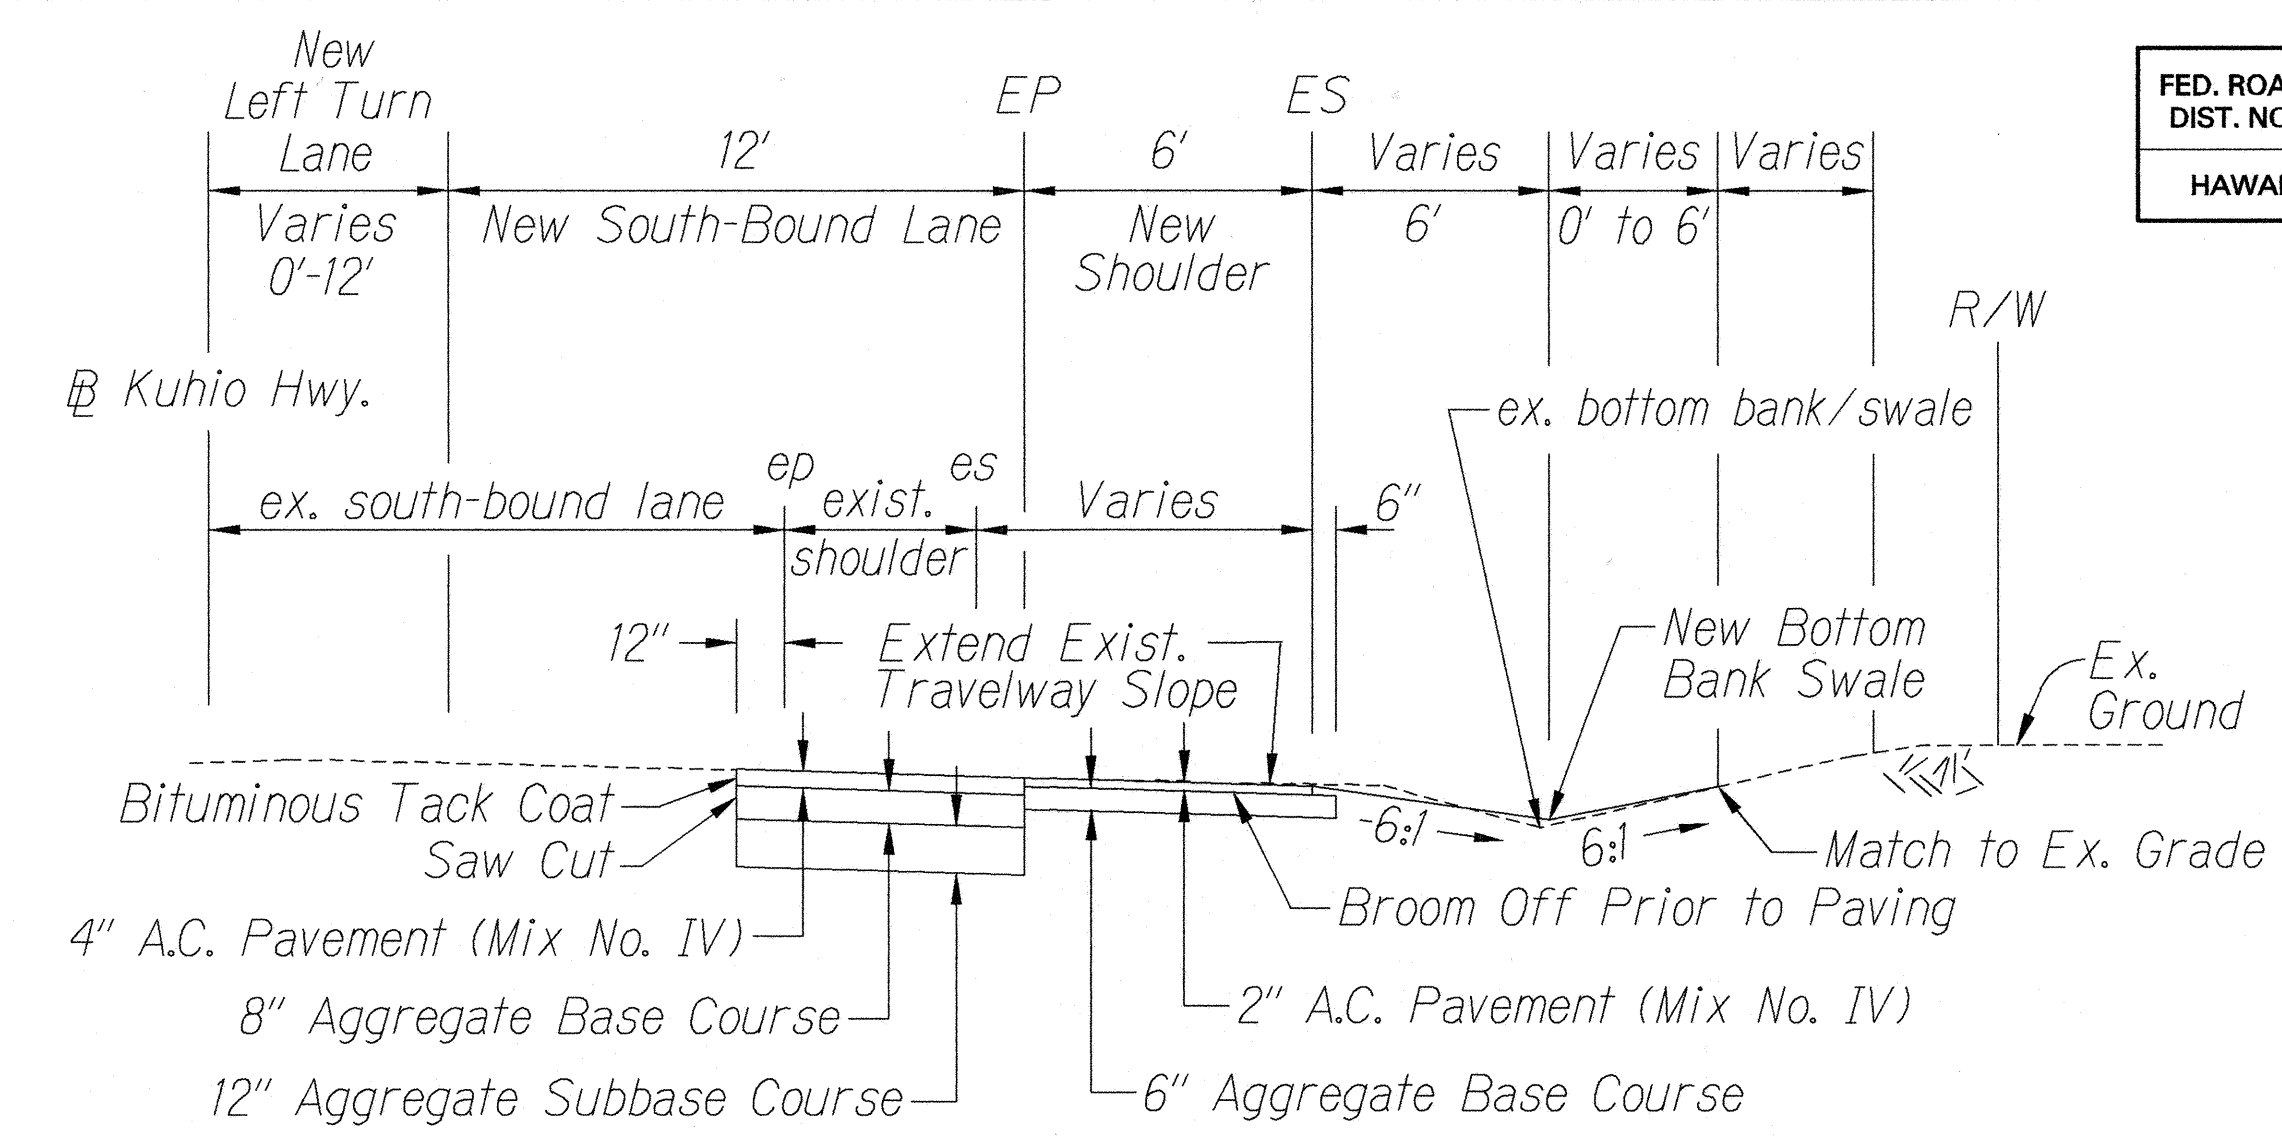

TYPICAL SECTION - KUHIO HIGHWAY @ STA. 21+00 TO @ STA. 22+70
 Scale: 1/4" = 1'

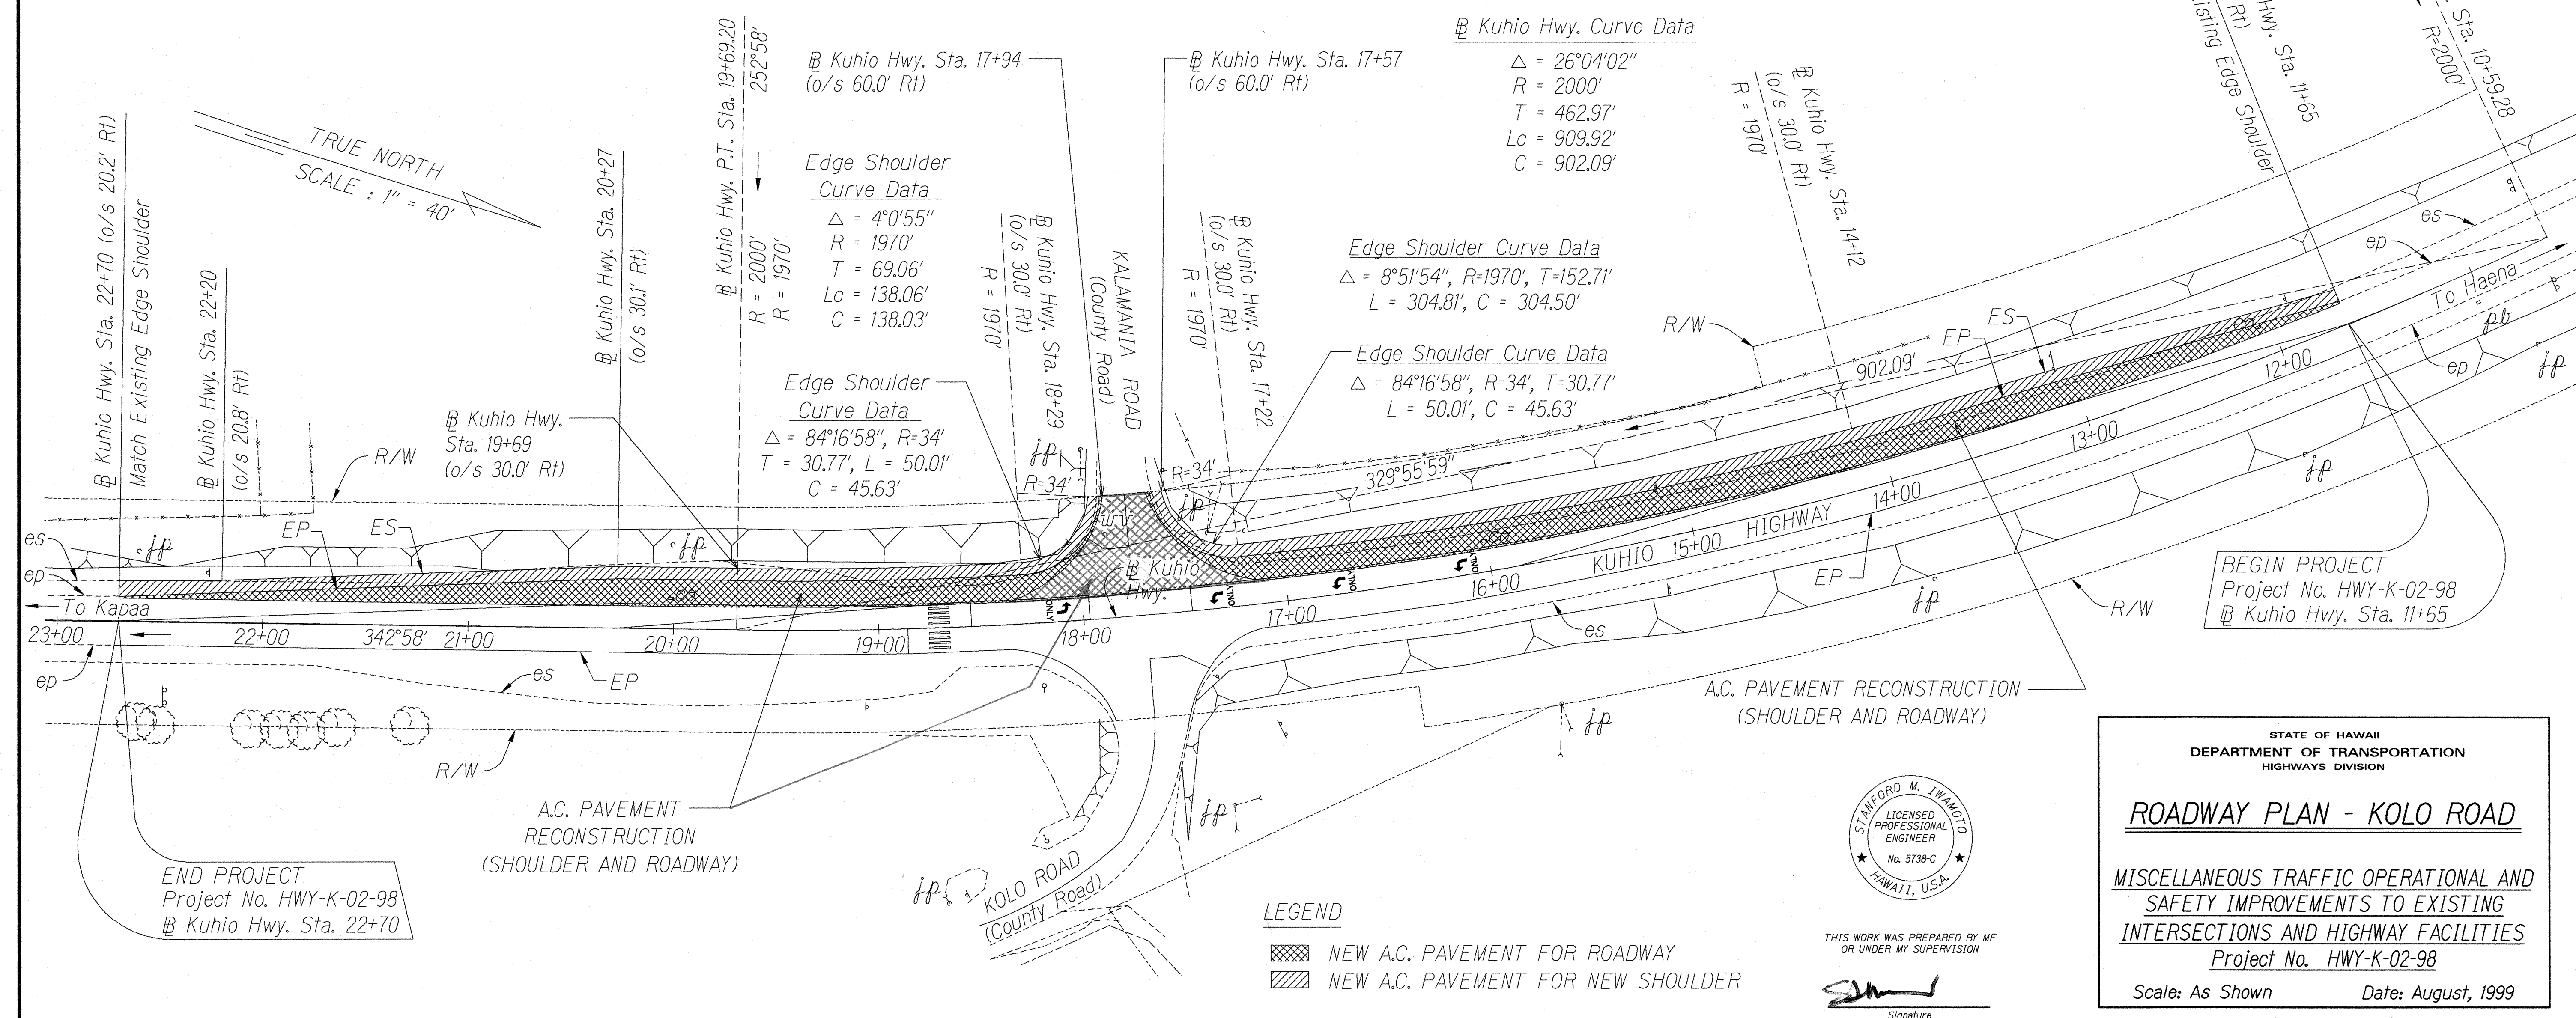

SURVEY PLOTTED BY	DATE
DRAWN BY	DATE
DESIGNED BY	DATE
CHECKED BY	DATE
NOTED BY	DATE
DATE	

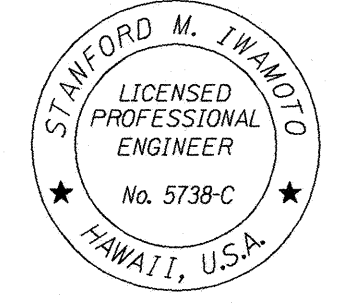

THIS WORK WAS PREPARED BY ME OR UNDER MY SUPERVISION

Signature

STATE OF HAWAII
DEPARTMENT OF TRANSPORTATION
HIGHWAYS DIVISION

ROADWAY PLAN - KOLO ROAD

MISCELLANEOUS TRAFFIC OPERATIONAL AND SAFETY IMPROVEMENTS TO EXISTING INTERSECTIONS AND HIGHWAY FACILITIES

Project No. HWY-K-02-98

Scale: As Shown Date: August, 1999

SHEET No. 1 OF 1 SHEETS

"AS-BUILT"