


FED. ROAD DIST. NO.	STATE	PROJ. NO.	FISCAL YEAR	SHEET NO.	TOTAL SHEETS
HAWAII	HAW.	HWY-K-02-98	2000	8	53

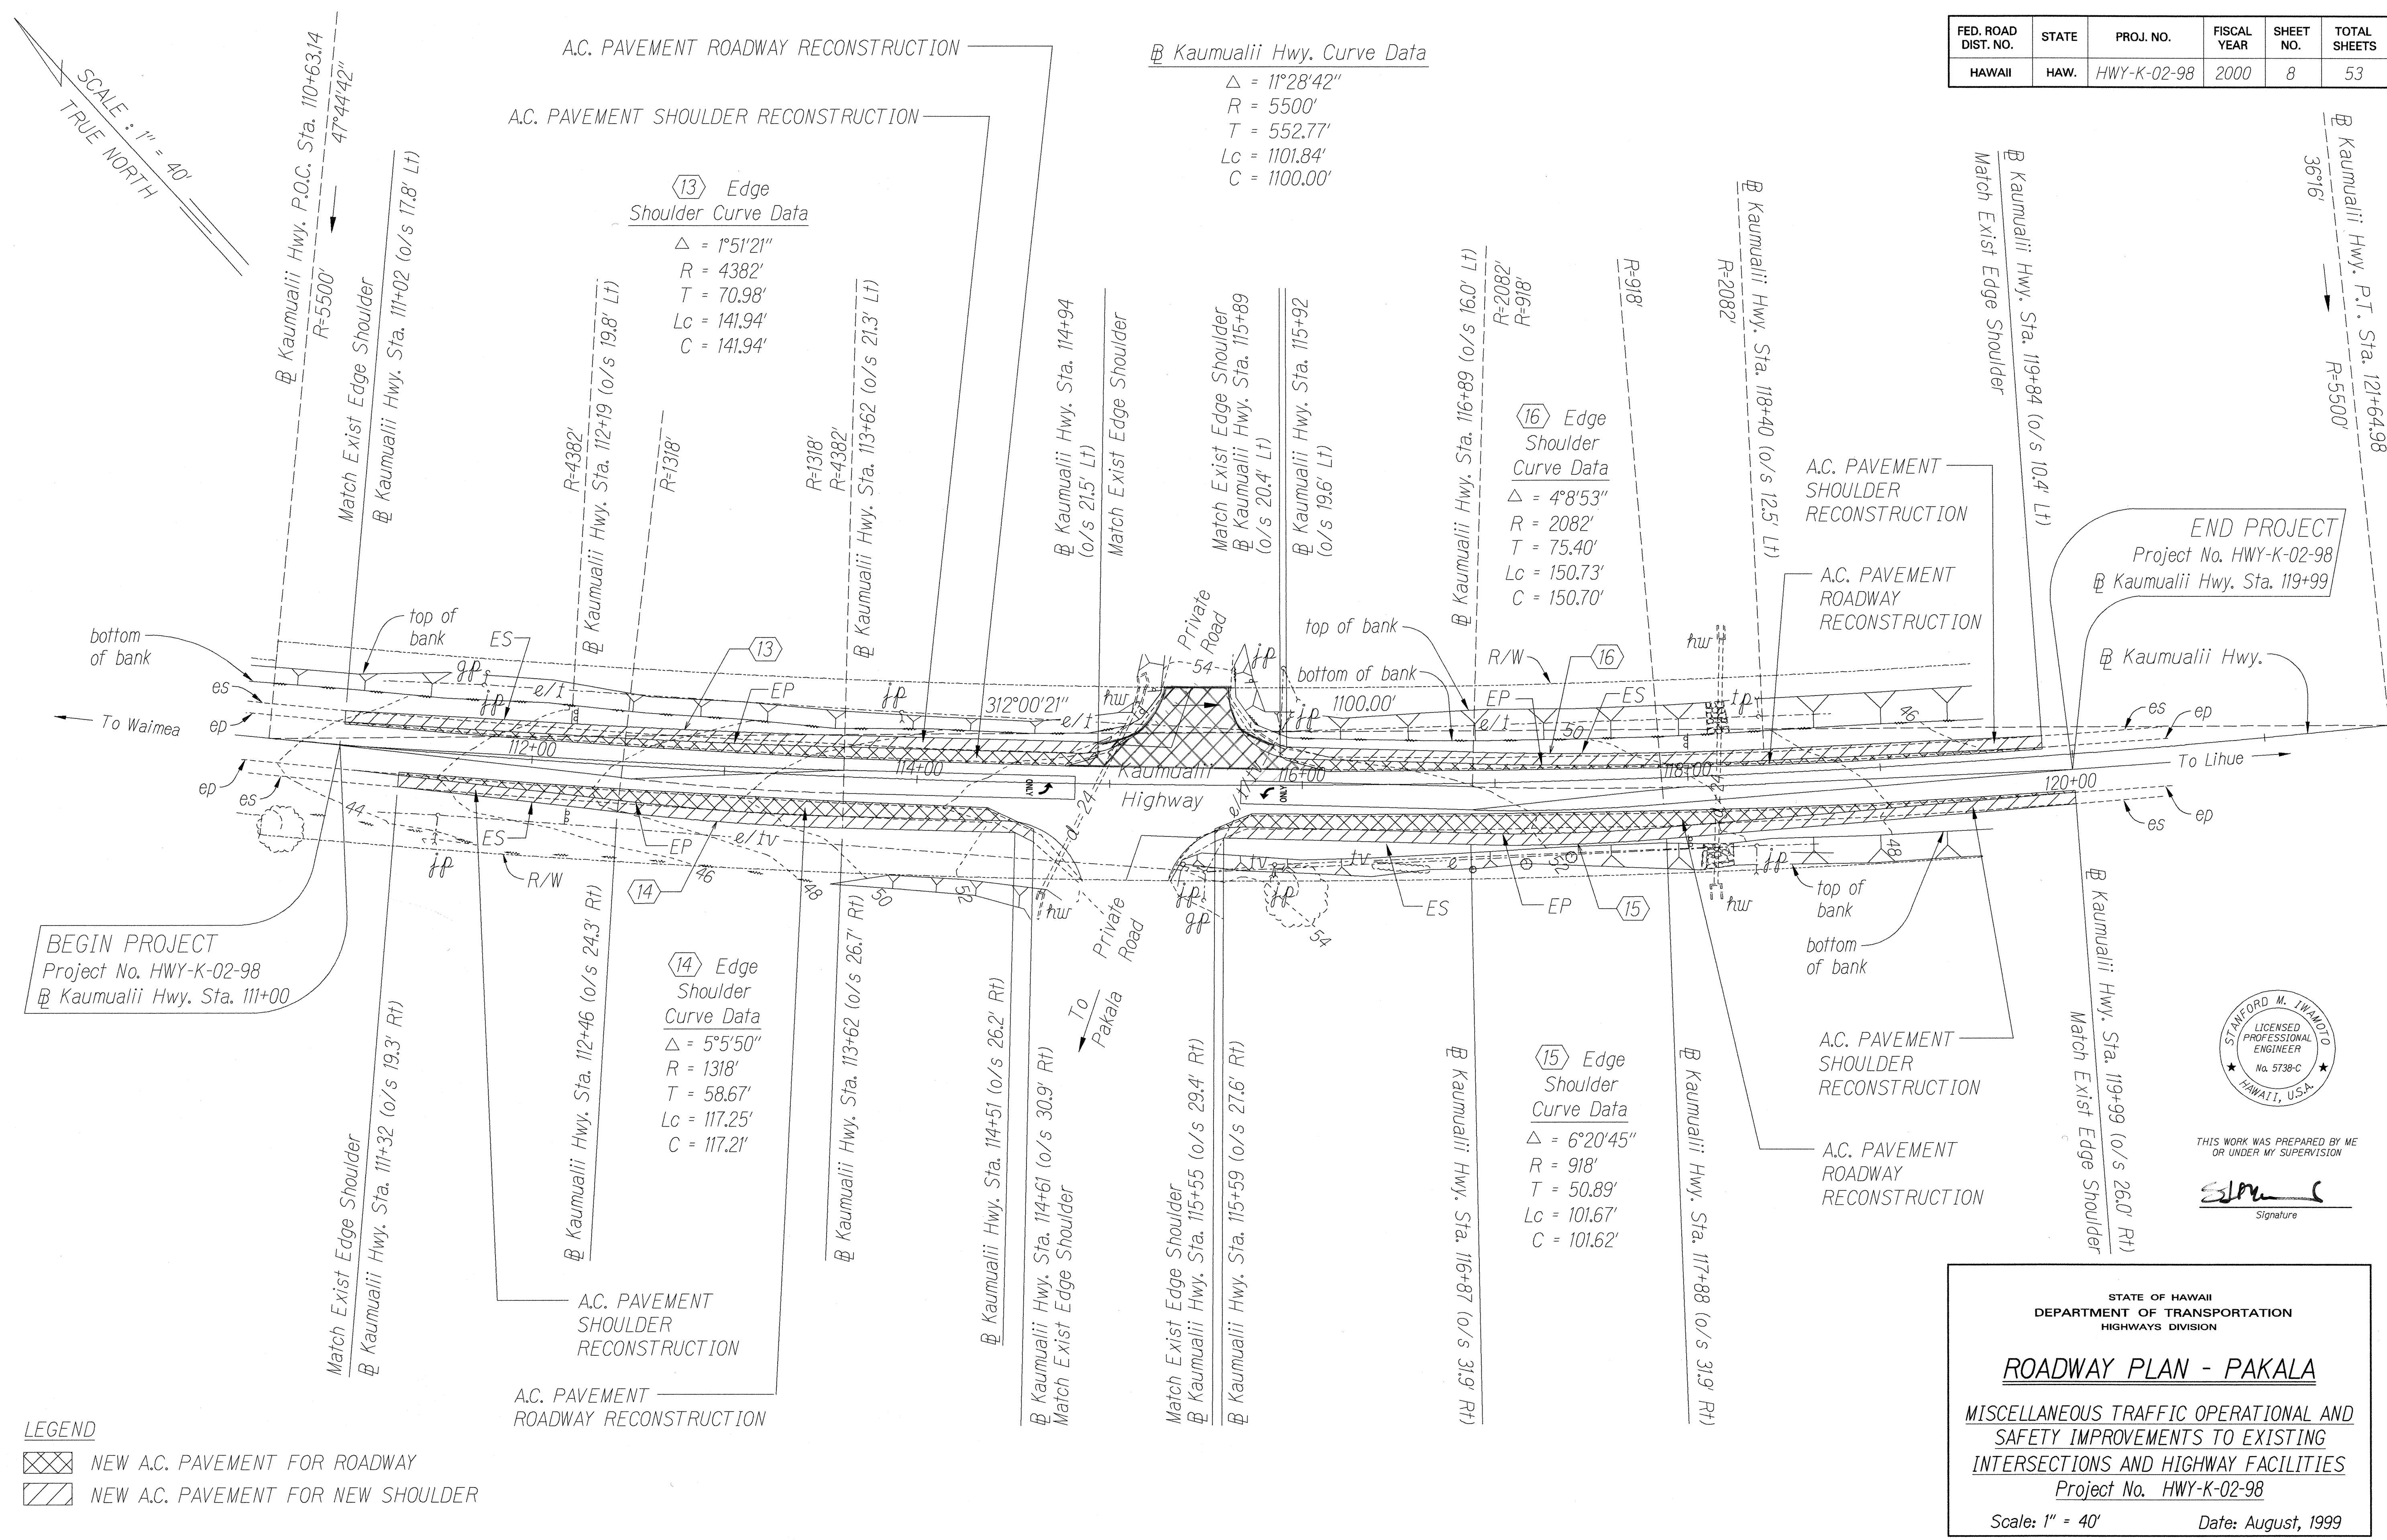

ORIGINAL PLAN	DATE
DESIGNED BY	DATE
CHECKED BY	DATE
NOTED BY	DATE
QUANTITIES BY	DATE
DATE	DATE

LEGEND

NEW A.C. PAVEMENT FOR ROADWAY

NEW A.C. PAVEMENT FOR NEW SHOULDER

STATE OF HAWAII
DEPARTMENT OF TRANSPORTATION
HIGHWAYS DIVISION

ROADWAY PLAN - PAKALA

MISCELLANEOUS TRAFFIC OPERATIONAL AND SAFETY IMPROVEMENTS TO EXISTING INTERSECTIONS AND HIGHWAY FACILITIES

Project No. HWY-K-02-98

Scale: 1" = 40' Date: August, 1999

SHEET No. 1 OF 1 SHEETS

STANFORD M. IWAMOTO
LICENSED PROFESSIONAL ENGINEER
No. 5739-C
HAWAII, U.S.A.

THIS WORK WAS PREPARED BY ME OR UNDER MY SUPERVISION

Stanford M. Iwamoto
Signature

"AS-BUILT"