



FED. ROAD DIST. NO.	STATE	PROJ. NO.	FISCAL YEAR	SHEET NO.	TOTAL SHEETS
HAWAII	HAW.	HWY-K-02-98	2000	19	53

CURVE DATA		
	①	②
Δ	41°59'23"	45°34'23"
R	40'	40'
T	15.35'	16.80'
Lc	29.31'	31.82'
C	28.66'	30.98'

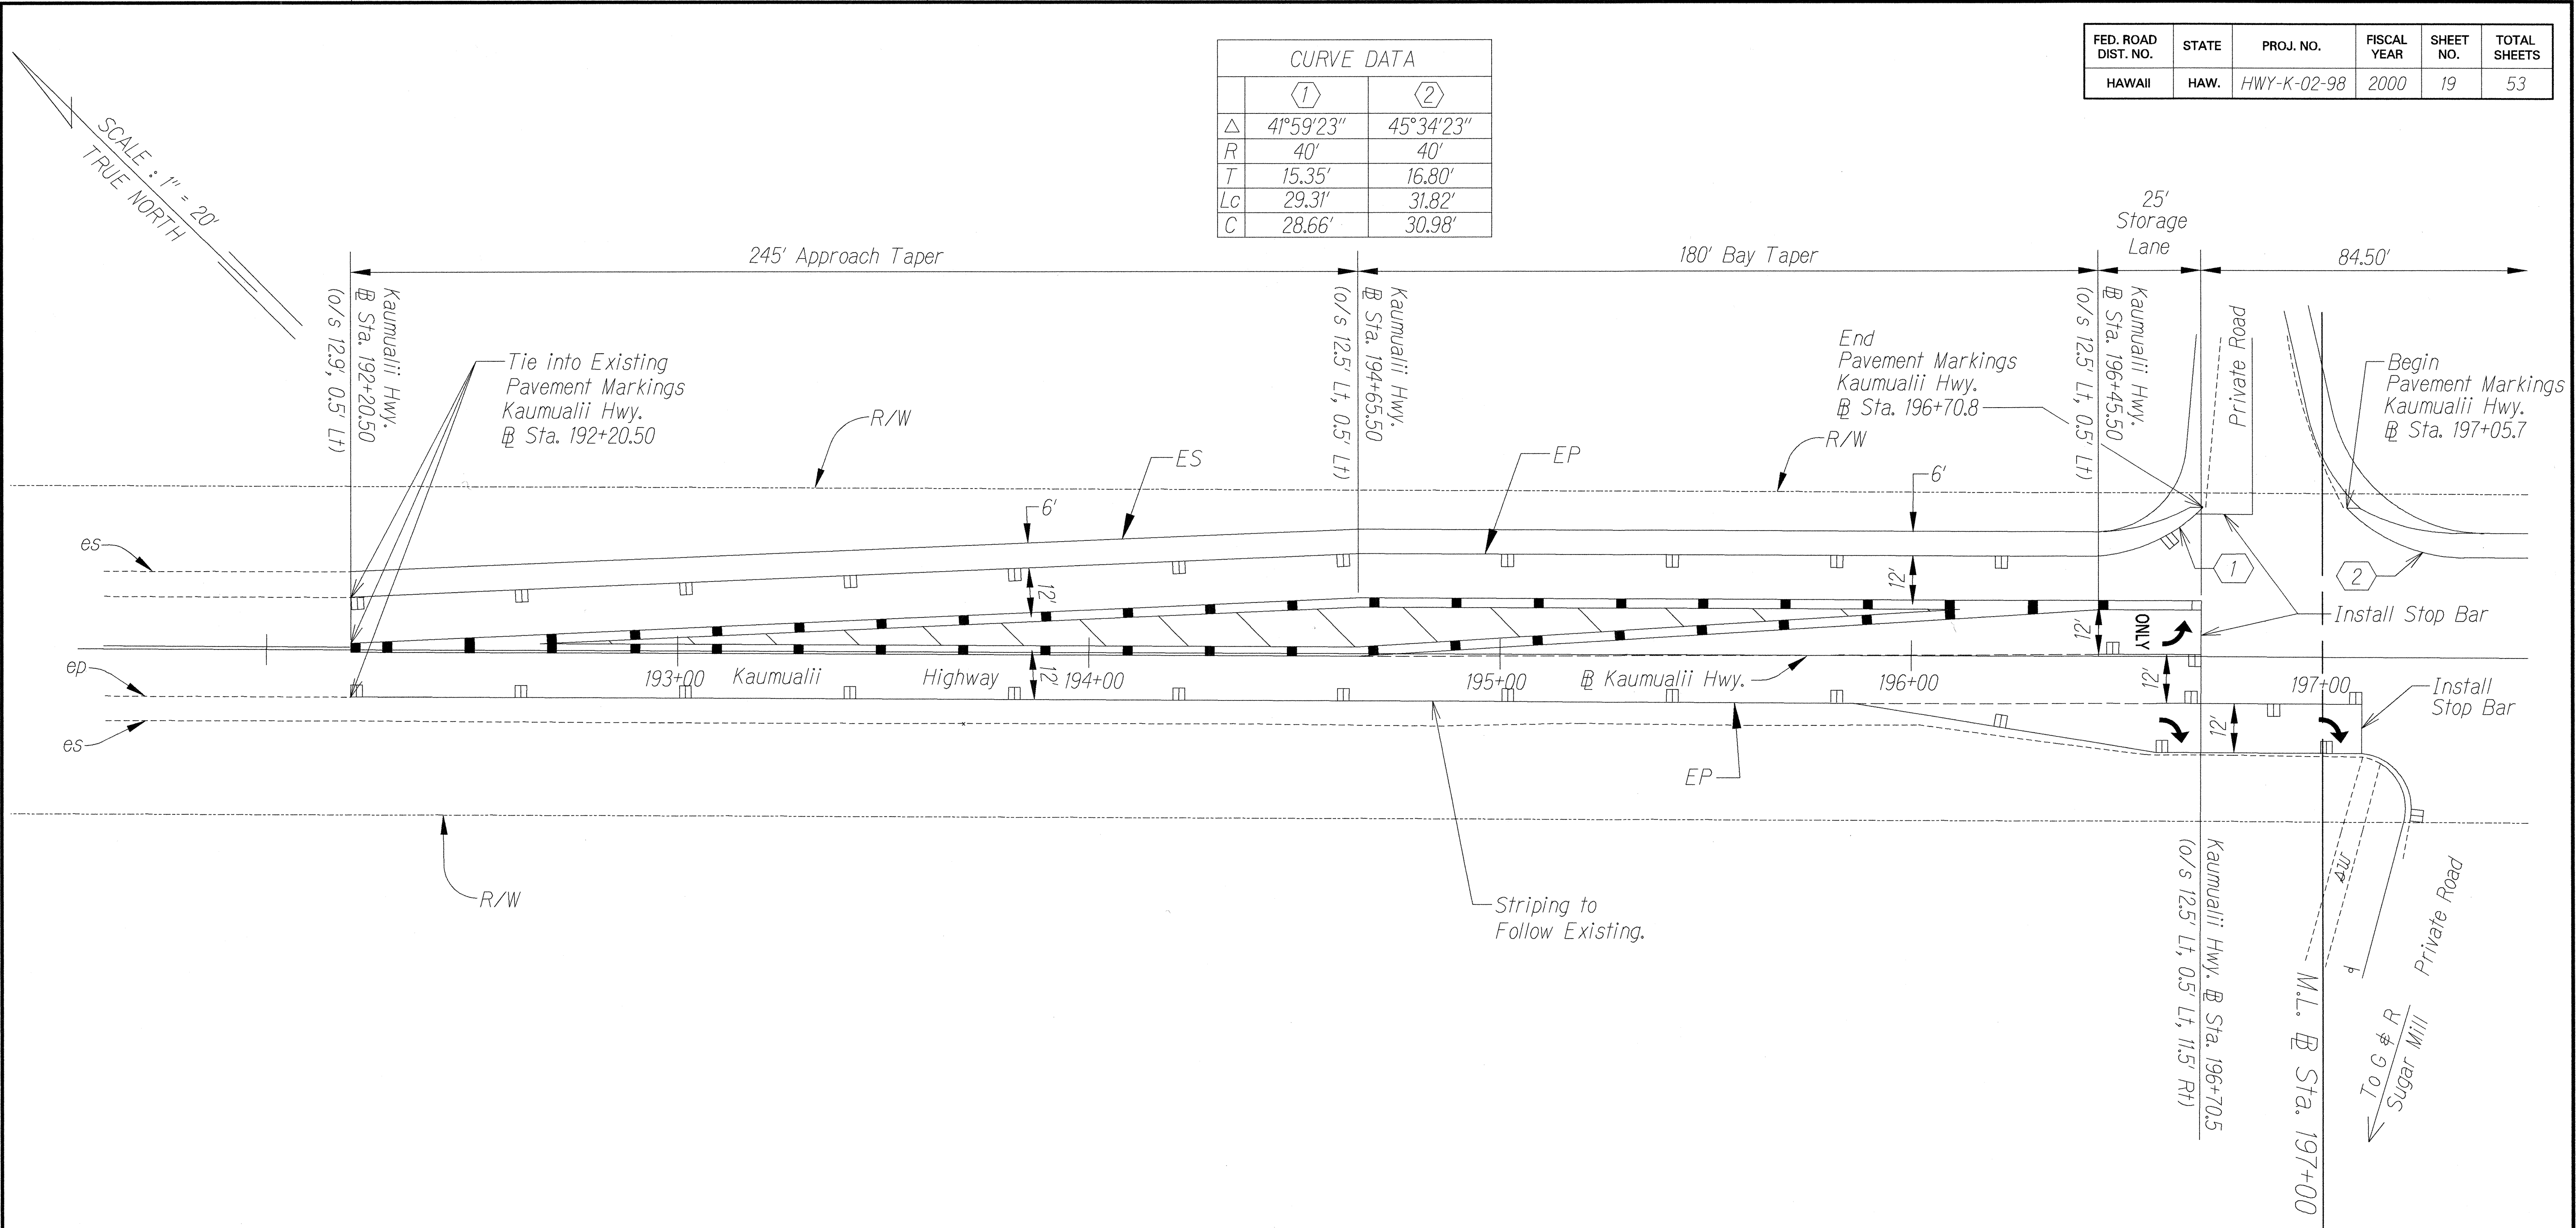

- NOTES:
- Existing pavement markers and striping between Sta. 192+20.50 and Sta. 202+85.50 Kaumualii Highway shall be removed and re-striped as defined on the Striping Plan. Removal of existing pavement markers and striping shall be considered incidental to the installation of the new pavement markers and striping.

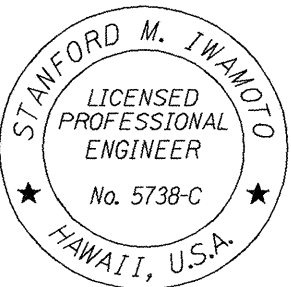

THIS WORK WAS PREPARED BY ME
OR UNDER MY SUPERVISION

Stanford M. Iwamoto
Signature

STATE OF HAWAII
DEPARTMENT OF TRANSPORTATION
HIGHWAYS DIVISION

STRIPING PLAN - MAKAWELI
KAUMUALII HWY.
@ STA. 192+20.50 TO @ STA. 197+00

MISCELLANEOUS TRAFFIC OPERATIONAL AND
SAFETY IMPROVEMENTS TO EXISTING
INTERSECTIONS AND HIGHWAY FACILITIES
Project No. HWY-K-02-98

Scale: 1" = 20' Date: August, 1999

SHEET No. 1 OF 2 SHEETS

SURVEY PLOTTED BY	DATE
DRAWN BY	DATE
DESIGNED BY	DATE
CHECKED BY	DATE
NOTE BOOK	DATE
NO.	DATE

