



FED. ROAD DIST. NO.	STATE	FED. AID PROJ. NO.	FISCAL YEAR	SHEET NO.	TOTAL SHEETS
HAWAII	HAW.	STP-050-1(17)	2000	43	72

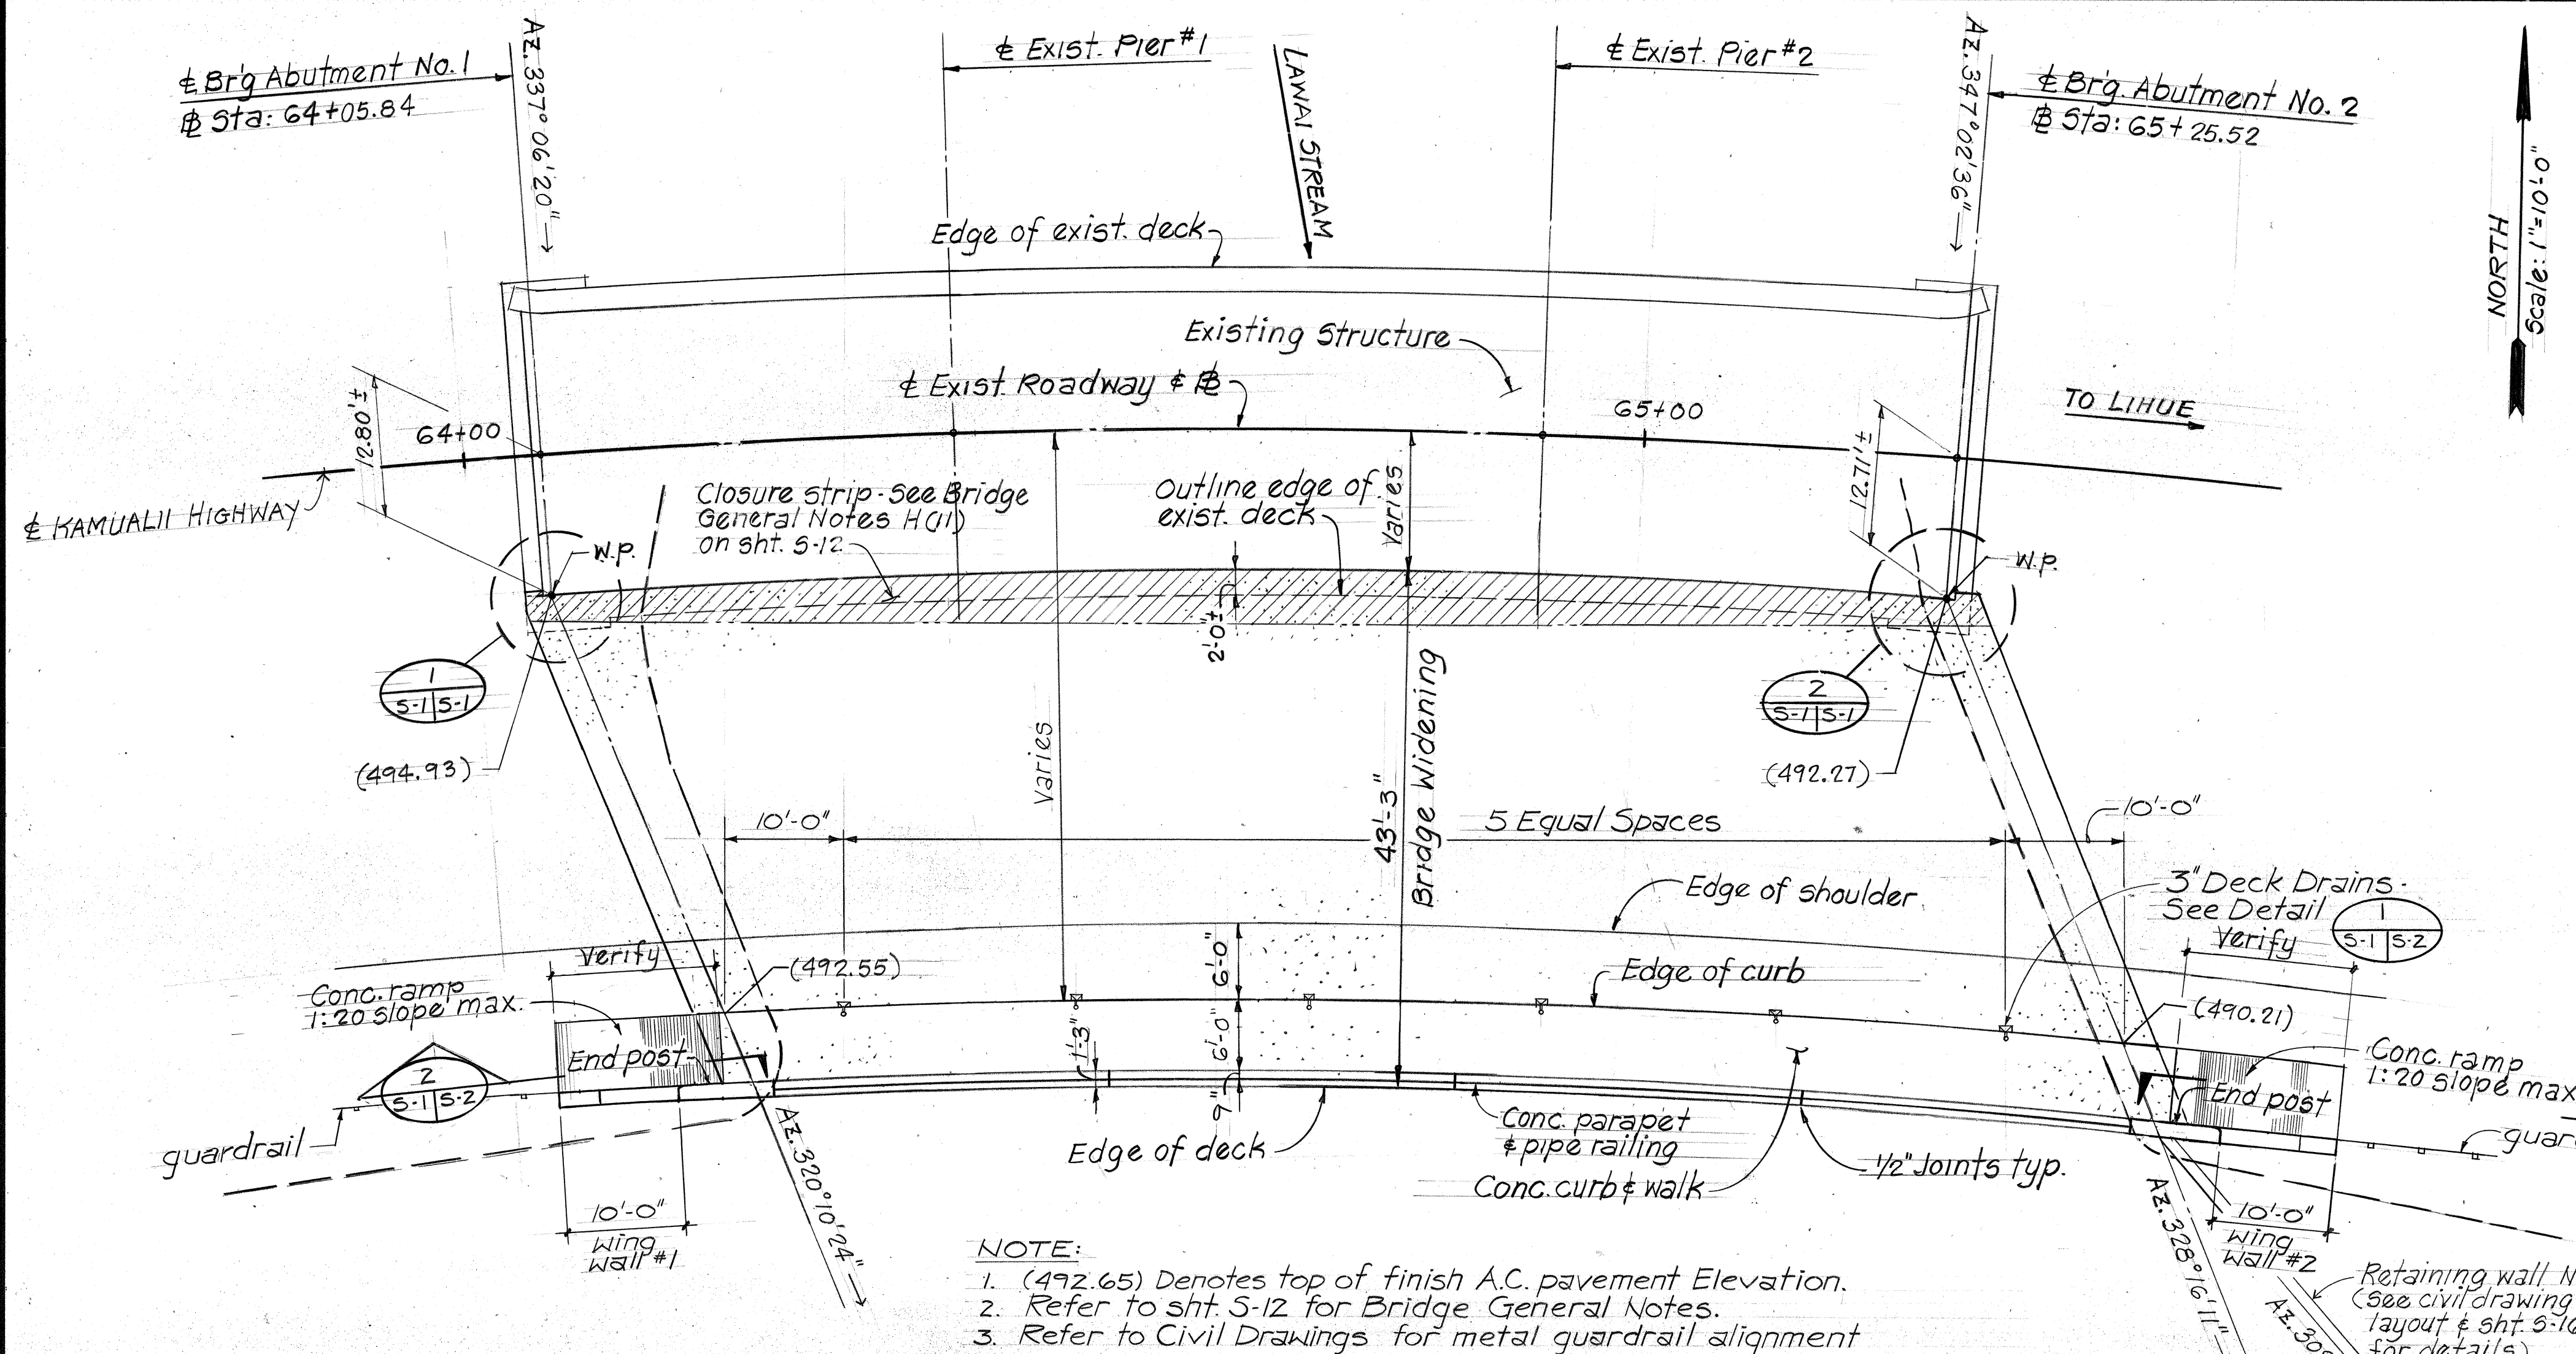


- NOTE:
- (492.65) Denotes top of finish A.C. pavement Elevation.
  - Refer to sht. S-12 for Bridge General Notes.
  - Refer to Civil Drawings for metal guardrail alignment


**BRIDGE WIDENING LAYOUT PLAN**  
Scale: 1"=10'-0"

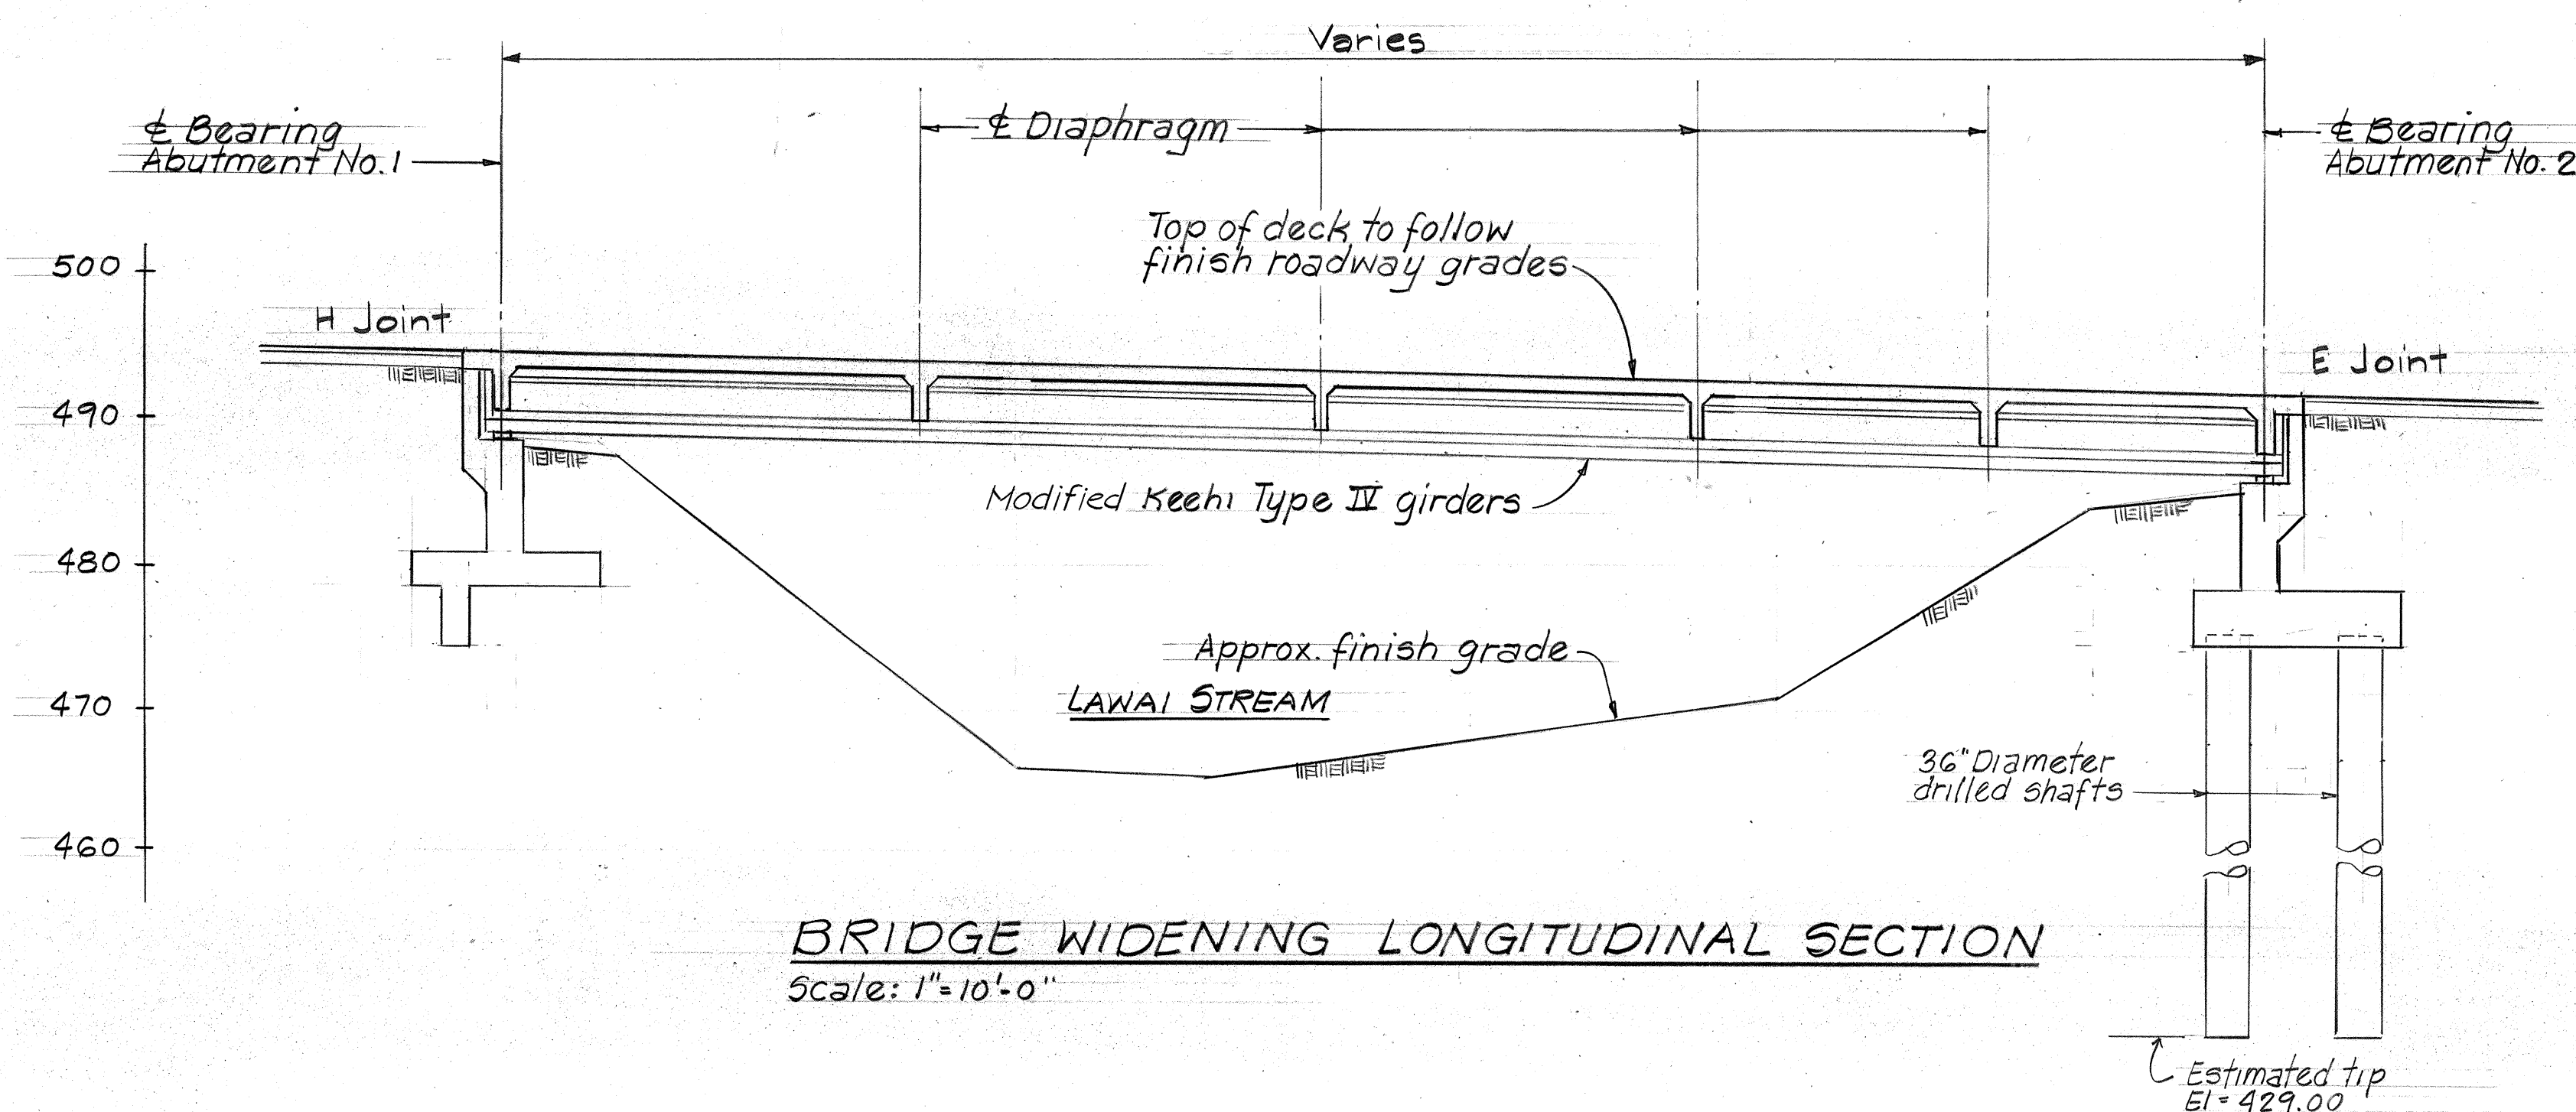

**BRIDGE WIDENING LONGITUDINAL SECTION**  
Scale: 1"=10'-0"

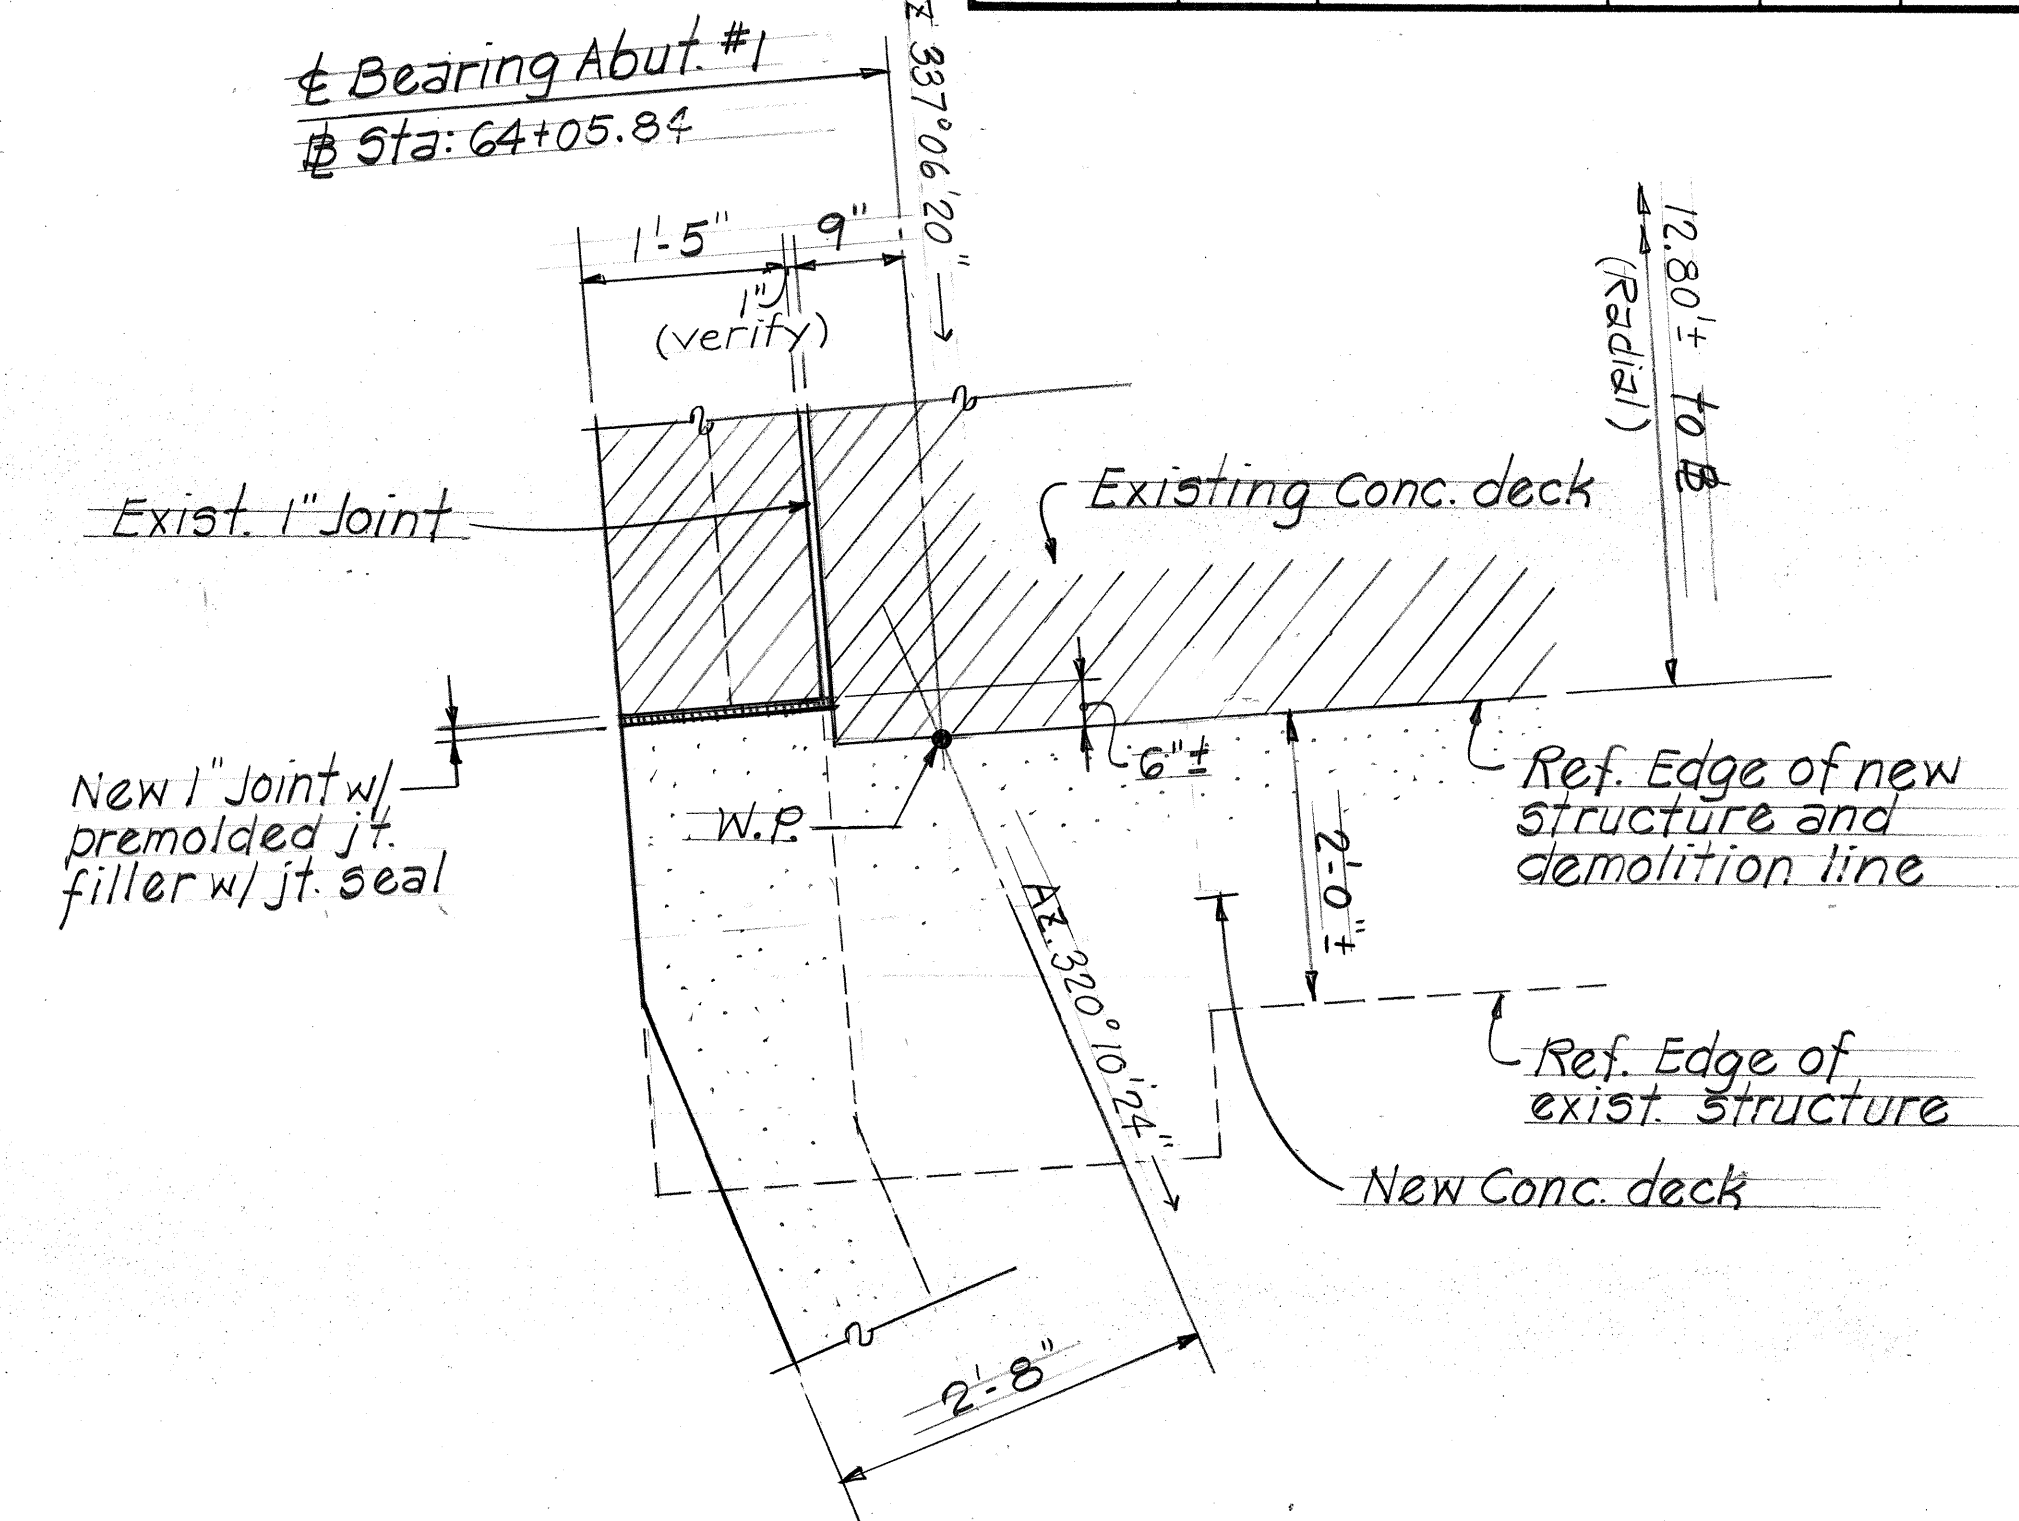


**1 DETAIL PLAN**  
Scale: 3/4"=1'-0"

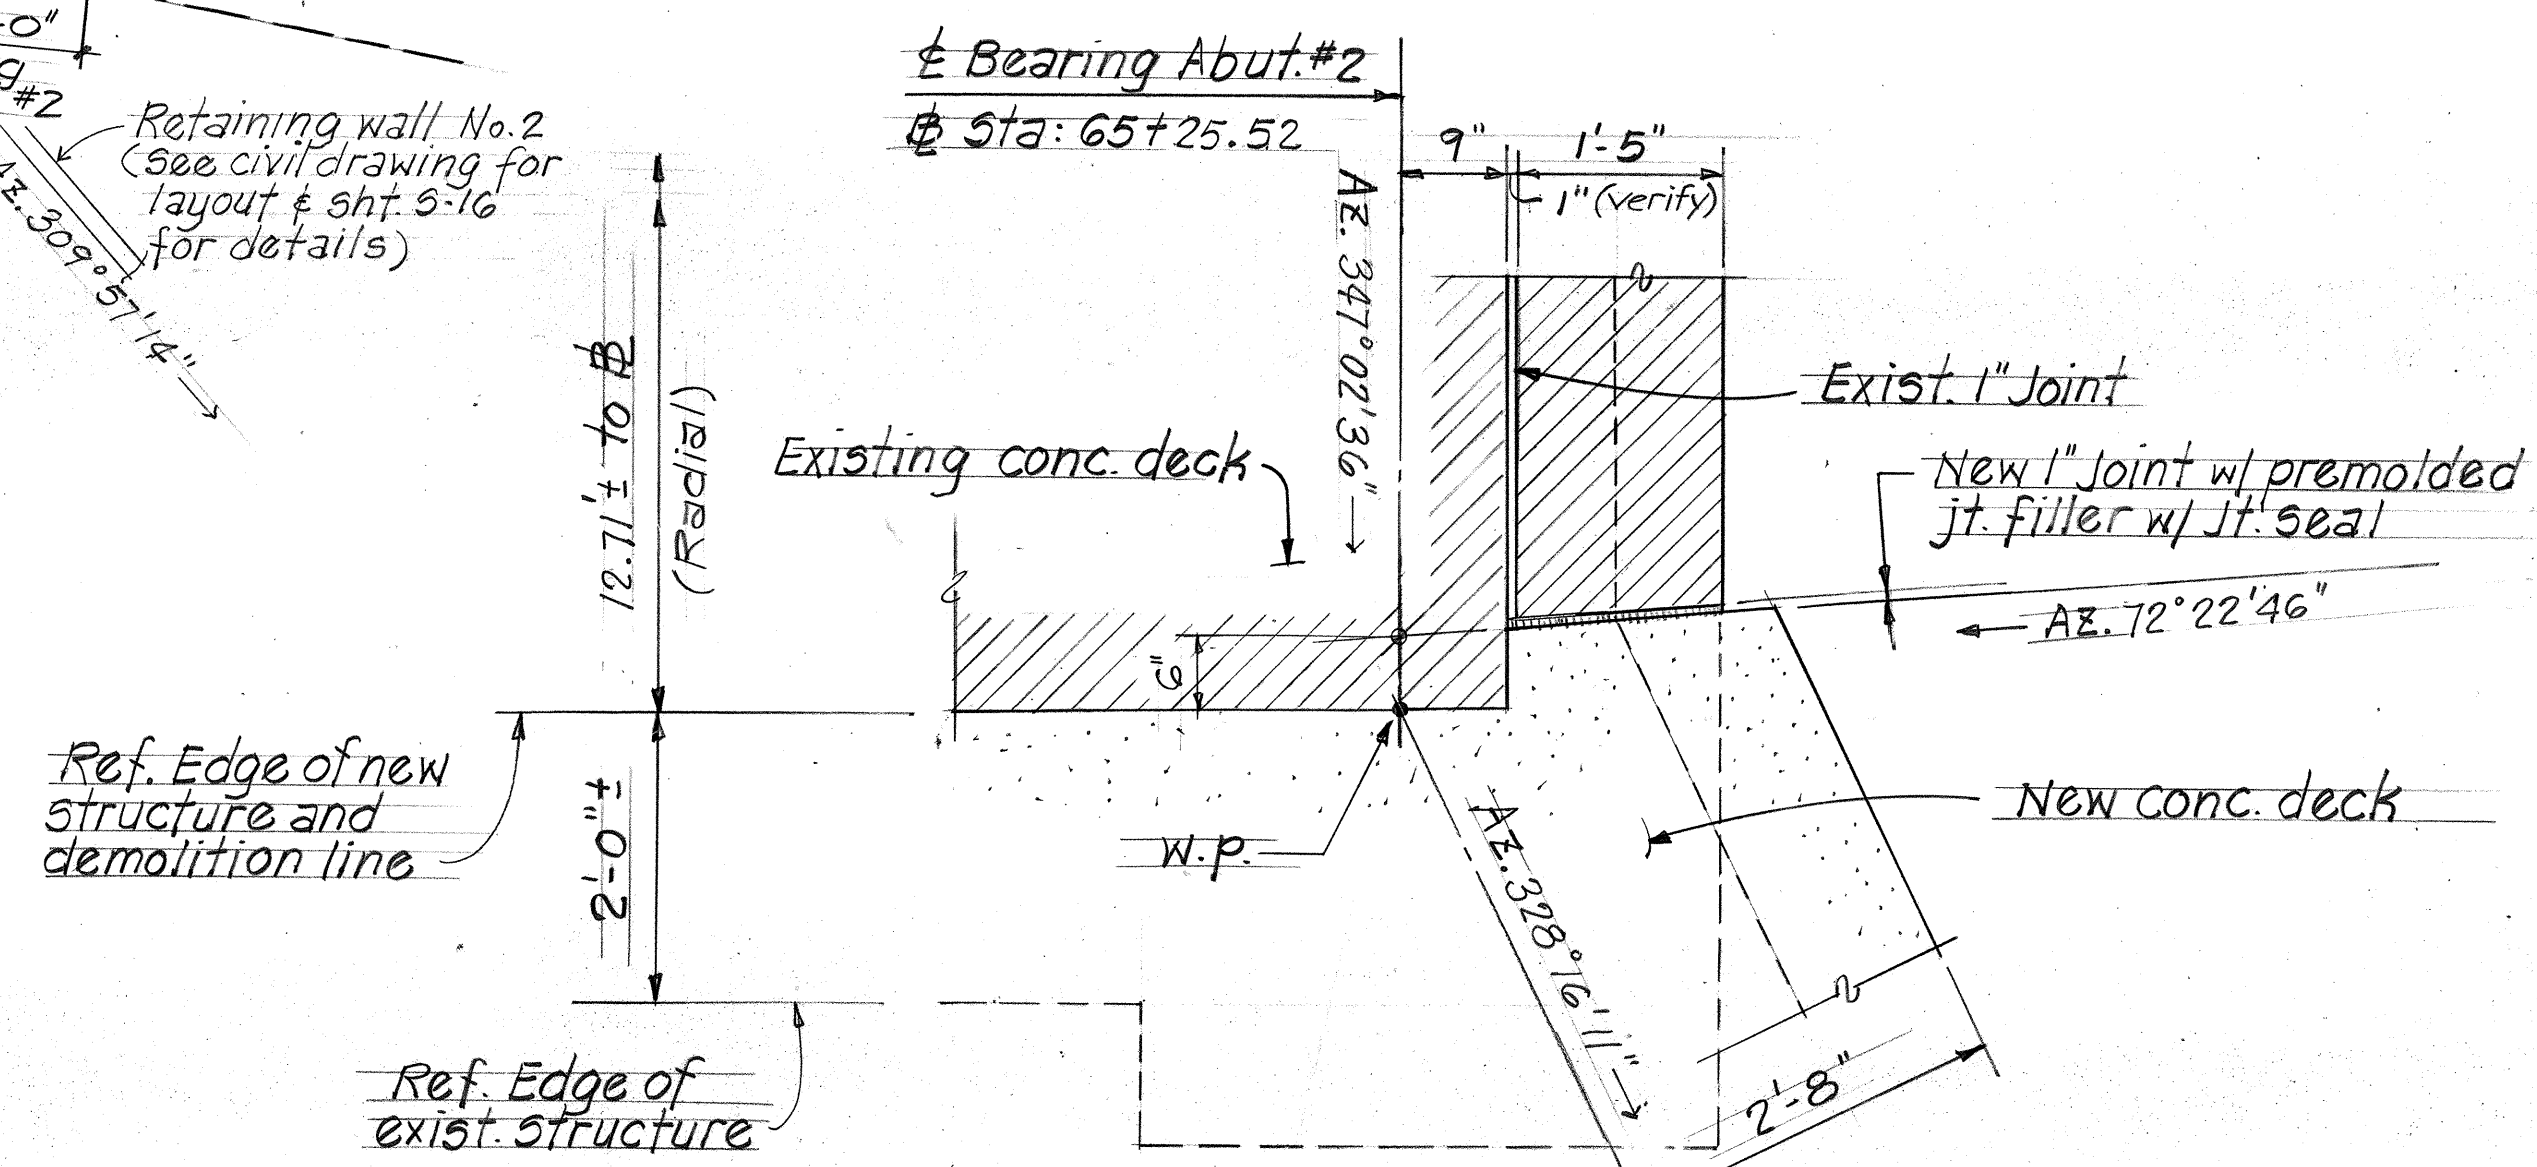

**2 DETAIL PLAN**  
Scale: 3/4"=1'-0"

DATE	
SURVEY PLOTTED BY	
DRAWN BY	
DESIGNED BY	
QUANTITIES BY	
CHECKED BY	
NO.	

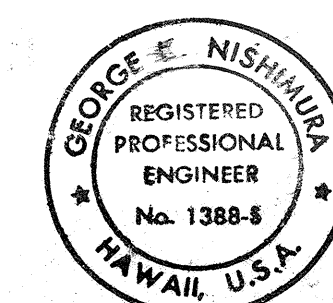

THIS WORK WAS PREPARED BY  
ME OR UNDER MY SUPERVISION.  
*[Signature]*


6/5/02	Revise Abutment Footings on Longitudinal Section
5/29/02	Revise Bridge Deck Elevations
Date	Revision

#30/02 Revise Bridge azimuths, dimensions, stations, and deck elevations.  
Date Revision

STATE OF HAWAII  
DEPARTMENT OF TRANSPORTATION  
HIGHWAYS DIVISION  
**BRIDGE LAYOUT PLAN  
LONGITUDINAL SECTION  
AND DETAIL PLANS**

KAUMUALII HIGHWAY INTERSECTION  
IMPROVEMENTS AT KOLOA ROAD  
FEDERAL AID PROJ. NO. STP-050-1(17)  
SCALE: AS NOTED DATE: OCT. 8, 1999  
**SHEET No. 5-1 OF 17 SHEETS**

FED. ROAD DIST. NO.	STATE	FED. AID PROJ. NO.	FISCAL YEAR	SHEET NO.	TOTAL SHEETS
HAWAII	HAW.	STP-050-1(17)	2000	44	72



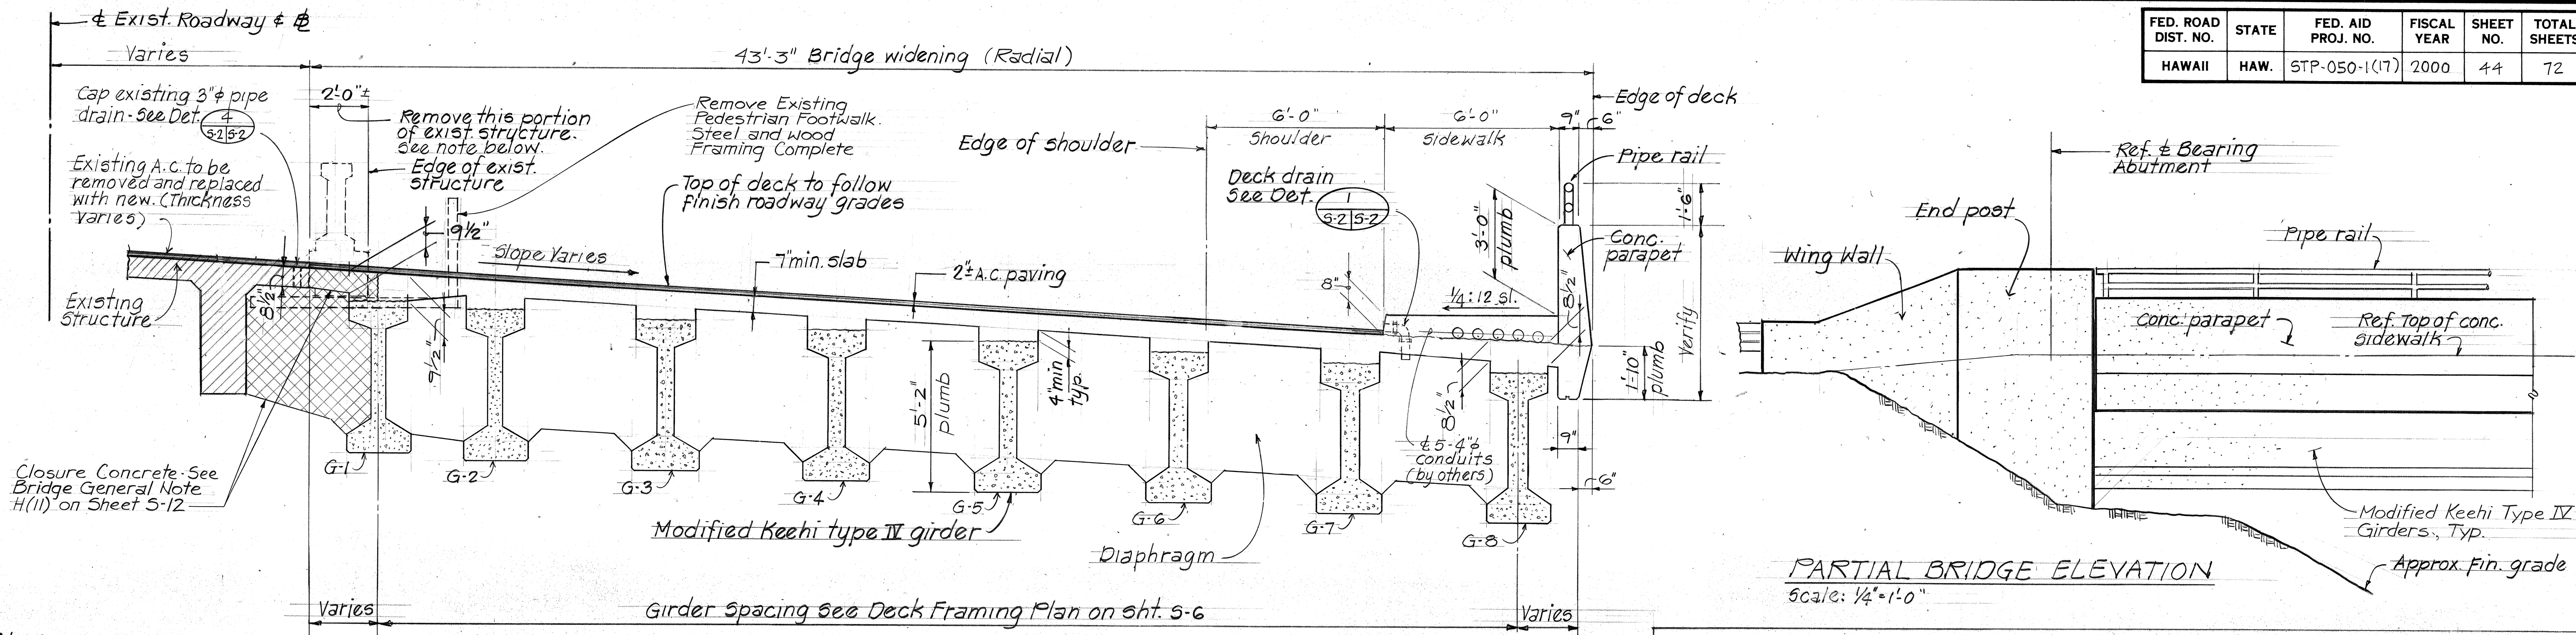


**NOTE:**  
Existing bridge railing section shall not be removed until the contractor is ready for closure concrete phase. Only portions of existing concrete may be removed to allow installation of girder "G-1".


### NORMAL SECTION @ BRIDGE WIDENING

Scale: 3/8"=1'-0"

ESTIMATED QUANTITIES			
ITEM NO.	CONTRACT ITEMS (STRUCTURAL ITEMS ONLY).	QUANTITIES	UNITS
202.0200	Removal of portion of existing conc. structure.	(50)	(C.Y.) L.S.
202.0440	Removal of existing wooden walkway and railing.	(450)	(S.F.) L.S.
206.6000	Structure excavation for bridge abutments, wingwalls, and retaining walls.	2,100	C.Y.
206.7000	Structural backfill for bridge abutments, wingwalls, and retaining walls.	1,350	C.Y.
206.8200	Filter material.	195	C.Y.
503.1090	Concrete in bridge, abutments, wingwalls, and retaining walls, excluding footings.	505	(C.Y.) L.S.
503.1093	Concrete in abutments, wingwalls, and retaining walls footings.	380	(C.Y.) L.S.
504.4501	Type IV (Modified Keehi) prestressed concrete girders.	950	(L.F.) L.S.
507.1501	Metal railing on parapet.	115	L.F.
507.7001	Concrete parapet for bridge (including end post)	130	L.F.
511.0100	Drilled shaft - 36 inch diameter	469	L.F.
511.0200	Unclassified shaft excavation.	469	L.F.
511.0600	Furnishing drilled shaft drilling equipment.	(1)	(each) L.S.
602.0091	Reinforcing steel.	163,000	(lbs) L.S.

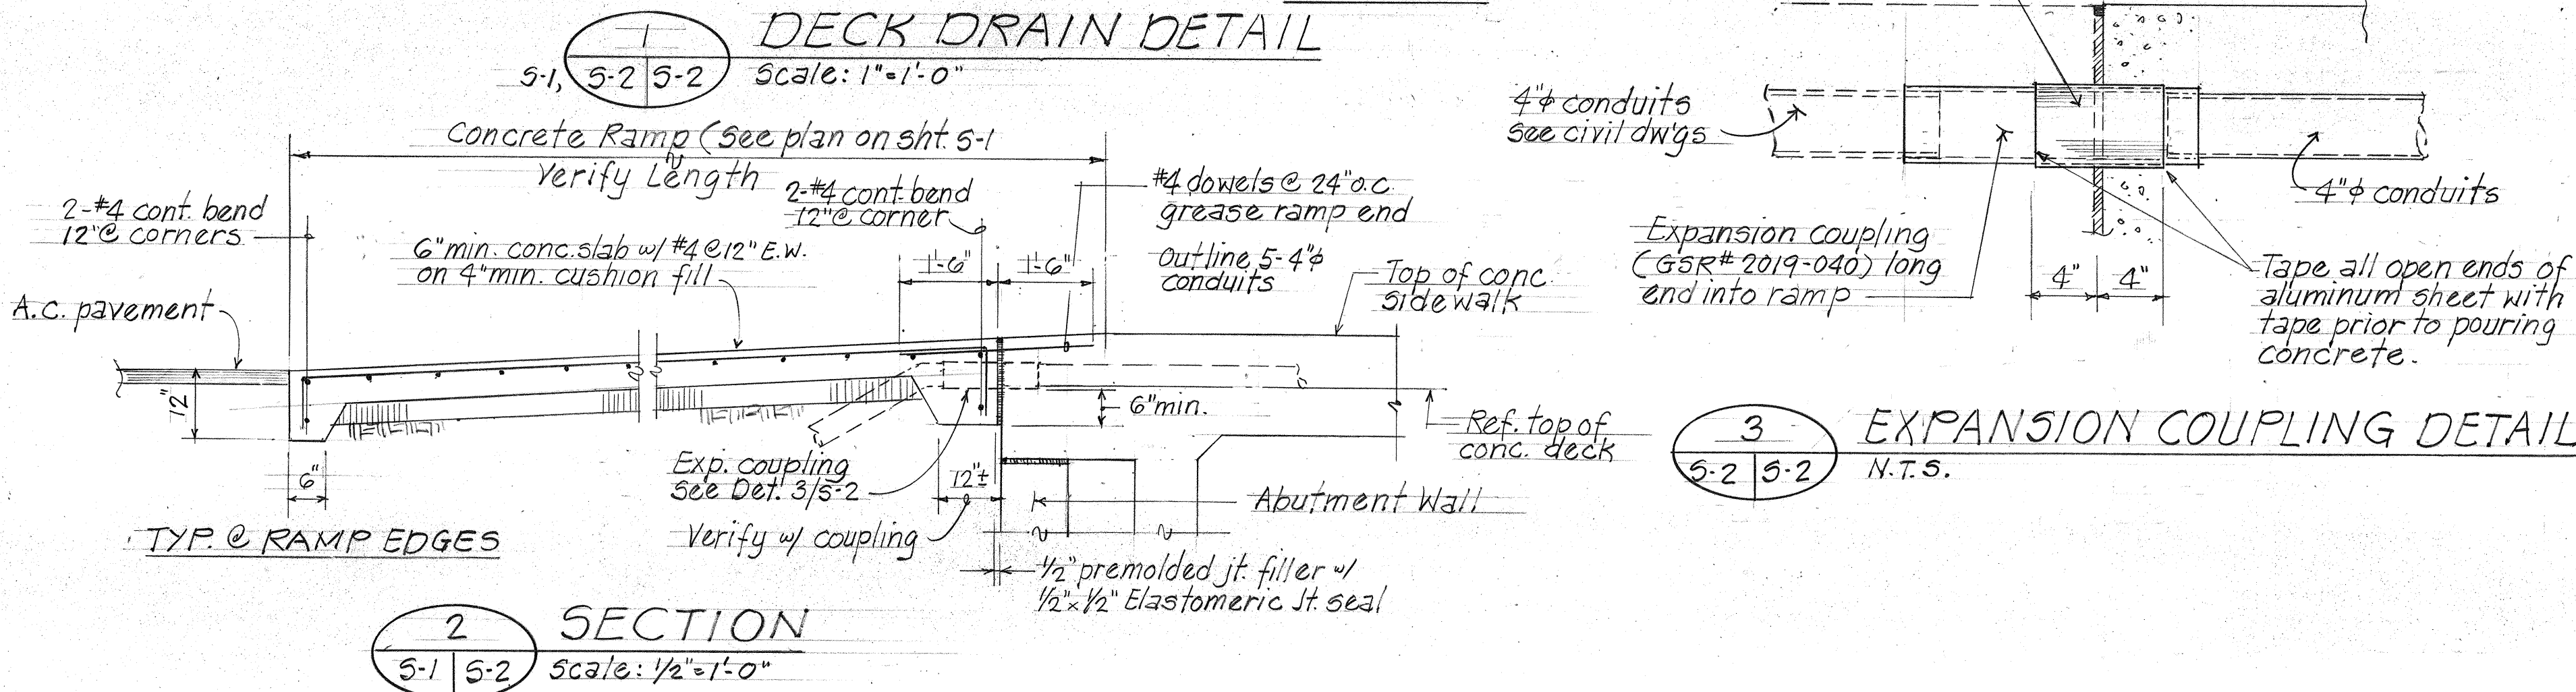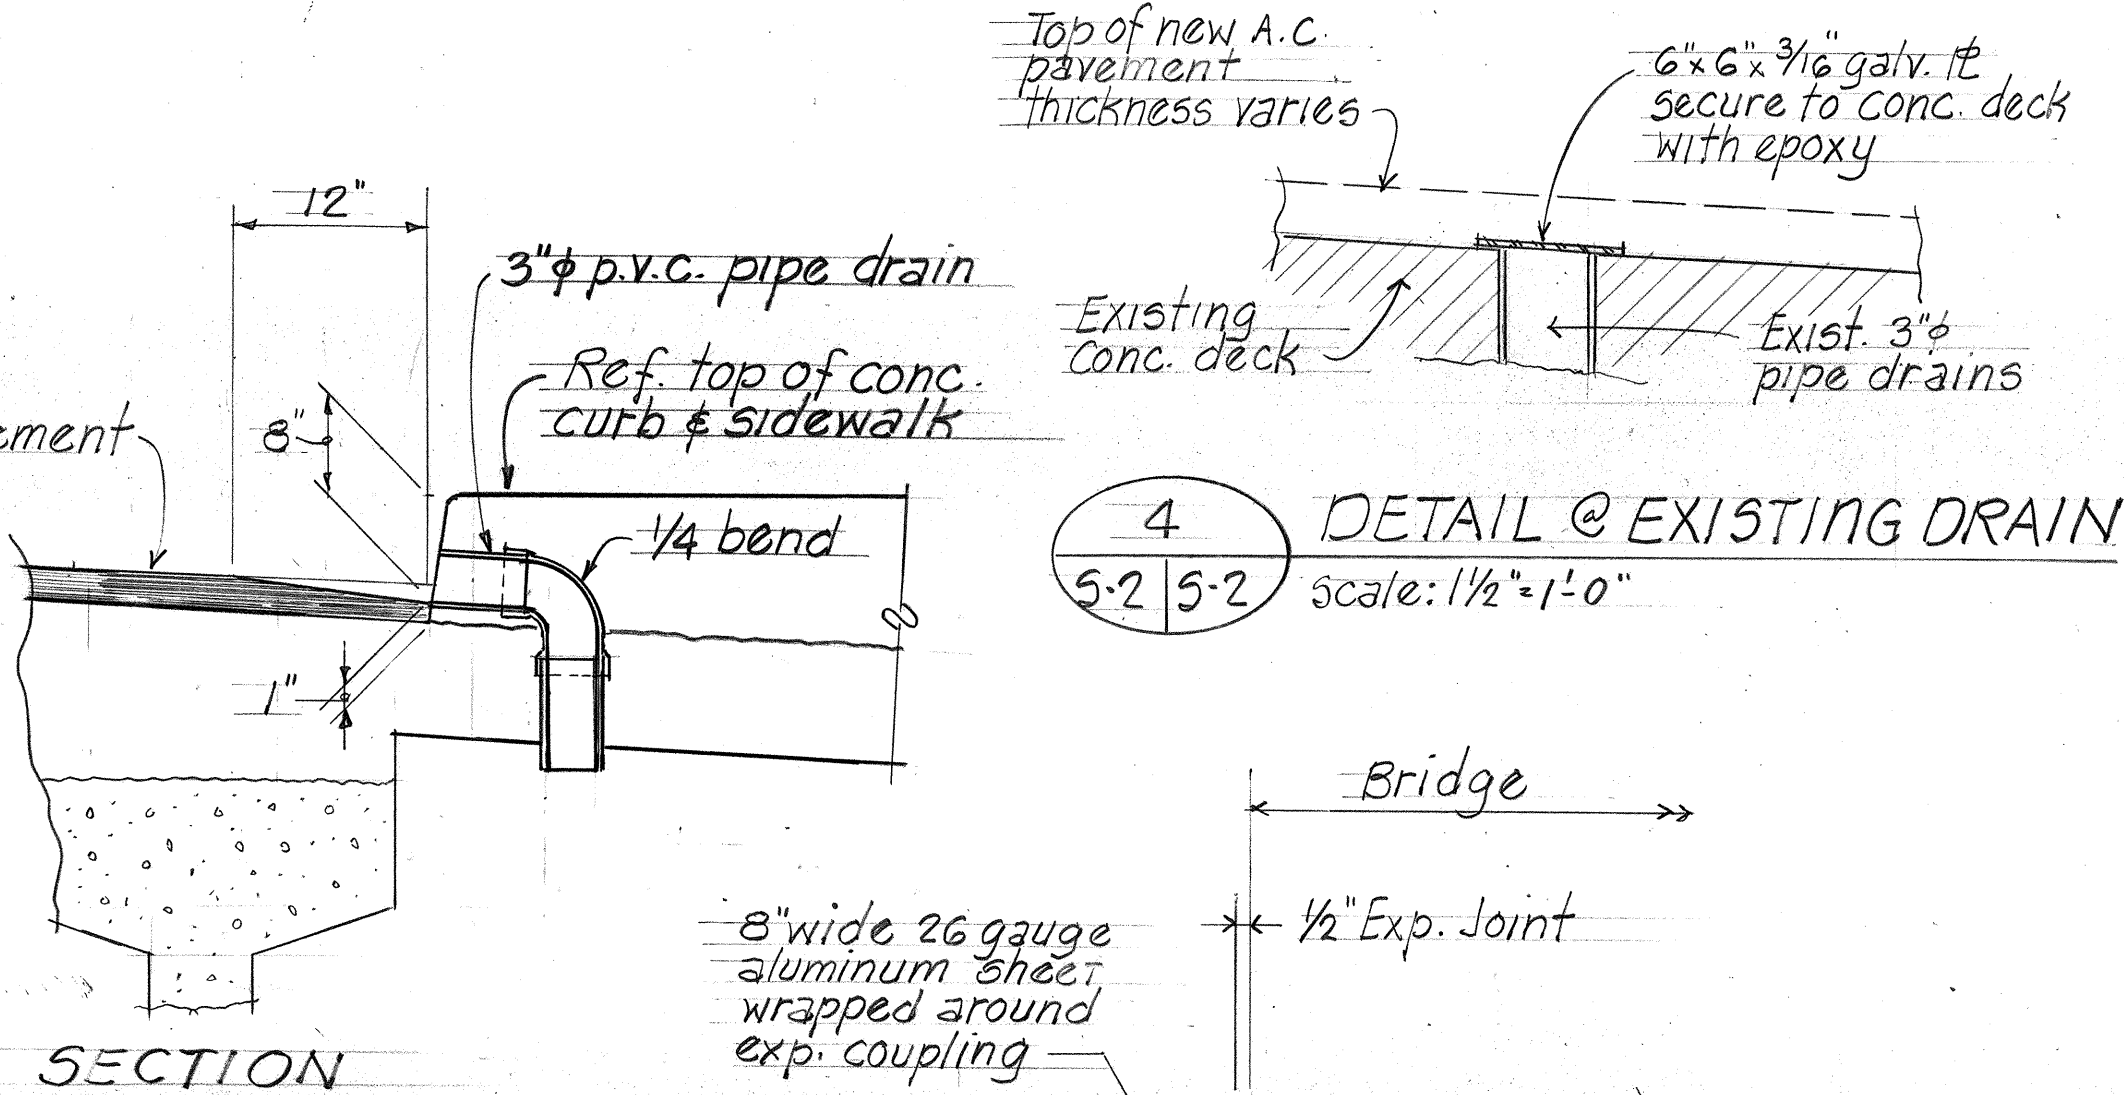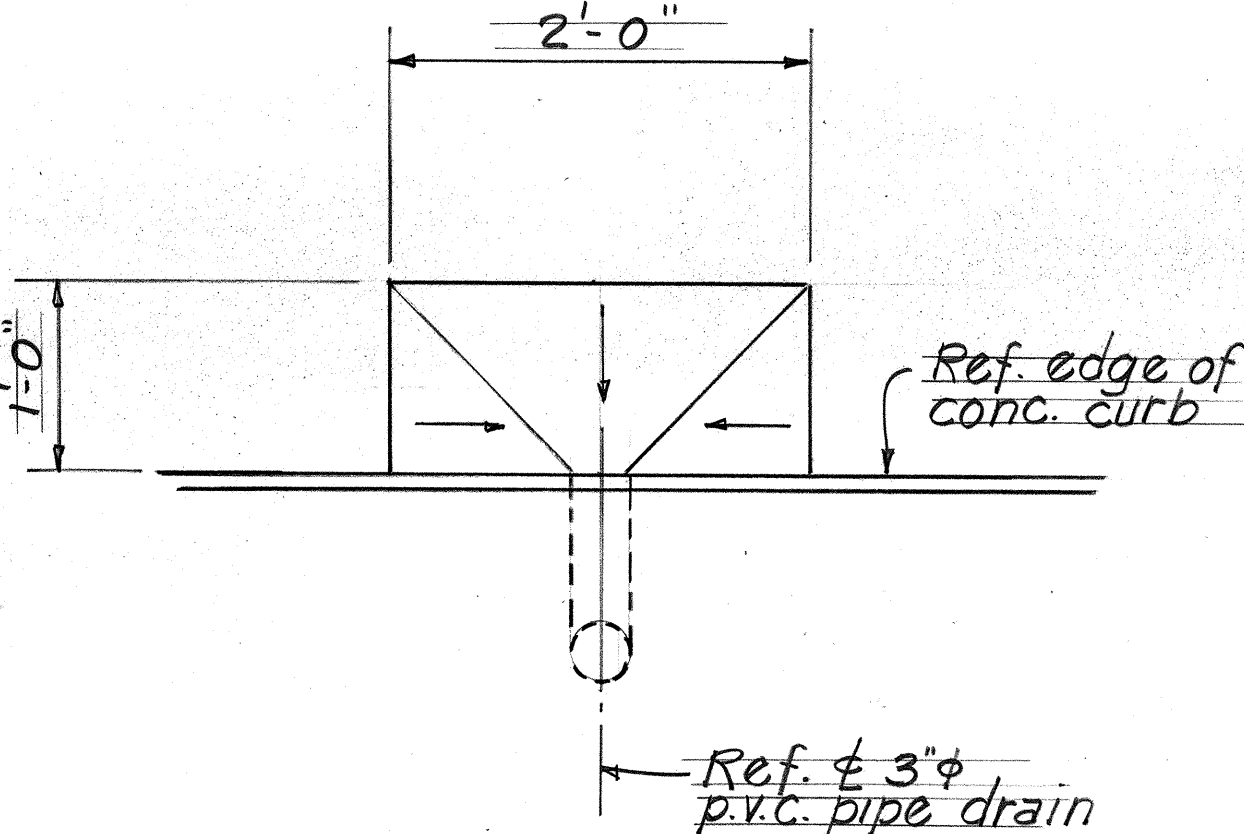

1/30/02	Revise dimensions, quantities and add conduits.
Date	Revision

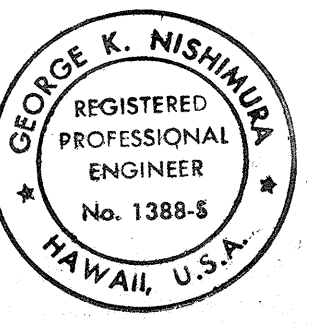

STATE OF HAWAII  
DEPARTMENT OF TRANSPORTATION  
HIGHWAYS DIVISION

**BRIDGE SECTION, PARTIAL ELEVATION & ESTIMATED QUANTITIES**

KAUMUALII HIGHWAY INTERSECTION  
IMPROVEMENTS AT KOLOA ROAD

FEDERAL AID PROJ. NO. STP-050-1(17)


SCALE: AS NOTED DATE: OCT. 8, 1999

**SHEET NO. 5-2 OF 17 SHEETS**

5/29/02	Add detail at existing deck drains, and note thickness varies for new A.C. over existing structure.
3/10/02	Revise 5-4" conduits to be by others & revise estimated quantities.
Date	Revision


THIS WORK WAS PREPARED BY  
ME OR UNDER MY SUPERVISION.  
*[Signature]*

FED. ROAD DIST. NO.	STATE	FED. AID PROJ. NO.	FISCAL YEAR	SHEET NO.	TOTAL SHEETS
HAWAII	HAW.	STP-050-1(17)	2000	45	72

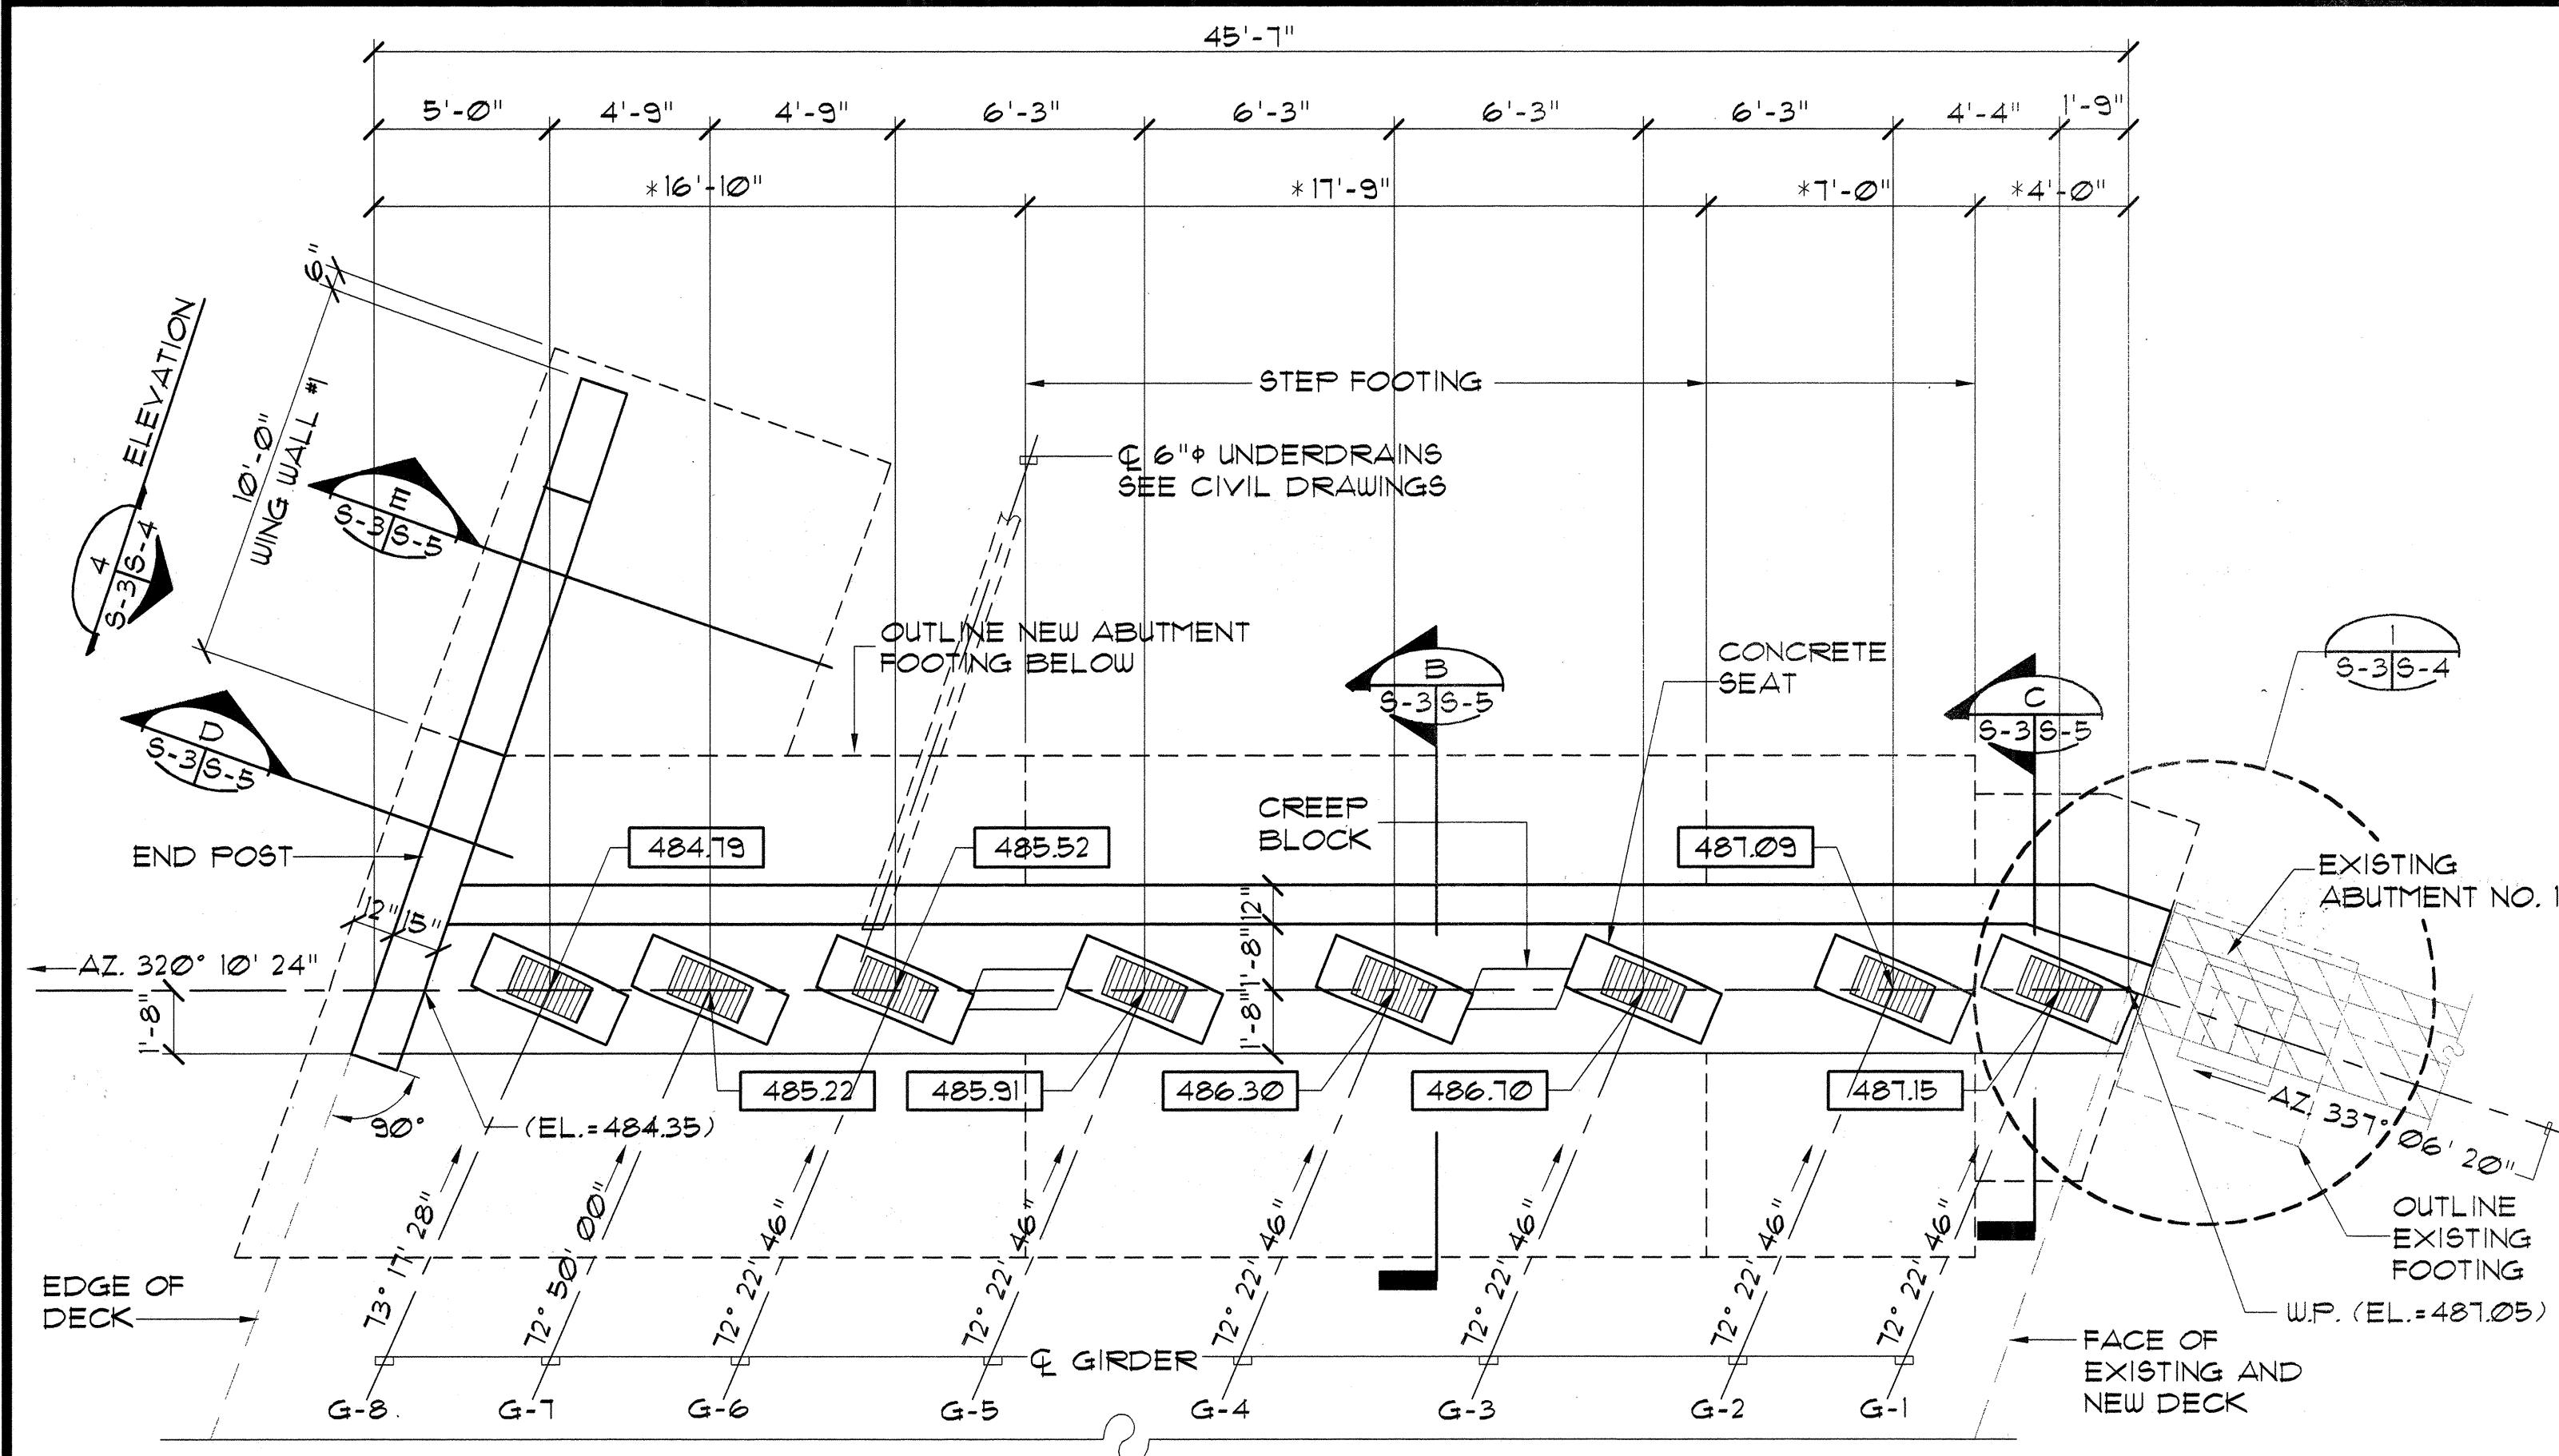

### ABUTMENT NO. 1 PLAN

SCALE: 1/4"=1'-0"

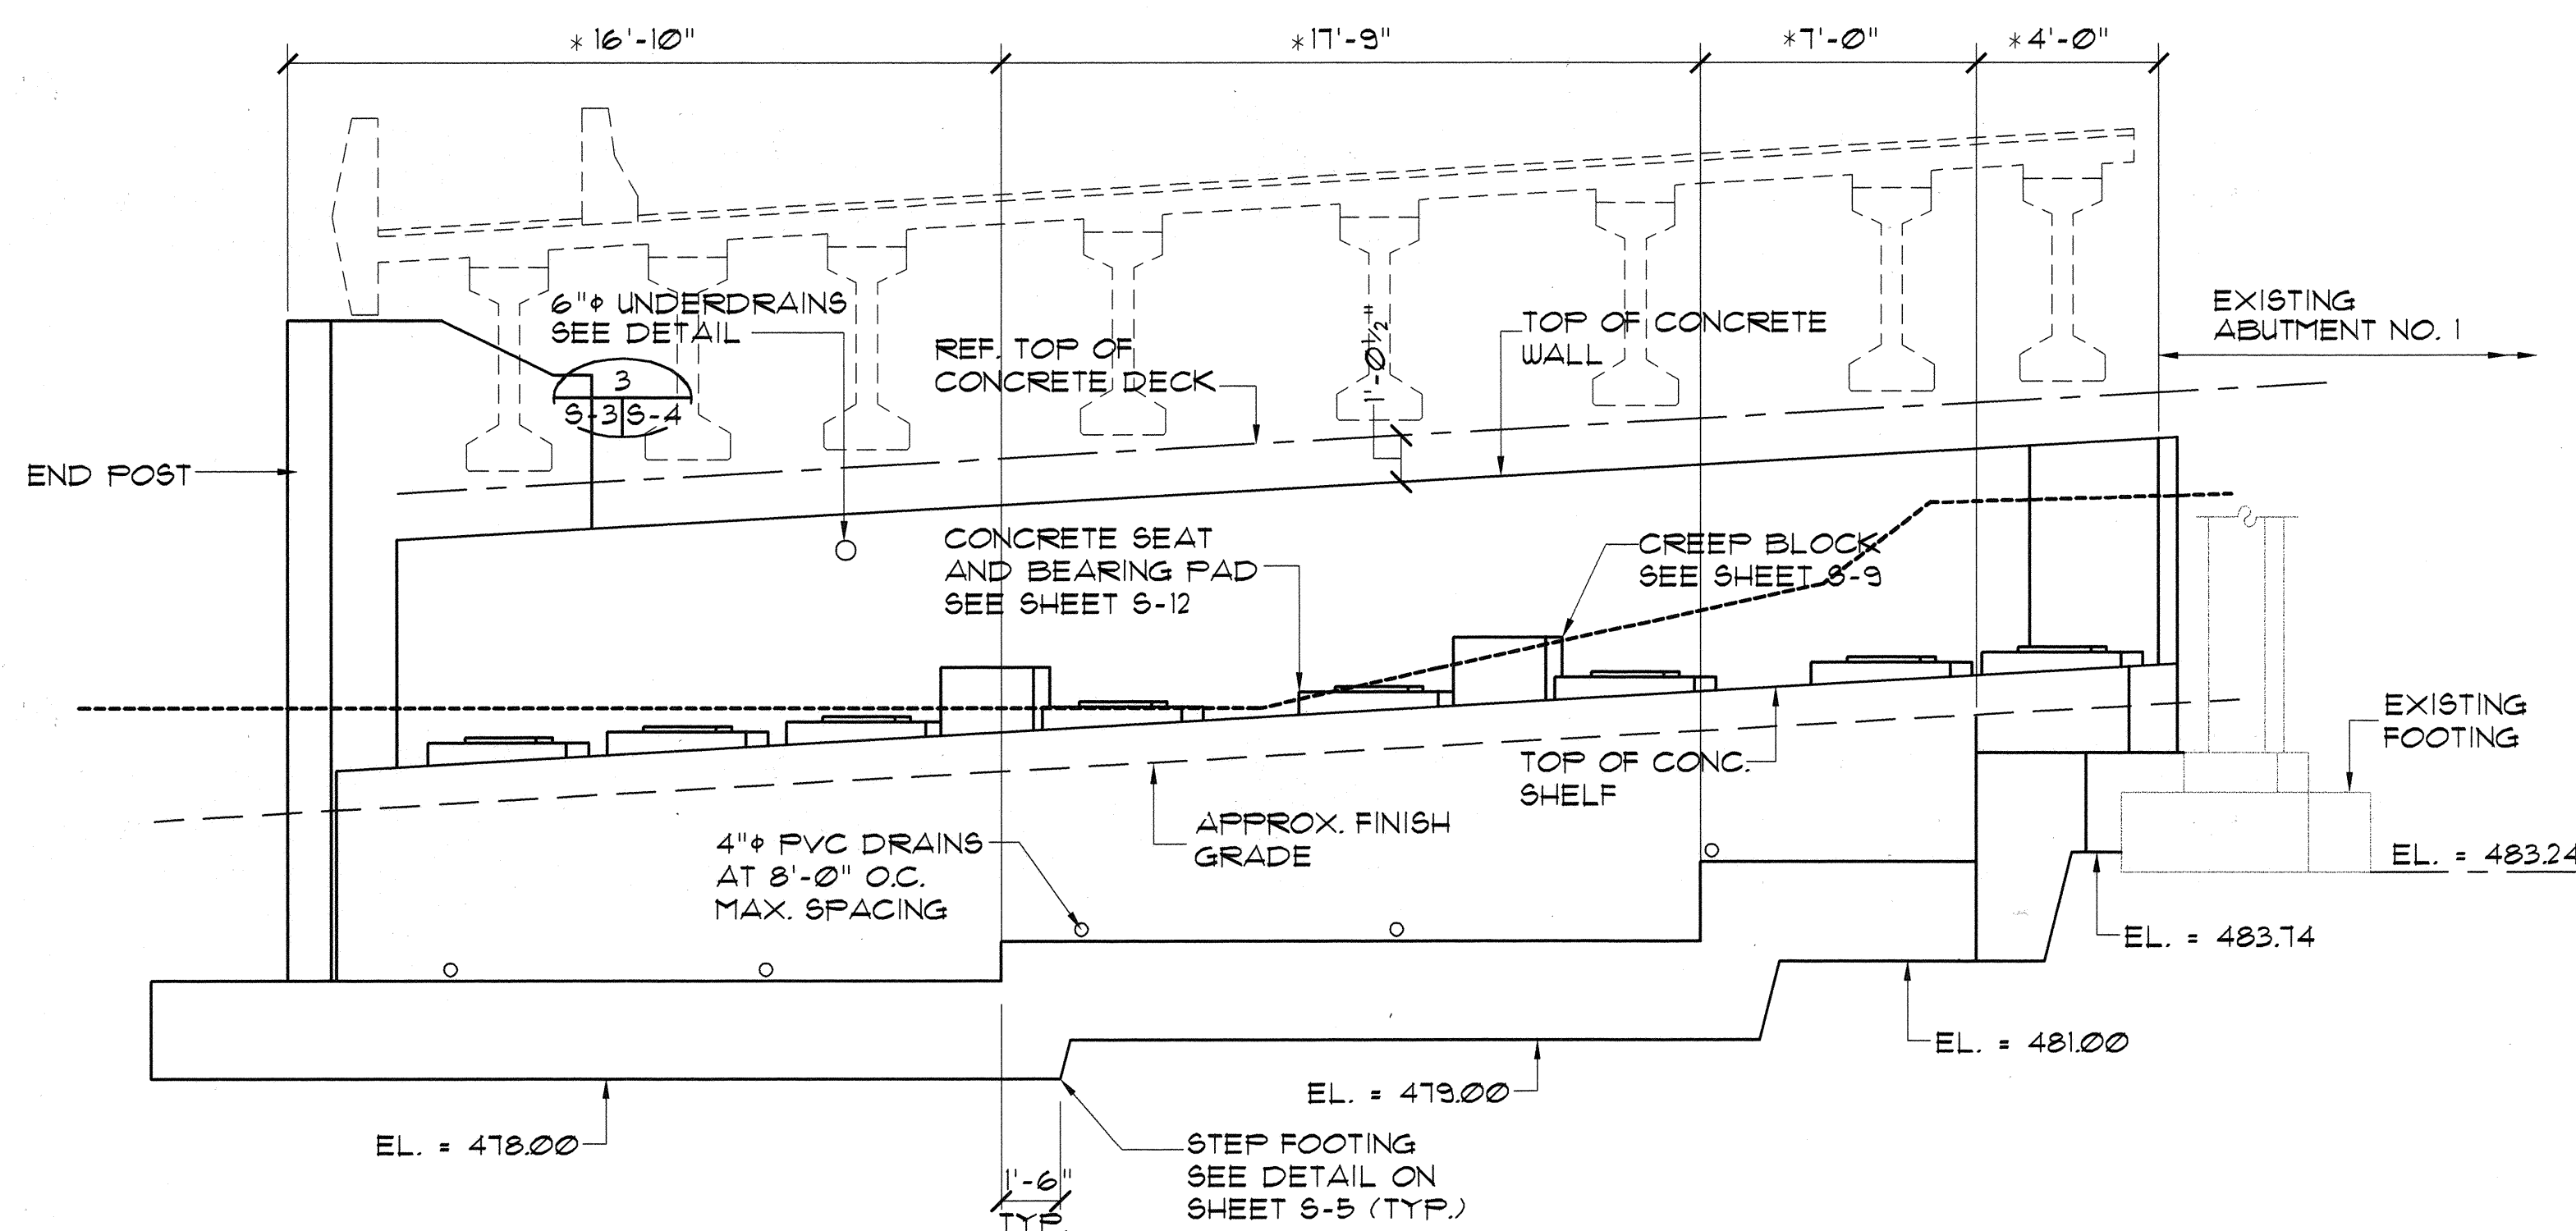


### ABUTMENT NO. 1 ELEVATION

SCALE: 1/4"=1'-0"

#### NOTE:

1. TOP OF CONCRETE WALL TO FOLLOW TOP OF FINISH CONCRETE DECK GRADES.
2. TOP OF CONCRETE SEAT TO FOLLOW TOP OF FINISH CONCRETE DECK GRADES AT Q BEARING.
3. FOR GIRDER BEARING AND CONCRETE SEAT DETAIL - SEE SHEETS S-11 AND S-12.
4. \* DENOTES DIMENSION FOR STEP FOOTING AT Q BEARING ABUTMENT NO. 1.
5. 000.00 DENOTES TOP OF SEAT ELEVATION.
6. (EL.=000.00) DENOTES TOP OF SHELF ELEVATION.

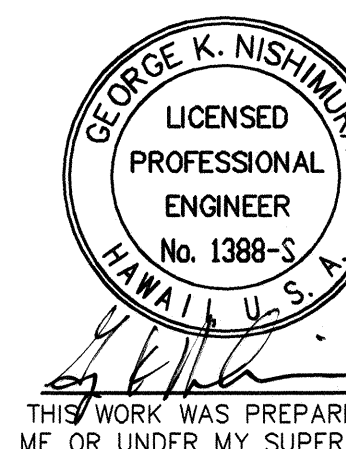

5/29/02	Revise Girder Seat And Shelf Elevation
3/18/02	Deleted Abutment No. 2 Plan And Elevation
1/30/02	Revise Bridge Azimuths, Dimensions, Deck Elevations And Footing Elevations.
Date	Revision

STATE OF HAWAII  
DEPARTMENT OF TRANSPORTATION  
HIGHWAYS DIVISION

ABUTMENT NO. 1 PLAN  
AND ELEVATION


KAUMUALII HIGHWAY INTERSECTION  
IMPROVEMENTS AT KOLOA ROAD  
PROJECT NO. STP-050-1(17)

SHEET No. 8-3 OF 17 SHEETS

C.O. 45


SURVEY PLOTTED BY	DATE
DRAWN BY	
DESIGNED BY	
CHECKED BY	
ORIGINAL PLAN	
NOTE BOOK	
No.	

FED. ROAD DIST. NO.	STATE	FED. AID PROJ. NO.	FISCAL YEAR	SHEET NO.	TOTAL SHEETS
HAWAII	HAW.	STP-050-1(17)	2000	45A	72

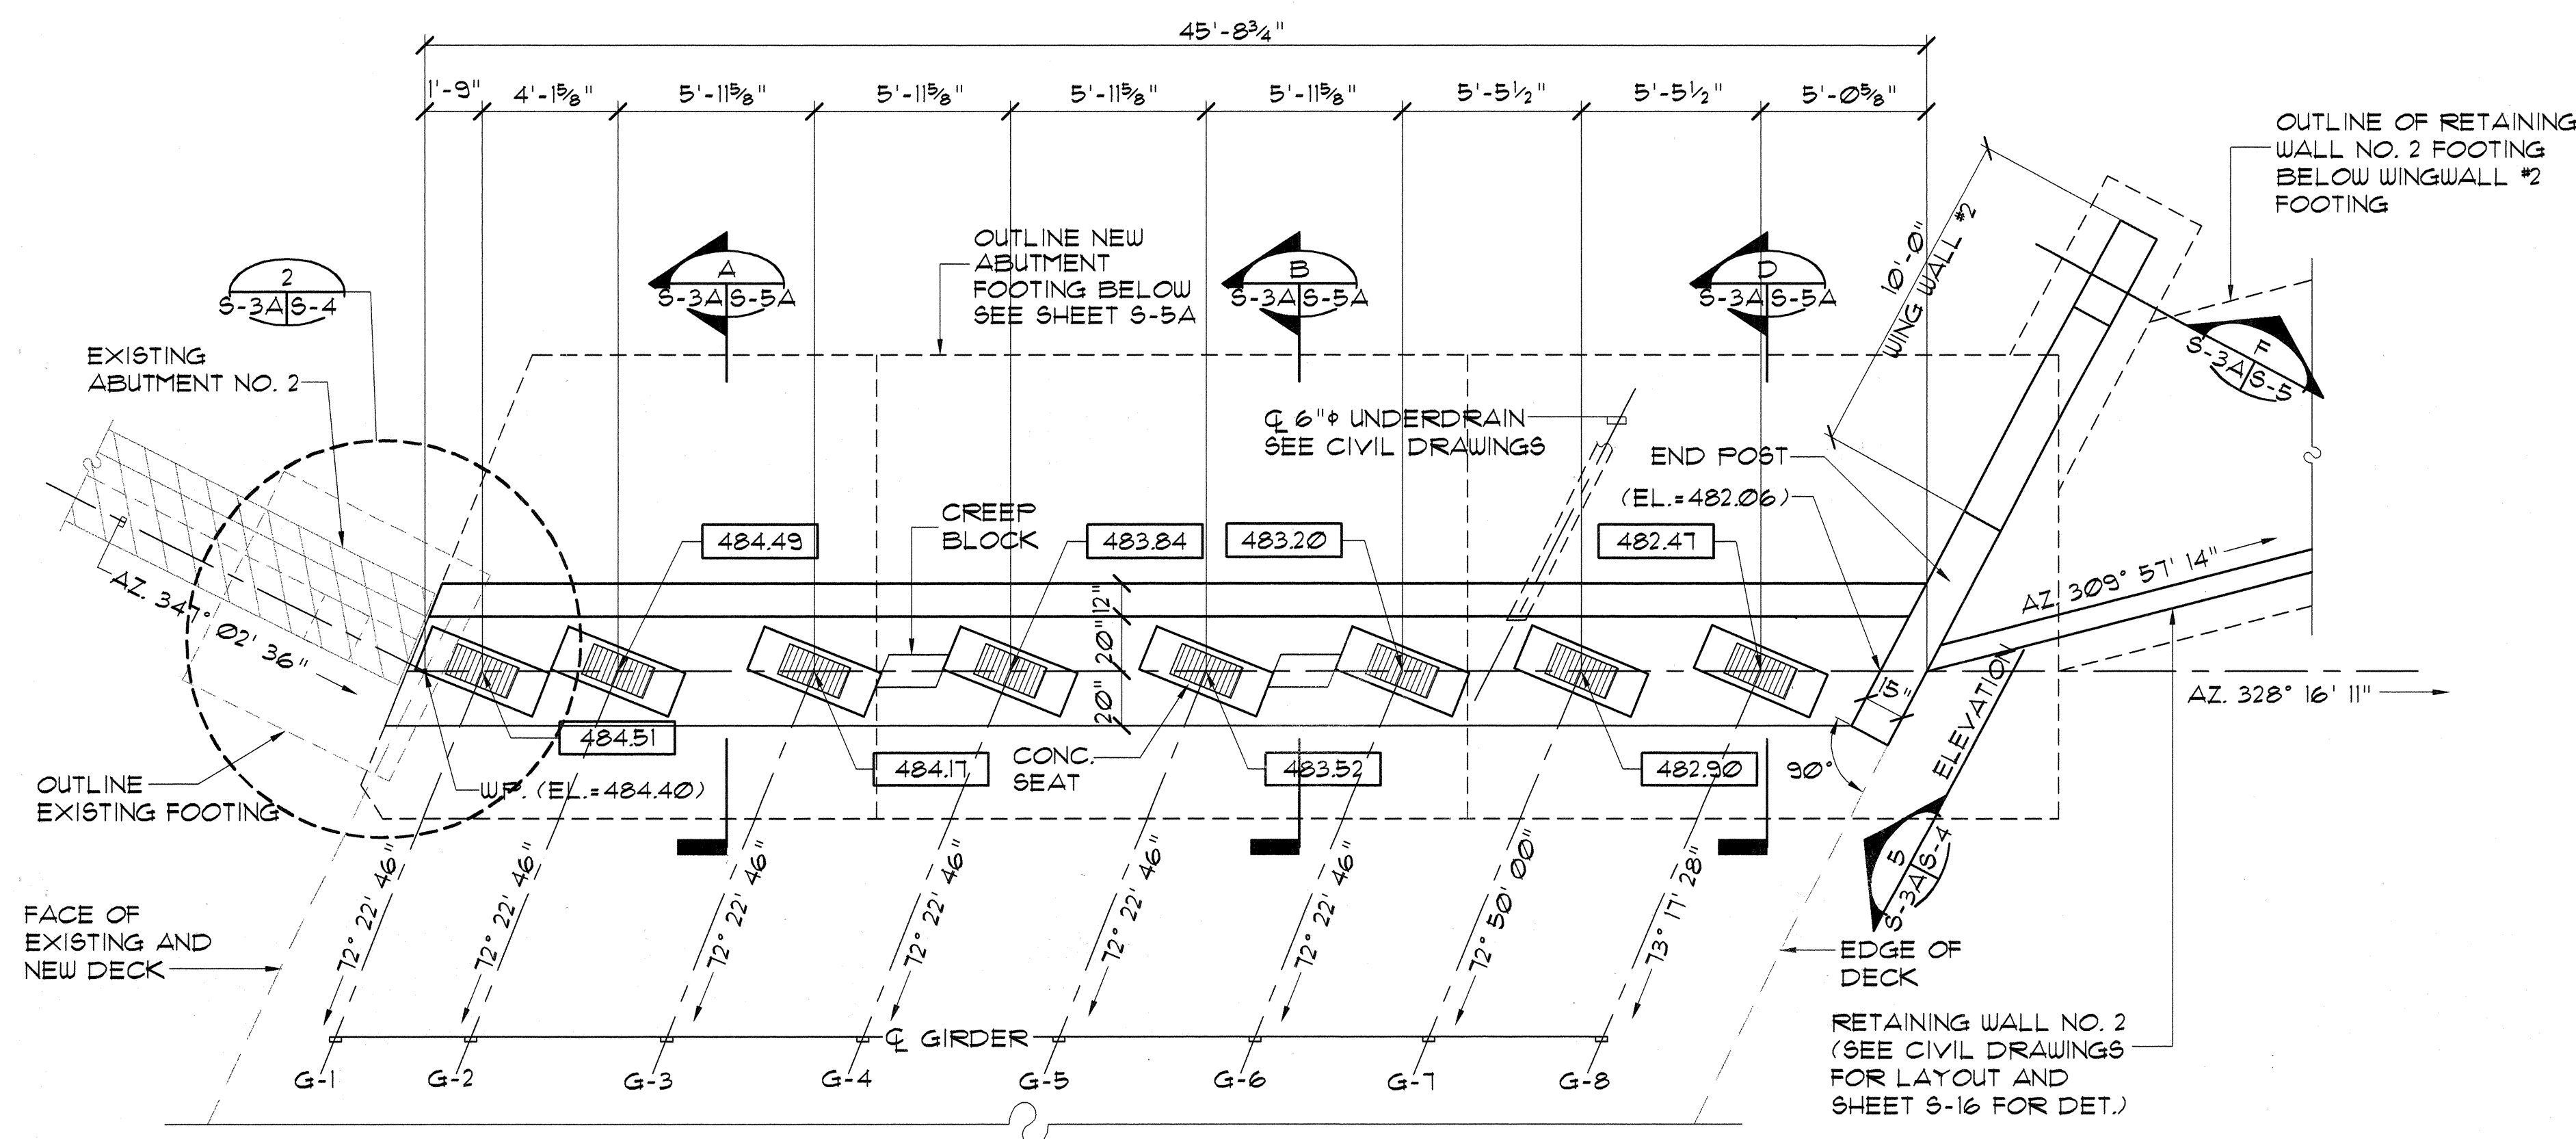

**ABUTMENT NO. 2 PLAN**


SCALE: 1/4"=1'-0"

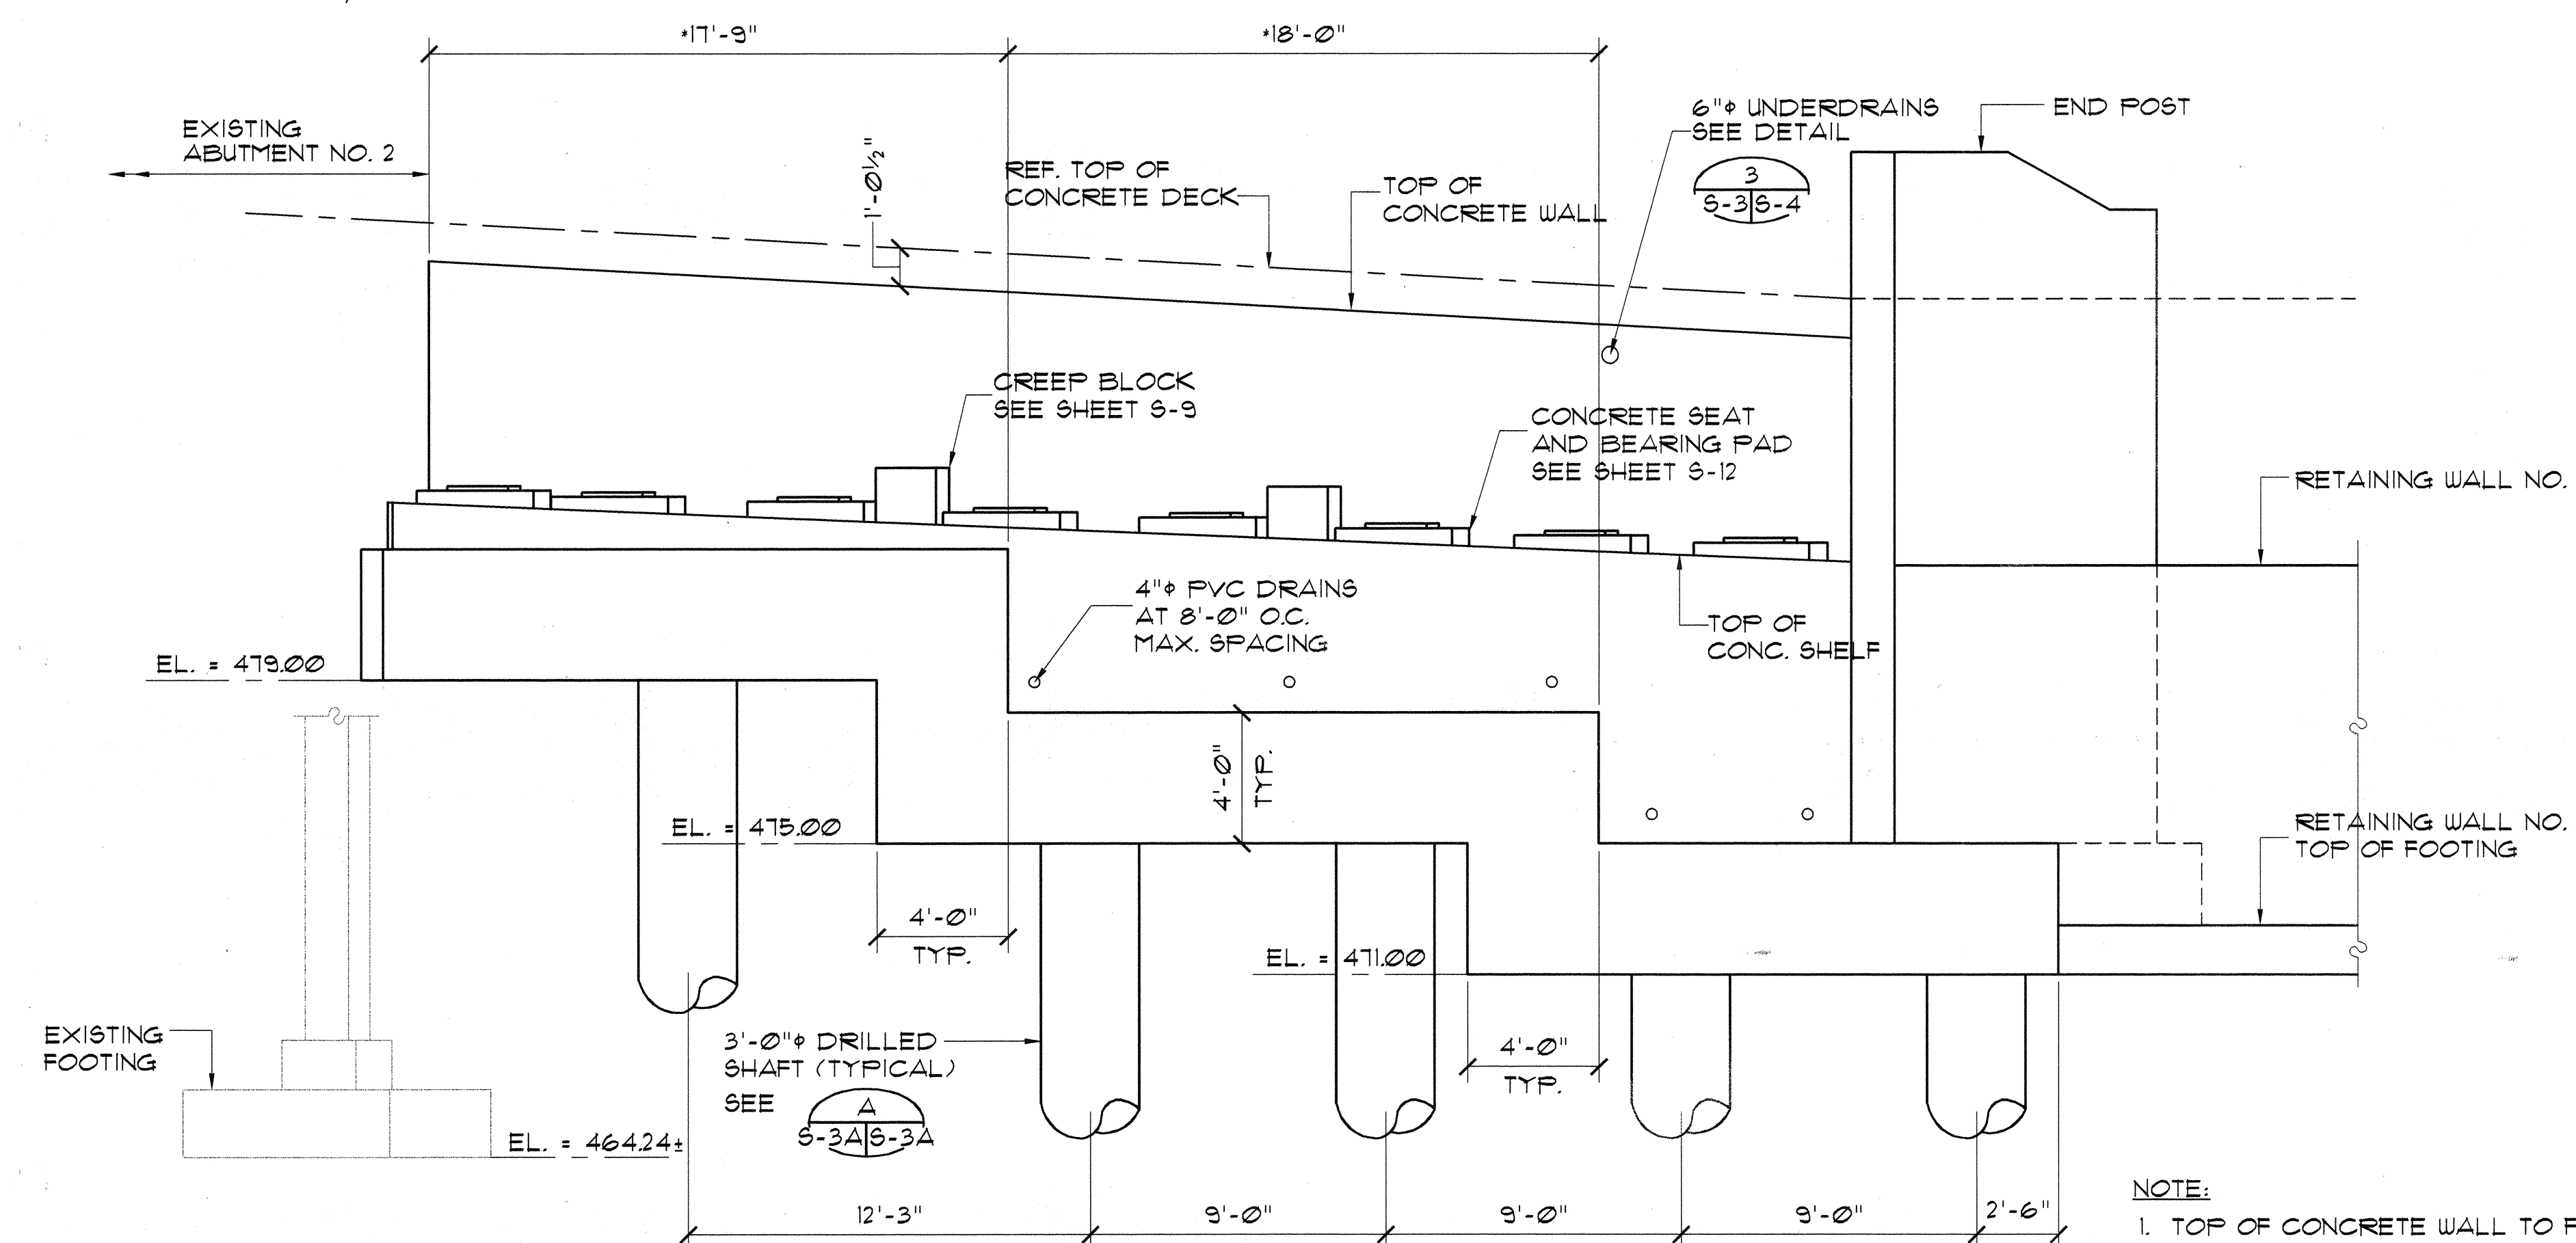

**ABUTMENT NO. 2 ELEVATION**

SCALE: 1/4"=1'-0"

2'-0" Bend (Typ.) Layers Of Bends Shall Be 3" Apart (4 Layers Max.)

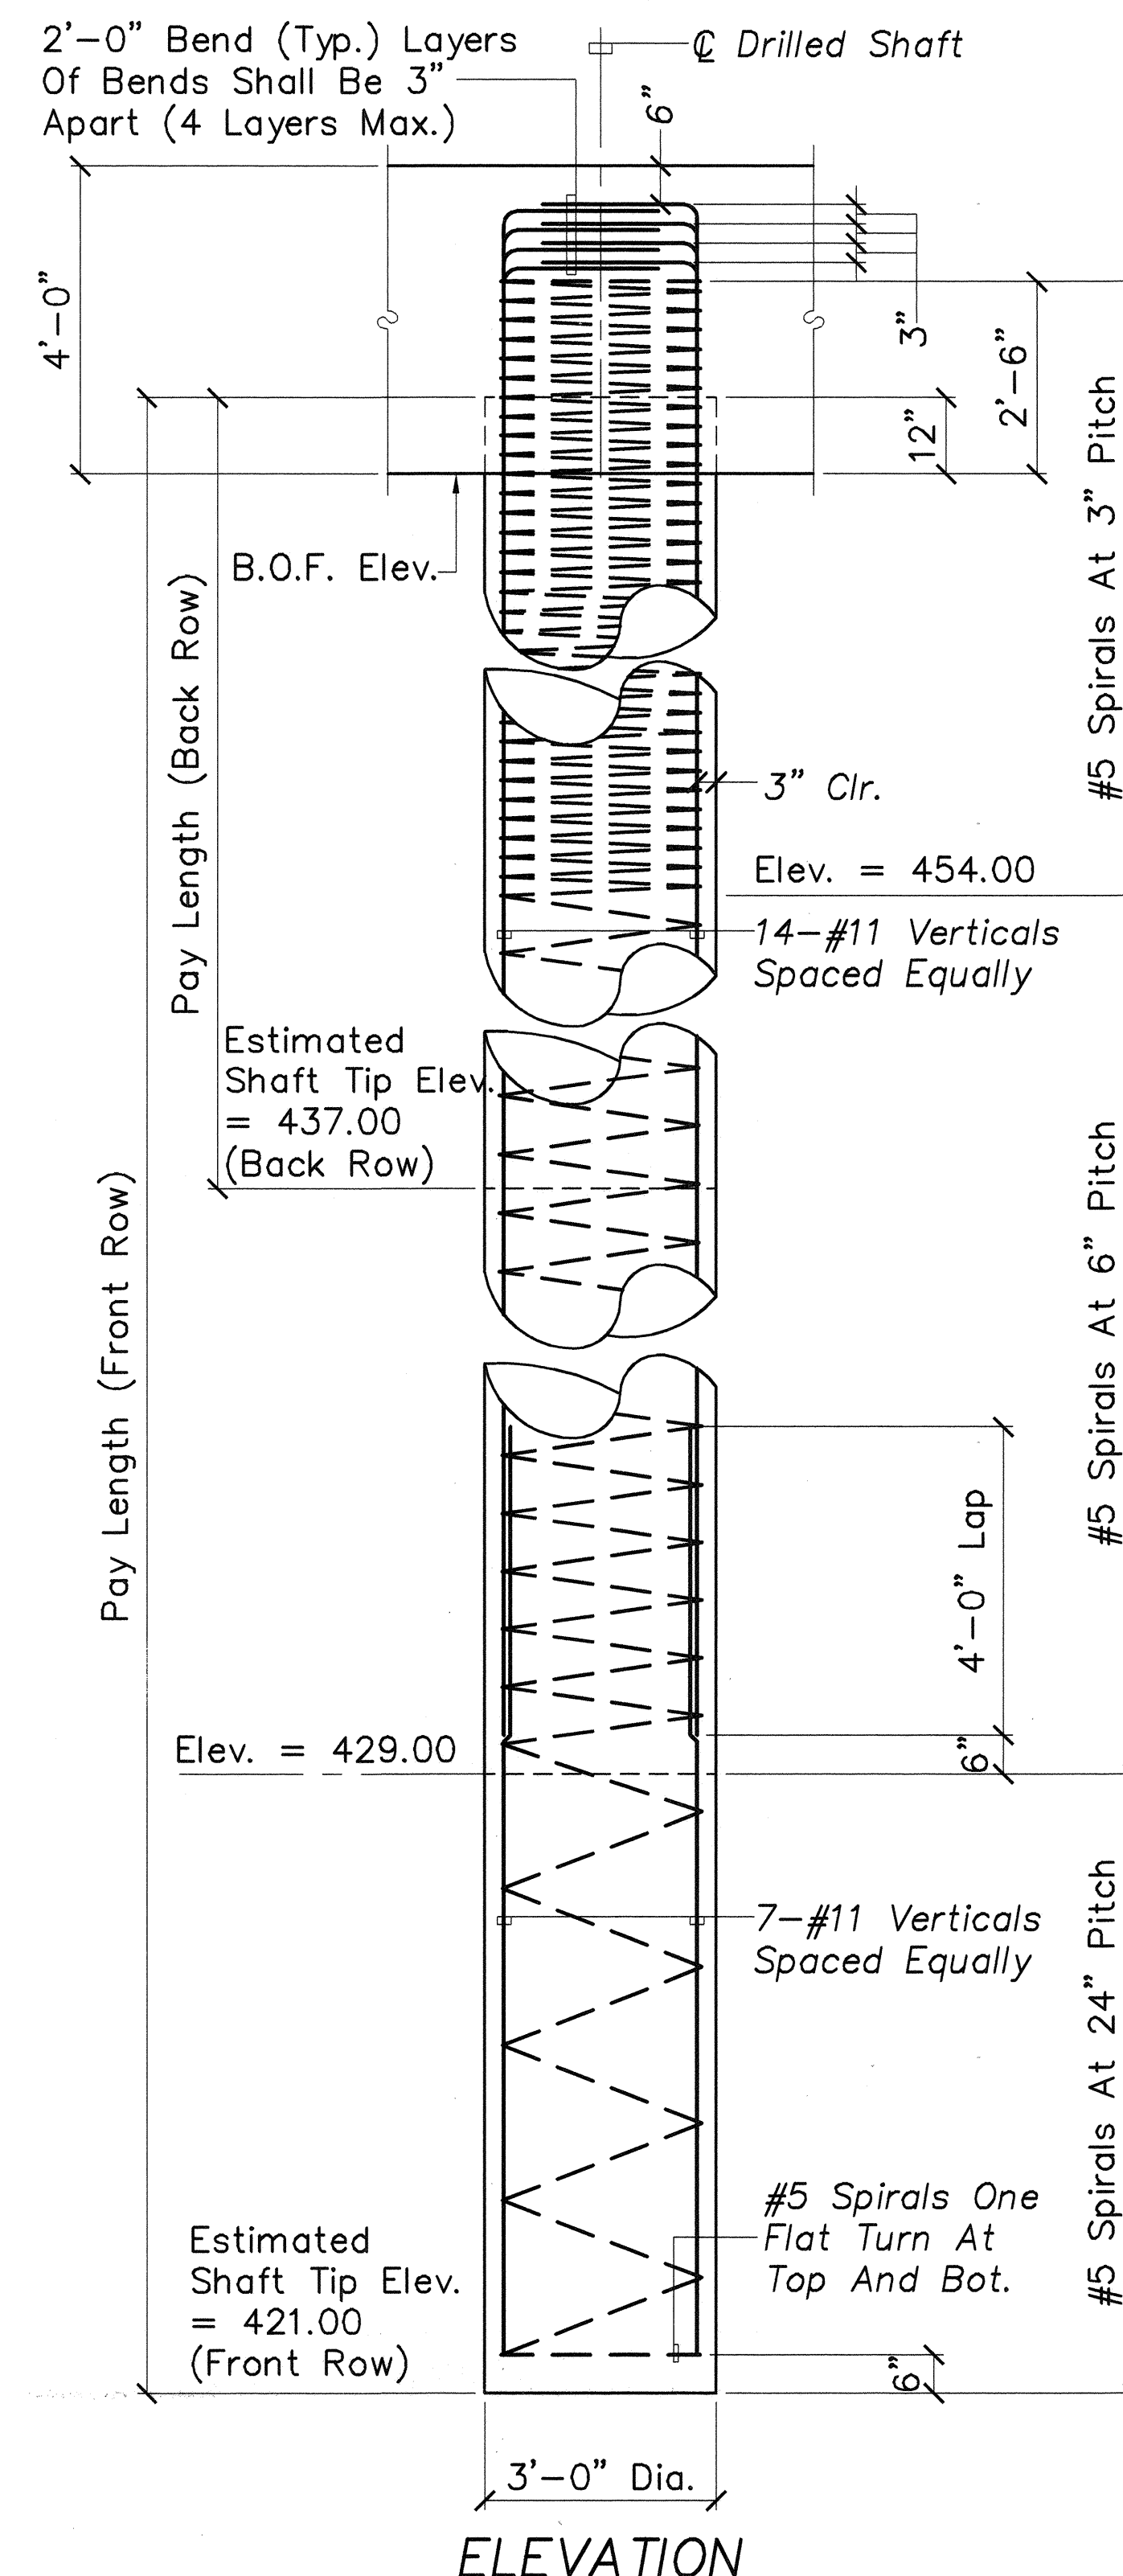


**ELEVATION**

**DRILLED SHAFT DETAILS**

Not To Scale

**NOTE:**

1. TOP OF CONCRETE WALL TO FOLLOW TOP OF FINISH CONCRETE DECK GRADES.
2. TOP OF CONCRETE SEAT TO FOLLOW TOP OF FINISH CONCRETE DECK GRADES AT  $\bar{Q}$  BEARING.
3. FOR GIRDER BEARING AND CONCRETE SEAT DETAIL - SEE SHEETS S-11 AND S-12.
4. \* DENOTES DIMENSION FOR STEP FOOTING AT  $\bar{Q}$  BEARING ABUTMENT NO. 2.
5.  $\square$  DENOTES TOP OF SEAT ELEVATION.
6. (EL.=000.00) DENOTES TOP OF SHELF ELEVATION.

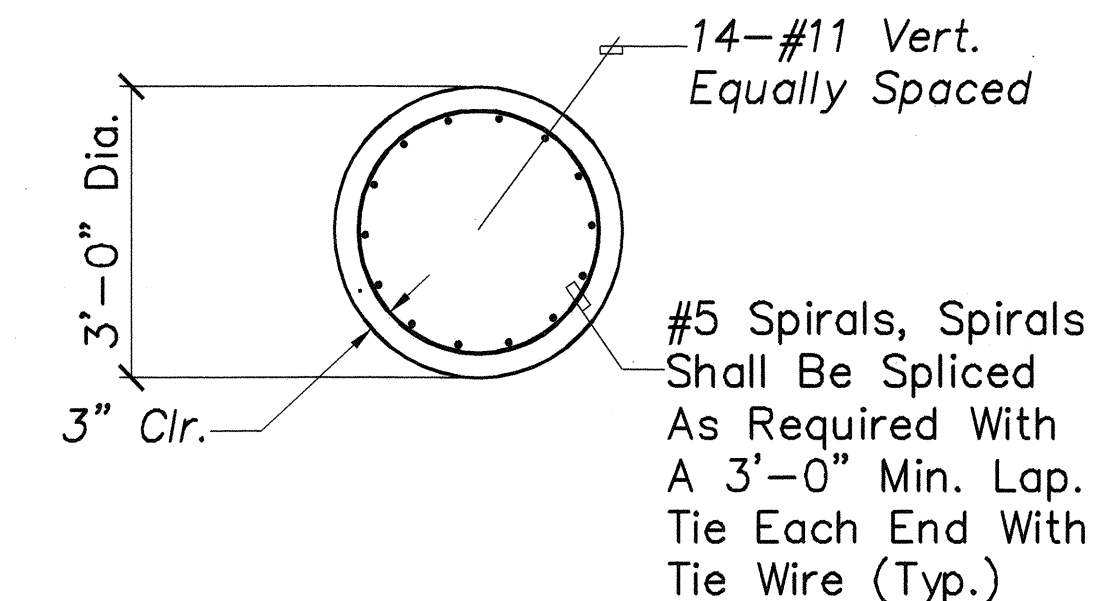

**SECTION**

**Notes:**

1. Drilled Shaft Concrete Shall Be 4000 PSI Strength At 28 Days.
2. Concrete Spacers Shall Be Used To Maintain The Reinforcement Cage In Position Within The Shaft.
3. Spirals May Be Discontinuous At Footing Reinforcement. The Discontinuous Spirals Shall Be Terminated With A 135° Hook Around Vertical Reinforcement.
4. Vertical Bars With Hooked Ends Shall Be Provided At All Drilled Shafts. The Hooked Ends Shall Be Bent Into The Drilled Shaft.


6/5/02	Revise Drilled Shaft Location And Detail
5/29/02	Revise Girder Seat And Bottom Of Footing Elevations
3/18/02	Sheet Added
Date	Revision

STATE OF HAWAII  
DEPARTMENT OF TRANSPORTATION  
HIGHWAYS DIVISION  
ABUTMENT NO. 2 PLAN AND  
ELEVATION, DRILLED SHAFT  
DETAILS

KAUAI HIGHWAY INTERSECTION  
IMPROVEMENTS AT KOLOA ROAD  
PROJECT NO. STP-050-1(17)

SHEET No. S-3A OF 17 SHEETS

C.O. 45A

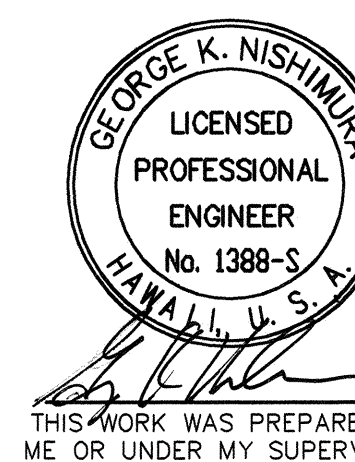


THIS WORK WAS PREPARED BY ME OR UNDER MY SUPERVISION.


SURVEY PLOTTED BY	DATE
DESIGNED BY	
TRACED BY	
NOTED BY	
CHECKED BY	
ORIGINAL PLAN	
NOTE BOOK	
QUANTITIES BY	
CHECKED BY	
No.	



FED. ROAD DIST. NO.	STATE	FED. AID PROJ. NO.	FISCAL YEAR	SHEET NO.	TOTAL SHEETS
HAWAII	HAW.	STP-050-1(17)	2000	47	72

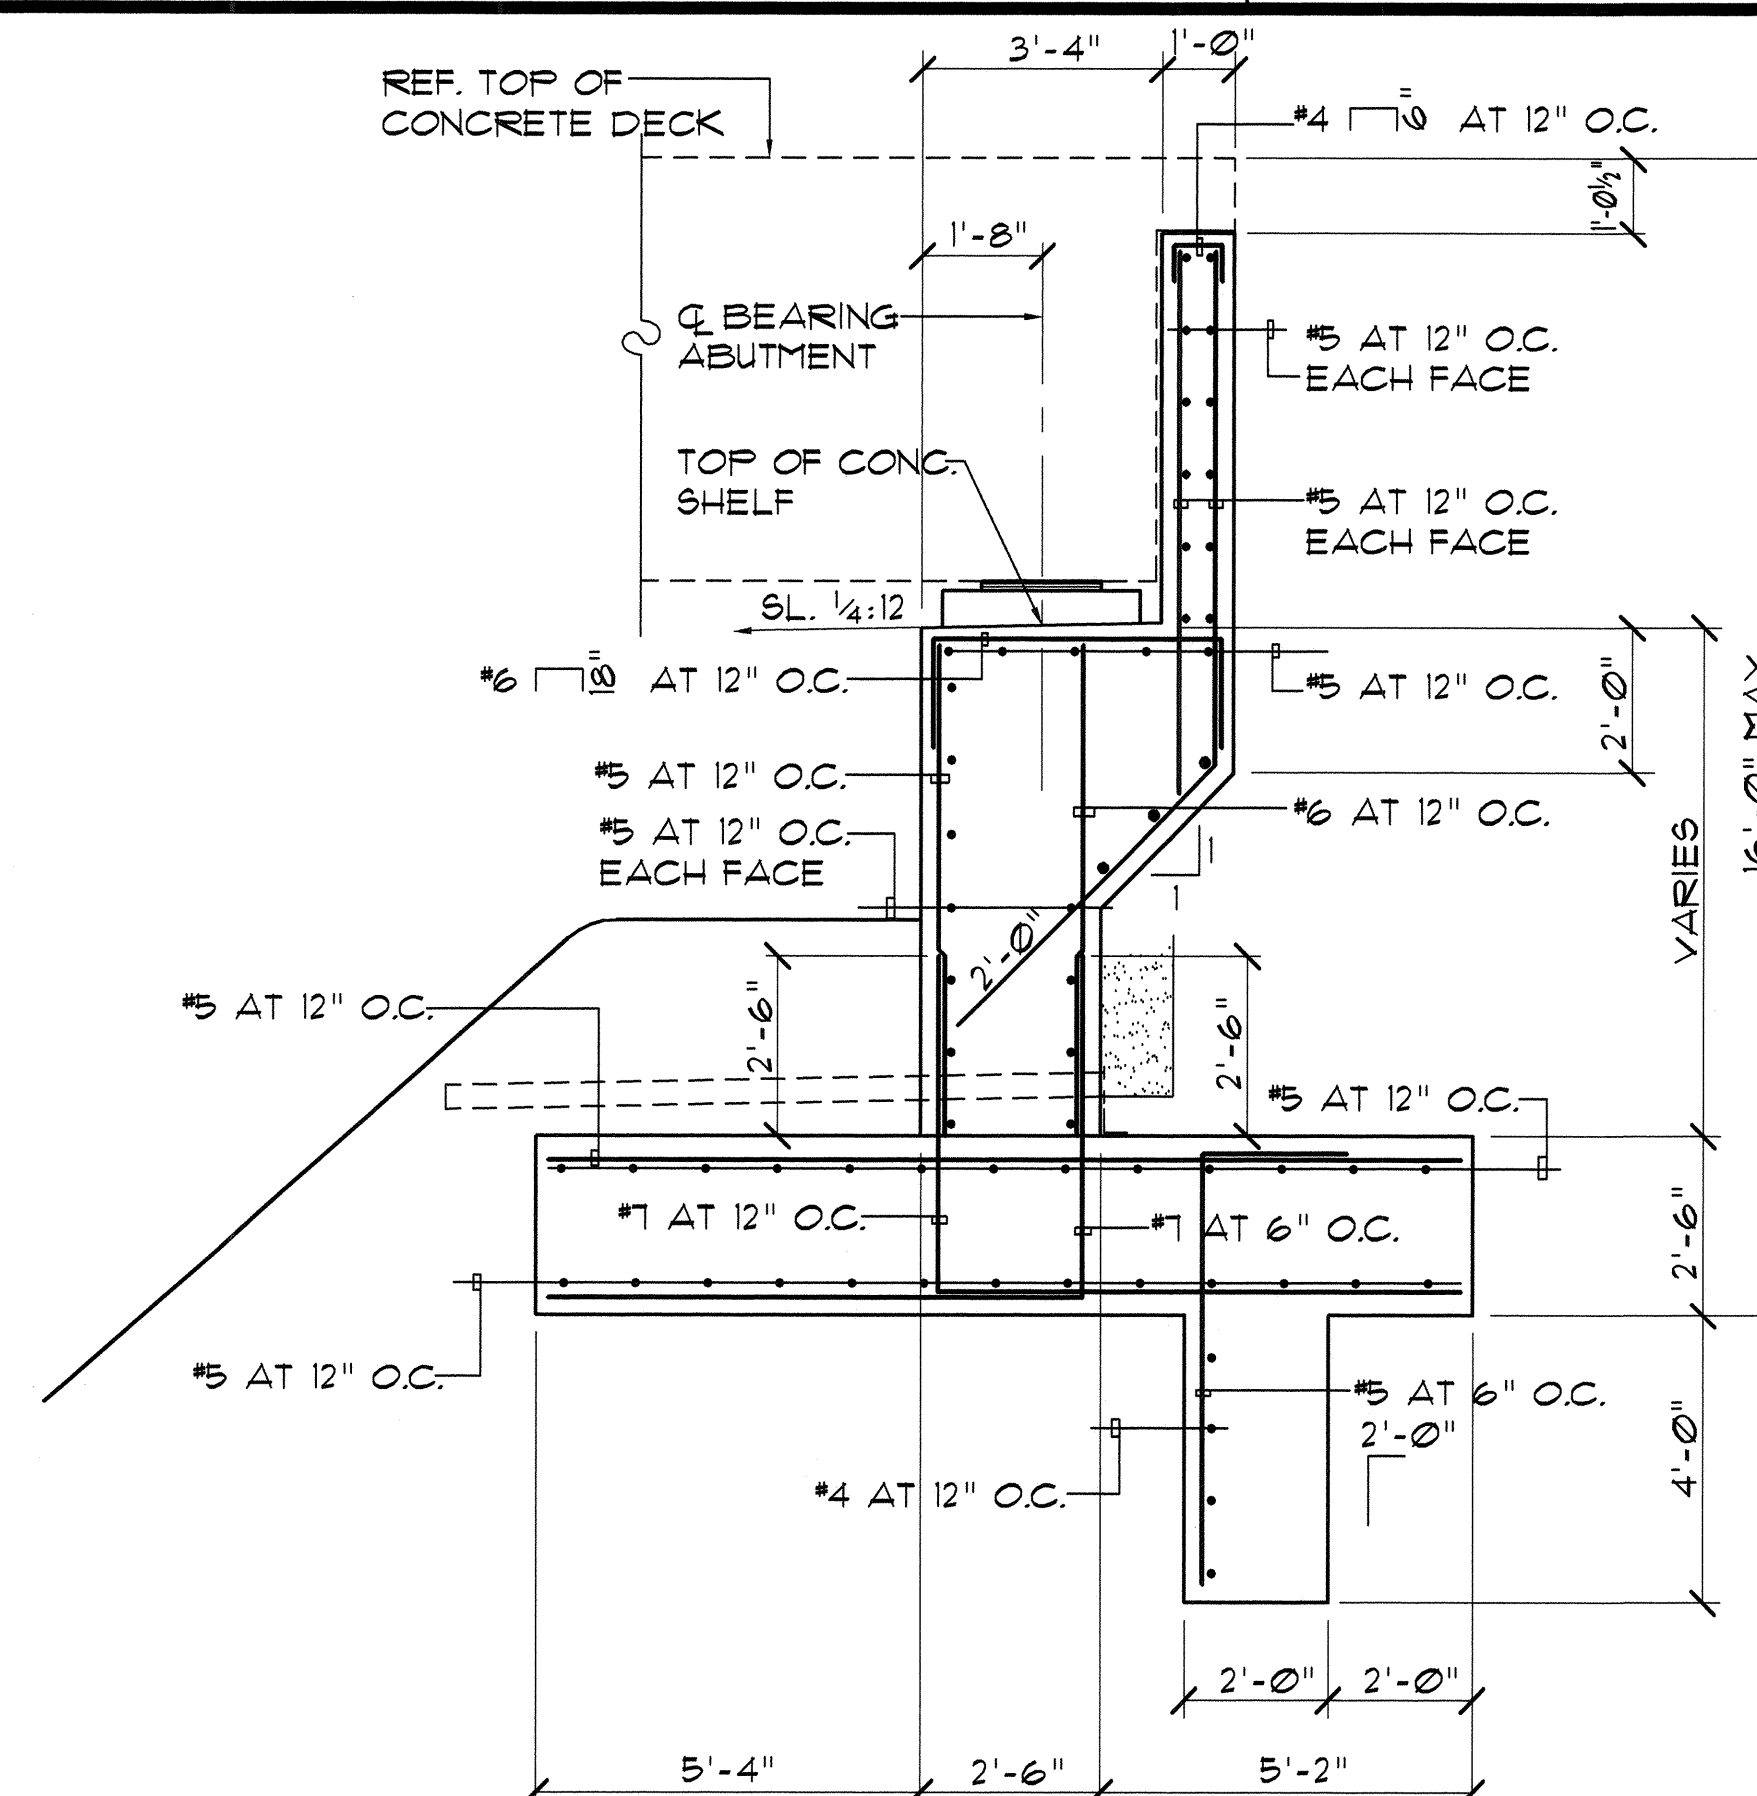


**ABUTMENT WALL SECT. B**  
SCALE: 3/8"=1'-0"

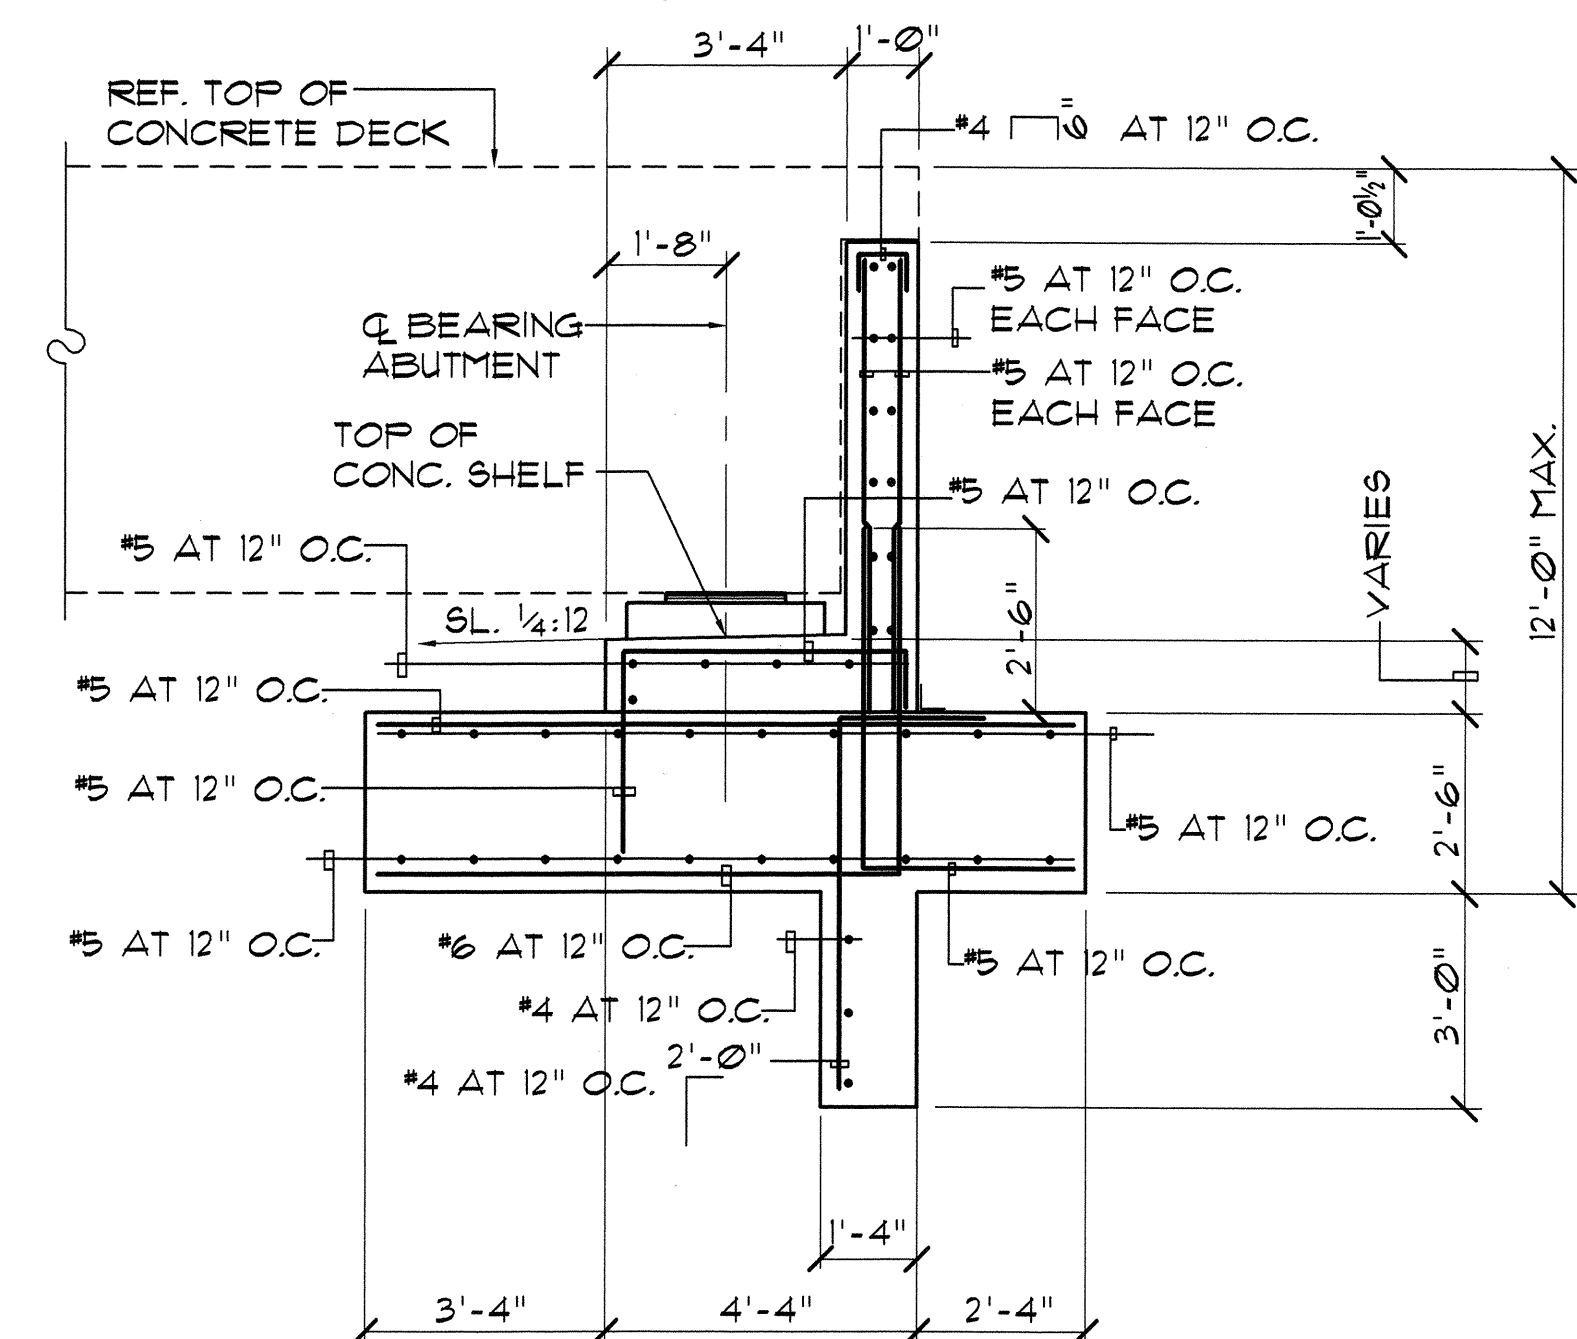


**ABUTMENT WALL SECT. C**  
SCALE: 3/8"=1'-0"


NOTE: REFER TO STANDARD PLAN B-03 FOR ABUTMENT AND WING WALL STRUCTURAL EXCAVATION AND BACKFILL PAY LIMITS

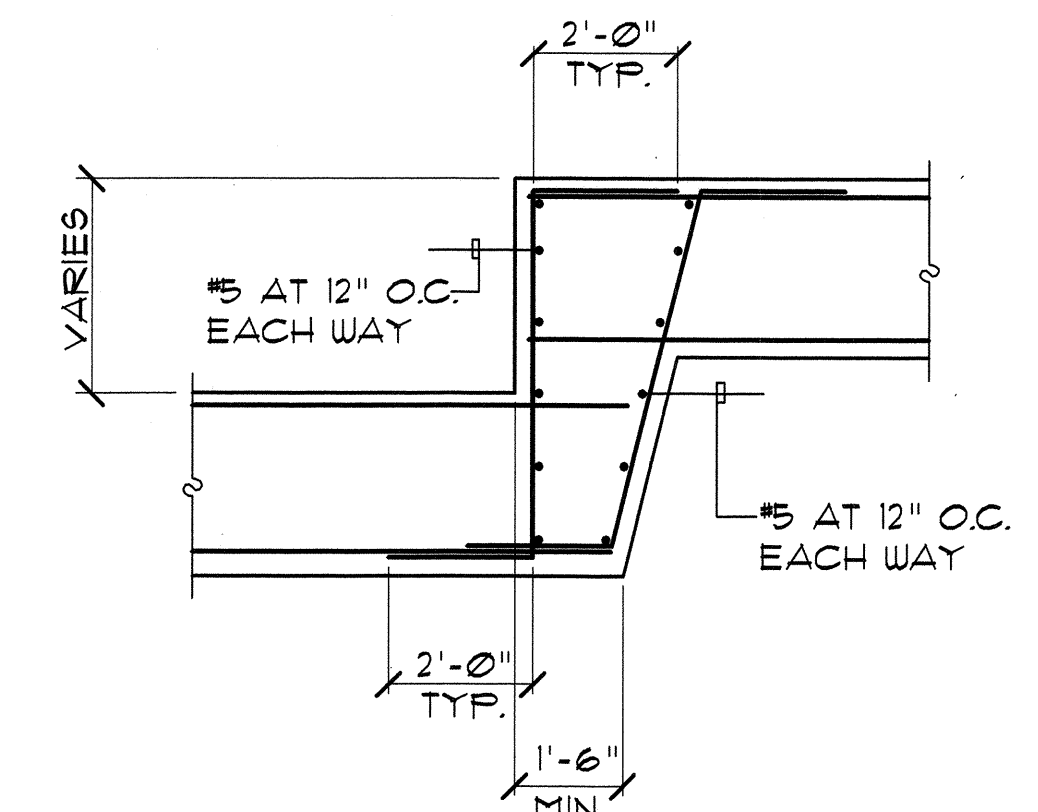


**TYP. STEP FOOTING DETAIL**  
SCALE: 3/8"=1'-0"

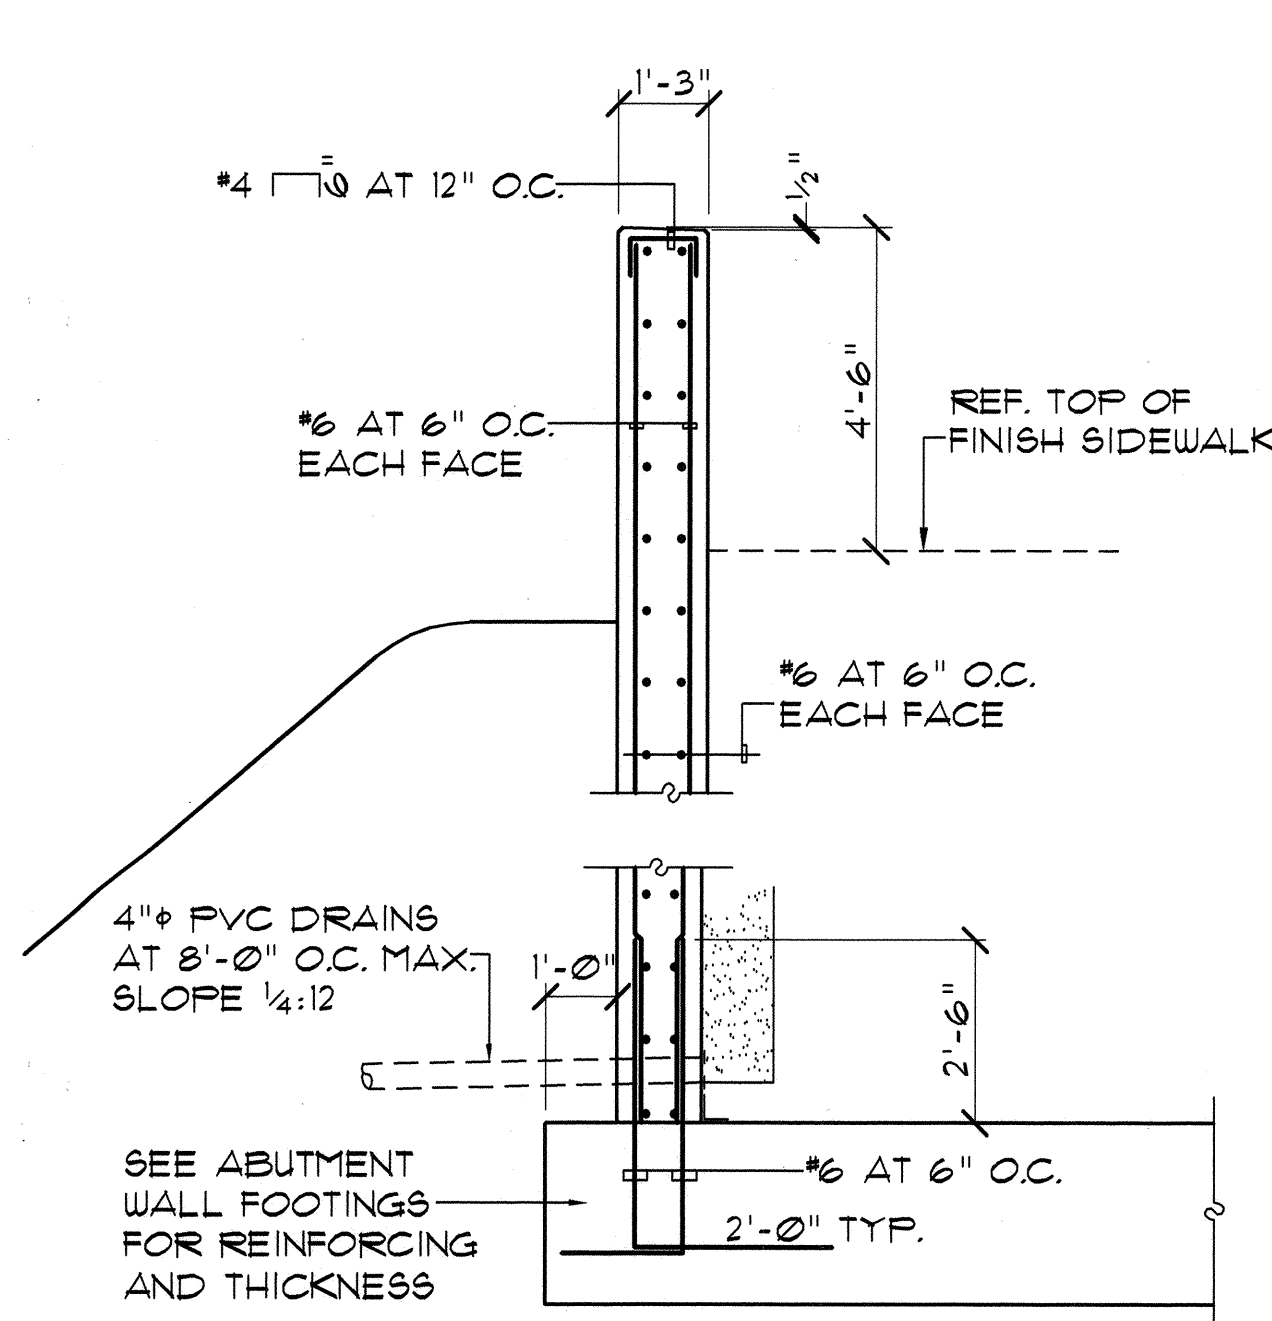

**END POST SECT. D**  
SCALE: 3/8"=1'-0"

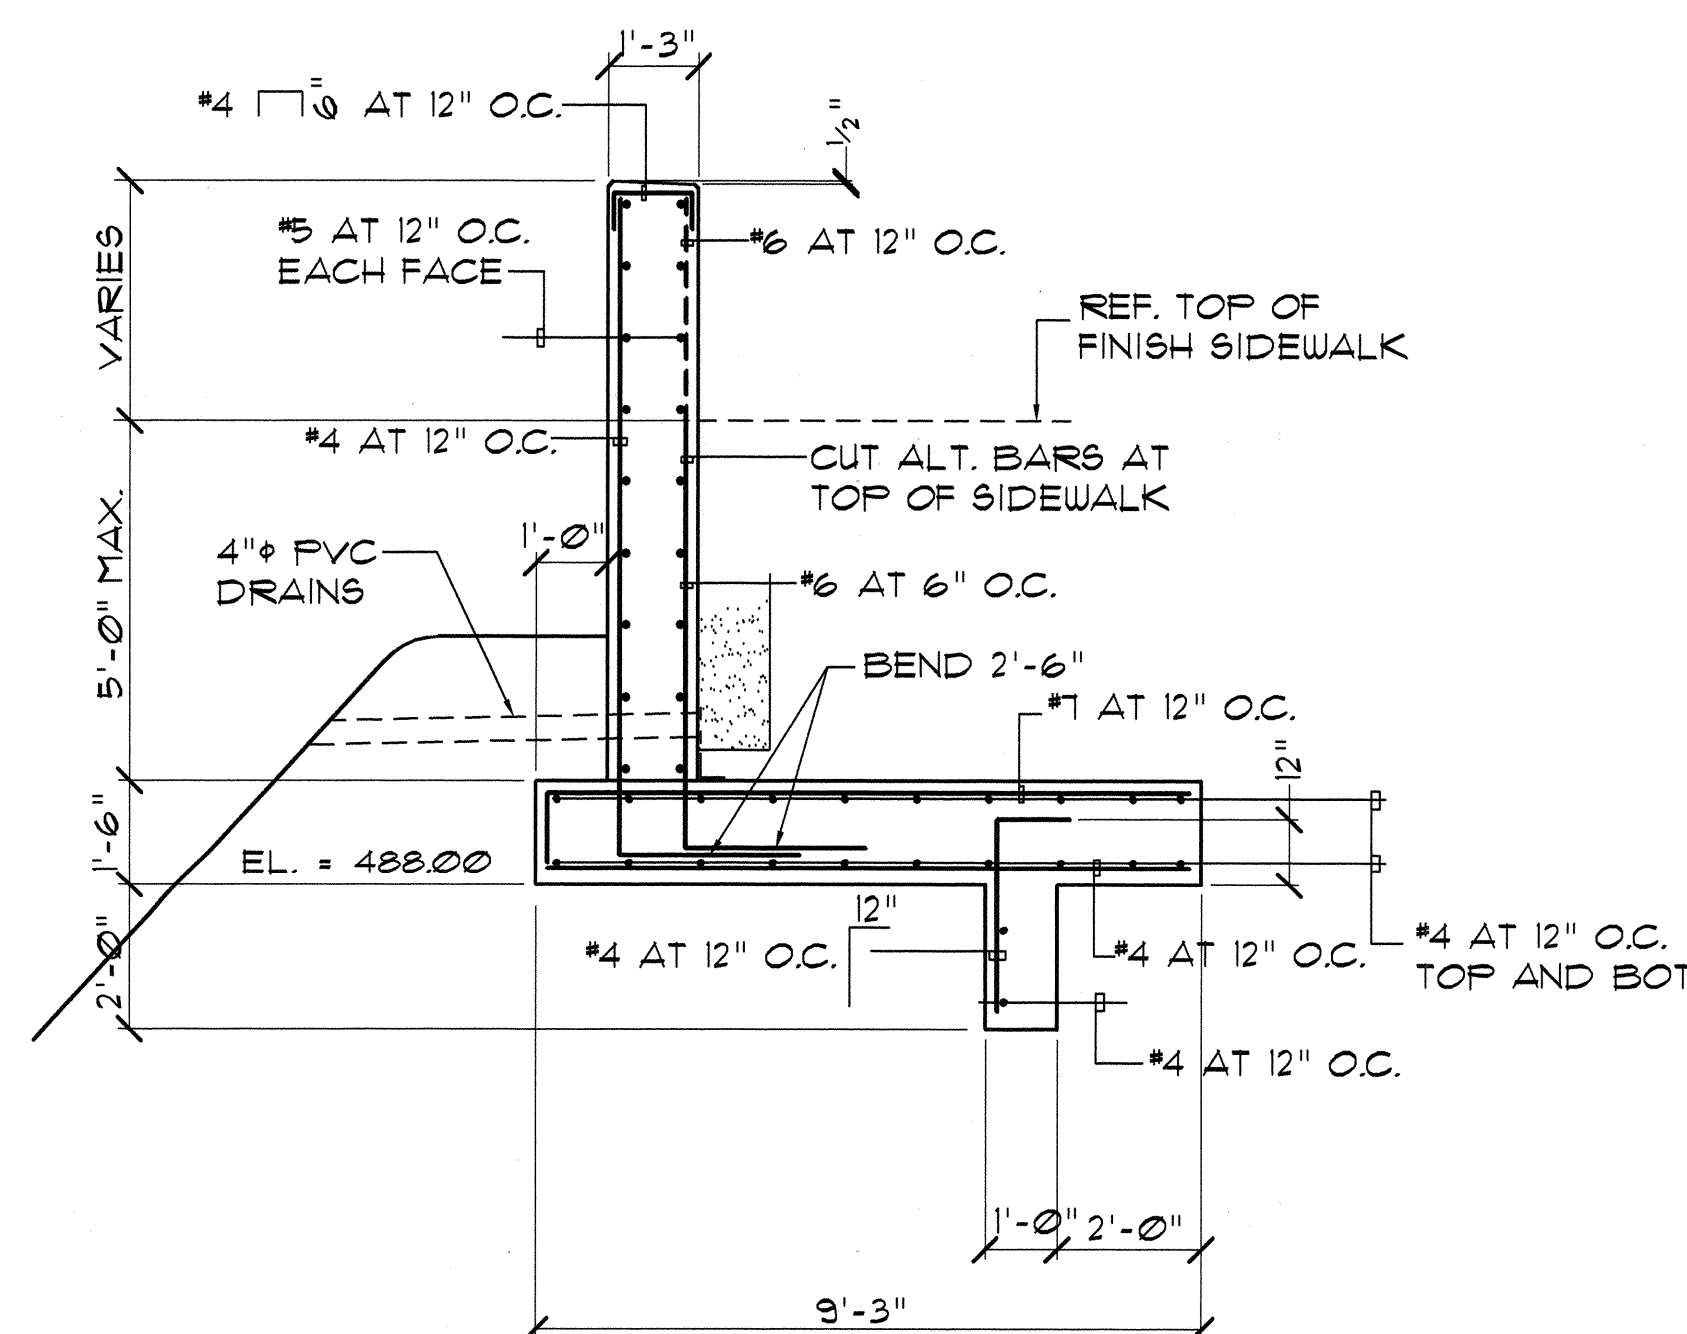

**WING WALL #1 SECTION E**  
SCALE: 3/8"=1'-0"

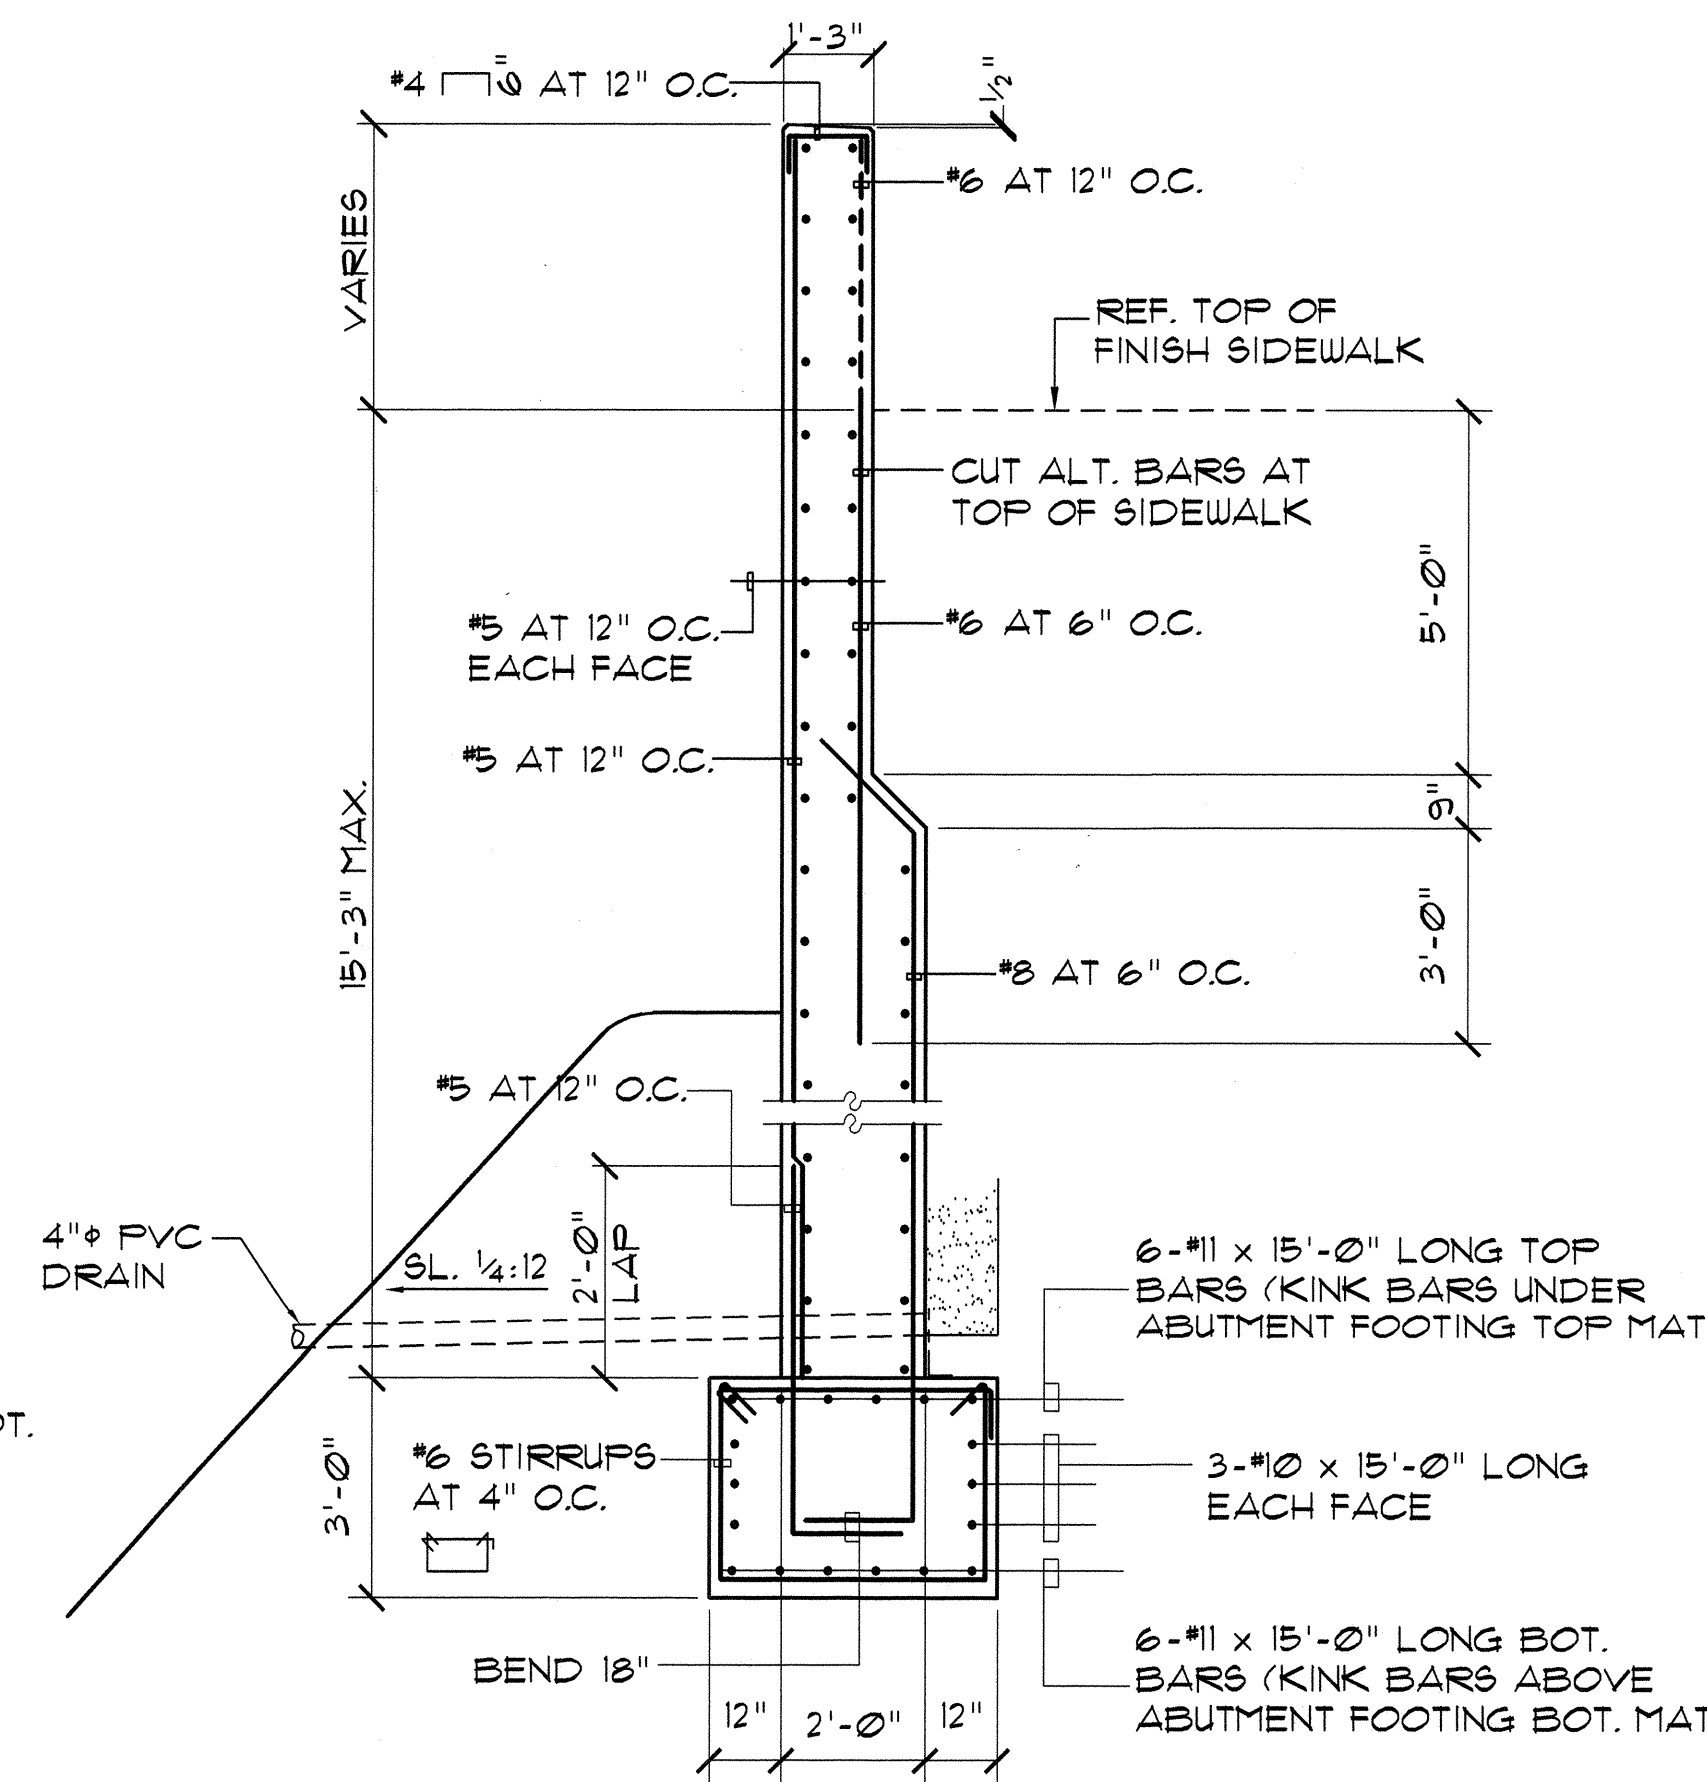

**WING WALL #2 SECTION F**  
SCALE: 3/8"=1'-0"




THIS WORK WAS PREPARED BY ME OR UNDER MY SUPERVISION.


3/18/02	Revised Wing Wall No. 2 Section
1/30/02	Revise Footing Elevations
Date	Revision
<b>STATE OF HAWAII</b> <b>DEPARTMENT OF TRANSPORTATION</b> <b>HIGHWAYS DIVISION</b> <b>ABUTMENT NO. 1 AND NO. 2</b> <b>SECTIONS AND DETAILS</b> <b>KAUWAHINE HIGHWAY INTERSECTION</b> <b>IMPROVEMENTS AT KOLOA ROAD</b> <b>PROJECT NO. STP-050-1(17)</b>	

SHEET No. 8-5 OF 17 SHEETS


FED. ROAD DIST. NO.	STATE	FED. AID PROJ. NO.	FISCAL YEAR	SHEET NO.	TOTAL SHEETS
HAWAII	HAW.	STP-050-1(17)	2000	47A	72

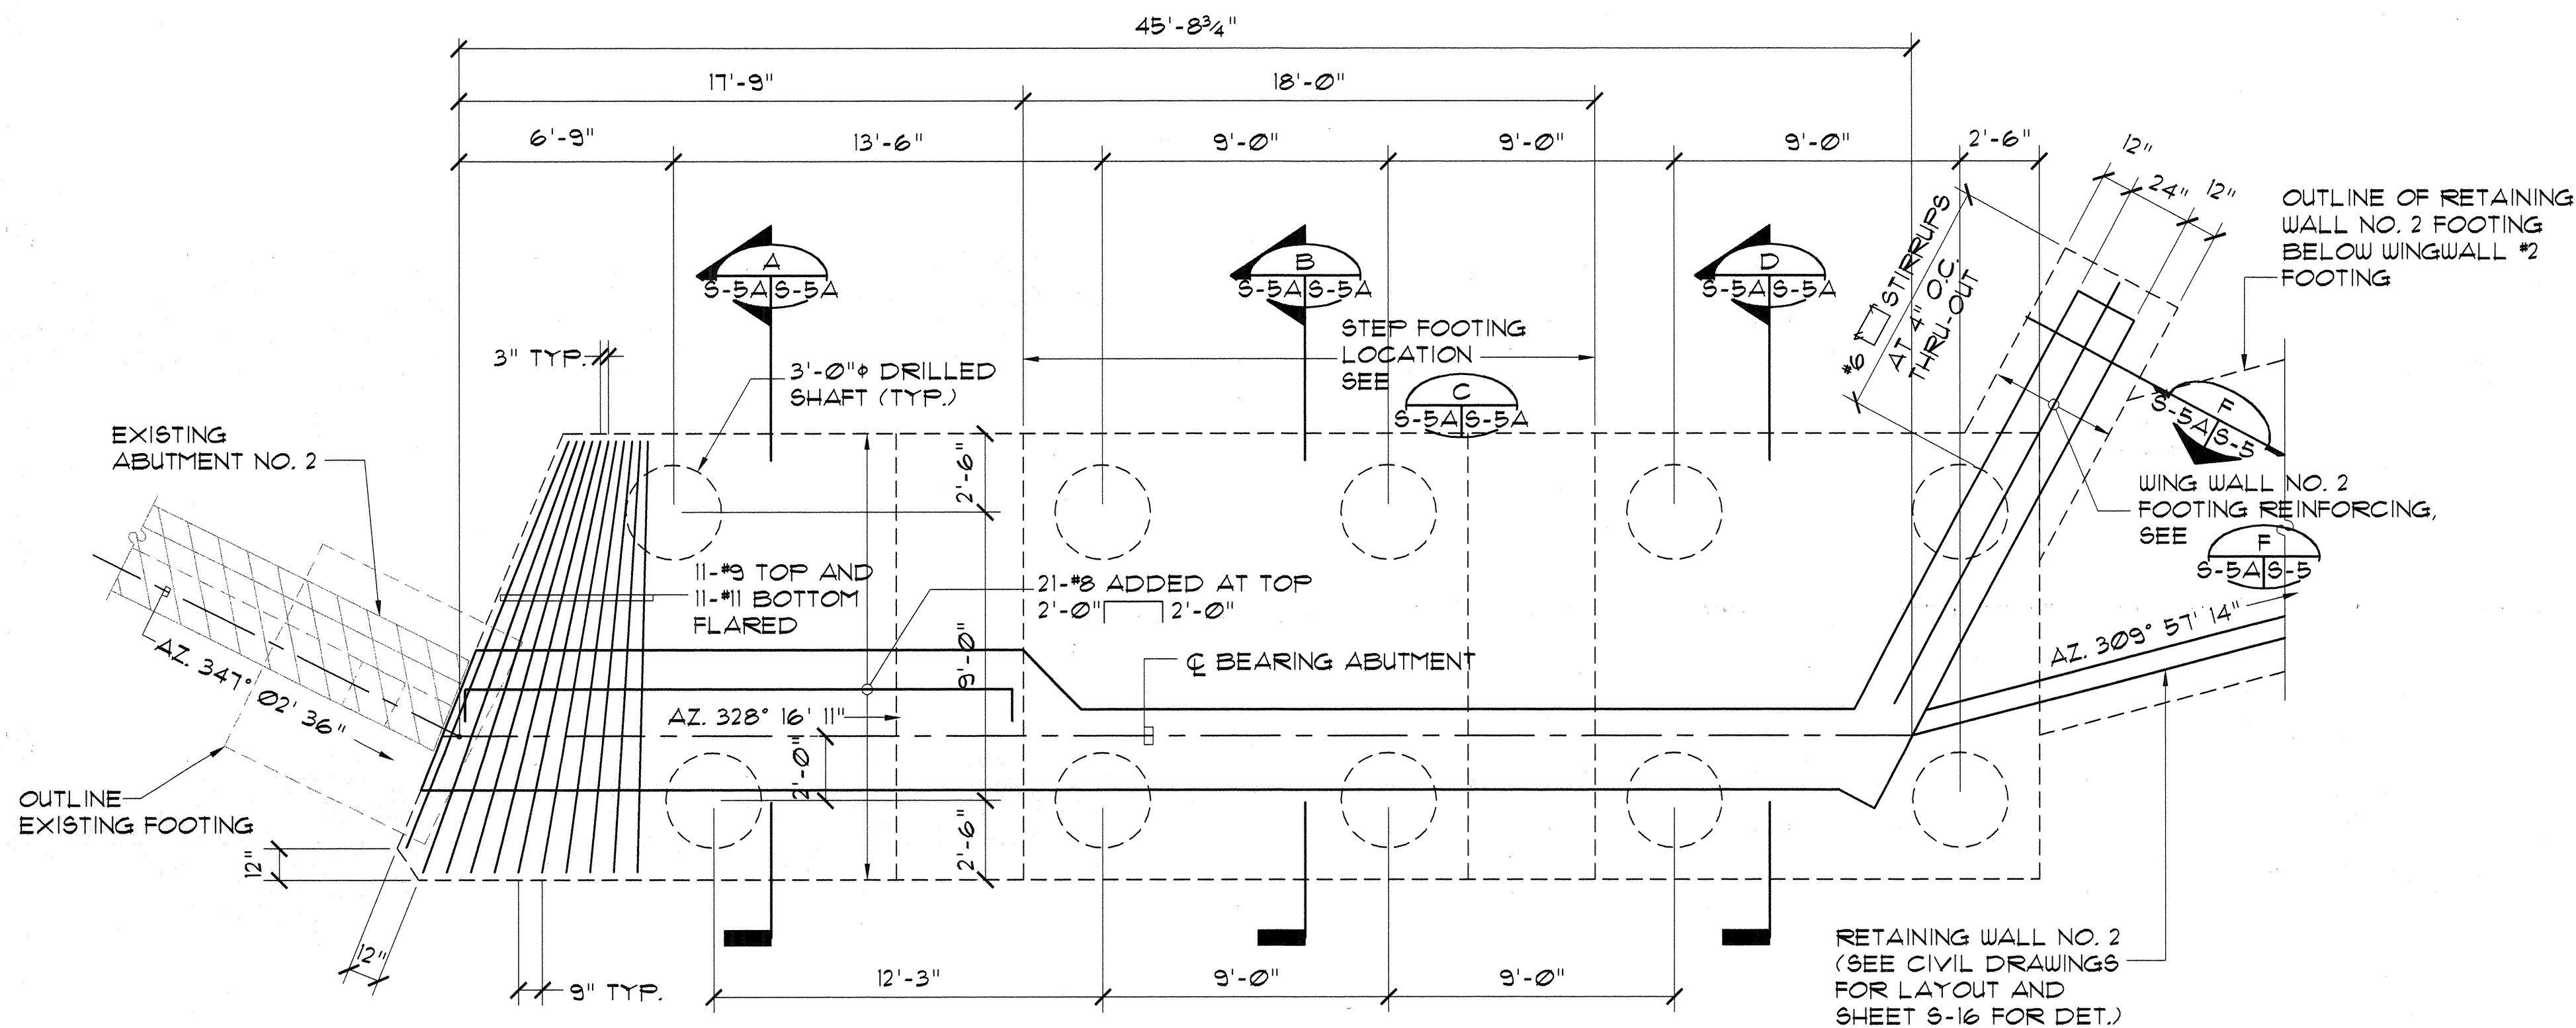


**ABUTMENT NO. 2 FOUNDATION PLAN**  
SCALE: 1/8"=1'-0"

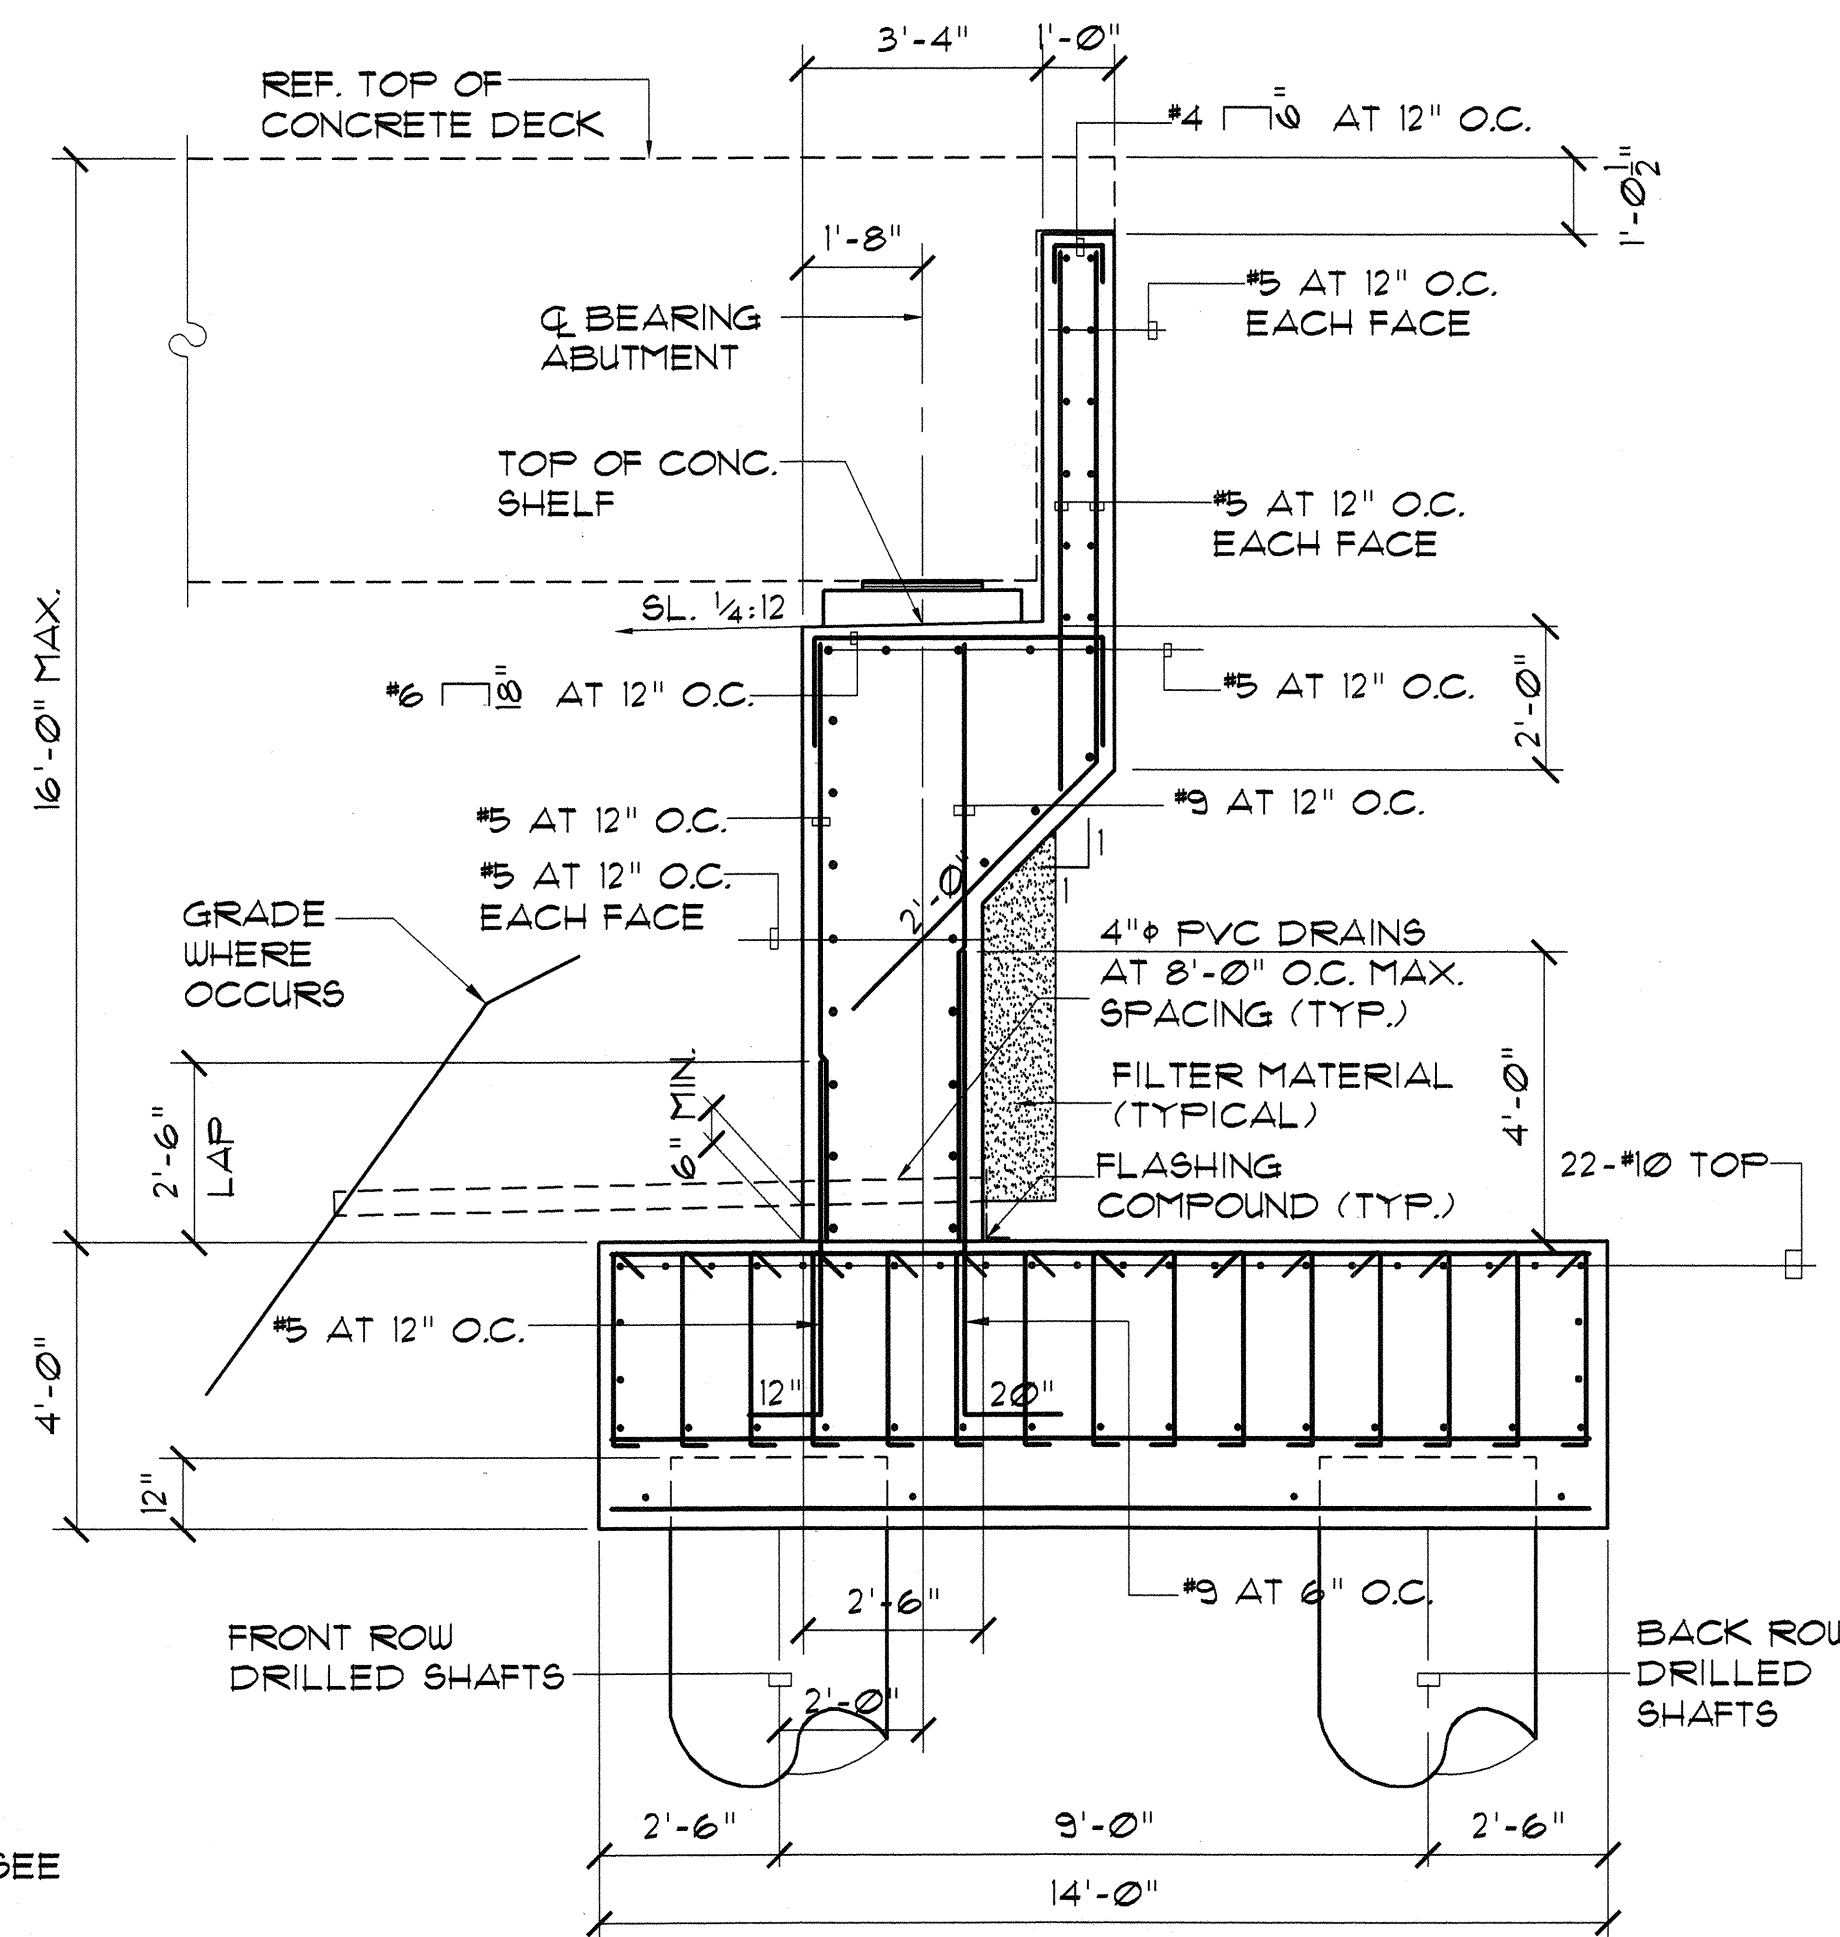


**ABUTMENT WALL SECT.**  
SCALE: 3/8"=1'-0"

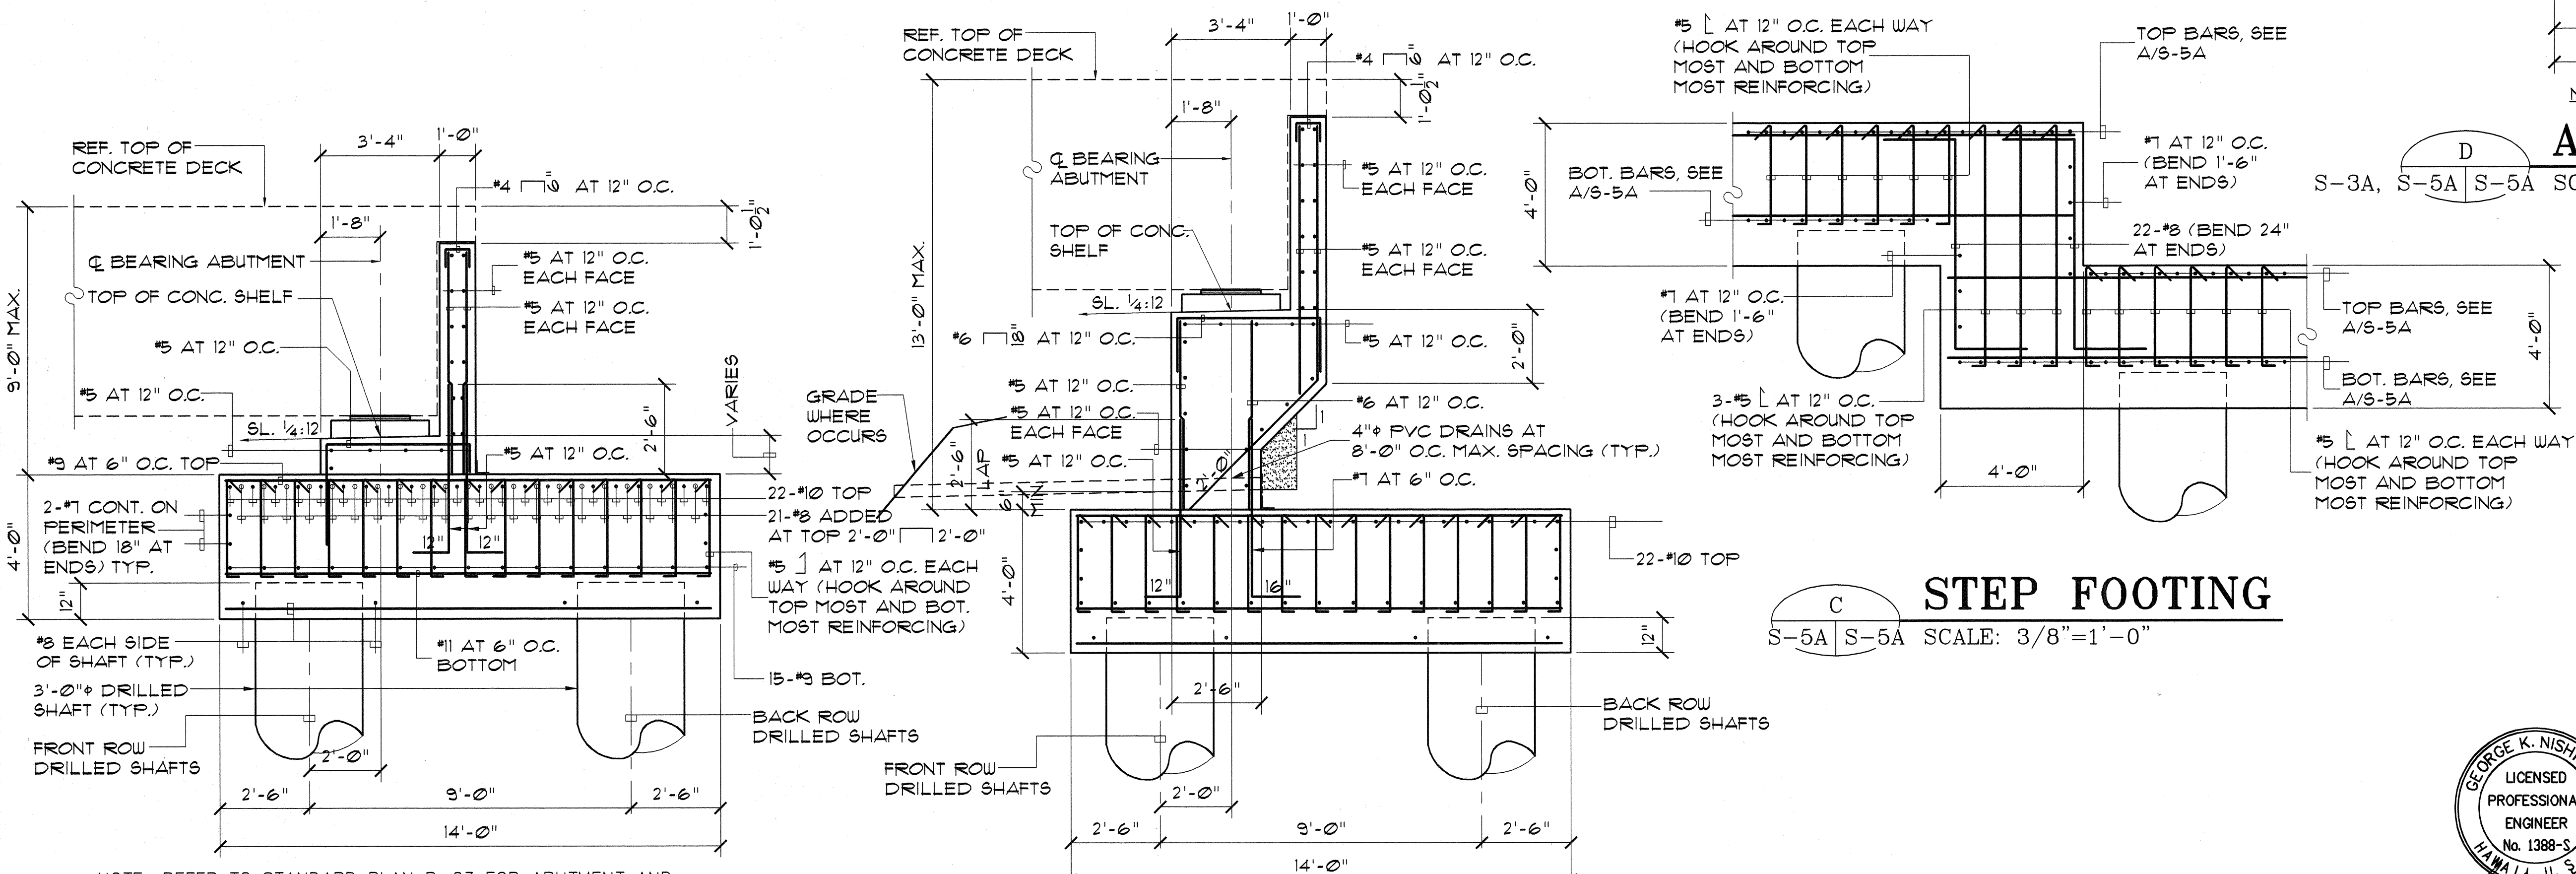

**STEP FOOTING**  
SCALE: 3/8"=1'-0"

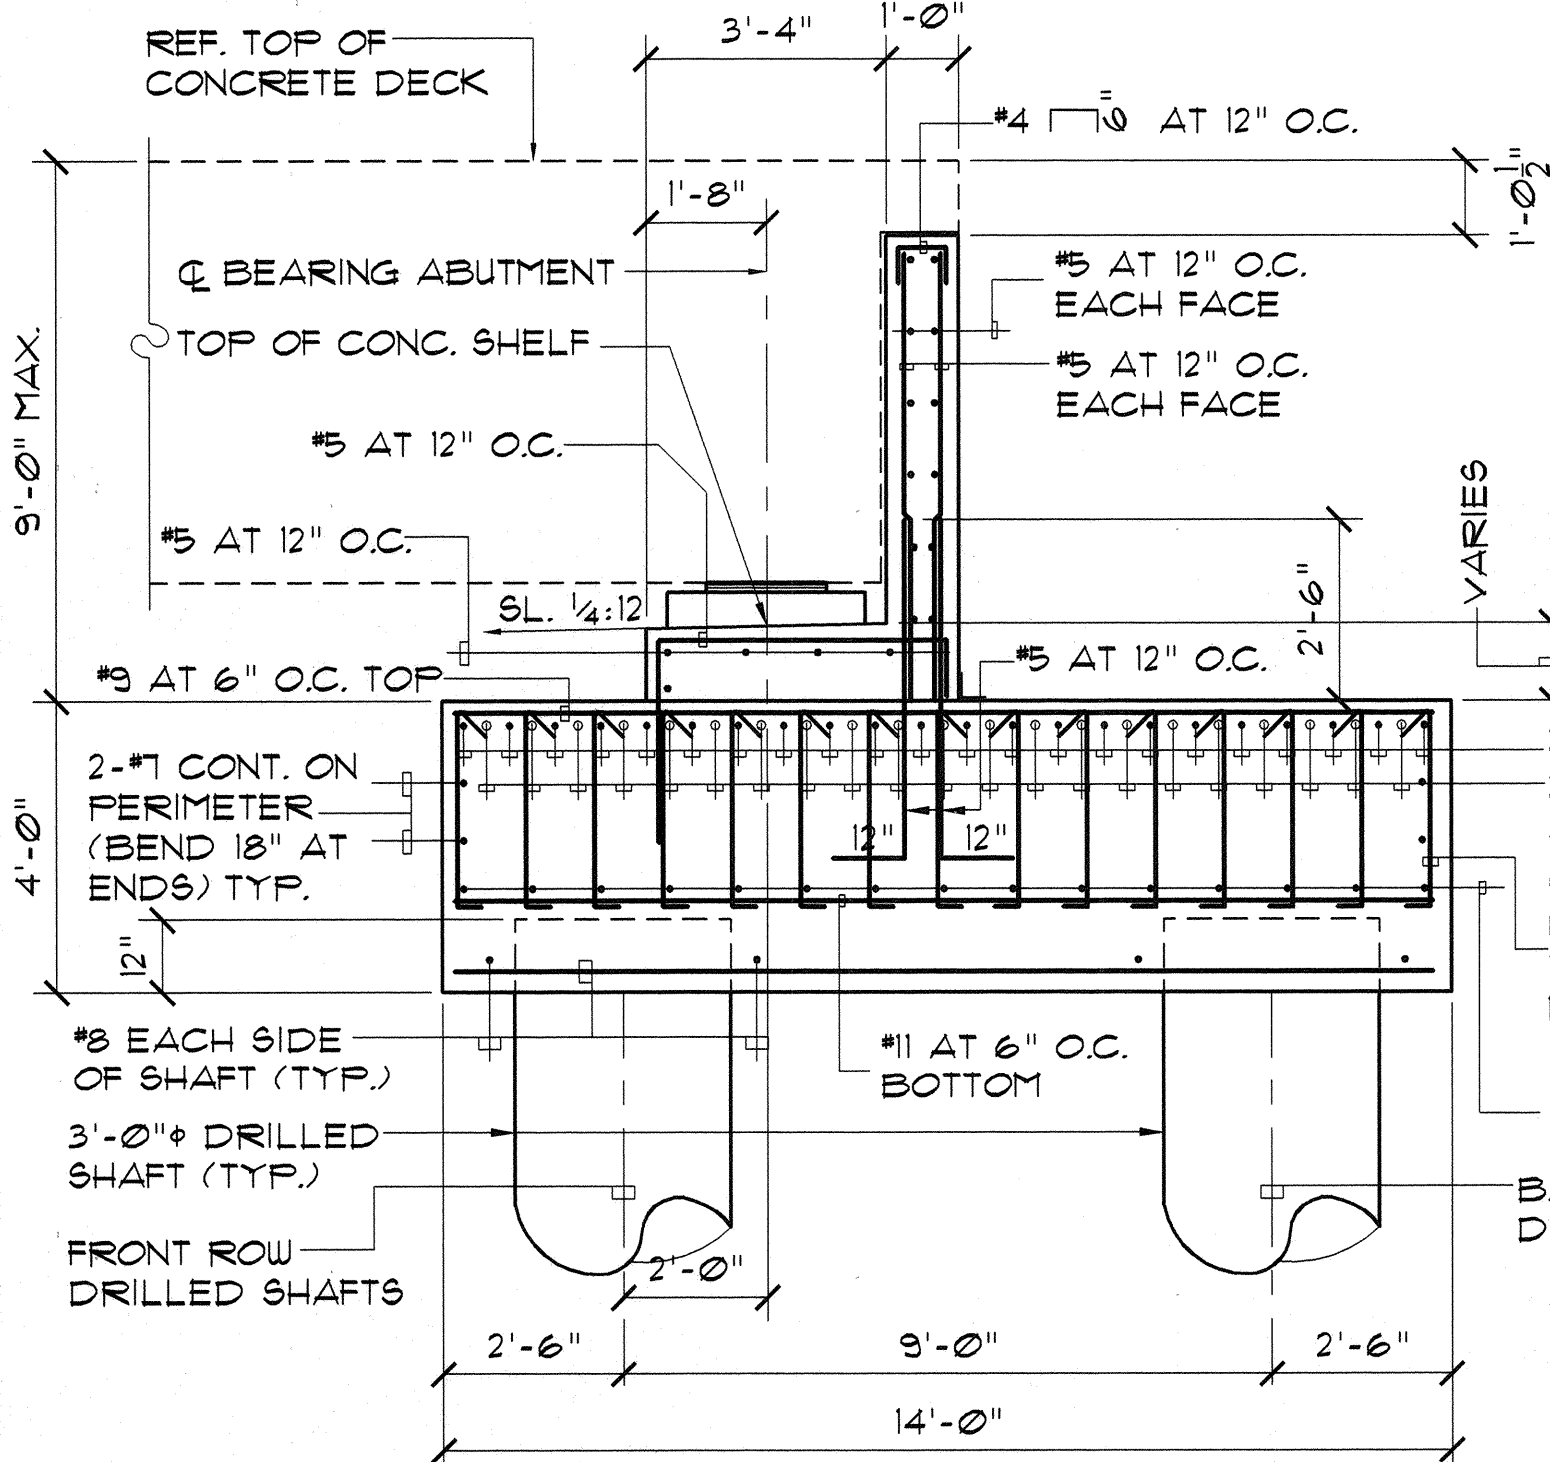


**ABUTMENT WALL SECT.**  
SCALE: 3/8"=1'-0"

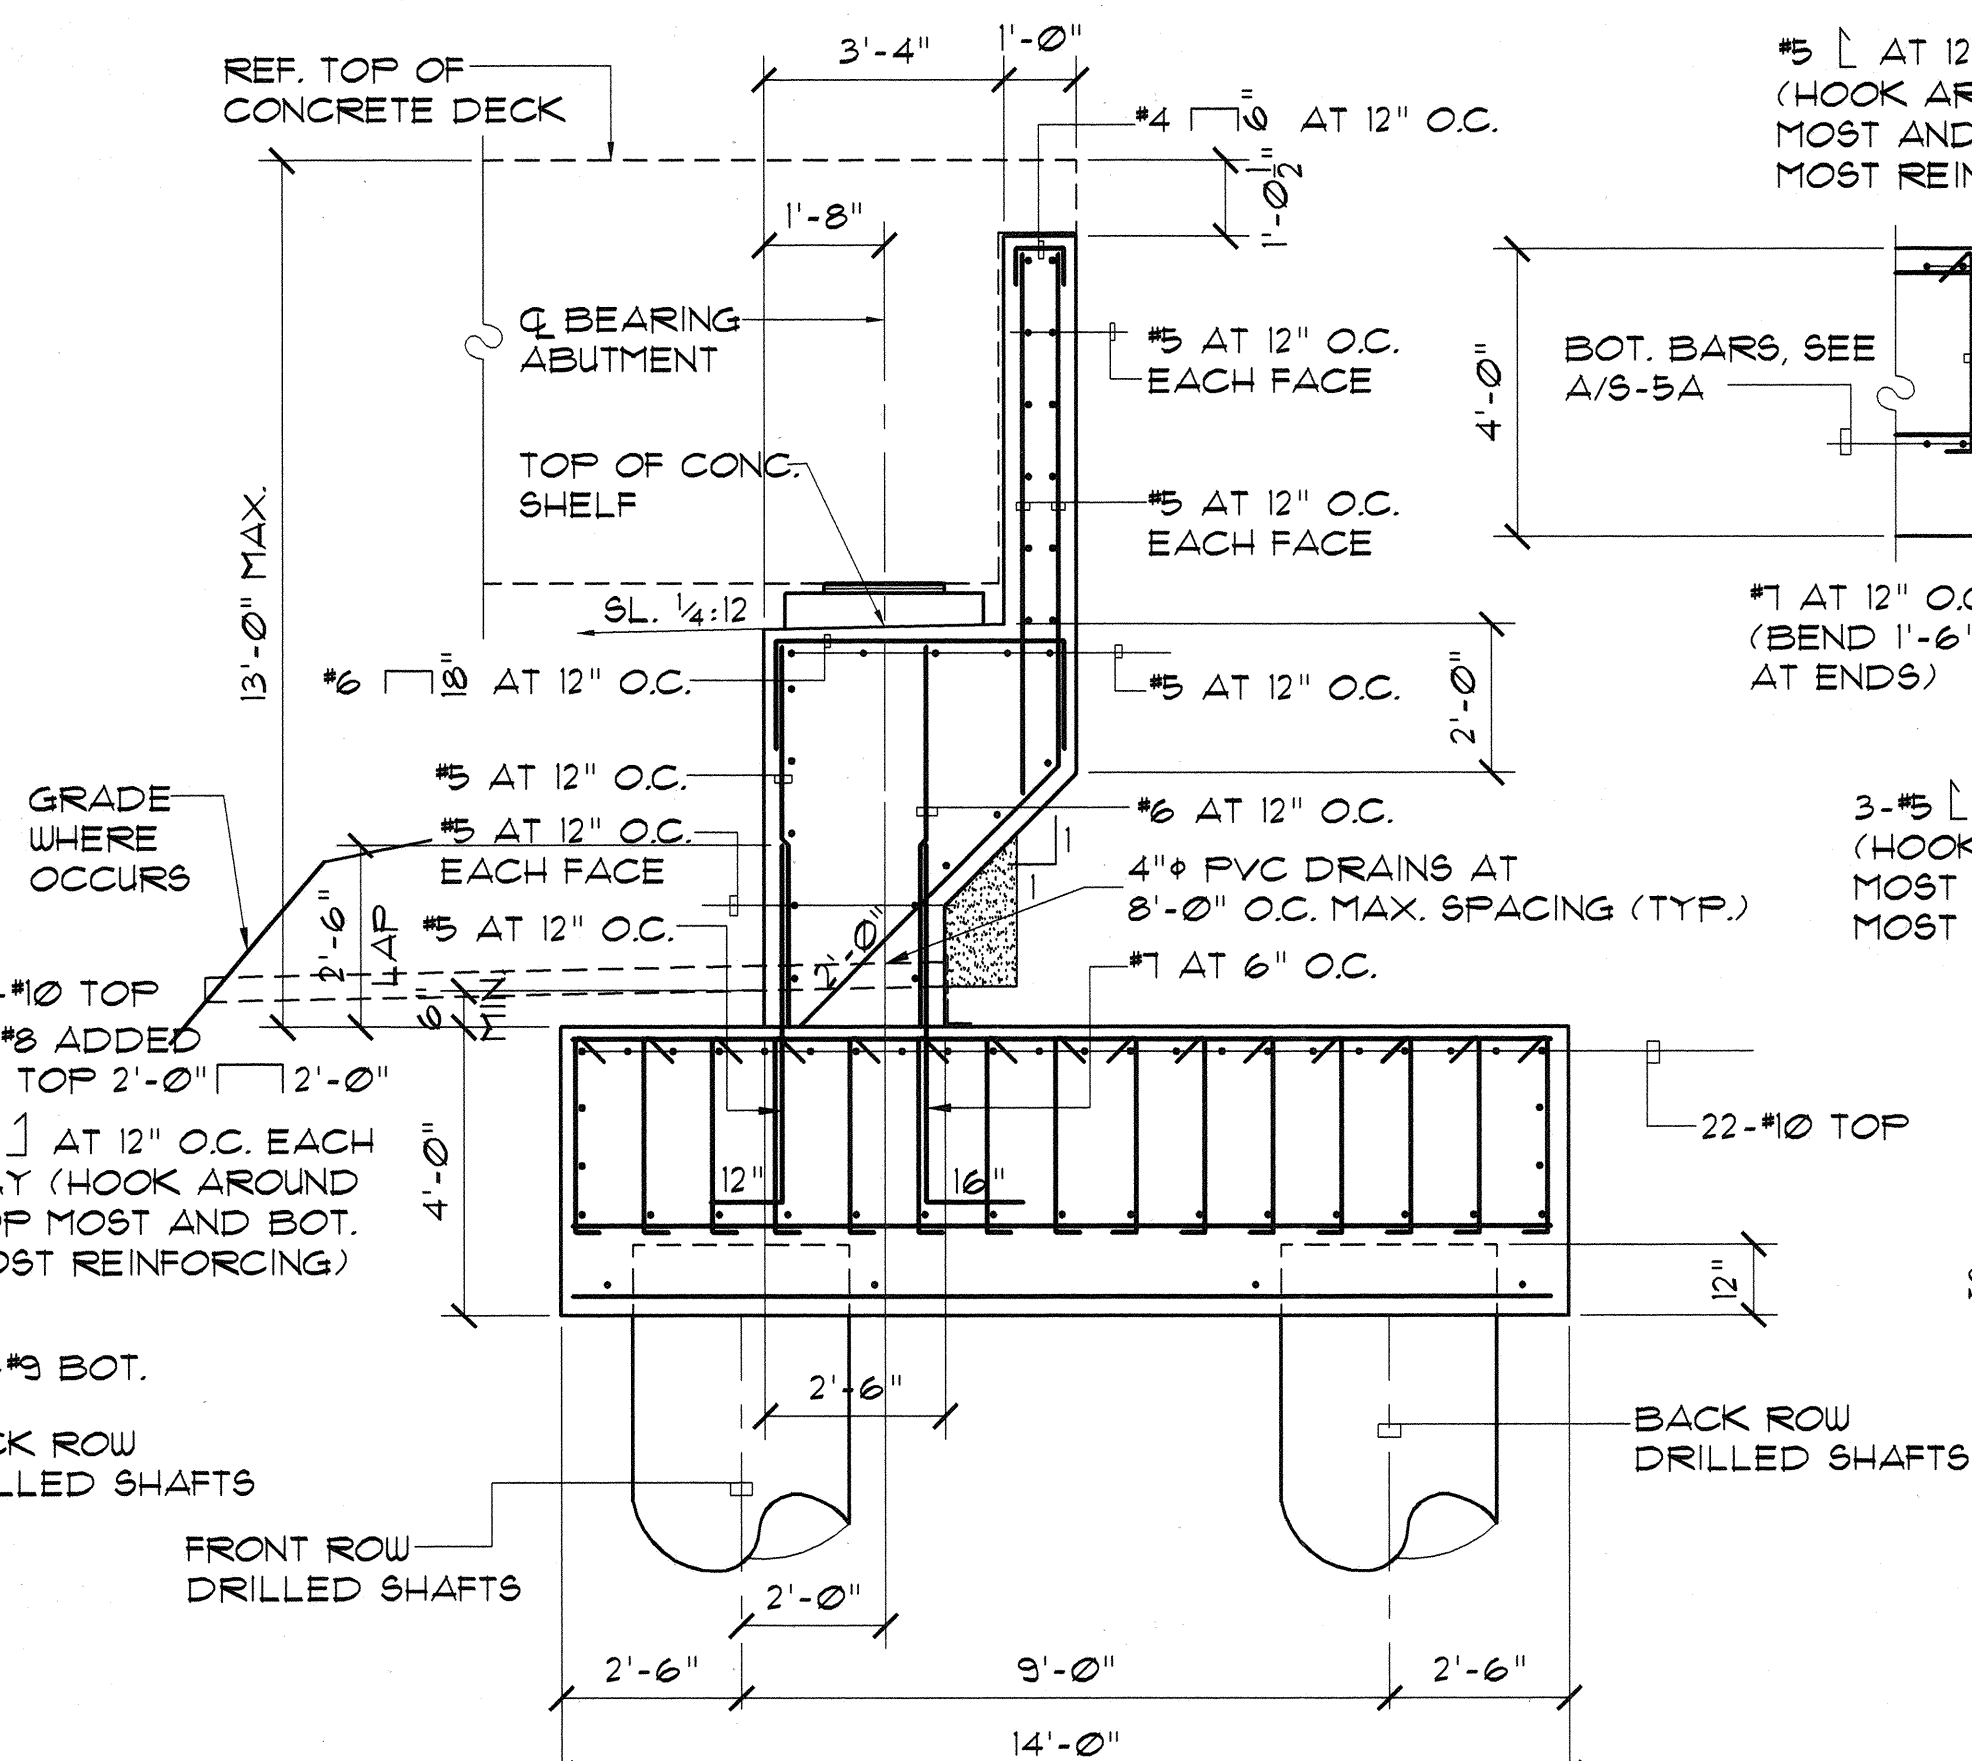

**ABUTMENT WALL SECT.**  
SCALE: 3/8"=1'-0"

6/5/02	Revised Drilled Shaft Locations
5/29/02	Revised Drilled Shaft Locations
3/18/02	SHEET ADDED
Date	Revision

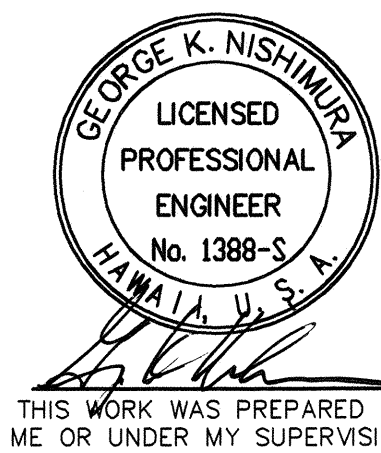


STATE OF HAWAII  
DEPARTMENT OF TRANSPORTATION  
HIGHWAYS DIVISION

ABUTMENT NO. 2 FOUNDATION  
PLAN, SECTIONS AND DETAILS

KAUMUALII HIGHWAY INTERSECTION  
IMPROVEMENTS AT KOLOA ROAD  
PROJECT NO. STP-050-1(17)

FED. ROAD DIST. NO.	STATE	FED. AID PROJ. NO.	FISCAL YEAR	SHEET NO.	TOTAL SHEETS
HAWAII	HAW.	STP-050-1 (17)	2000	48	72

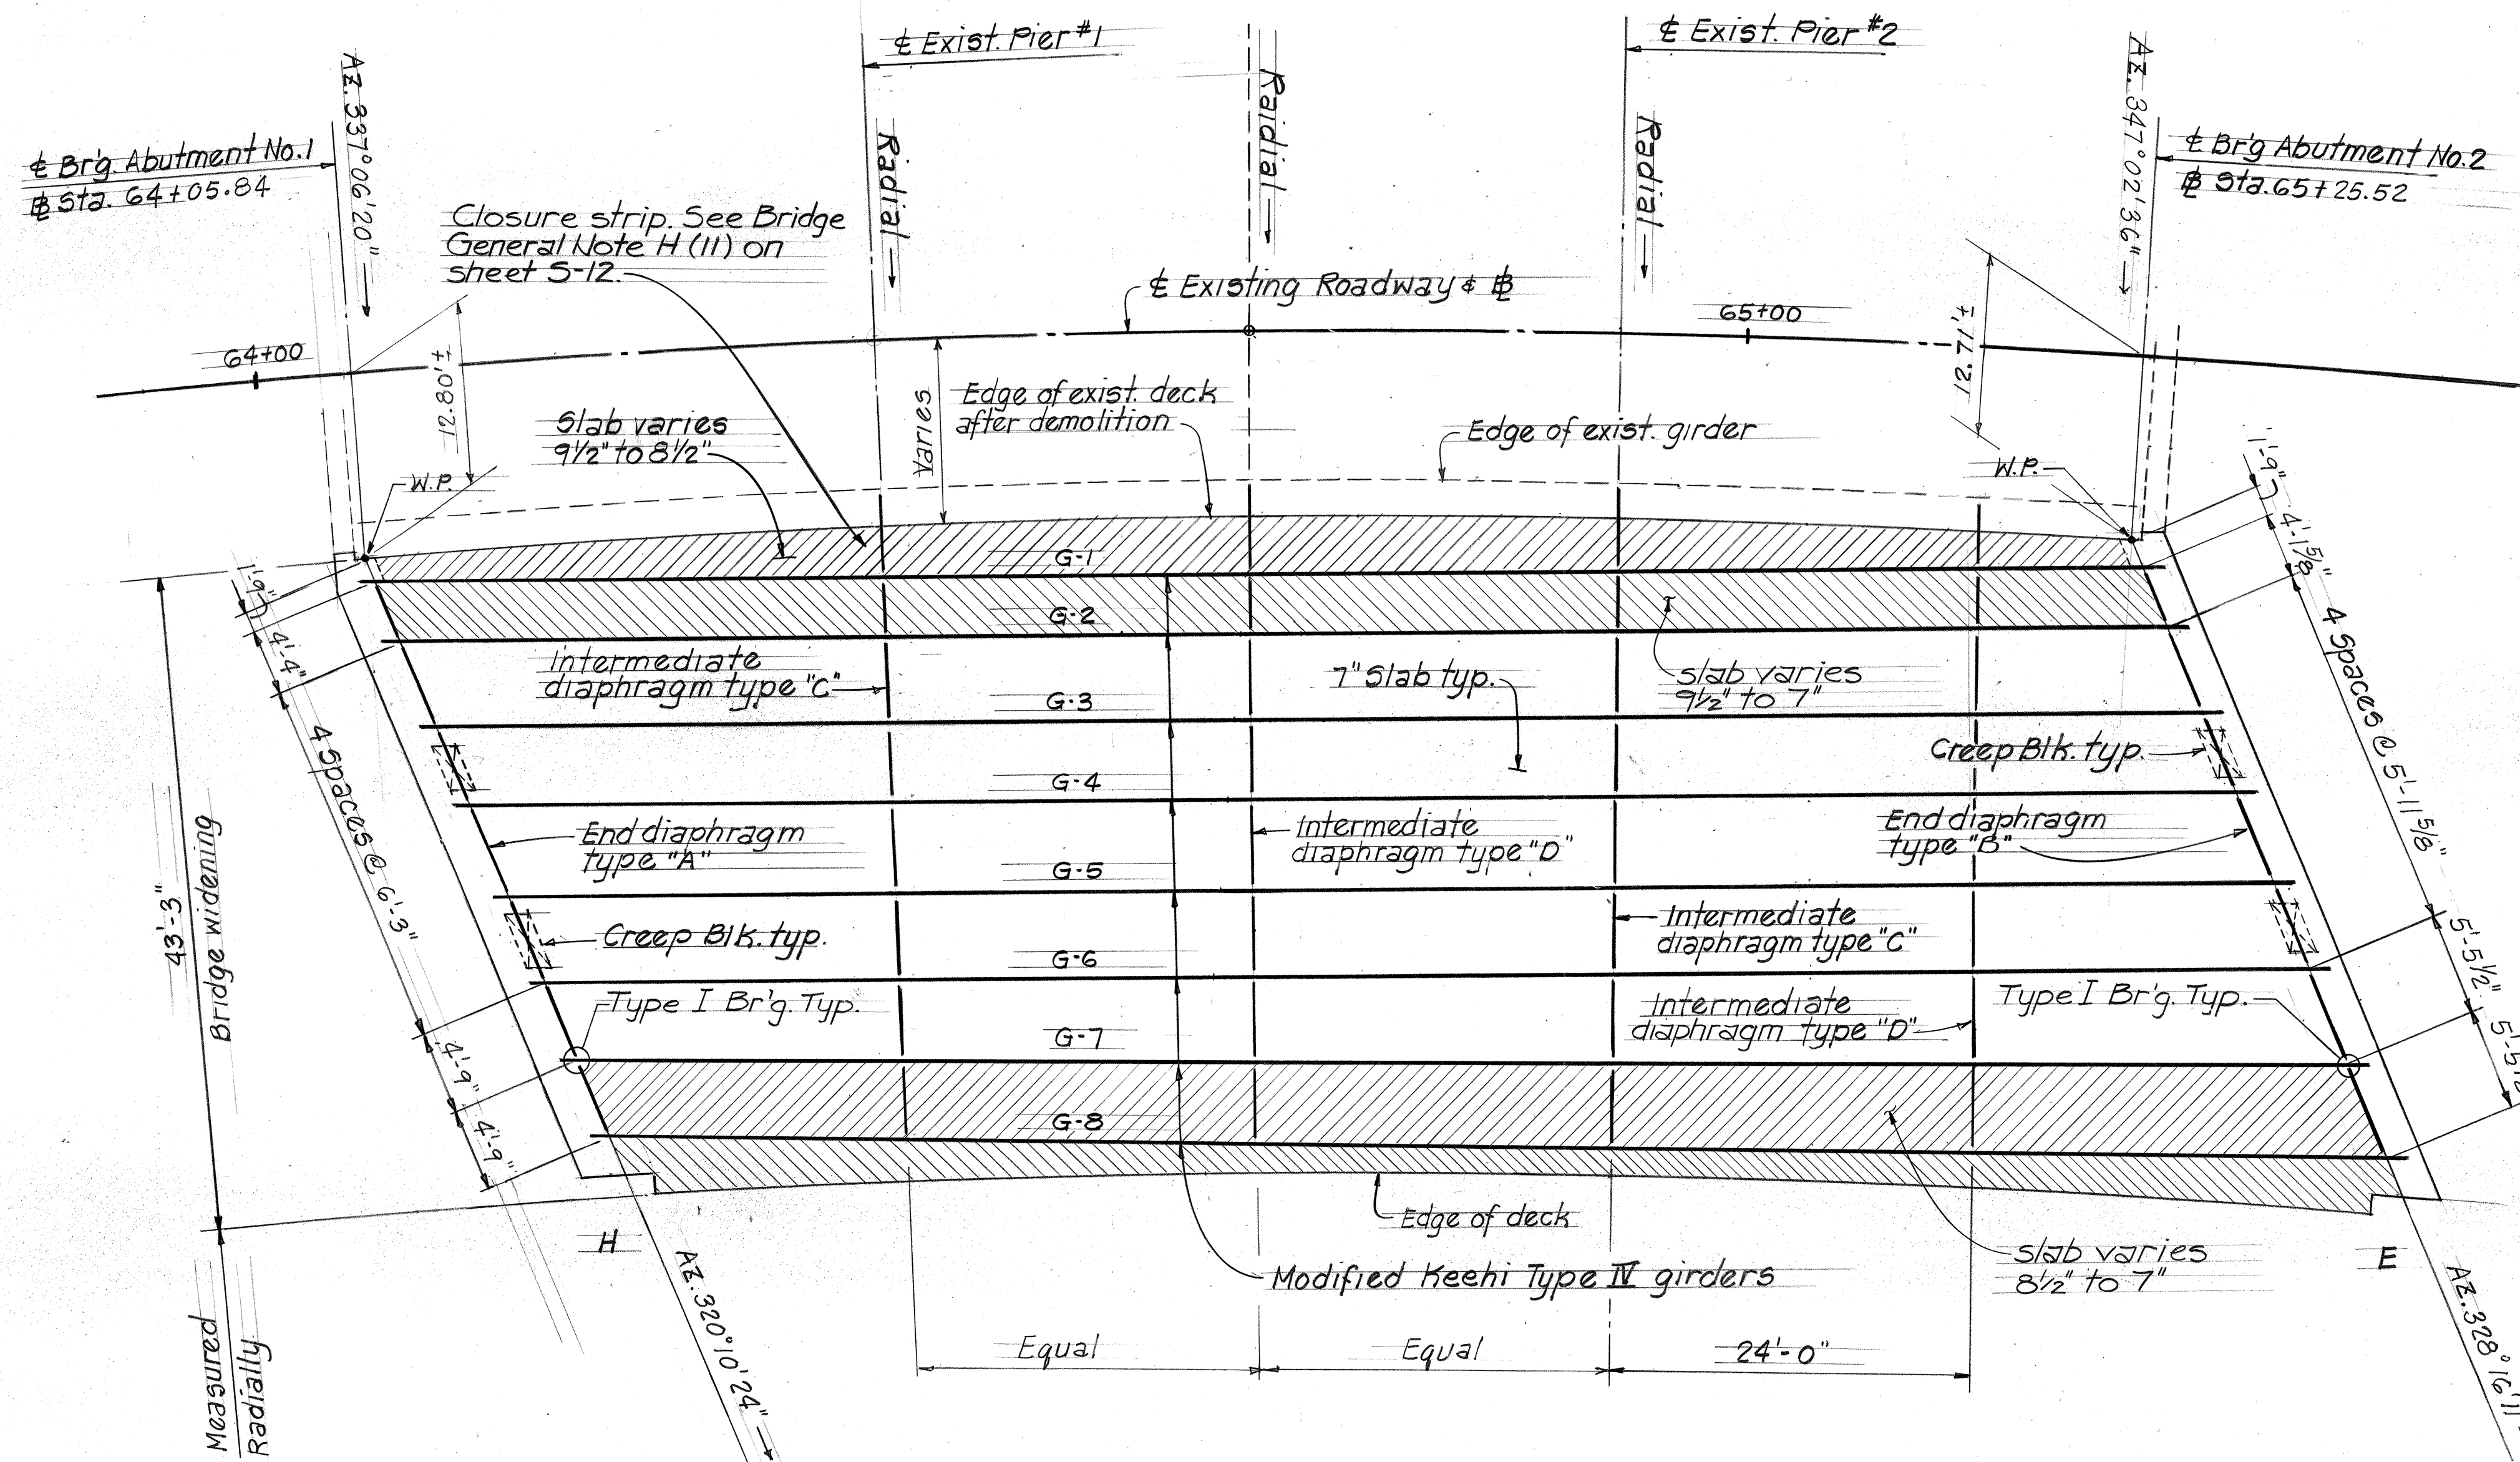


- NOTE:**
1. E- Denotes Expansion Bearing.
  2. H- Denotes Hinged Bearing.
  3. For Typical Intermediate diaphragm and End diaphragm details see shts. 5-8 & 5-9.
  4. For creep blocks - See detail on sheet 5-9.
  5. Refer to sheet 5-7 for Normal Deck Section & details.

**DECK FRAMING PLAN**  
Scale: 1/8"=1'-0"

ORIGINAL PLAN	SURVEY PLOTTED BY	DATE
NOTE BOOK	DRAWN BY	
	DESIGNED BY	
	CHECKED BY	
No.		


5/29/02	Remove stations at existing & Pier #1 and Pier #2.
1/30/02	Revise deck azimuths, dimensions, and stations.
Date	Revision

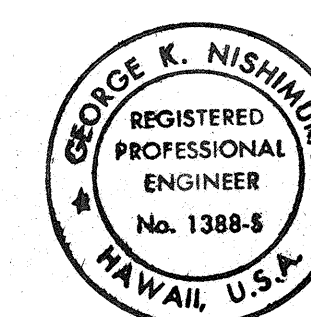


THIS WORK WAS PREPARED BY  
ME UNDER MY SUPERVISION  
*[Signature]*

STATE OF HAWAII DEPARTMENT OF TRANSPORTATION HIGHWAYS DIVISION
<b>DECK FRAMING PLAN</b>
KAUAI/ALII HIGHWAY INTERSECTION IMPROVEMENTS AT KOLOA ROAD
FEDERAL AID PROJ. NO. STP-050-1 (17)
SCALE: 1/8"=1'-0" DATE: OCT. 8, 1999
<b>SHEET NO. 5-6 OF 17 SHEETS</b>

FED. ROAD DIST. NO.	STATE	FED. AID PROJ. NO.	FISCAL YEAR	SHEET NO.	TOTAL SHEETS
HAWAII	HAW.	STP-050-1(17)	2000	49	72

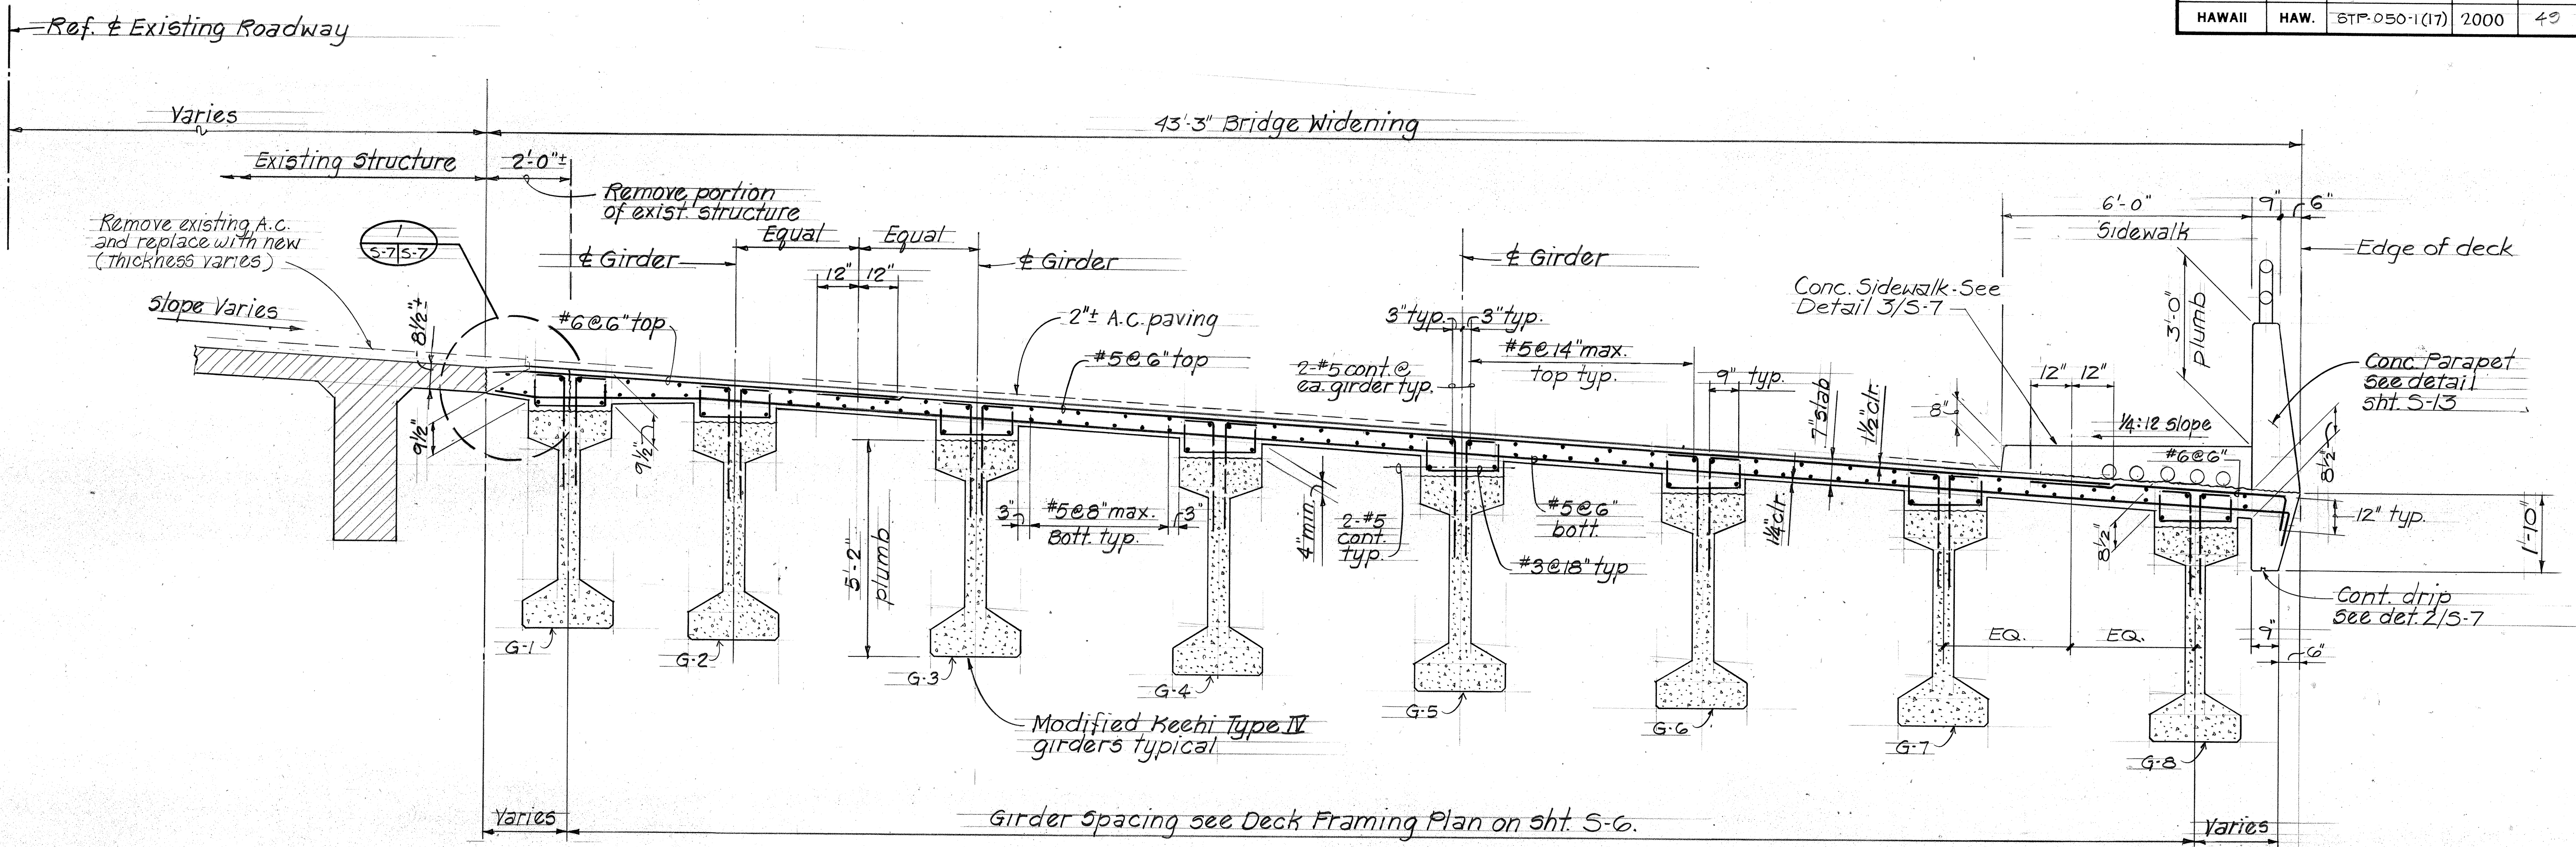


**NORMAL DECK SECTION**  
Scale: 1/2"=1'-0"

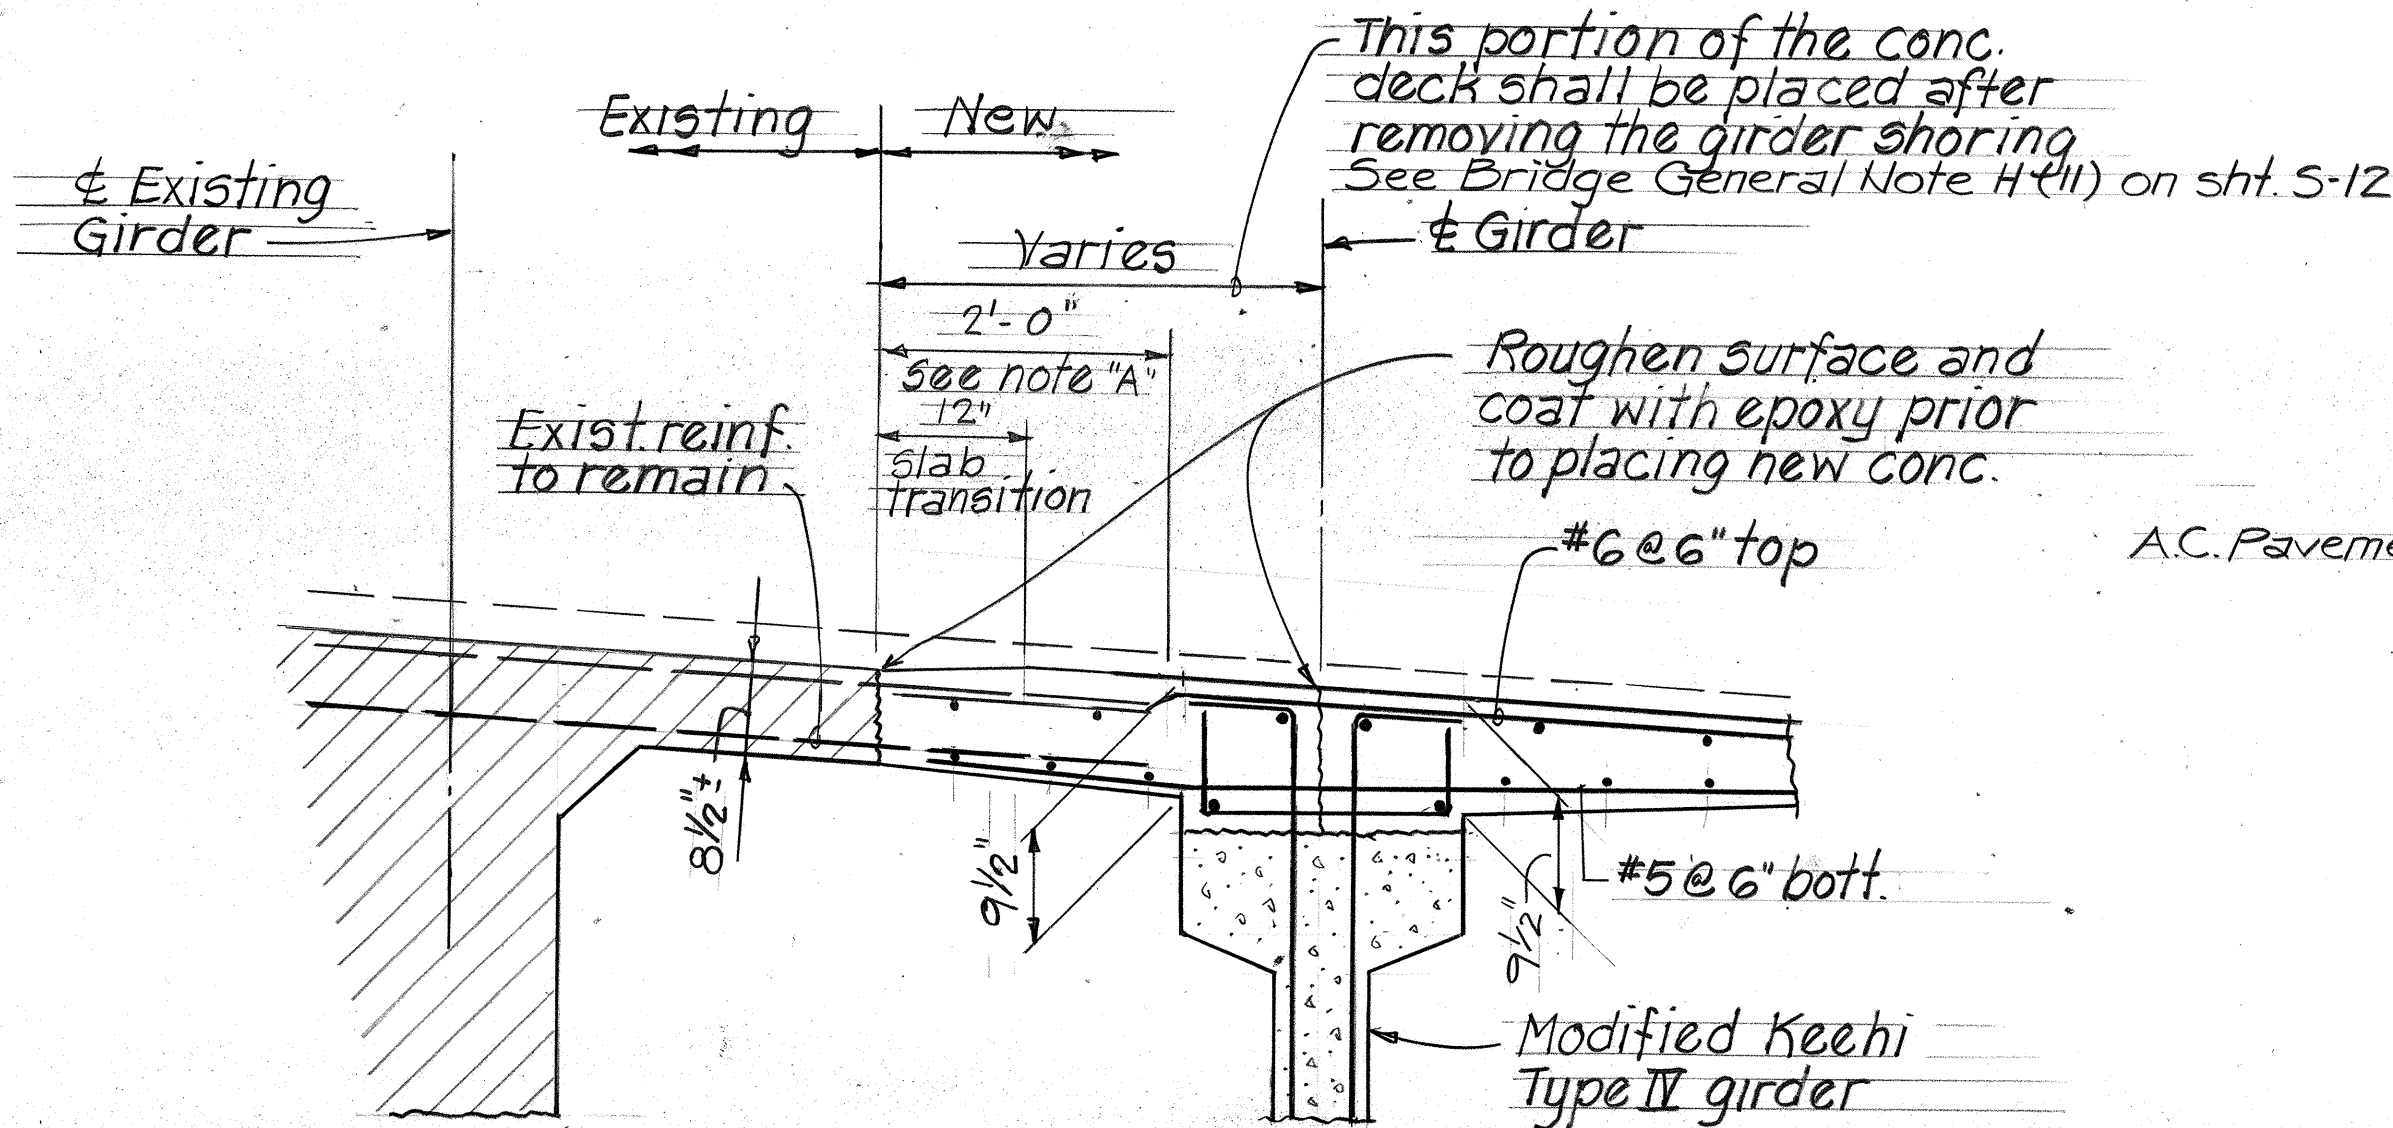


**NOTE "A"**  
Remove 2'-0" portion of existing deck and railing. Existing deck transverse reinforcing to remain. When removing existing conc. deck, the top of the conc. deck shall be saw cut to a depth of 1" and the balance chipped out.

**1 DETAIL**  
Scale: 3/4"=1'-0"

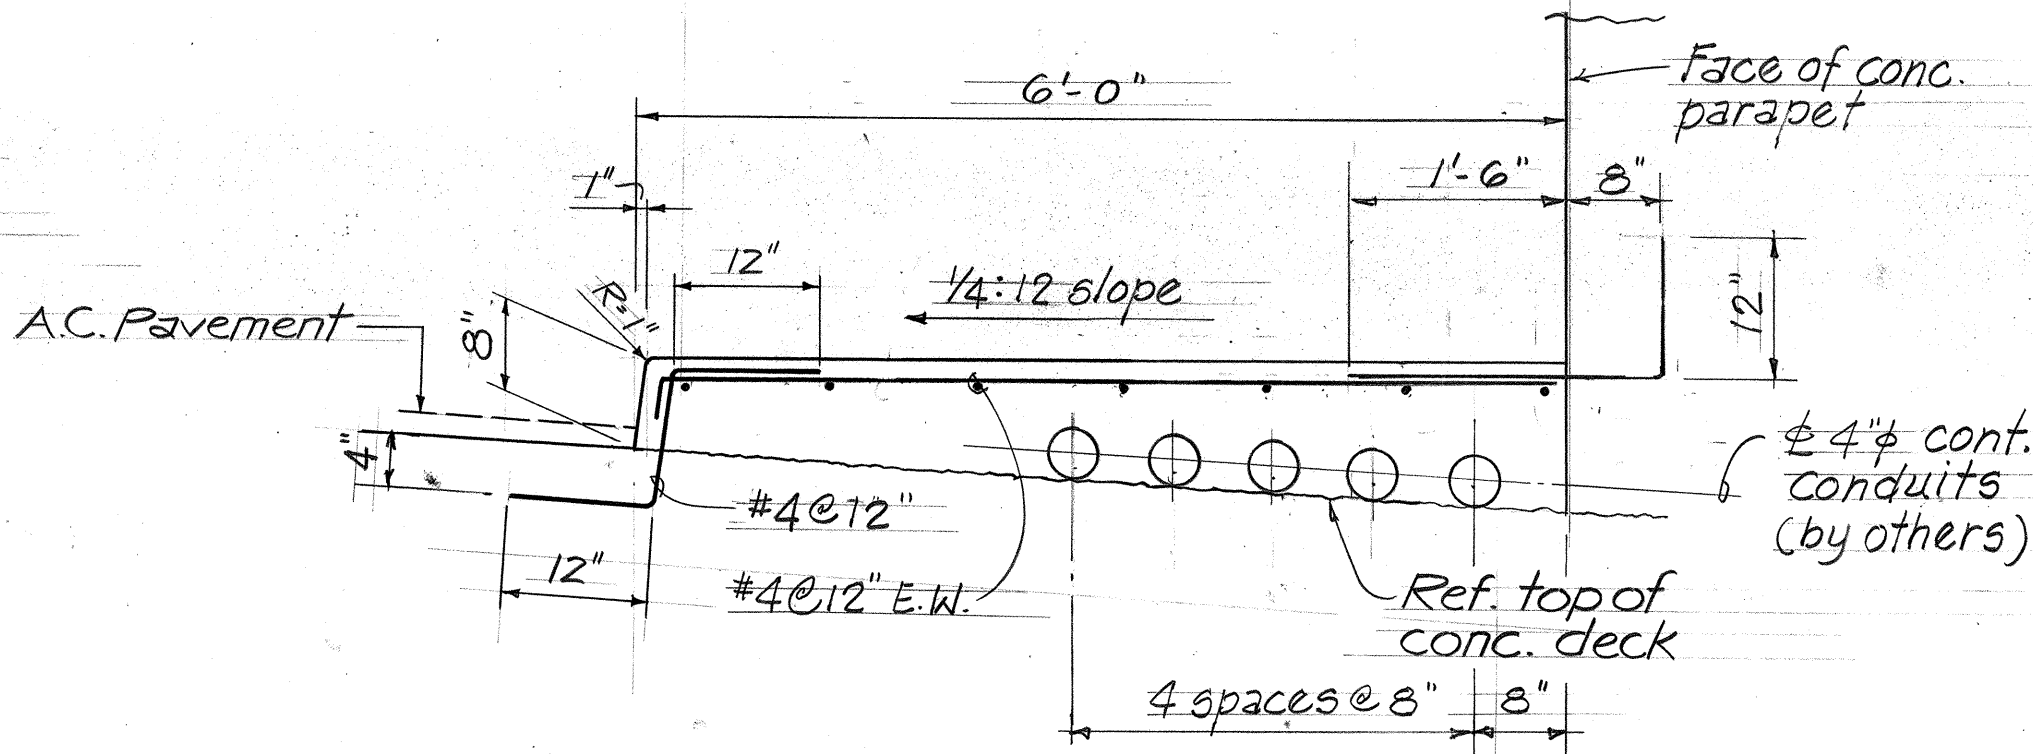

**3 DETAIL**  
Scale: 3/4"=1'-0"

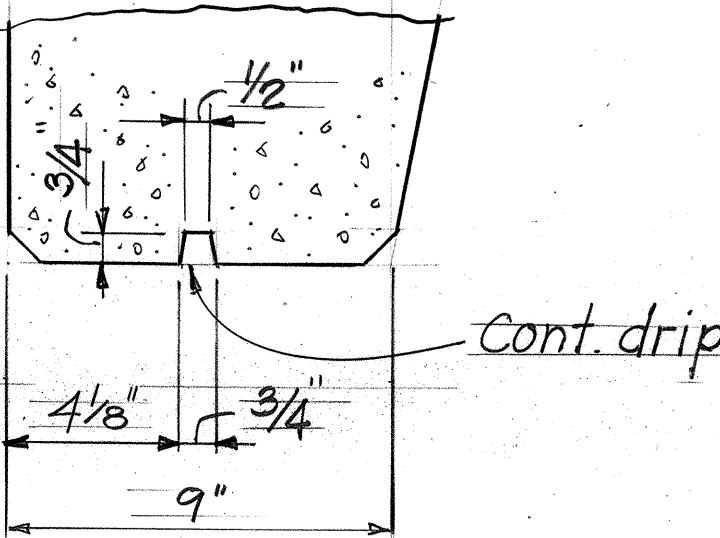

**2 DRIP DETAIL**  
Scale: 3"=1'-0"


1/30/02	Revise dimensions and add conduits in sidewalk.
Date	Revision
STATE OF HAWAII DEPARTMENT OF TRANSPORTATION HIGHWAYS DIVISION <b>NORMAL DECK SECTION &amp; DETAILS</b> KAUMUALII HIGHWAY INTERSECTION IMPROVEMENTS AT KOLOA ROAD FEDERAL AID PROJ. NO. STP-050-1(17) SCALE: AS NOTED DATE: OCT. 8, 1999 <b>SHEET NO. 5-7 OF 17 SHEETS</b>	

5/29/02	Revise detail connection at existing deck to new deck.
3/18/02	Revise 5-4" conduits to be by others
Date	Revision




THIS WORK WAS PREPARED BY  
ME OR UNDER MY SUPERVISION  
*[Signature]*

ORIGINAL PLAN	DATE
SURVEY PLOTTED BY	
DRAWN BY	
DESIGNED BY	
QUANTITIES BY	
CHECKED BY	
NO.	

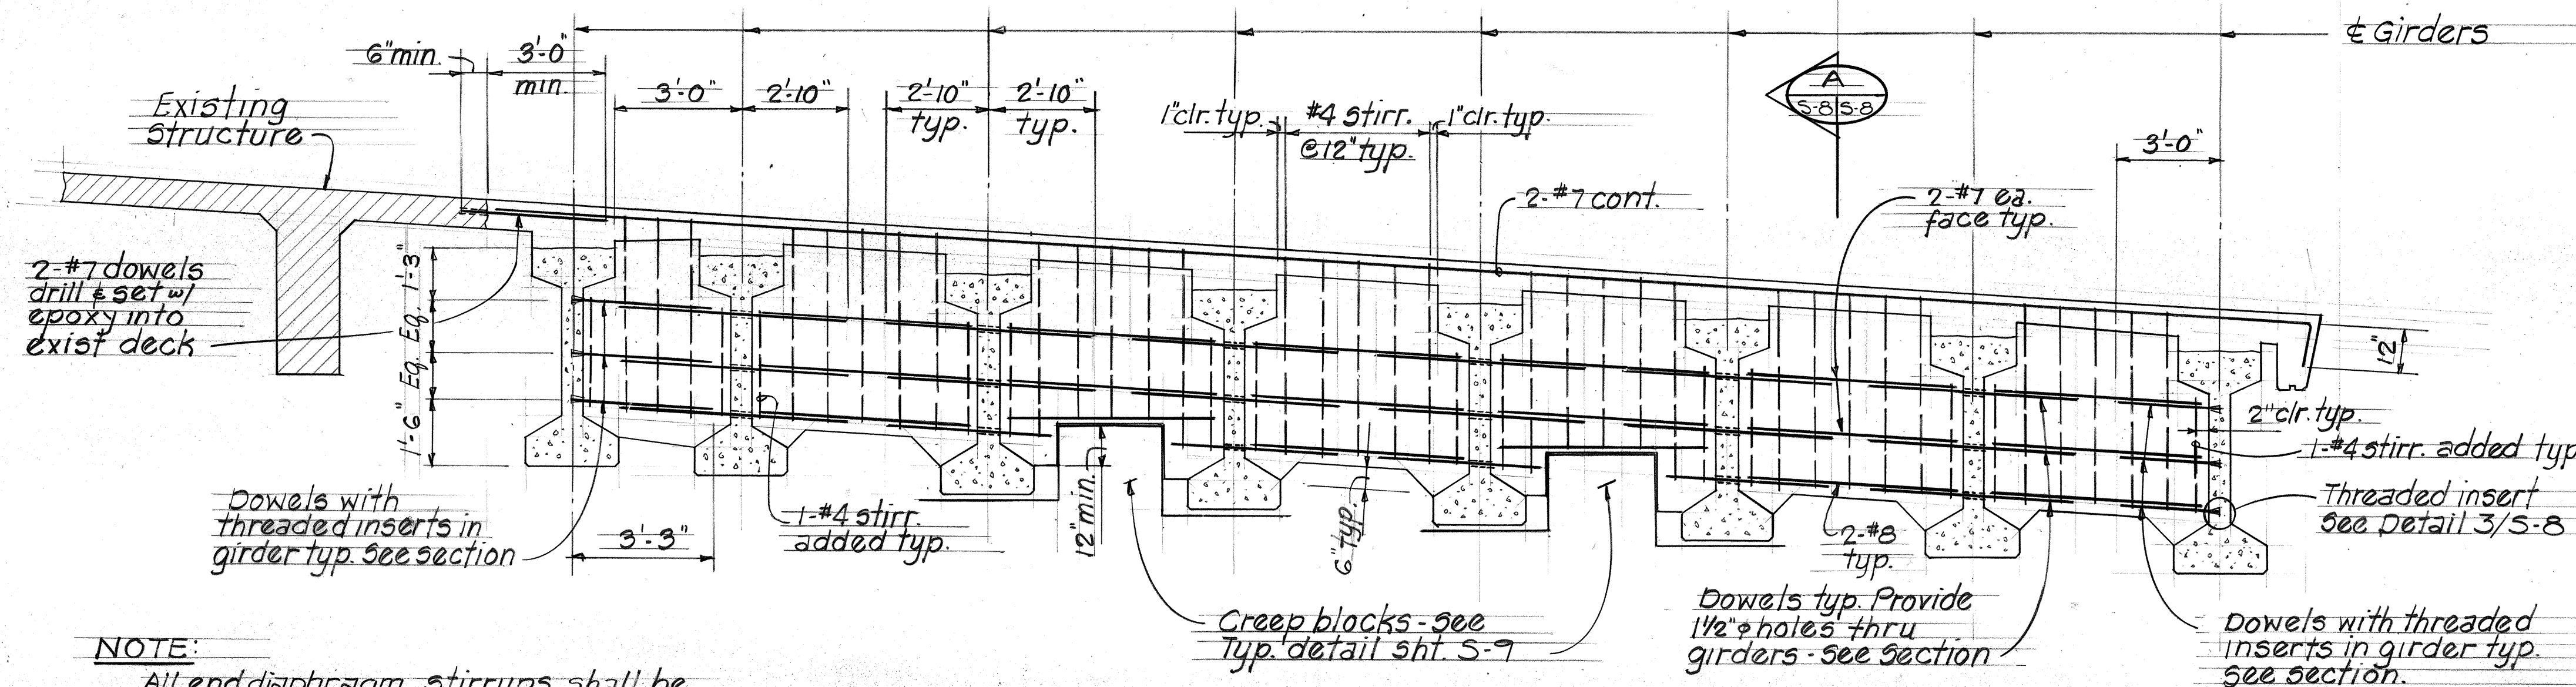


**TYPICAL END DIAPHRAGM "A" & "B" ELEVATION**

Scale: 3/8"=1'-0"

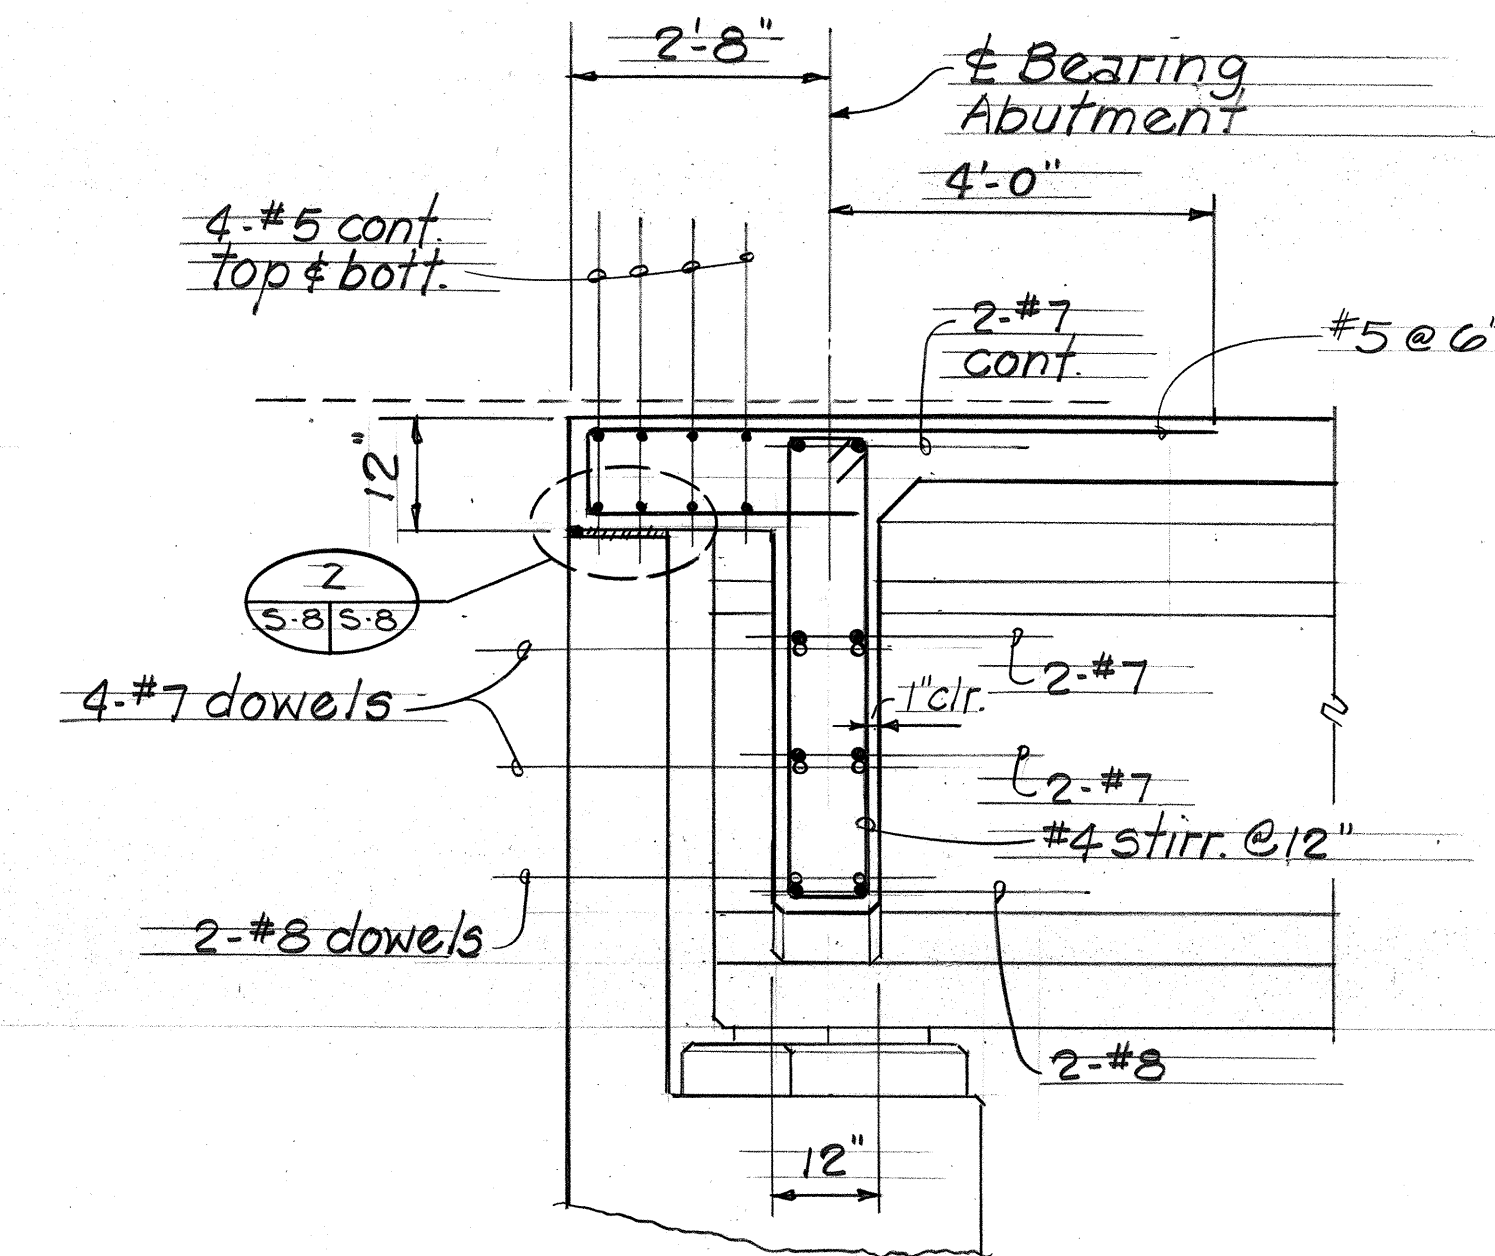

**SECTION A**


Scale: 1/2"=1'-0"

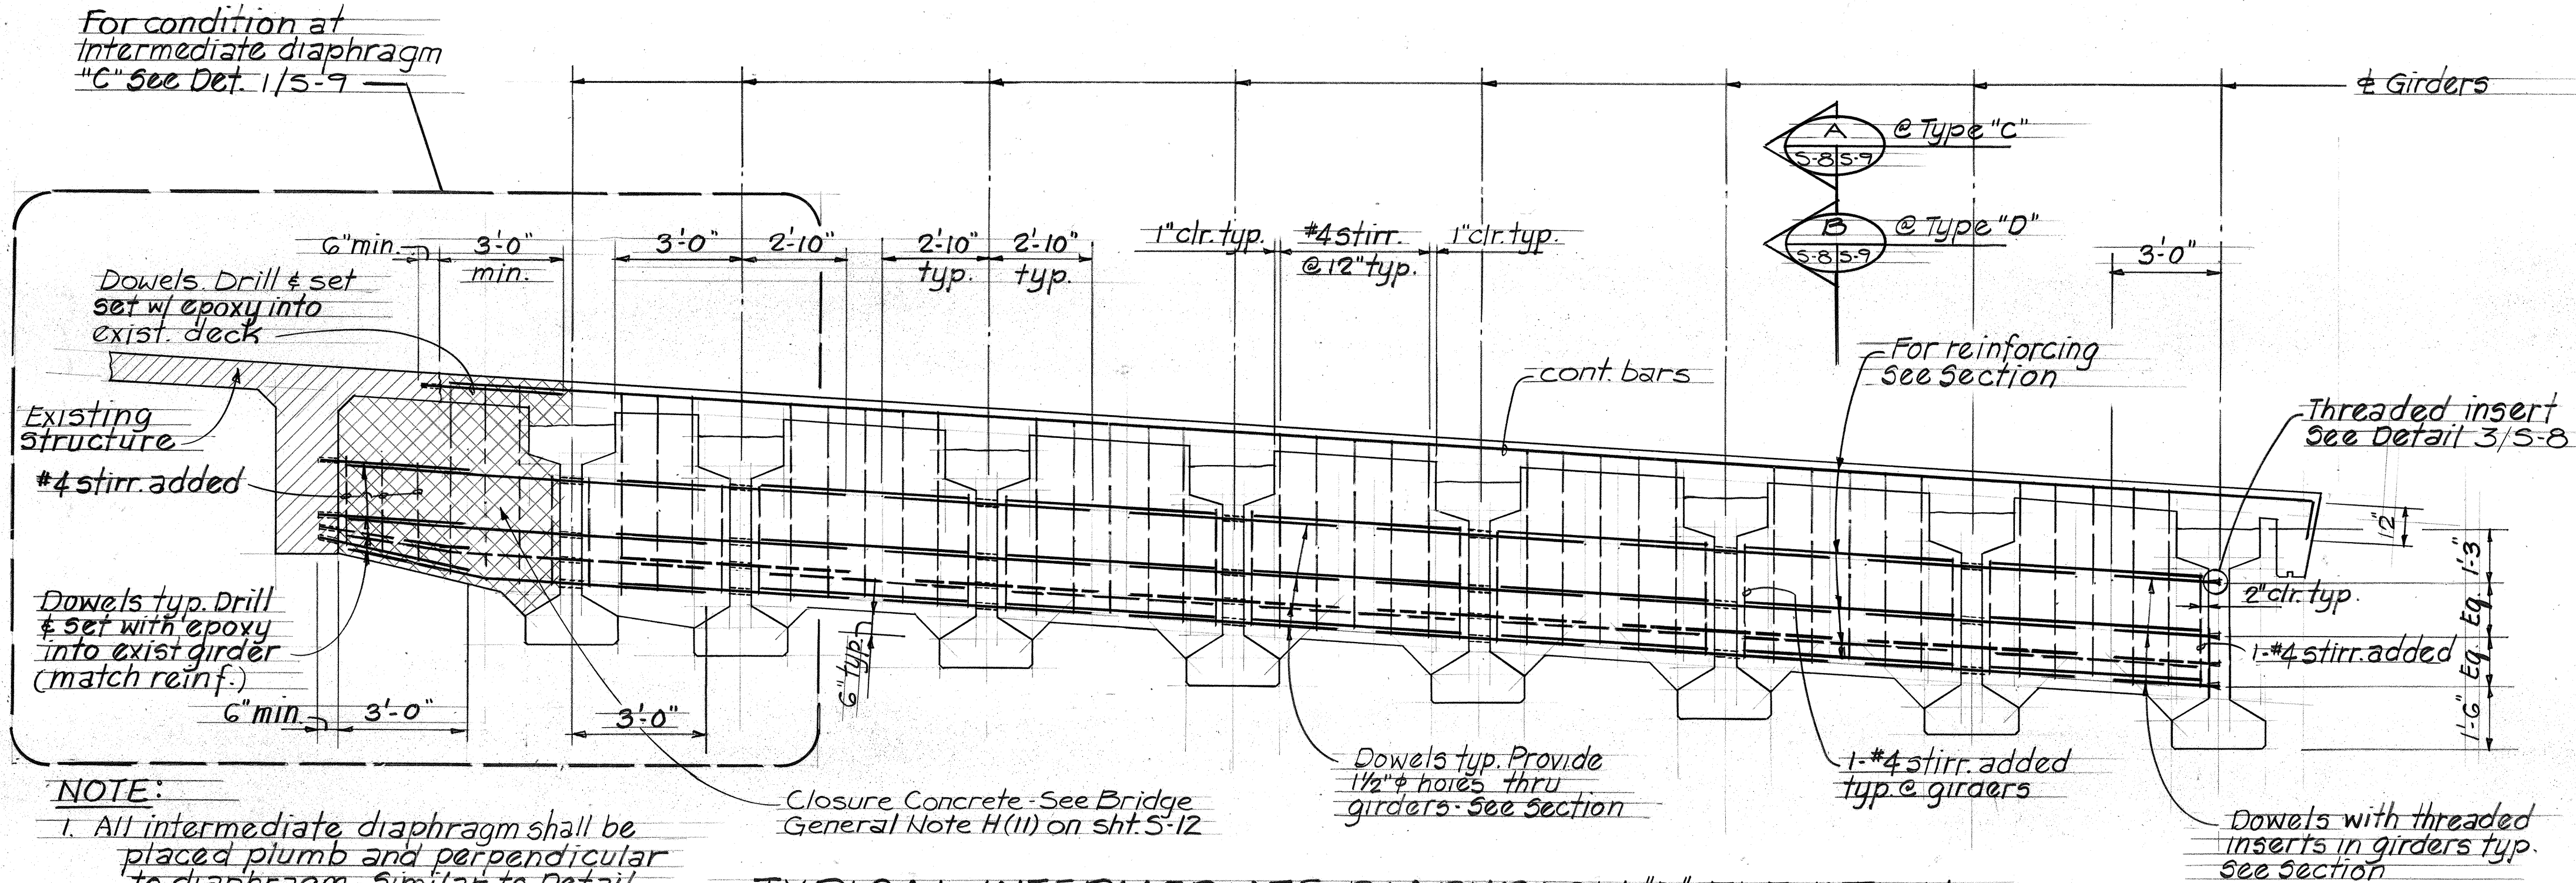

**TYPICAL INTERMEDIATE DIAPHRAGM "D" ELEVATION**

Scale: 3/8"=1'-0"

DIAPHRAGM "C" SIMILAR EXCEPT AS NOTED

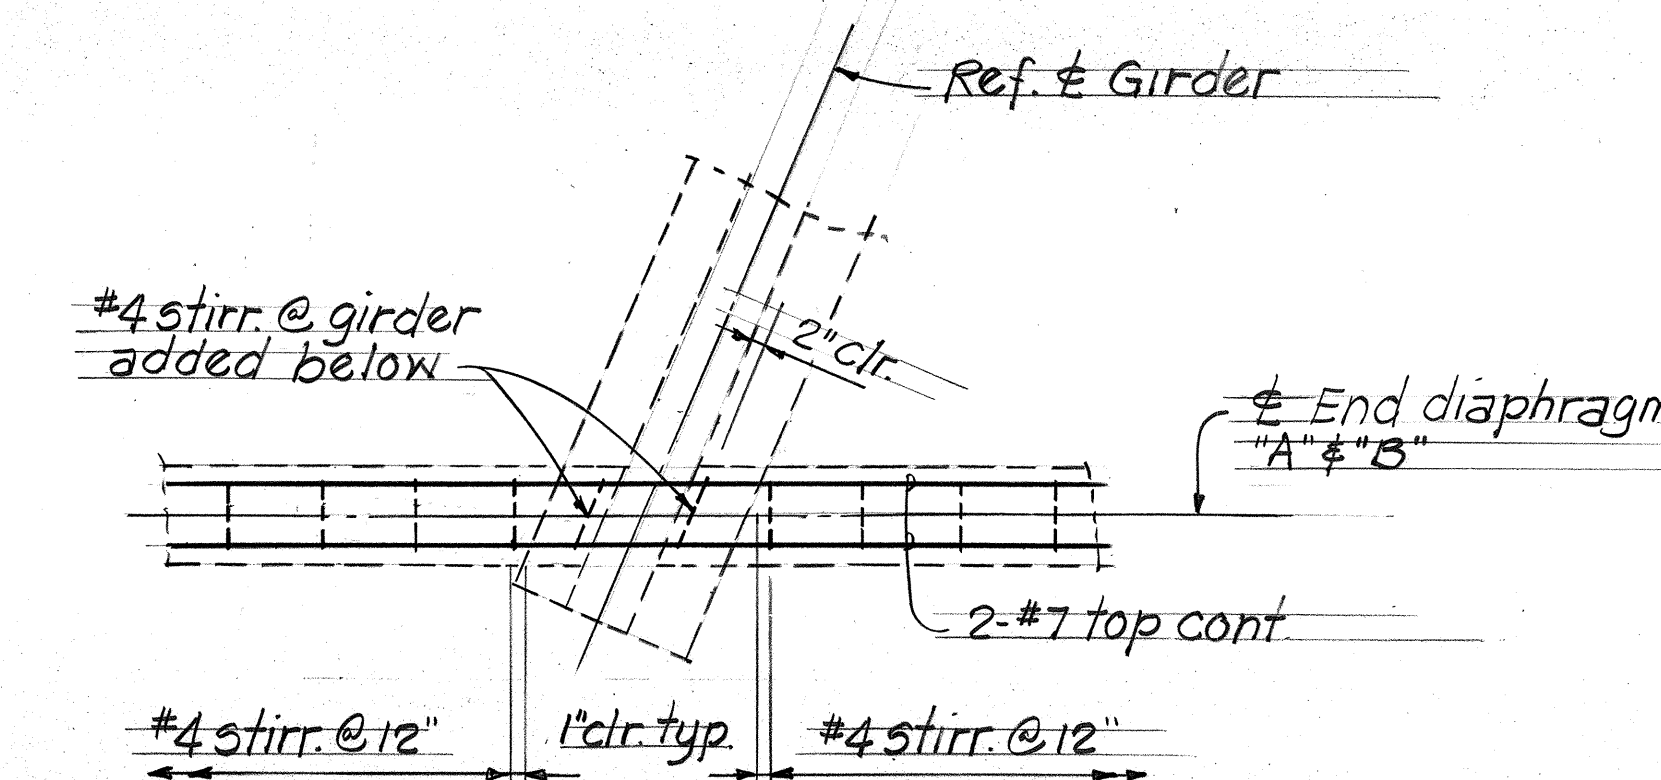

**PLAN-SHOWING STIRRUP PLACEMENT**


Scale: 1/2"=1'-0"

DATE: \_\_\_\_\_

DESIGNED BY: \_\_\_\_\_


CHECKED BY: \_\_\_\_\_

NO. \_\_\_\_\_

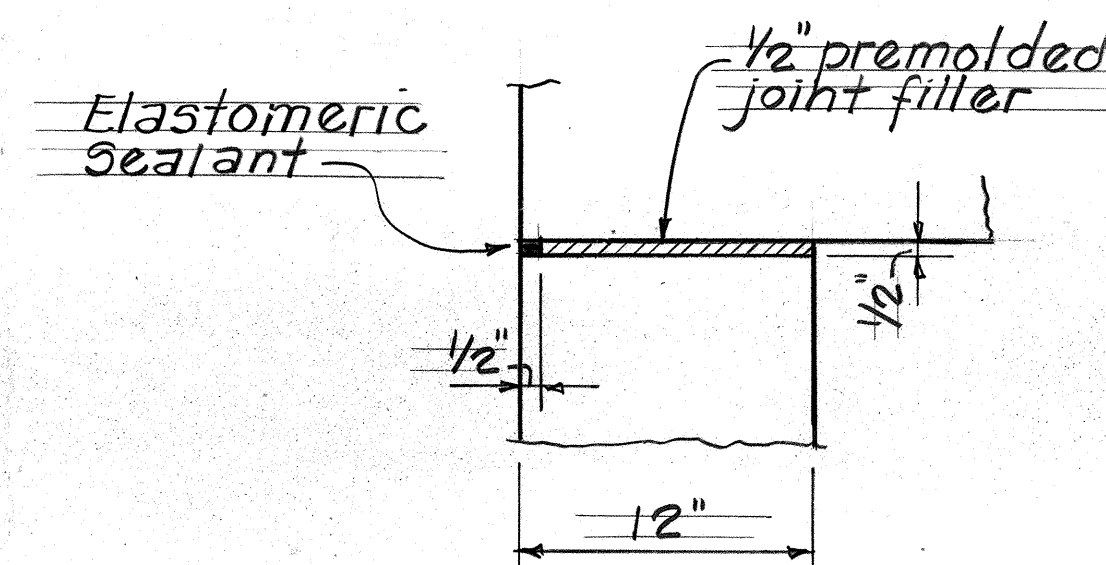

**DETAIL 2**

Scale: 1 1/2"=1'-0"

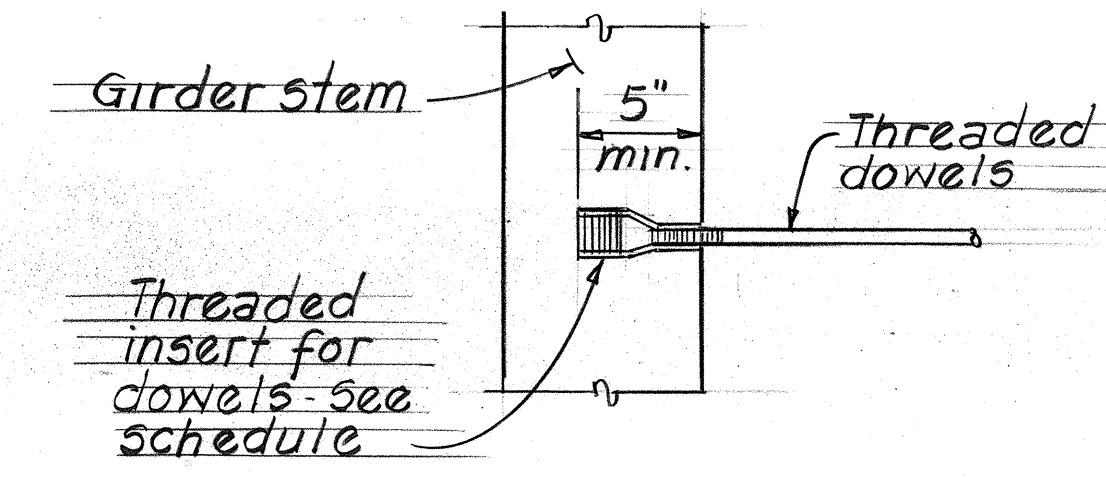


**THREADED INSERT DETAIL 3**

Scale: 1 1/2"=1'-0"

THREADED INSERT SCHEDULE *		
Dowel Size	Allow. tension	Allow. shear
#8 Dowels	7.8 kips	6.0 kips
#7 Dowels	6.1 kips	5.0 kips
#6 Dowels	5.1 kips	4.5 kips

\* - Based on safety factor of 3.

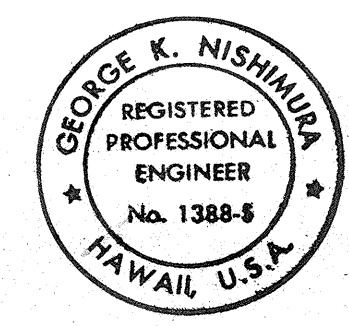

THIS WORK WAS PREPARED BY ME OR UNDER MY SUPERVISION.


STATE OF HAWAII  
DEPARTMENT OF TRANSPORTATION  
HIGHWAYS DIVISION

**DIAPHRAGM "A", "B", "C", & "D" ELEVATION, SECTION AND DETAIL**

KAUAI HIGHWAY INTERSECTION  
IMPROVEMENTS AT KOLOA ROAD  
FEDERAL AID PROJ. NO. STP-050-1(17)  
SCALE: AS NOTED DATE: OCT. 8, 1999


**SHEET No. 5-8 OF 17 SHEETS**

FED. ROAD DIST. NO.	STATE	FED. AID PROJ. NO.	FISCAL YEAR	SHEET NO.	TOTAL SHEETS
HAWAII	HAW.	STP-050-1 (17)	2000	51	72

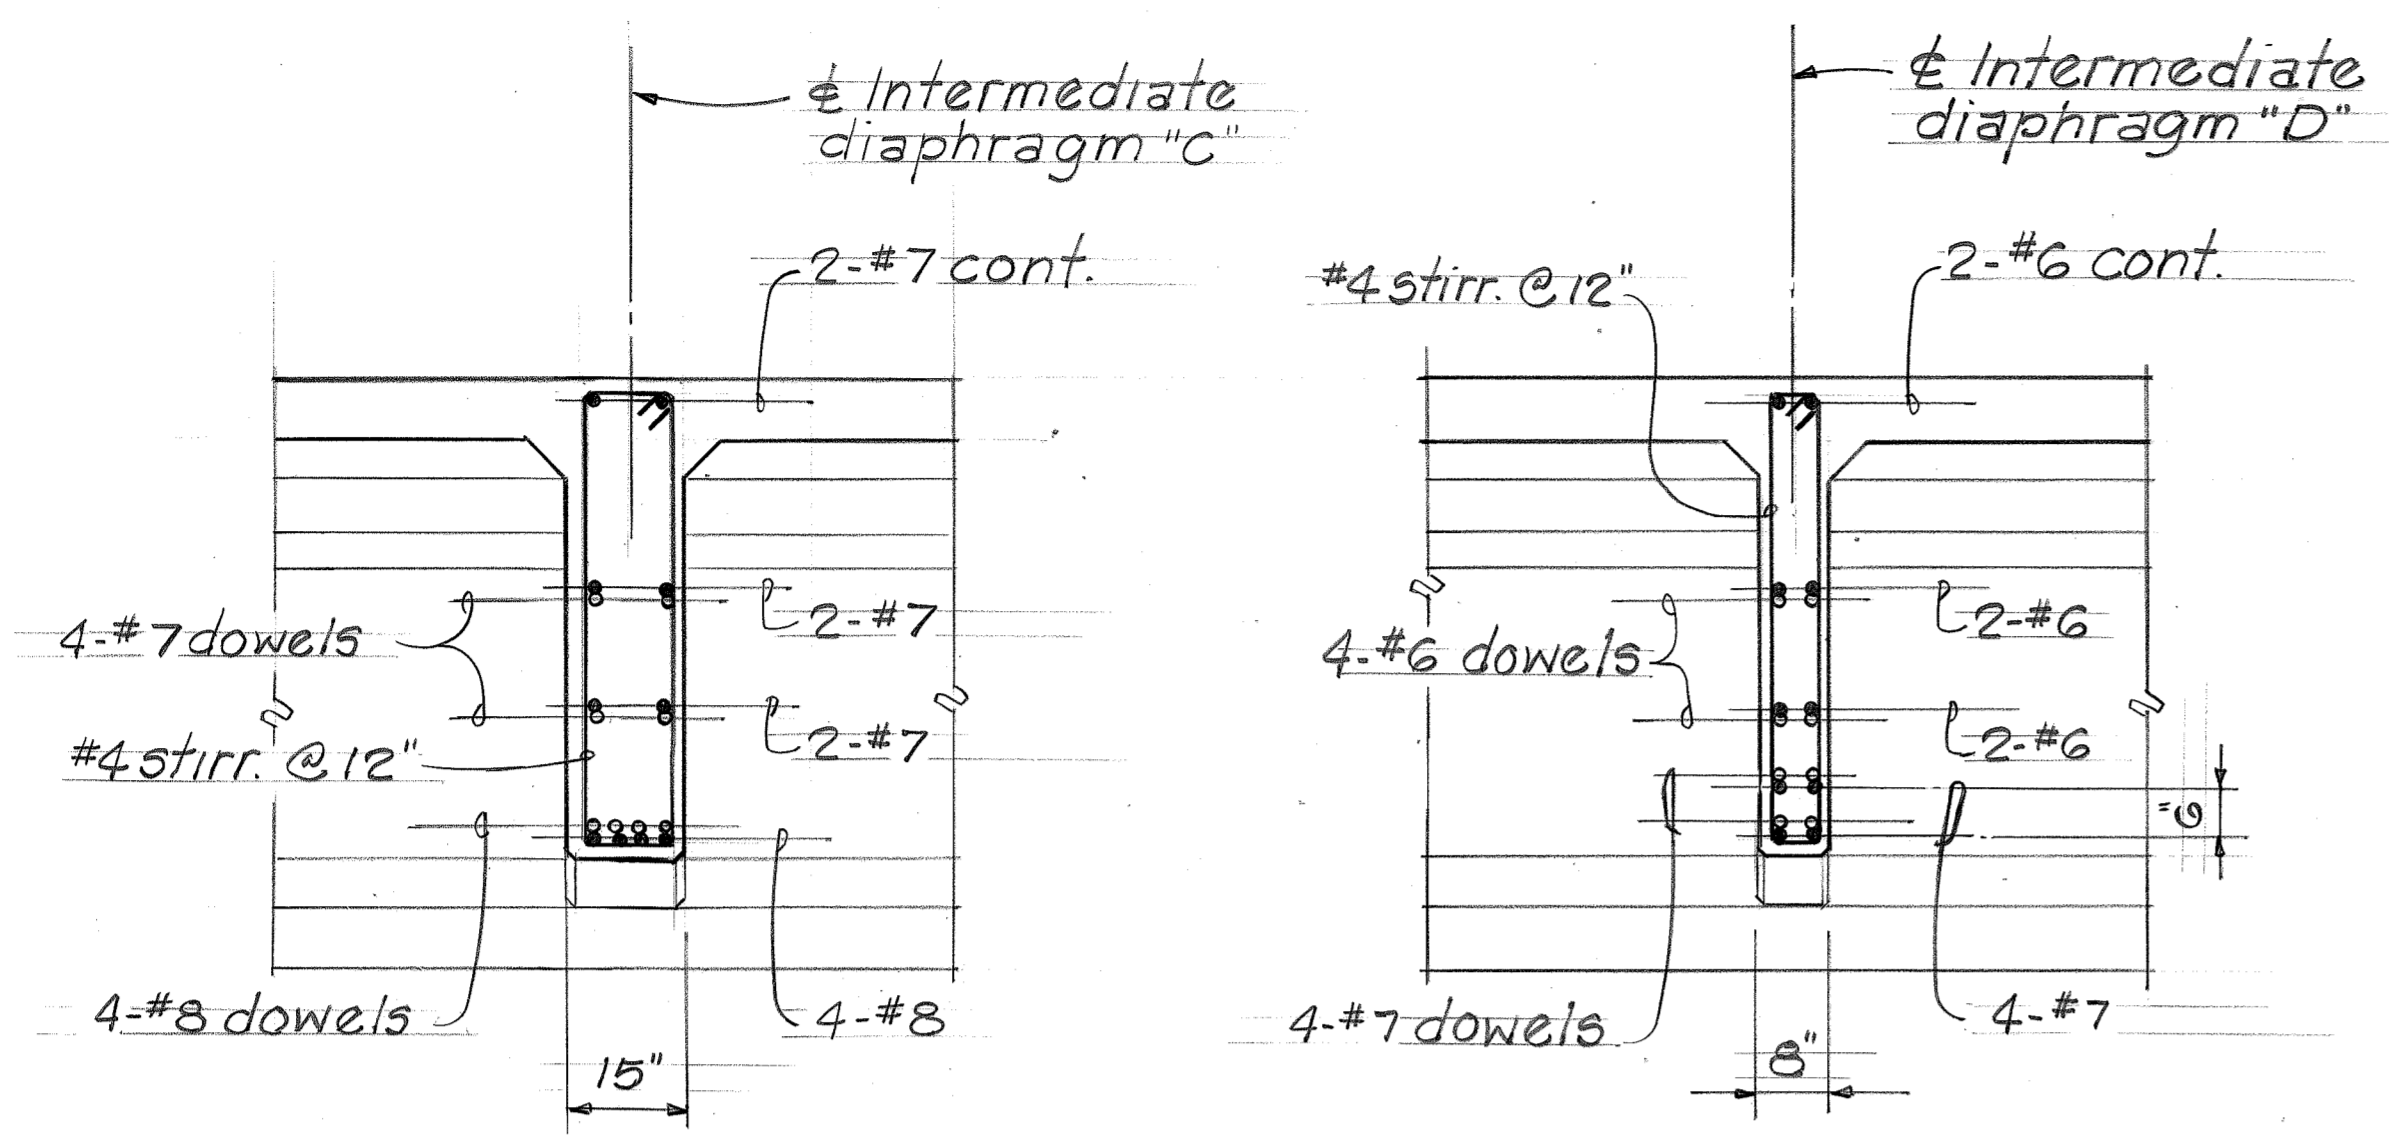


**A SECTION**  
S-8 | S-9 Scale: 1/2"=1'-0"

**B SECTION**  
S-8 | S-9 Scale: 1/2"=1'-0"

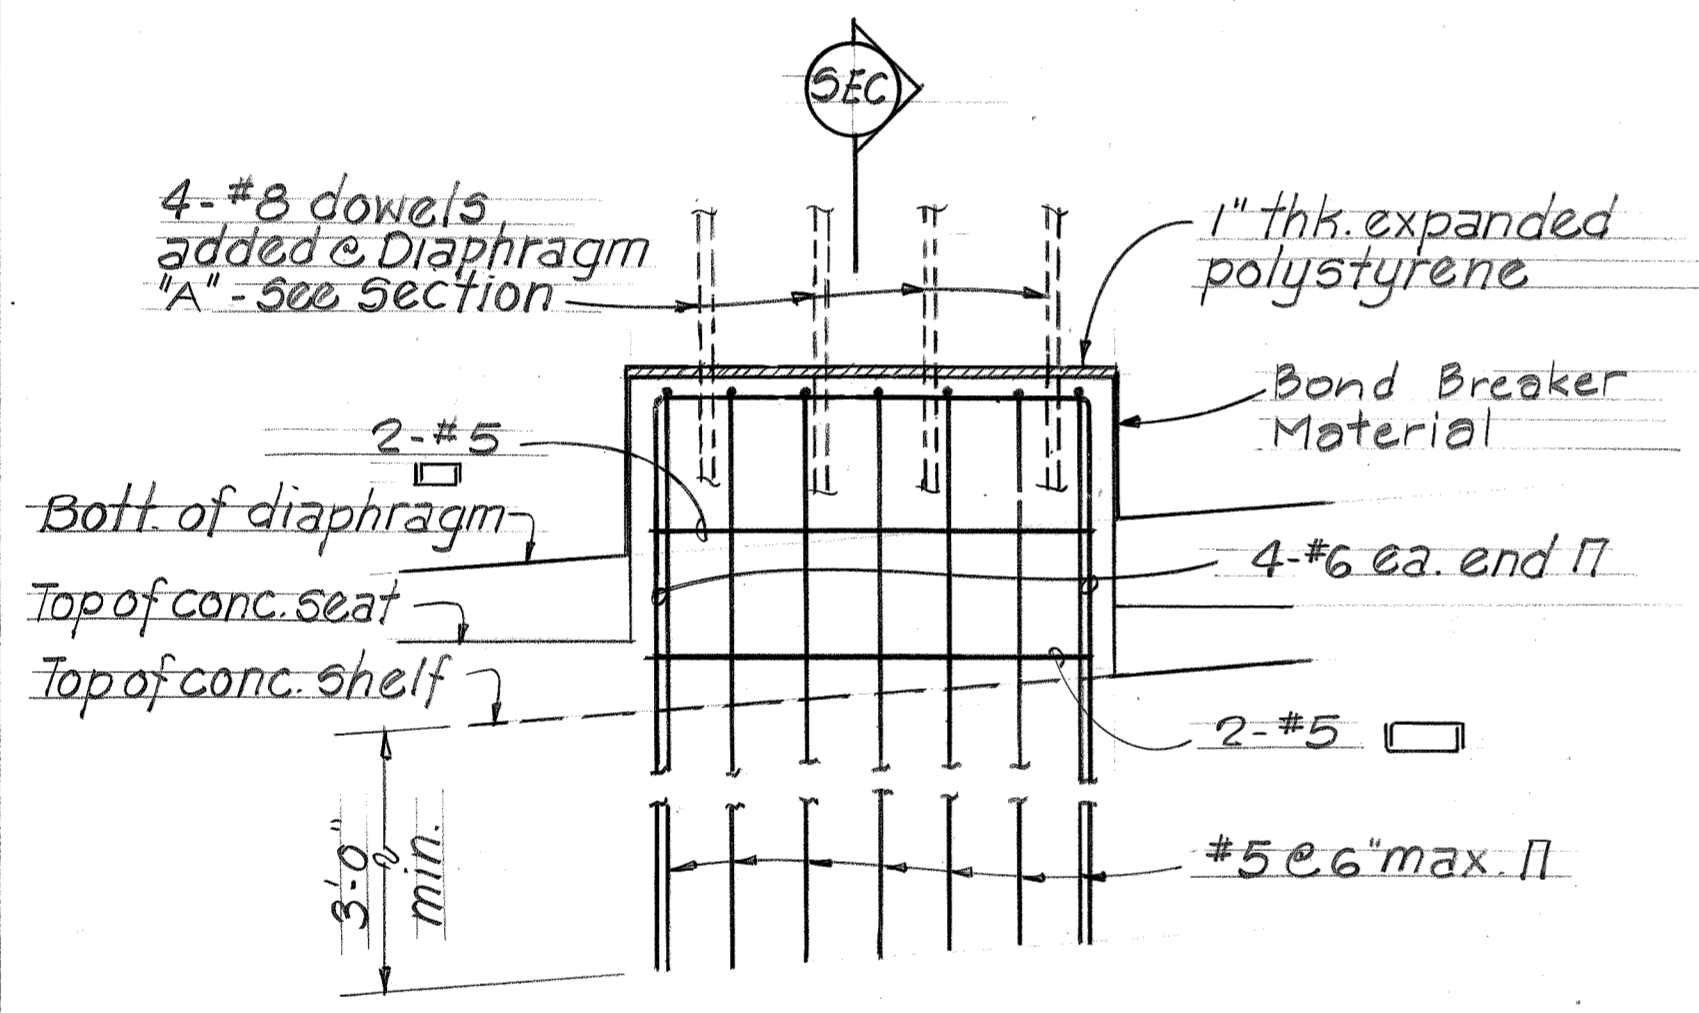


**ELEVATION**

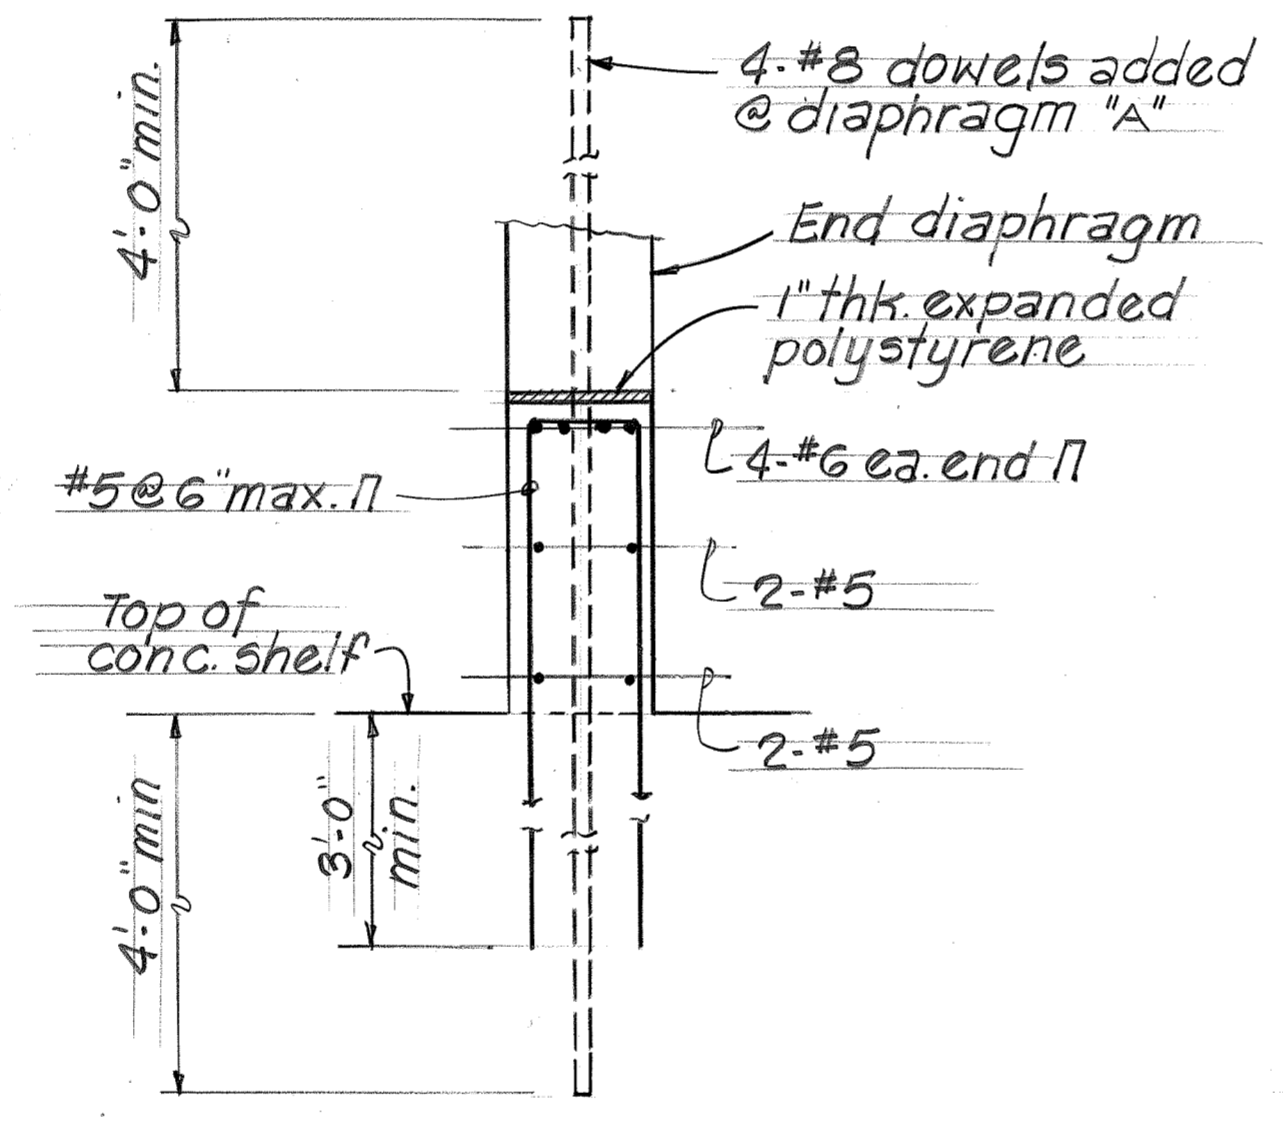


**SECTION**

**TYPICAL CREEP BLOCK DETAIL**  
Scale: 3/4"=1'-0"

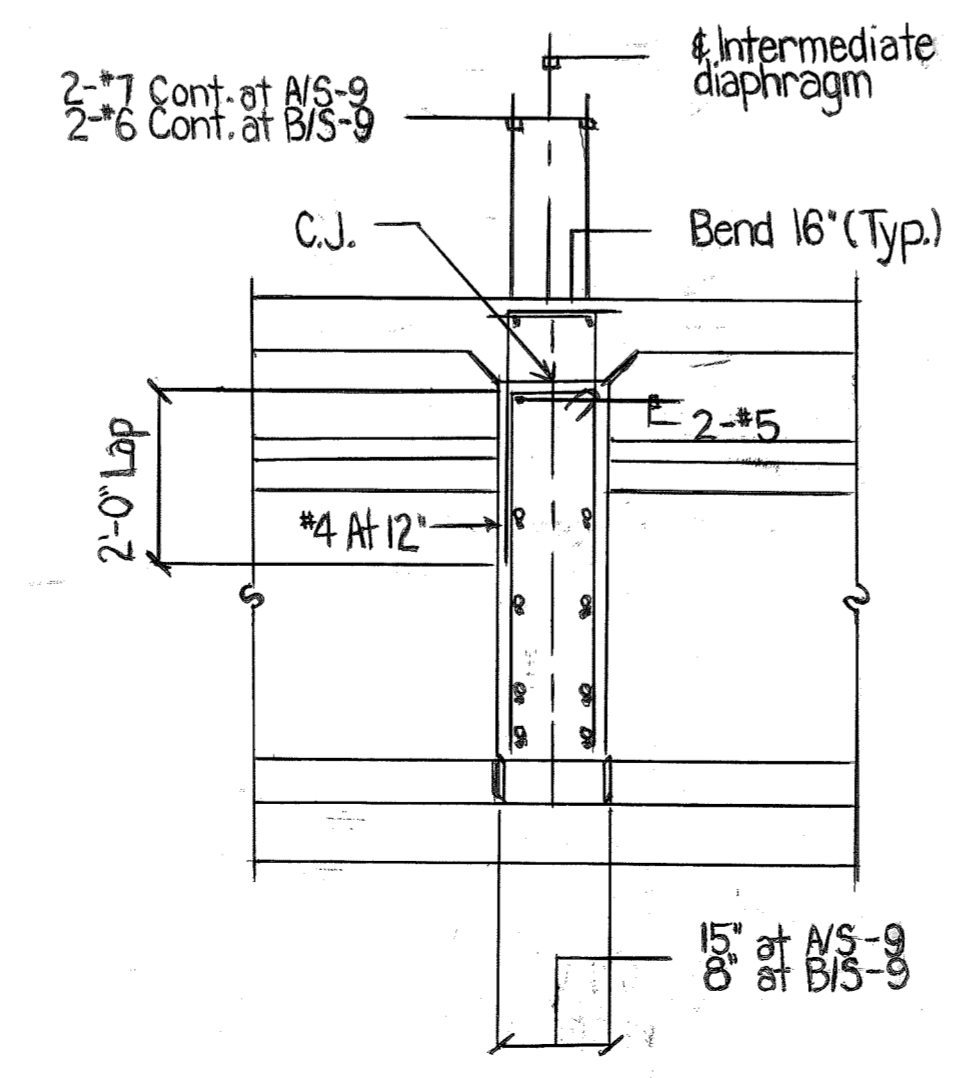


Note:  
See contract drawings for remainder of section.

**MODIFIED DIAPHRAGM STIRRUPS**

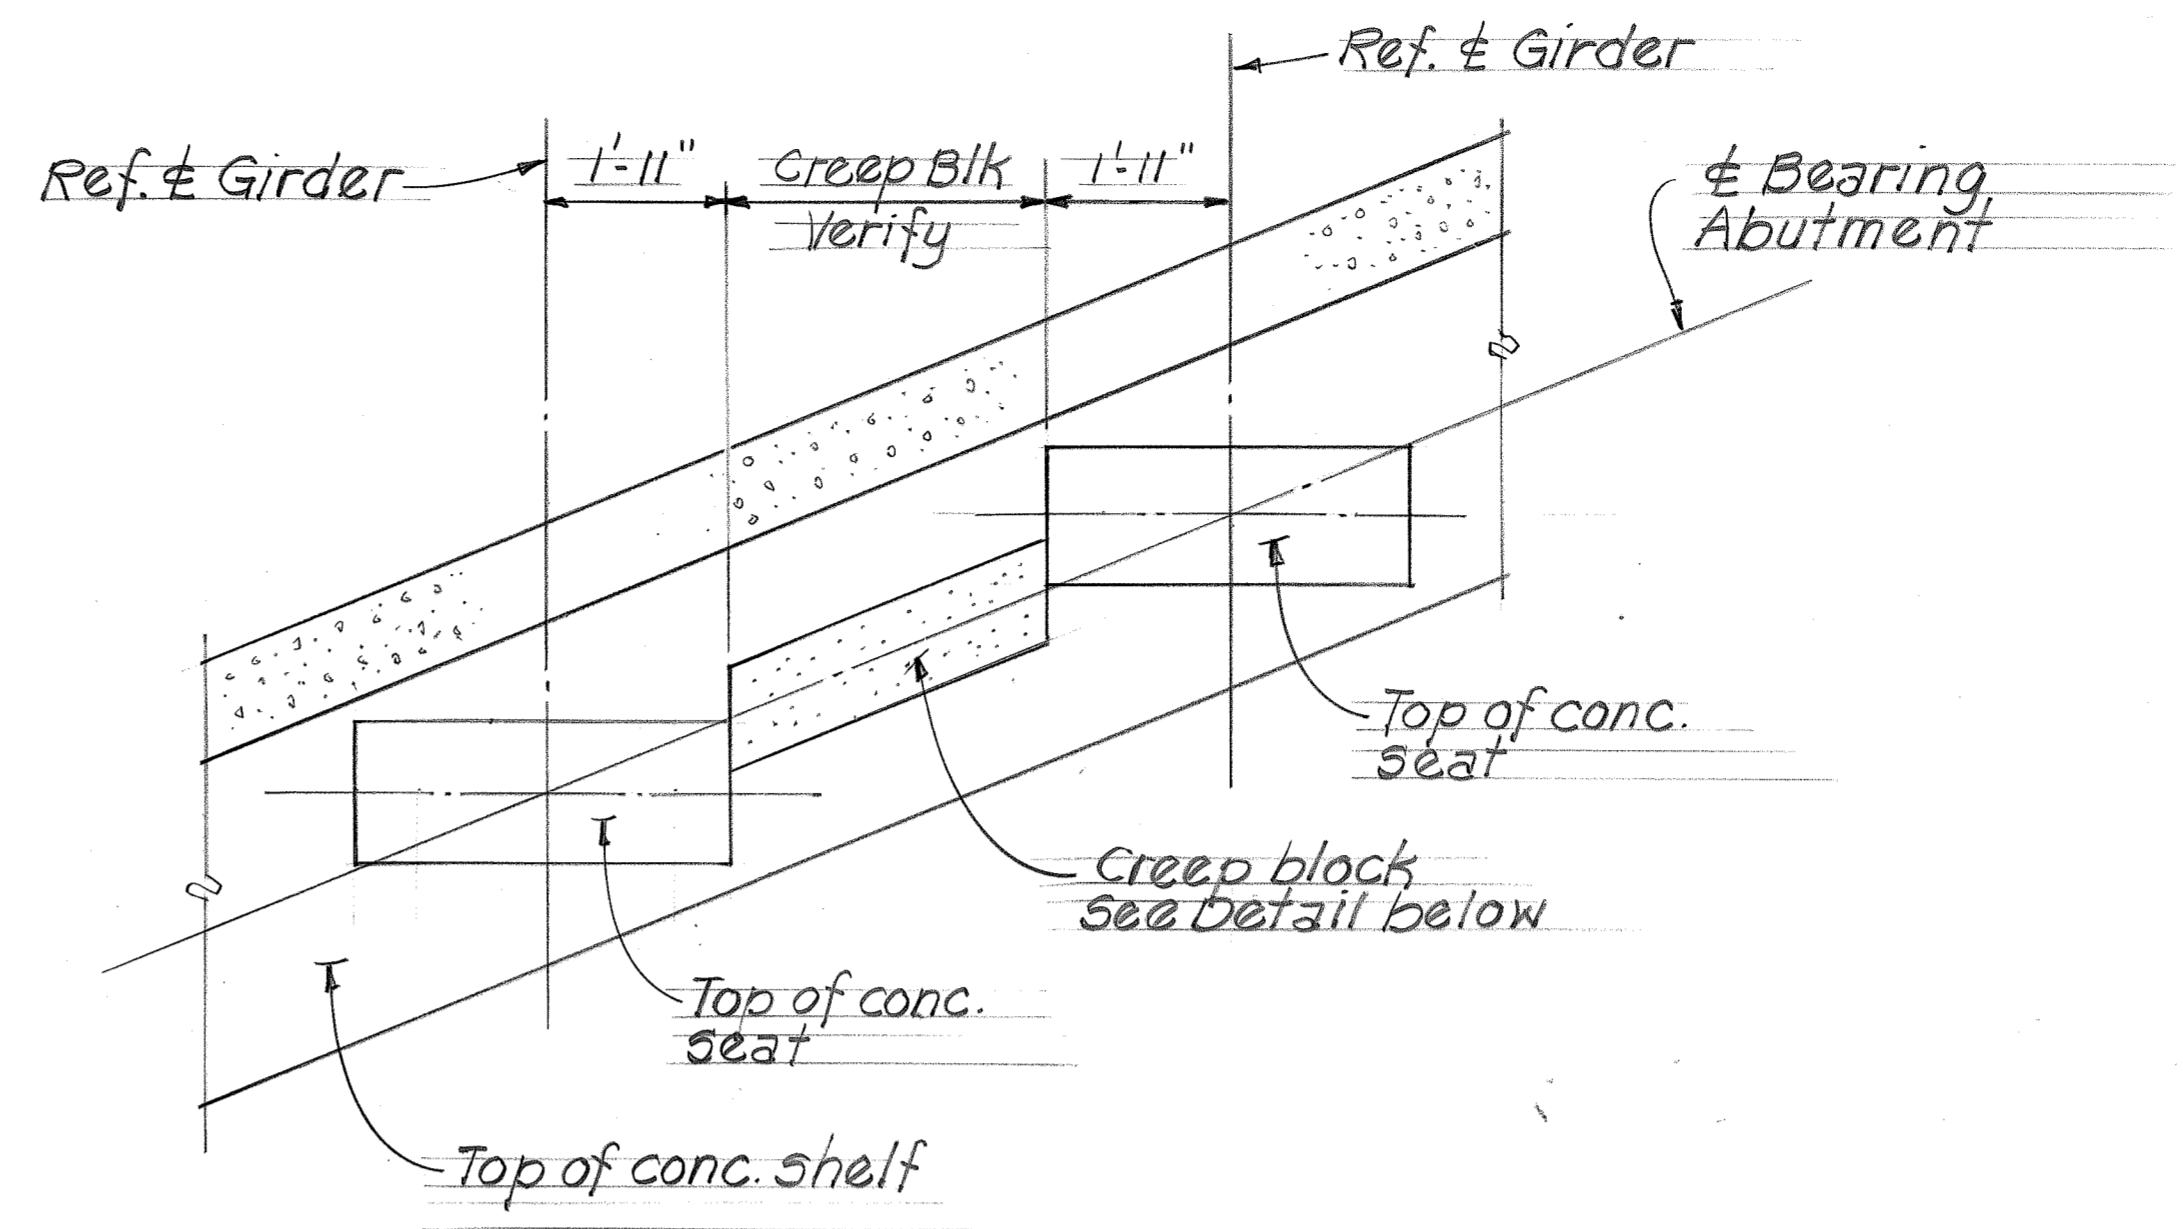


**PARTIAL PLAN AT CREEP BLOCK**  
Scale: 1/2"=1'-0"

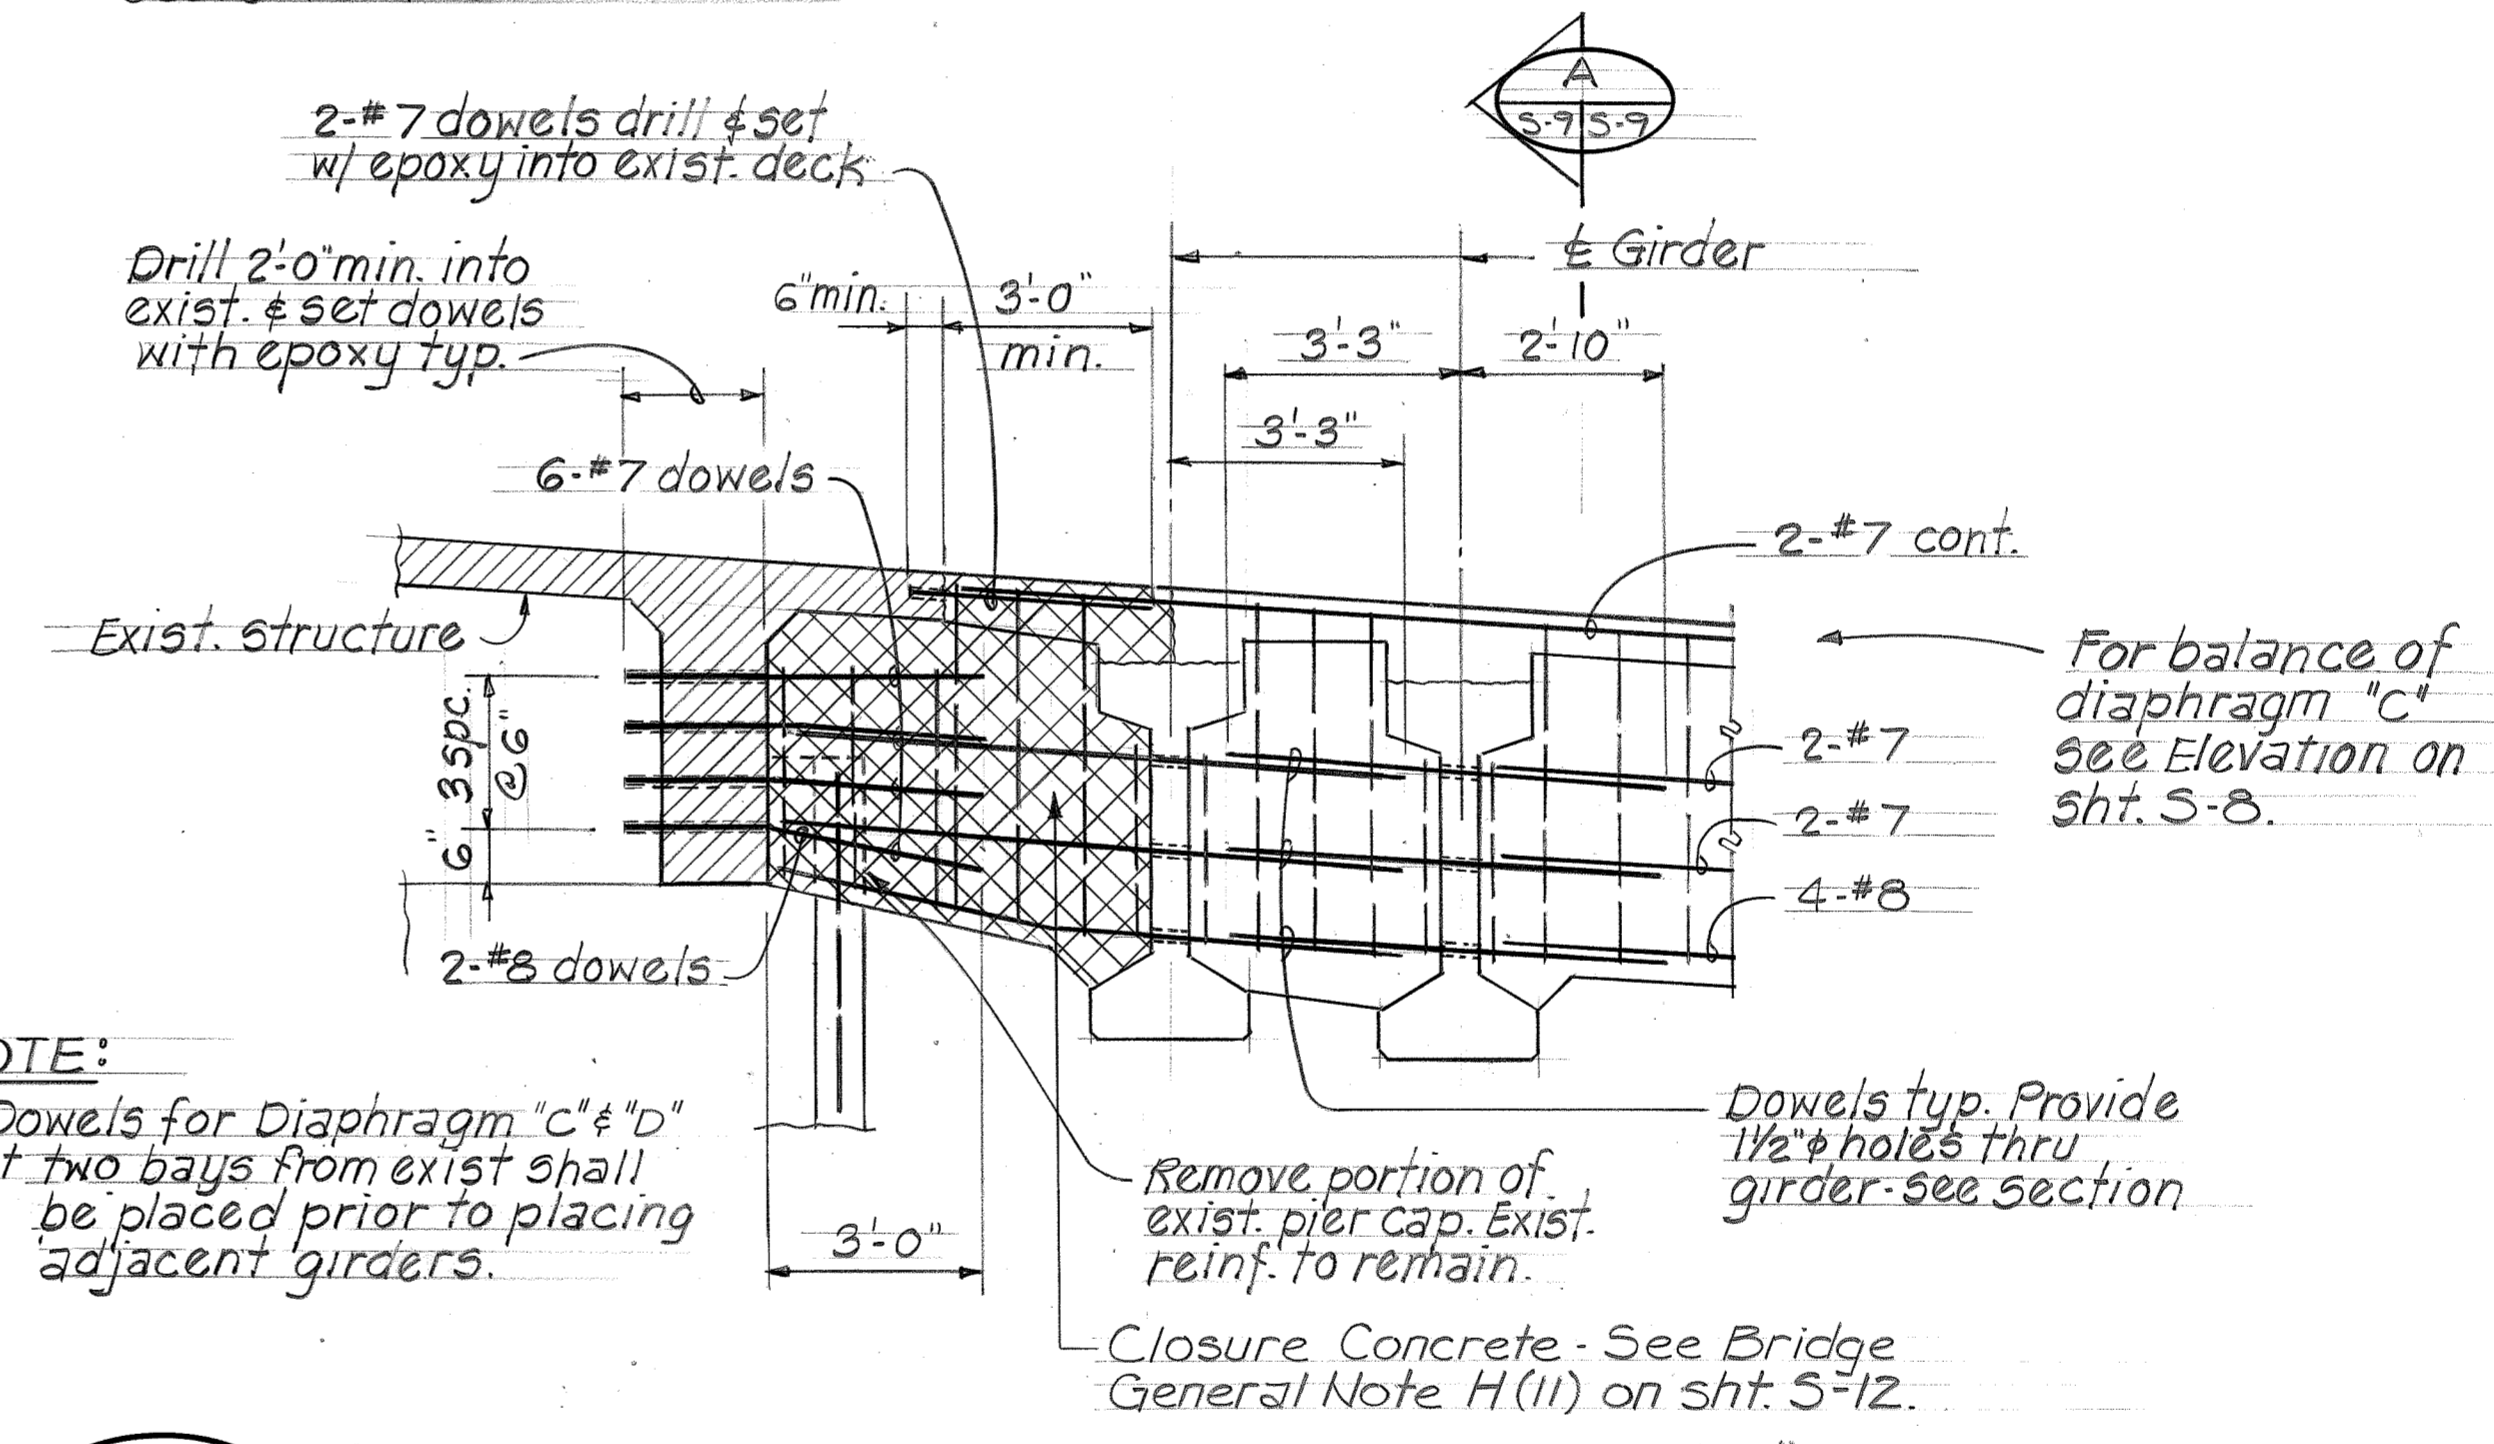

NOTE:  
Dowels for Diaphragm "C" & "D" first two bays from exist. shall be placed prior to placing adjacent girders.

**1 PARTIAL INTERMEDIATE DIAPHRAGM "C" ELEVATION**  
S-8 | S-9 Scale: 3/8"=1'-0"

DATE	
SURVEY PLOTTED BY	
DESIGNED BY	
TRACED BY	
NOTE BOOK	
QUANTITIES BY	
CHECKED BY	
No.	

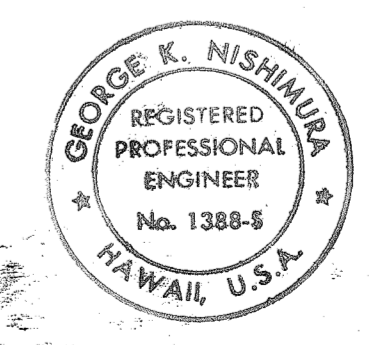

THIS WORK WAS PREPARED BY  
ME OR UNDER MY SUPERVISION.  
*[Signature]*


STATE OF HAWAII  
DEPARTMENT OF TRANSPORTATION  
HIGHWAYS DIVISION

DIAPHRAGM SECTION & DETAIL AND  
CREEP BLOCK PLAN & DETAIL


KAUMUALII HIGHWAY INTERSECTION  
IMPROVEMENTS AT KOLOA ROAD  
FEDERAL AID PROJ. NO. STP-050-1 (17)  
SCALE: AS NOTED DATE: OCT. 8, 1999

SHEET No. 5-9 OF 17 SHEETS

FED. ROAD DIST. NO.	STATE	FED. AID PROJ. NO.	FISCAL YEAR	SHEET NO.	TOTAL SHEETS
HAWAII	HAW.	STP-050-1 (17)	2000	52	72

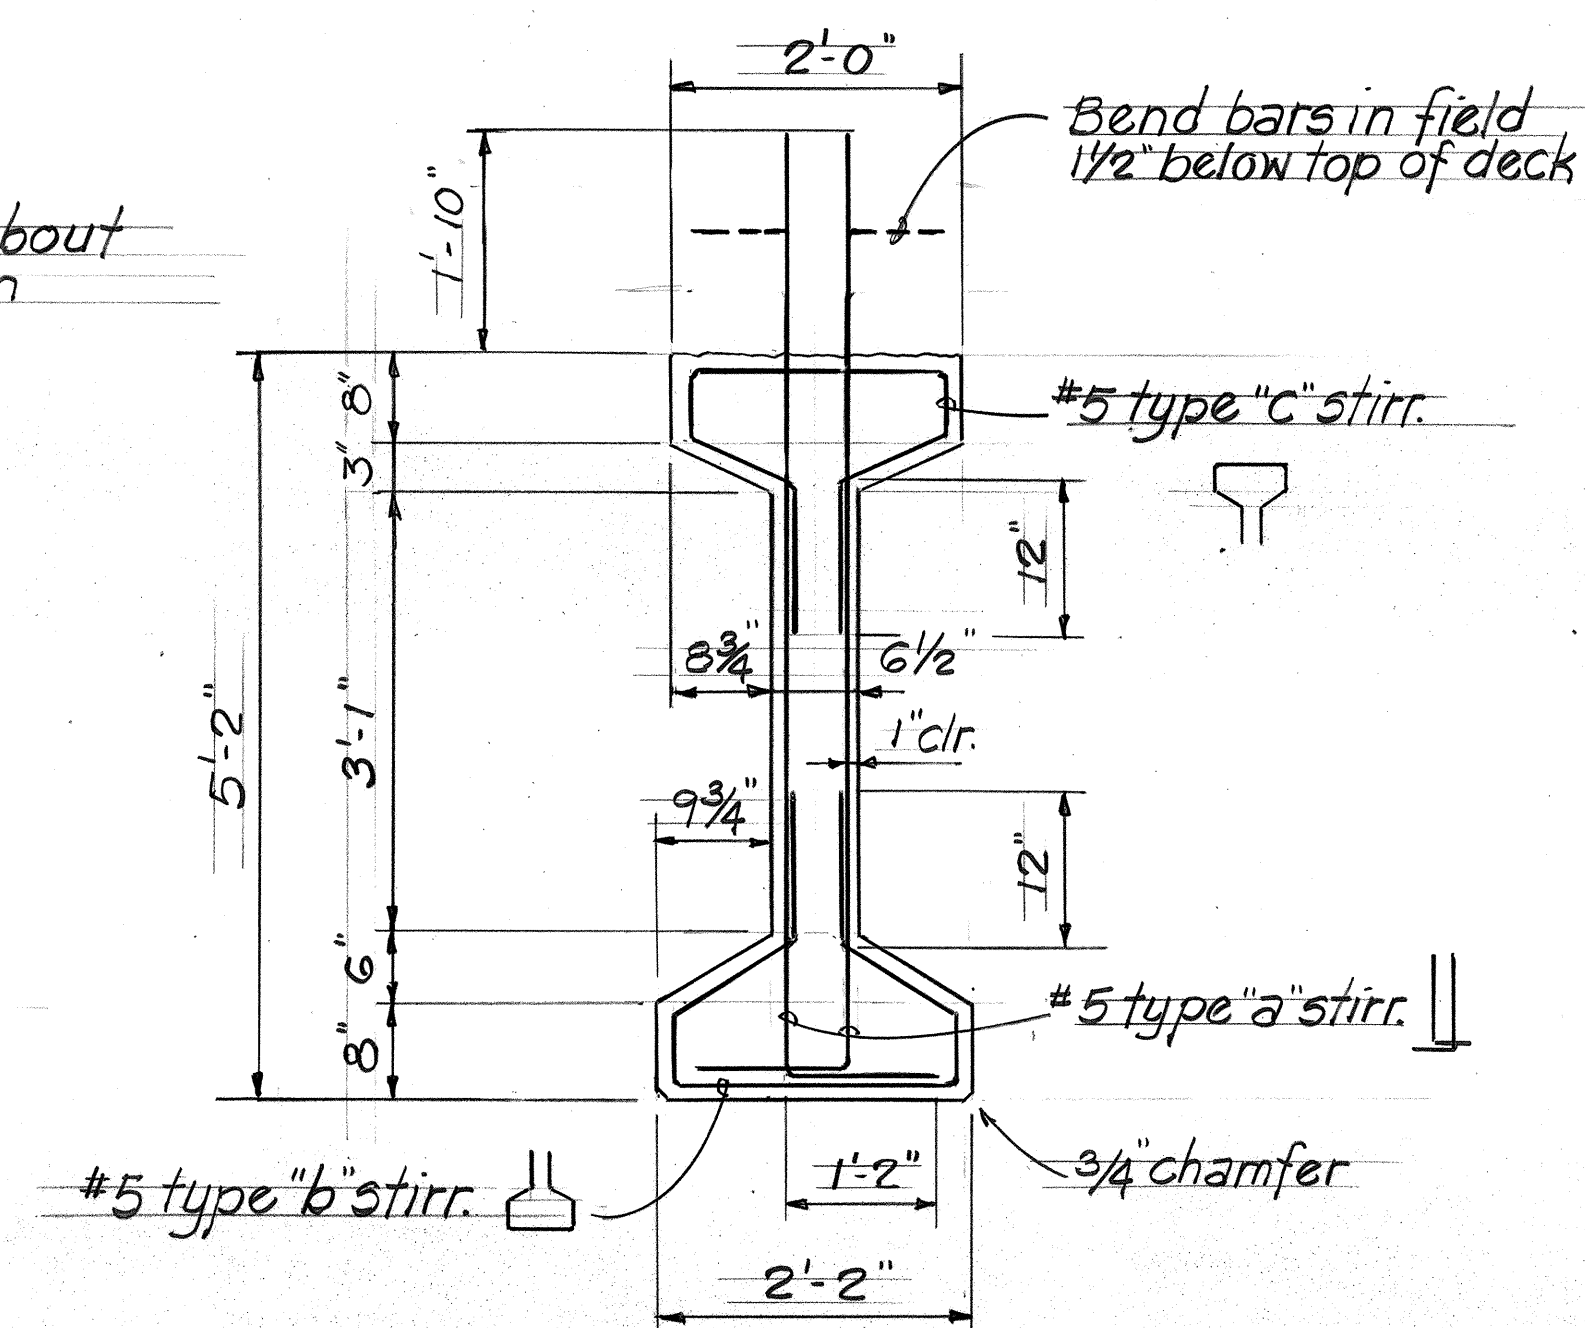


NOTE:  
 1. For Prestressed girder notes, refer to sht. 5-12  
 2. (126.0K) - Denotes final prestress force in KIPS after all losses. Estimated prestress losses = 53,000 psi. Losses are due to creep, shrinkage, elastic shortening and relaxation of steel.

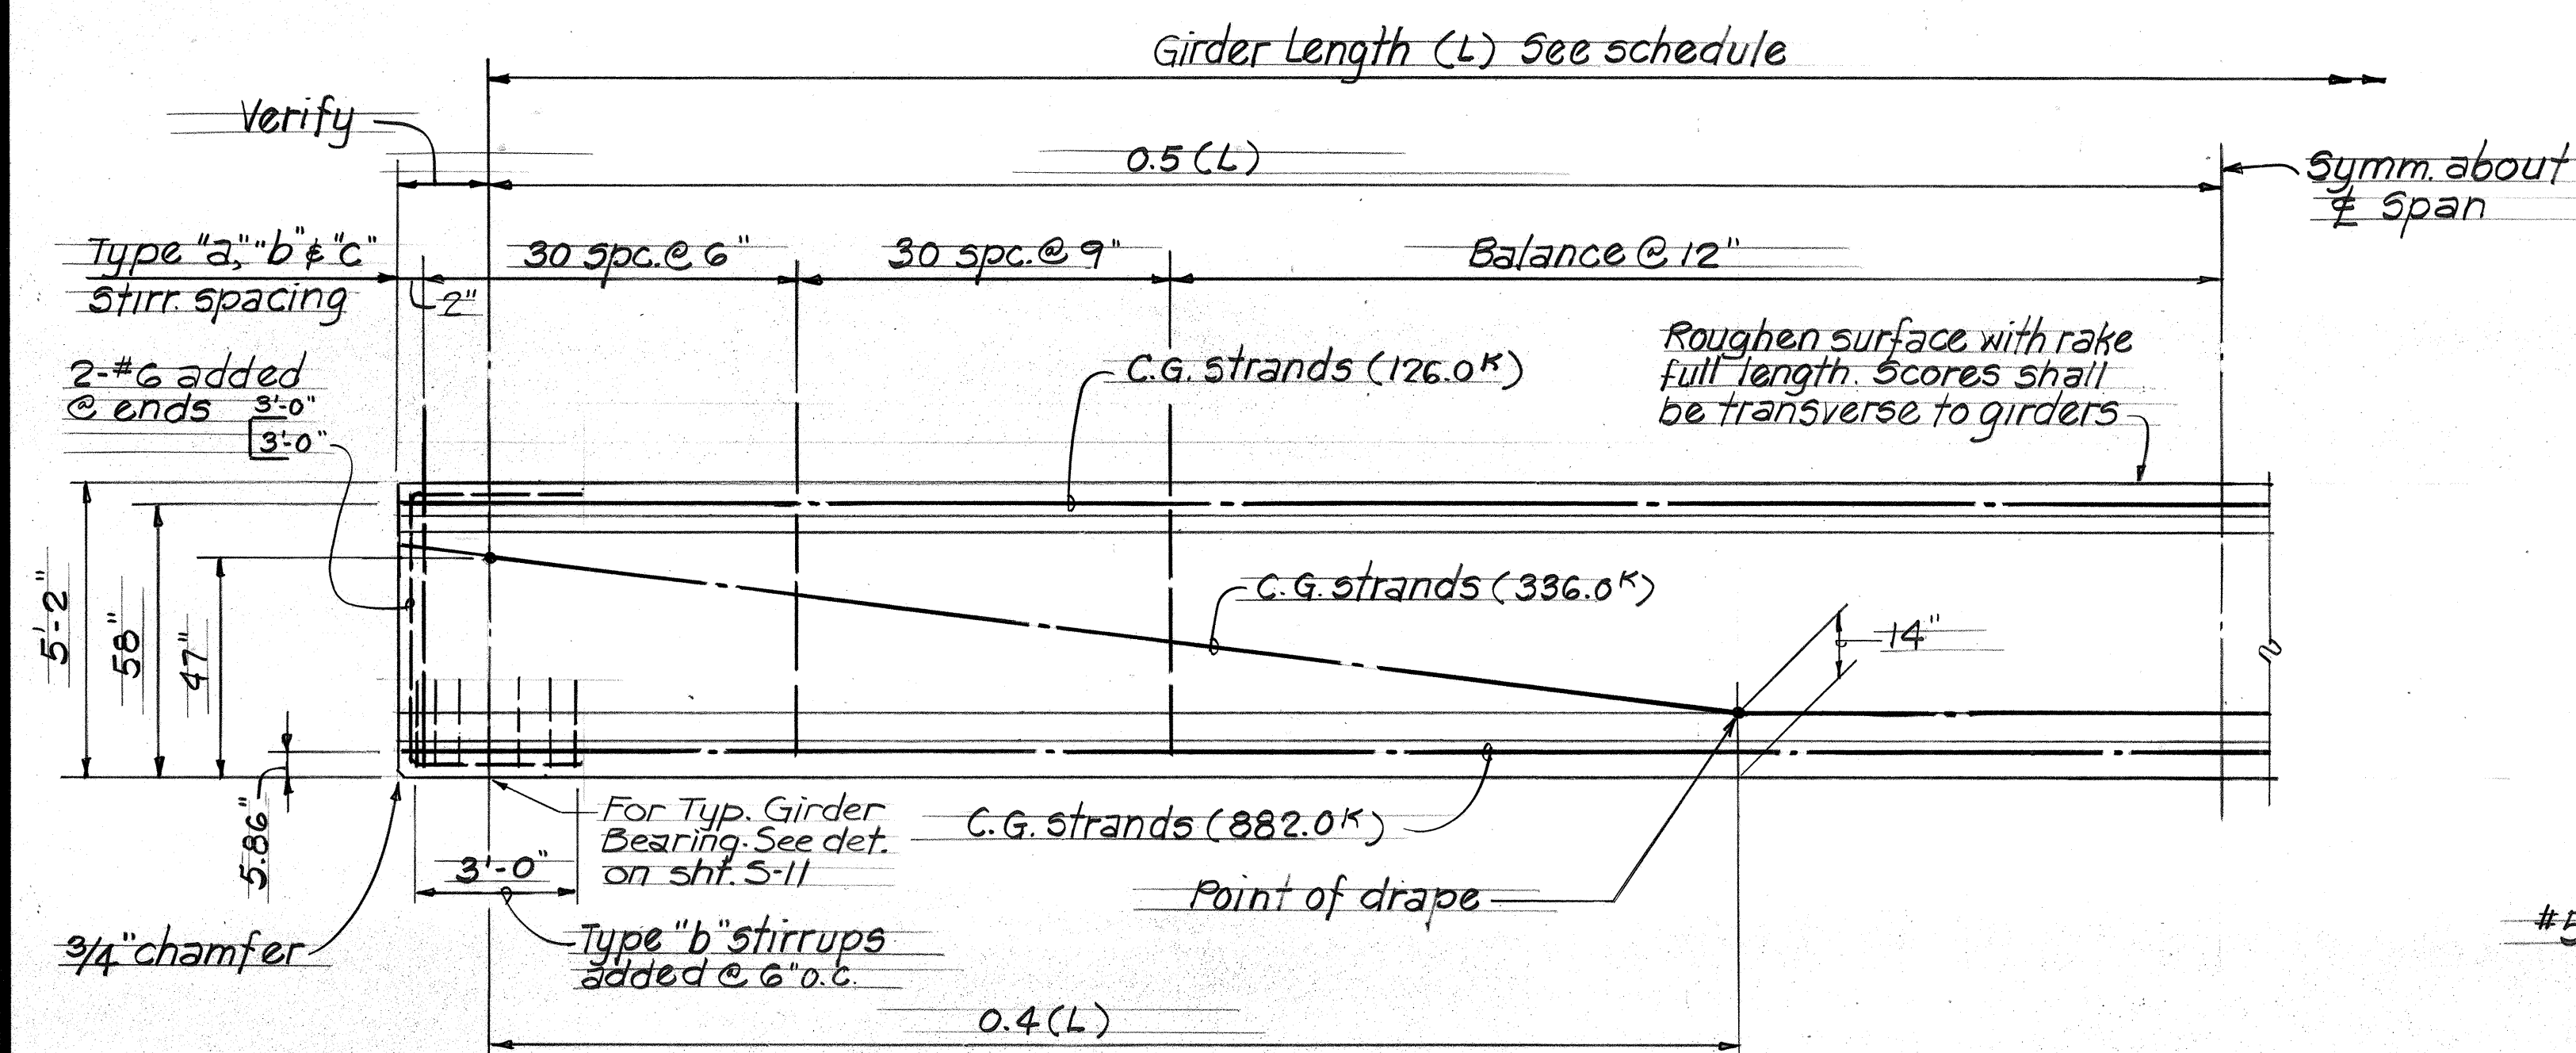


TYPICAL PRESTRESSED GIRDER ELEVATION (KEEHI II MODIFIED)  
 Not to scale: (Girders G-1 thru G-8 inclusive)

TYPICAL GIRDER SECTION  
 Scale: 3/4"=1'-0"

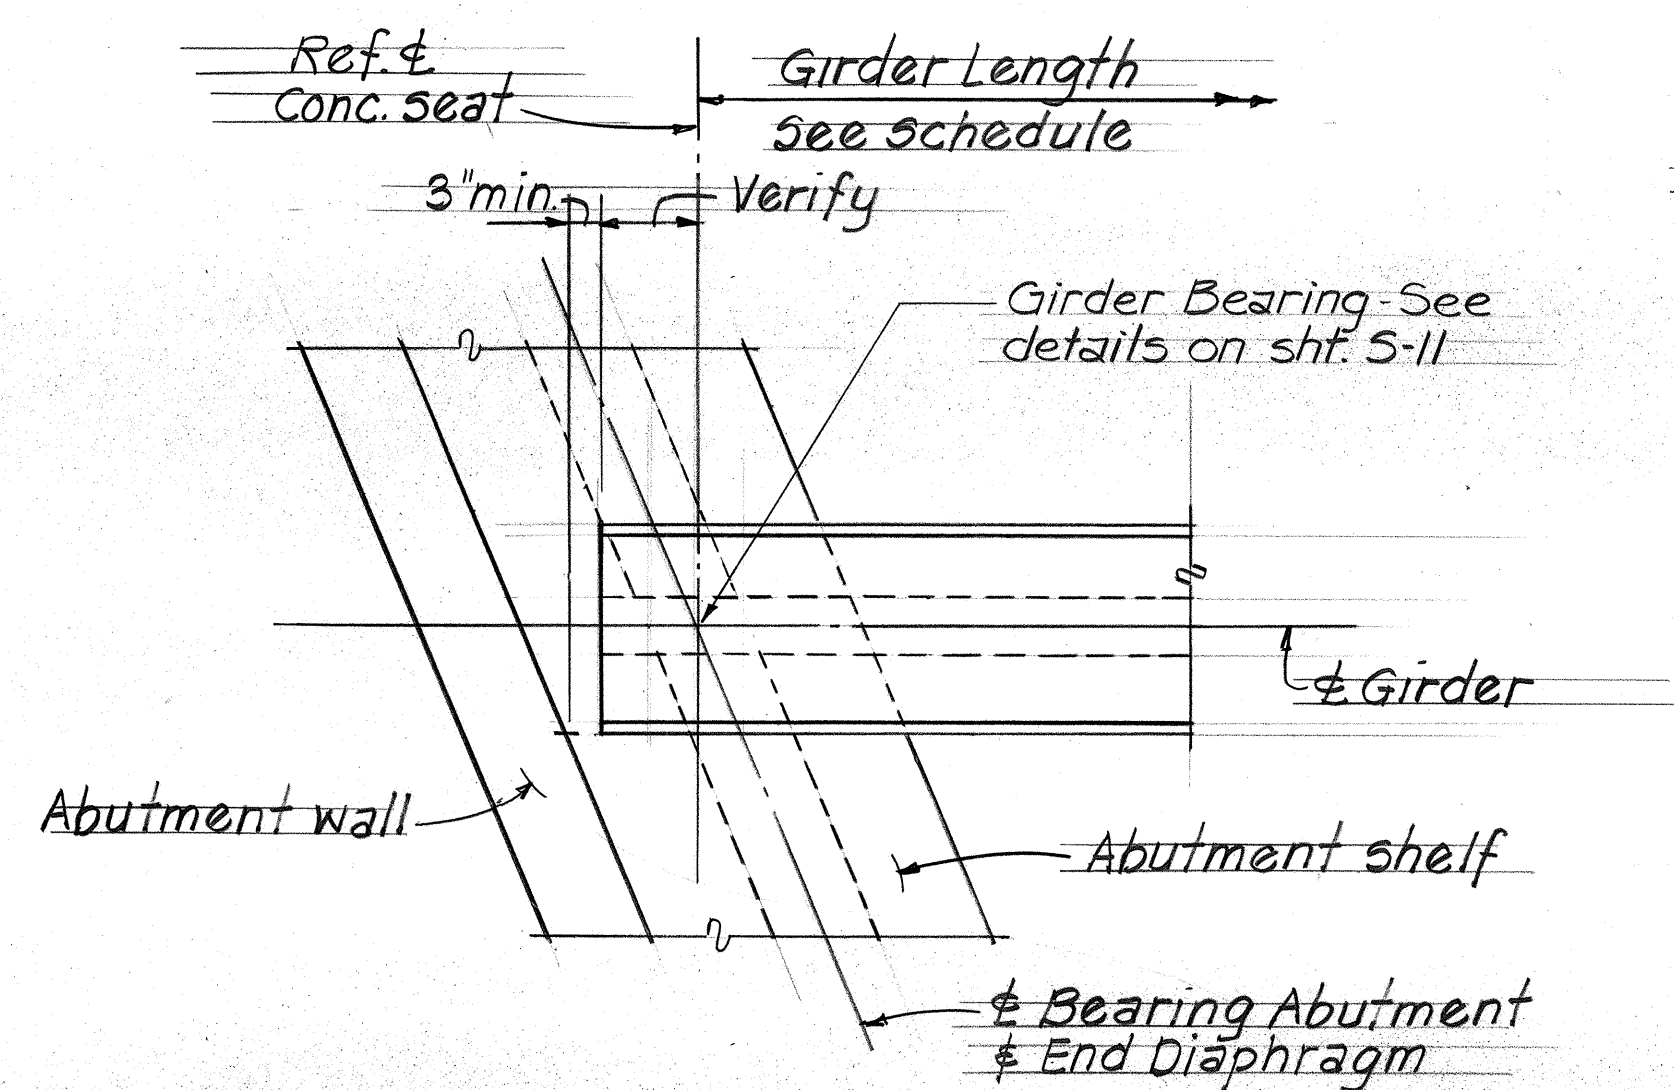


TYPICAL GIRDER END DETAIL  
 Scale: 1/2"=1'-0"

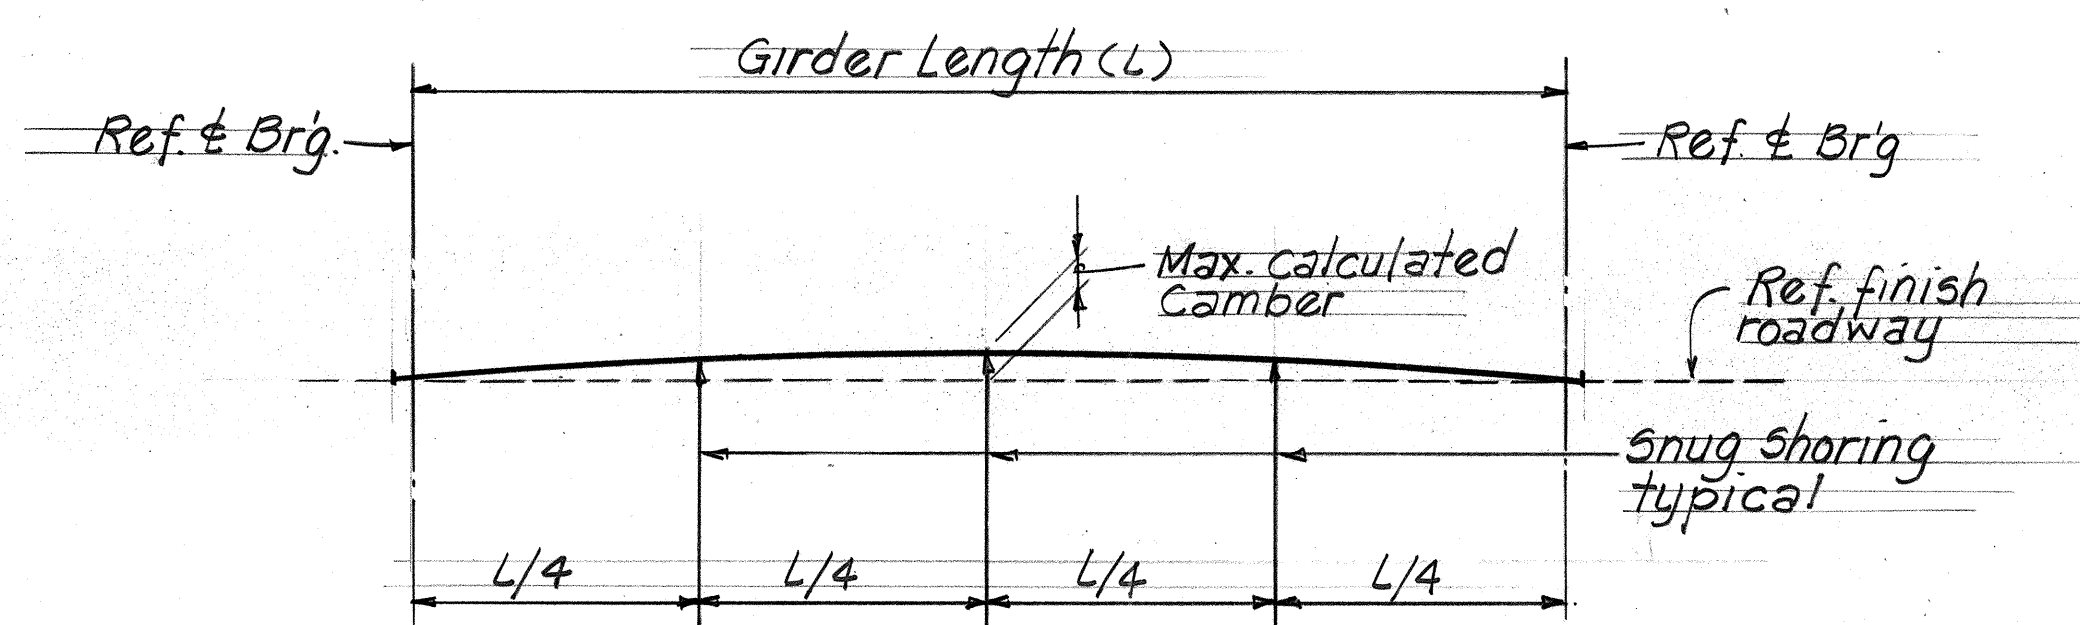

TYPICAL GIRDER SHORING DIAGRAM  
 Not to scale

# GIRDER SCHEDULE

Girder Mark	Girder Length (L)	Tapered # @ Abut. #1	Tapered # @ Abut. #2	Calculated Camber (max)
"t"	Taper	"t"	Taper	
G-1	117'-6 15/16"	1.0"	5/16" @ 12	3.25"
G-2	116'-11 5/16"	1.0"	1"	
G-3	116'-0 7/16"	1.0"	1"	
G-4	115'-1 9/16"	1.0"	1"	
G-5	114'-2 5/8"	1.0"	1"	
G-6	113'-3 3/4"	1.0"	1"	
G-7	112'-10 1/4"	1.0"	1"	
G-8	112'-4 3/4"	1.0"	1"	

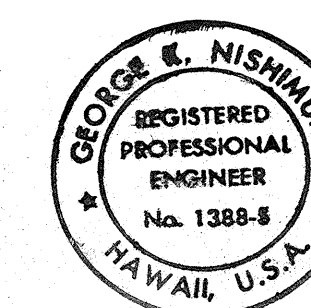


THIS WORK WAS PREPARED BY  
 ME OR UNDER MY SUPERVISION.  
 [Signature]


1/30/02	Revise girder lengths
Date	Revision
STATE OF HAWAII DEPARTMENT OF TRANSPORTATION HIGHWAYS DIVISION PRESTRESSED GIRDER DETAIL	
KAUNUALII HIGHWAY INTERSECTION IMPROVEMENTS AT KOLOA ROAD	
FEDERAL AID PROJ. NO. STP-050-1 (17)	
SCALE: AS NOTED	DATE: OCT. 8, 1999
SHEET No. 5-10 OF 17 SHEETS	

SURVEY PLOTTED BY	DATE
DESIGNED BY	
TRACED BY	
NOTE BOOK	
QUANTITIES BY	
CHECKED BY	
No.	


FED. ROAD DIST. NO.	STATE	FED. AID PROJ. NO.	FISCAL YEAR	SHEET NO.	TOTAL SHEETS
HAWAII	HAW.	STP-050-1(17)	2000	53	72

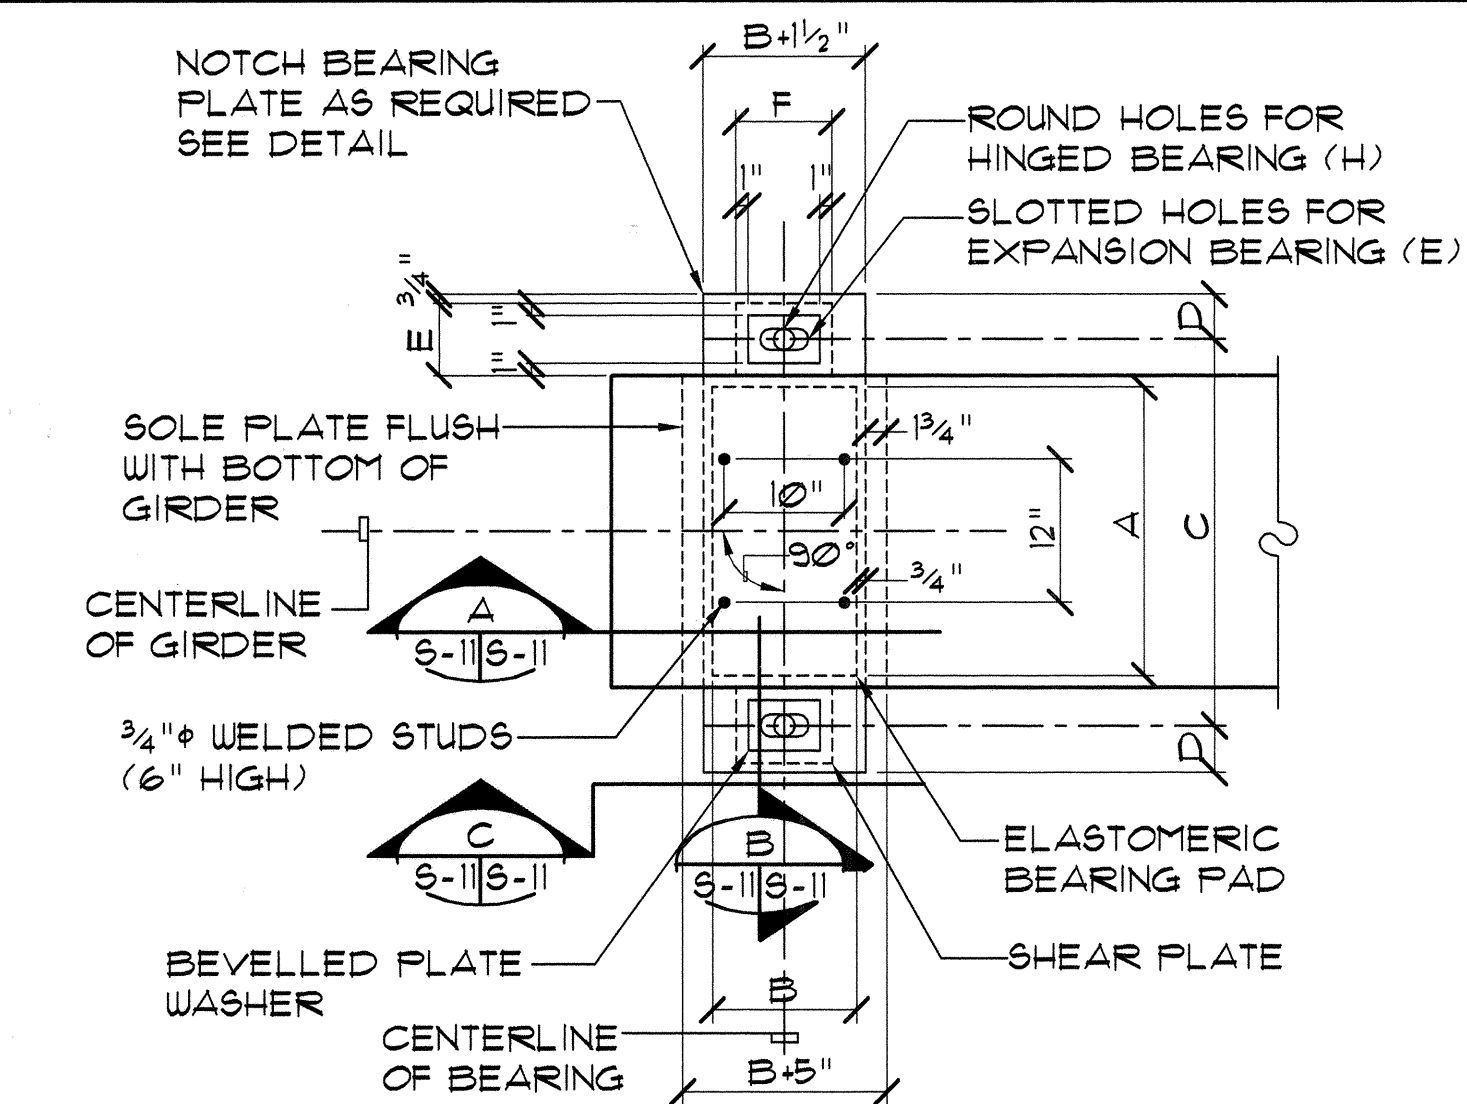


(HINGED AND EXPANSION)  
**TYPICAL BEARING PLAN**  
 NOT TO SCALE

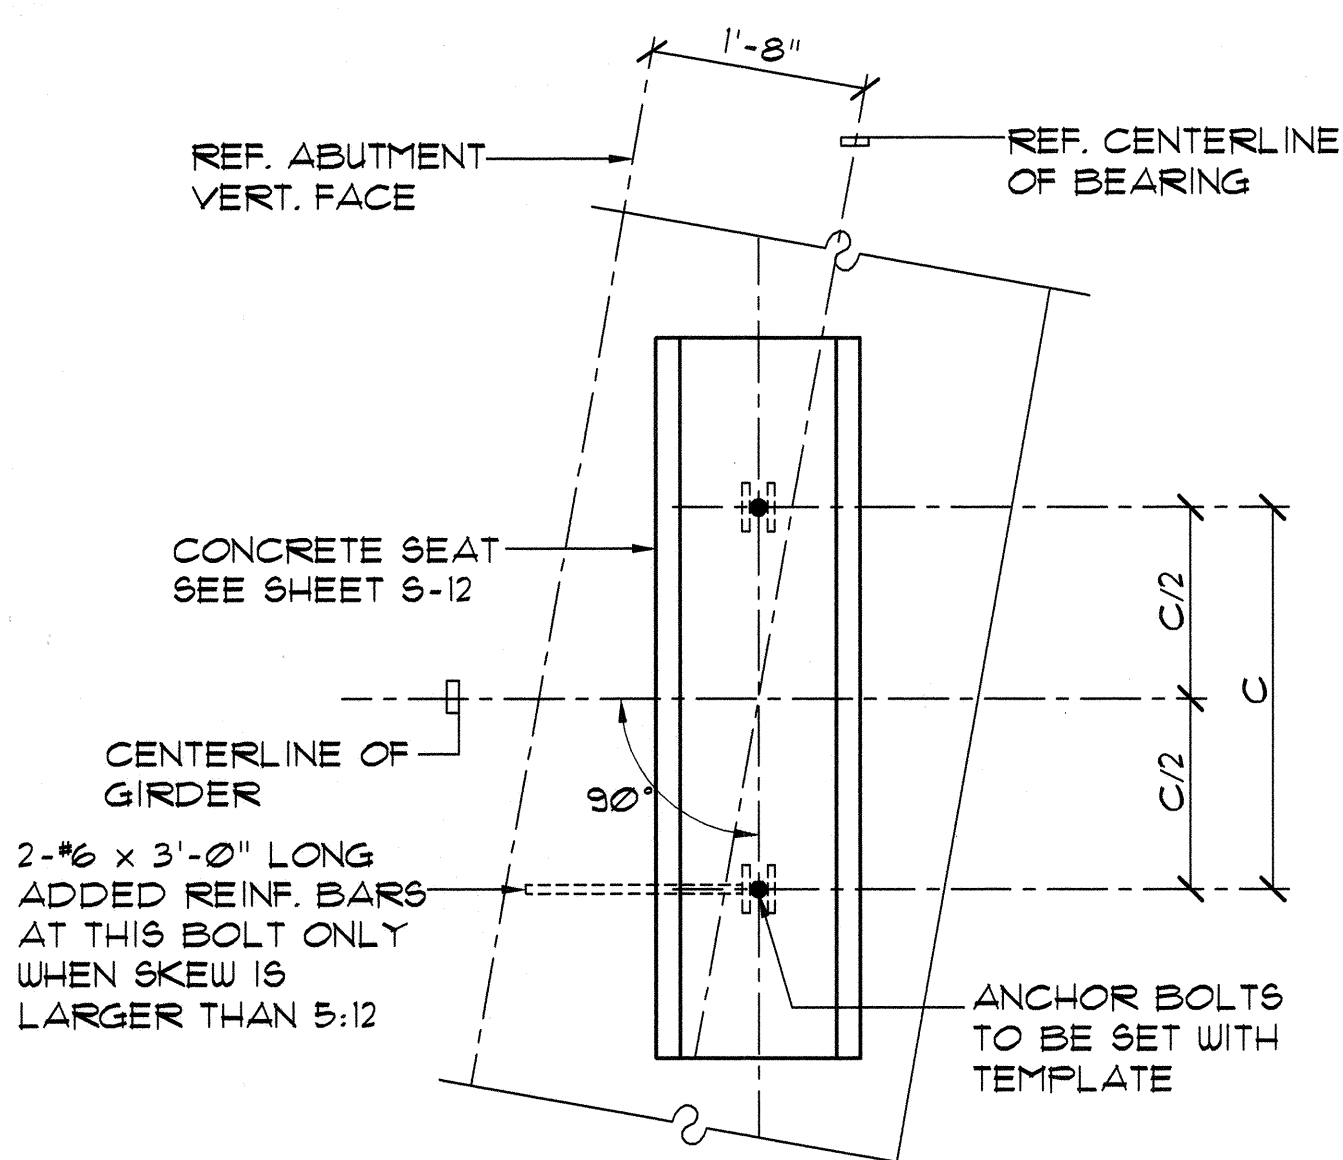


**ANCHOR BOLT PLAN**  
 NOT TO SCALE

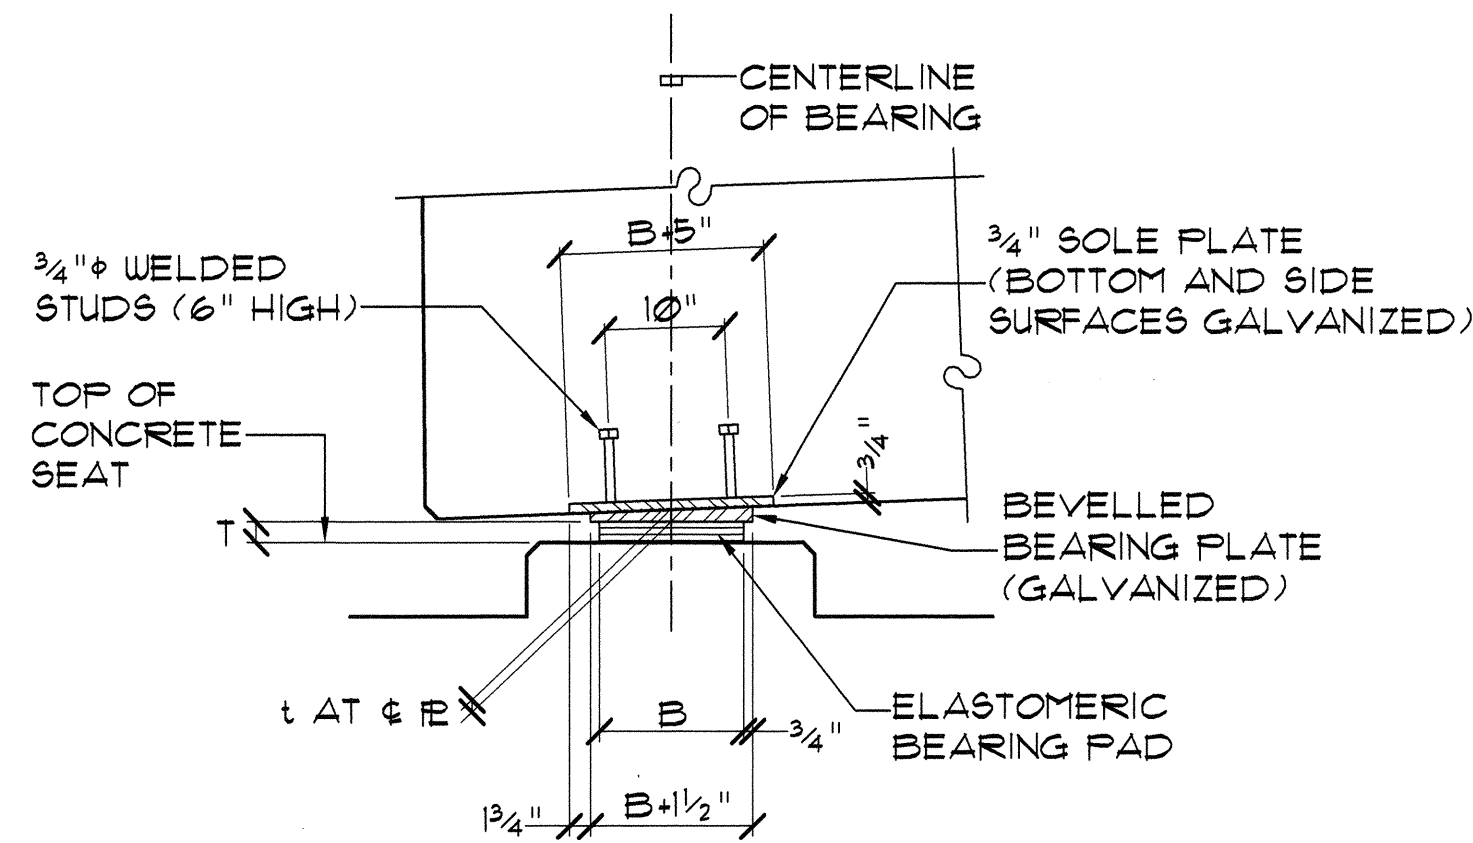


**SECTION A**  
 S-11 | S-11 NOT TO SCALE

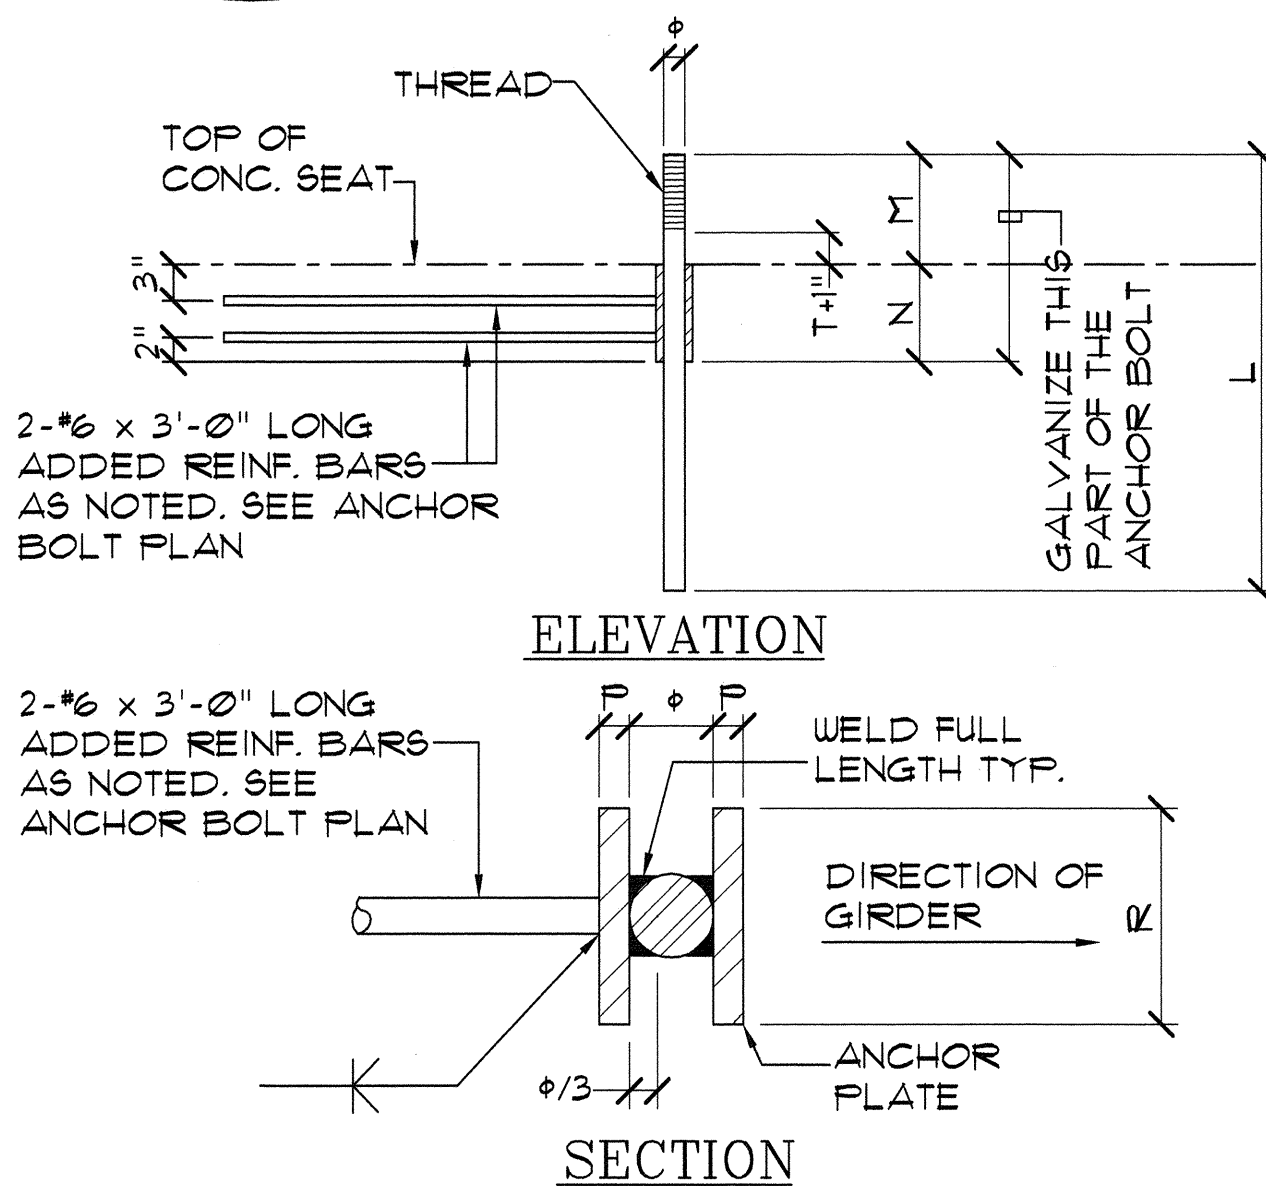


**ANCHOR BOLT DETAIL**  
 NOT TO SCALE

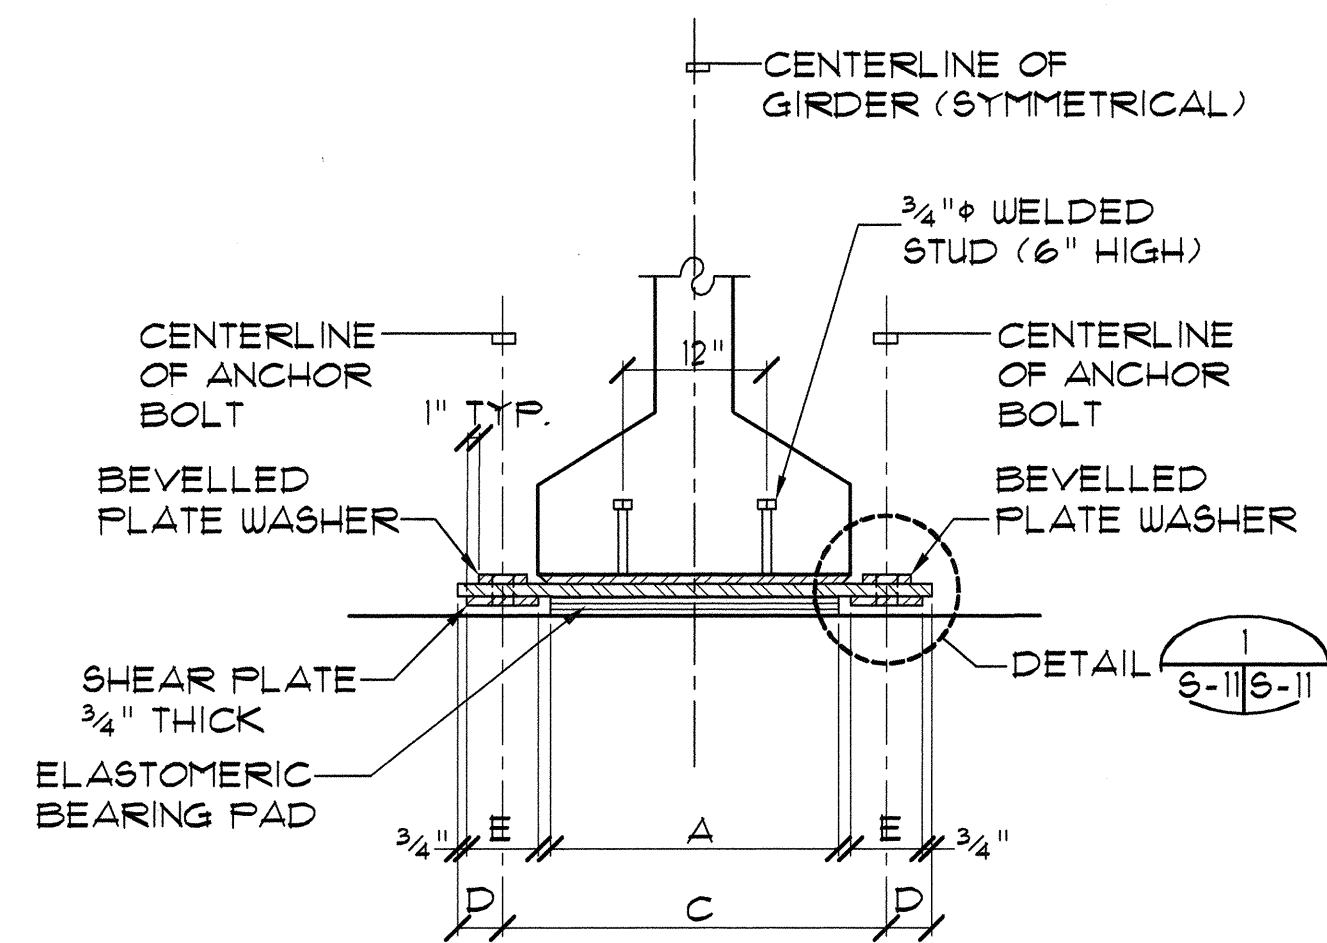

**SECTION B**  
 S-11 | S-11 NOT TO SCALE

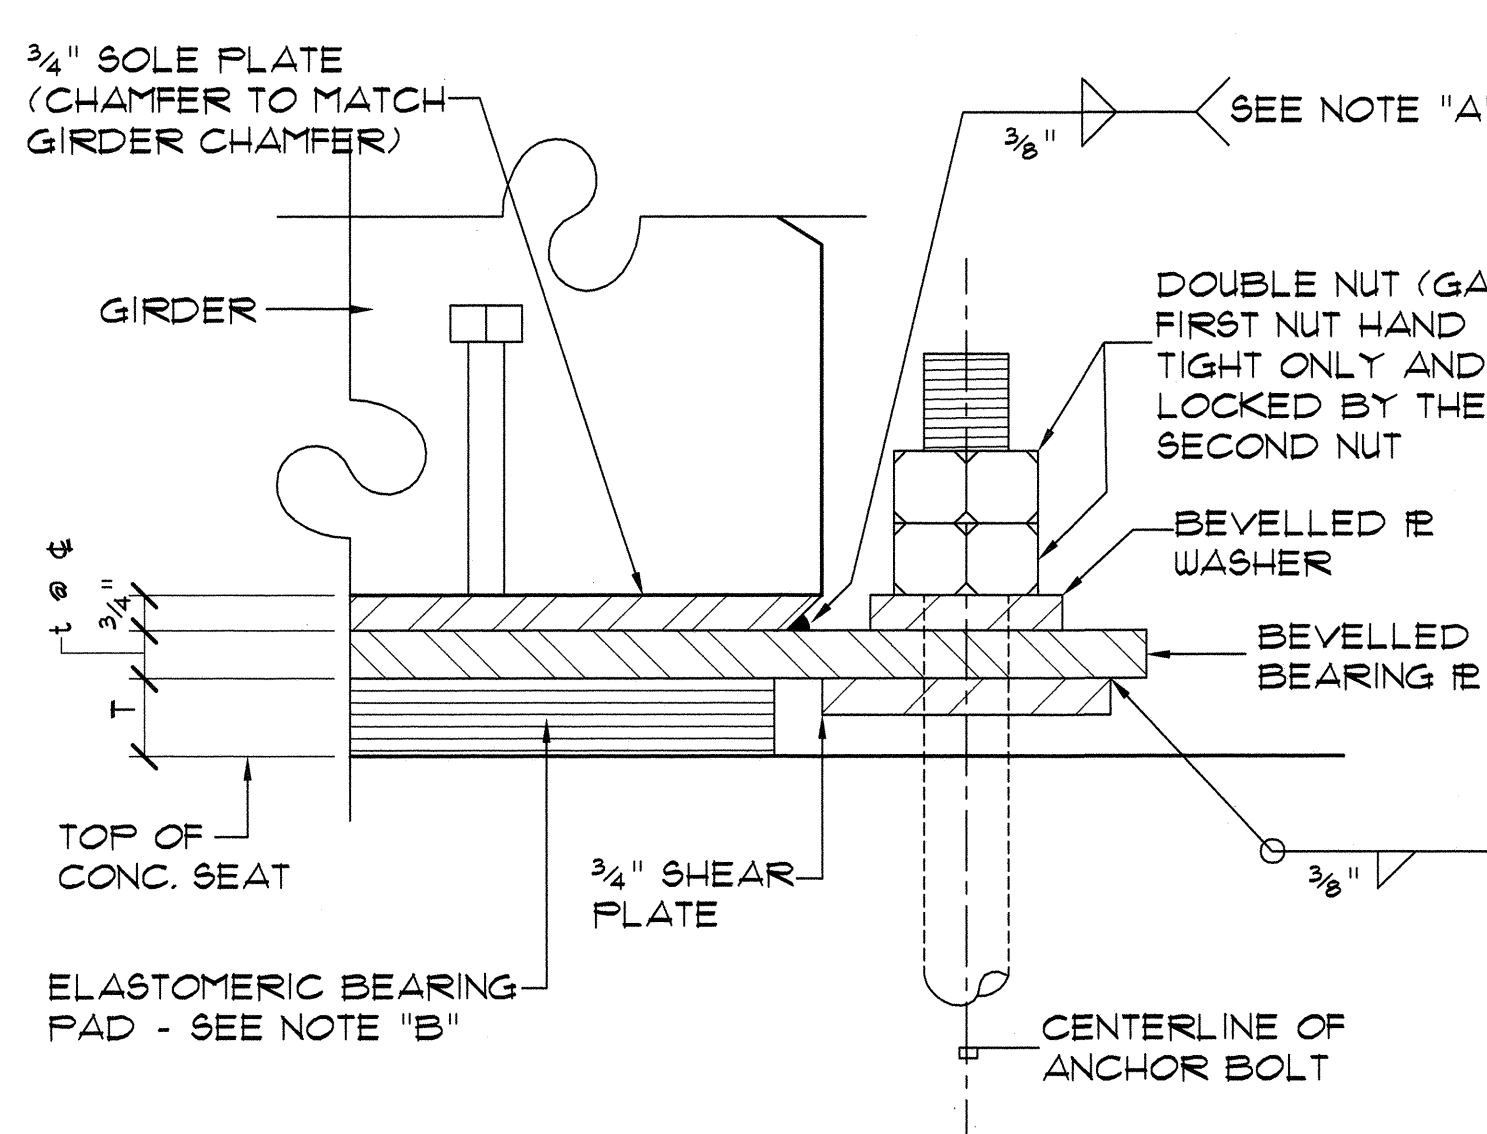

**DETAIL 1**  
 S-11 | S-11 NOT TO SCALE

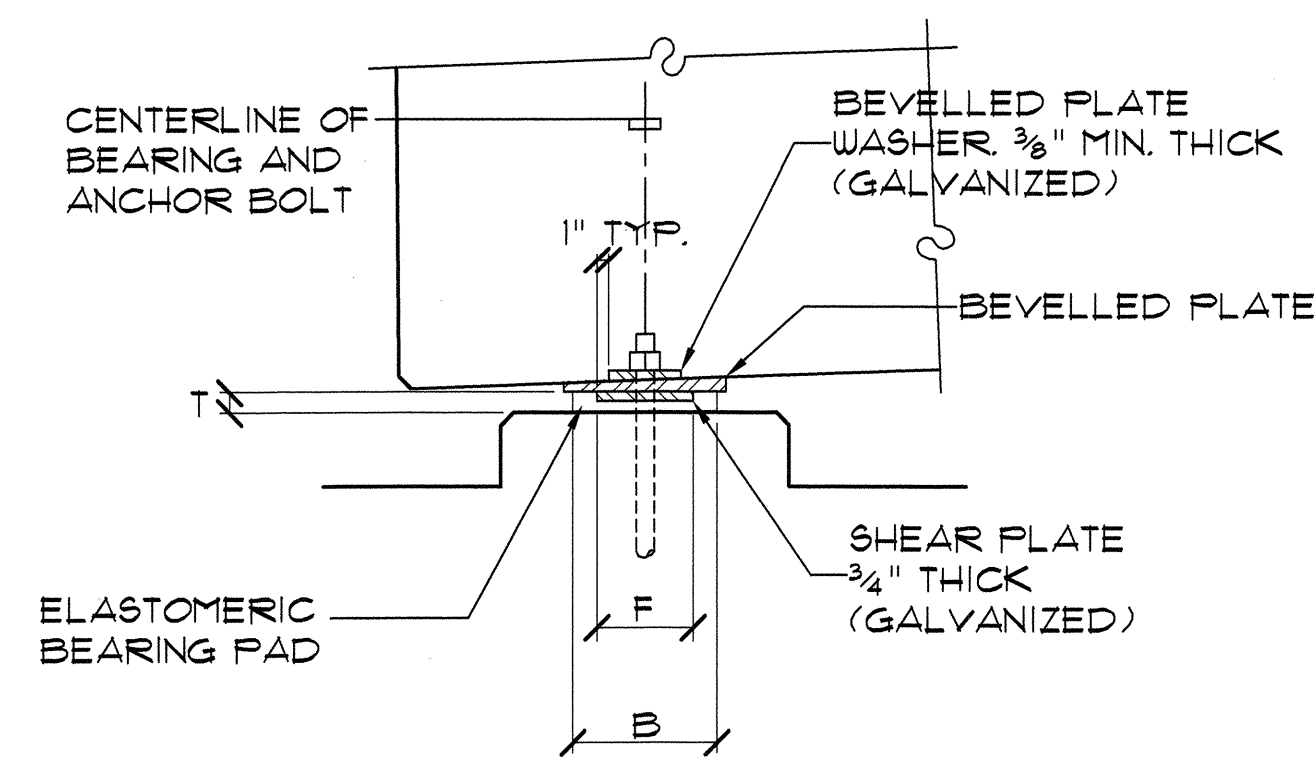


**SECTION C**  
 S-11 | S-11 NOT TO SCALE

- NOTES**
- THE CONTRACTOR SHALL MINIMIZE AND DISSIPATE THE HEAT GENERATION DURING THE FIELD WELDING OF THE 3/4" SOLE PLATE TO THE BEVELLED BEARING PLATE. THE CONTRACTOR SHALL TAKE ALL NECESSARY PRECAUTIONS TO AVOID BURNING THE ELASTOMERIC BEARING PAD DURING WELDING. WELDING OF THE SOLE PLATE TO THE BEARING PLATE SHALL BE DONE PRIOR TO PLACEMENT OF THE DIAPHRAMS AND DECK.
  - ALL ELASTOMERIC BEARING PAD BE STEEL LAMINATED ELASTOMERIC PAD WITH 60 HARDNESS. BEARING PAD SIZE SHALL BE AS SHOWN ON SHEET S-12.
  - AT TIME OF INSTALLATION OF GIRDERS, ANCHOR BOLTS AT EXPANSION END SHALL BE POSITIONED SUCH THAT THEY ARE LOCATED AT THE WAIMEA SIDE OF THE SLOTTED HOLES.

BEARING AND ANCHOR BOLT TABLE														
BEARING TYPE	ELASTOMERIC BEARING PAD			STEEL PLATE DIMENSIONS				ANCHOR BOLT HOLES		ANCHOR BOLT			ANCHOR PLATE DIMENSIONS	
	A	B	T	C	D	E	F	t	BR'G. (H)	BR'G. (E)	φ	L	M	N
I	24"	12"	3-1/8"	32"	3 3/4"	6"	8"	*	1 3/4"	1 3/4" x 4"	1 1/2"	36"	9"	8"


\* - SEE GIRDER SCHEDULE ON SHEET S-10.

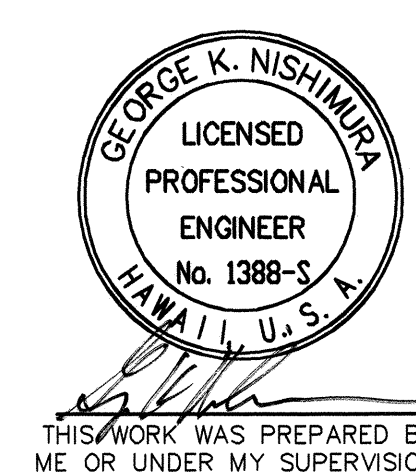

THIS WORK WAS PREPARED BY ME OR UNDER MY SUPERVISION.

1/30/02	Revise Bearing Pad
Date	Revision
STATE OF HAWAII DEPARTMENT OF TRANSPORTATION HIGHWAYS DIVISION  TYPICAL GIRDER BEARING DETAILS  KAUMUALII HIGHWAY INTERSECTION IMPROVEMENTS AT KOLOA ROAD PROJECT NO. STP-050-1(17)	
SHEET No. 8-11 OF 17 SHEETS	

FED. ROAD DIST. NO.	STATE	FED. AID PROJ. NO.	FISCAL YEAR	SHEET NO.	TOTAL SHEETS
HAWAII	HAW.	STP-050-1(17)	2000	54	72

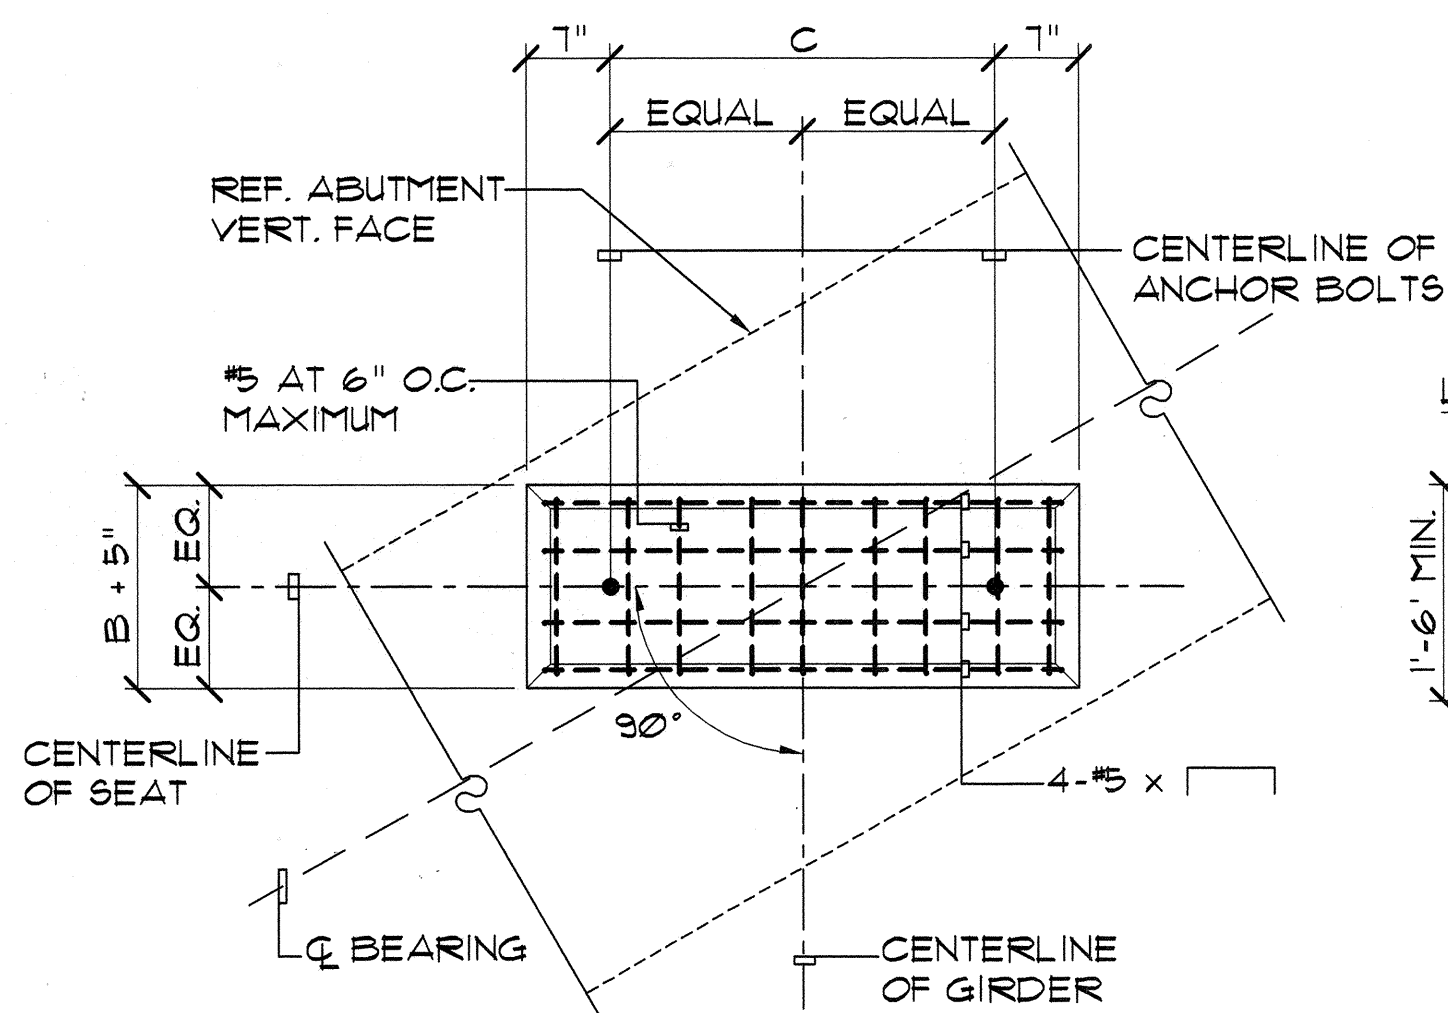

TYPICAL CONCRETE SEAT DETAIL

NOT TO SCALE

BRIDGE GENERAL NOTES

- A. **GENERAL SPECIFICATIONS:** HAWAII DEPARTMENT OF TRANSPORTATION, STANDARD SPECIFICATIONS FOR ROAD, BRIDGE, AND PUBLIC WORKS CONSTRUCTION, 1994, TOGETHER WITH SPECIAL PROVISIONS PREPARED FOR THIS CONTRACT.
- B. **DESIGN SPECIFICATIONS:** A.A.S.H.T.O. STANDARD SPECIFICATIONS FOR HIGHWAY BRIDGES, 15TH EDITION (1992), AND ITS SUBSEQUENT INTERIM SPECIFICATIONS.
- C. **DESIGN LOADS:**
- DEAD LOAD:** AN ALLOWANCE FOR 1-1/2 INCHES OF WEARING SURFACE OF ASPHALT CONCRETE HAS BEEN PROVIDED FOR IN THE DESIGN.
  - LIVE LOAD:** HS20-44 OR INTERSTATE LOADING.
  - SEISMIC LOAD:** ACCELERATION COEFFICIENT - 0.09
- D. **MATERIALS:**
- ALL CONCRETE EXCEPT PRESTRESSED CONCRETE GIRDERS SHALL BE 4,000 PSI CONCRETE UNLESS OTHERWISE NOTED.
  - ALL REINFORCING STEEL SHALL CONFORM TO ASTM A615, GRADE 60 UNLESS OTHERWISE NOTED.
  - ALL STRUCTURAL STEEL ITEMS FOR GIRDER BEARING ASSEMBLY SHALL CONFORM TO ASTM A588. ENTIRE FABRICATED ASSEMBLY INCLUDING ANCHORS SHALL BE HOT-DIP GALVANIZED.
  - ALL STEEL PIPE SECTIONS SHALL CONFORM TO ASTM A53, GRADE B AND SHALL BE HOT-DIP GALVANIZED AFTER FABRICATION.
  - ALL ANCHOR BOLTS, WASHERS AND NUTS SHALL CONFORM TO ASTM A307 AND SHALL BE HOT-DIP GALVANIZED AFTER FABRICATION.
  - OTHER MISCELLANEOUS STEEL PLATES SHALL CONFORM TO ASTM A36 AND SHALL BE HOT-DIP GALVANIZED AFTER FABRICATION.
  - FOR MATERIALS OF PRESTRESSED CONCRETE GIRDERS, SEE PRESTRESSED CONCRETE NOTES.
- E. **DESIGN STRESSES:** SHALL FOLLOW A.A.S.H.T.O. STANDARD SPECIFICATIONS FOR HIGHWAY BRIDGES IN ADDITION TO THOSE LISTED BELOW.
- | CONCRETE CLASS "A" |           |           |
|--------------------|-----------|-----------|
| $f_c$              | 3,000 PSI | 4,000 PSI |
| $f_t$              | 1,200 PSI | 1,600 PSI |
| $n$                | 9         | 8         |
- FOR PRESTRESSED CONCRETE GIRDERS, SEE PRESTRESSED GIRDER NOTES.
- F. **REINFORCEMENT:**
- UNLESS OTHERWISE NOTED, THE COVER MEASURED FROM THE SURFACE OF THE CONCRETE TO THE FACE OF ANY REINFORCING BARS SHALL BE AS FOLLOWS:
    - DECK SLABS
      - TOP BARS = 1-1/2"
      - BOTTOM BARS = 1-1/4"
    - BEAMS = 1-1/2" TO STIRRUPS
    - FOR PRESTRESSED CONCRETE GIRDERS, SEE GIRDER DETAILS.
    - ABUTMENTS AND RETAINING WALLS = 2"
    - CONCRETE CAST AGAINST AND PERMANENTLY EXPOSED TO EARTH = 3"
  - REINFORCING BARS SHALL BE DETAILED IN ACCORDANCE WITH ACI MANUAL OF STANDARD PRACTICE FOR DETAILING REINFORCED CONCRETE HIGHWAY STRUCTURES UNLESS OTHERWISE NOTED.
  - MINIMUM CLEAR SPACING BETWEEN PARALLEL BARS SHALL BE 1-1/2 TIMES THE DIAMETER OF BARS (FOR NON BUNDLED BARS). BUT IN NO CASE SHALL THE CLEAR DISTANCE BETWEEN THE BARS BE LESS THAN 1-1/2 TIMES THE MAXIMUM SIZE OF THE COARSE AGGREGATE.
  - ALL DIMENSIONS RELATING TO REINFORCING BARS (E.G. SPACING OF BARS, ETC.) ARE TO CENTERS OF BARS UNLESS OTHERWISE NOTED.
  - REINFORCING BARS SHALL BE SECURELY TIED AT ALL INTERSECTIONS AND LAP SPLICES EXCEPT WHERE THE SPACING OF INTERSECTIONS IS LESS THAN ONE FOOT IN EACH DIRECTION, IN WHICH CASE ALTERNATE INTERSECTIONS SHALL BE TIED.
- G. **GIRDER BEARINGS:**
- GIRDER CONCRETE SEATS RECEIVING ELASTOMERIC BEARING PADS SHALL BE POURED MONOLITHICALLY WITH SUPPORTING STRUCTURE. TOP OF CONCRETE SEATS SHALL BE FINISHED WITH A STEEL TROWEL TO A SMOOTH LEVEL SURFACE TO THE ELEVATION SHOWN ON THE PLANS.
  - BOTTOM OF BRIDGE ELASTOMERIC BEARING PADS SHALL BE SECURED TO THE CONCRETE SEATS, TO PREVENT DISPLACEMENT, WITH ADHESIVES APPROVED BY THE ENGINEER.

CONSTRUCTION NOTES:

- SEE STANDARD SPECIFICATIONS AND SPECIAL PROVISIONS.
- IN GENERAL, TOP OF CONCRETE DECK SLAB SHALL BE CONSTRUCTED TO FOLLOW THE ROADWAY VERTICAL AND HORIZONTAL CURVES.
- FOR THE INSTALLATION OF ANCHOR BOLTS FOR BRIDGE BEARINGS, THE CONTRACTOR SHALL PROVIDE RIGID TEMPLATES TO MAINTAIN THE PROPER LOCATIONS AND SHALL PROTECT SUCH ANCHOR BOLTS AT ALL TIMES DURING THE PERIOD OF CONSTRUCTION. METHODS SHALL BE APPROVED BY THE ENGINEER.
- EXCEPT AS OTHERWISE NOTED, ALL VERTICAL DIMENSIONS ARE MEASURED PLUMB.
- THE CONTRACTOR SHALL VERIFY ALL EXISTING SITE CONDITIONS.
- THE CONTRACTOR SHALL VERIFY THE LOCATION OF ALL UTILITY LINES AND NOTIFY THE RESPECTIVE OWNERS BEFORE COMMENCING WITH WORK.
- FOR CONCRETE FINISH, SEE STANDARD SPECIFICATIONS.
- CONSTRUCTION JOINTS MAY BE RELOCATED OR ADDITIONAL ONES ADDED SUBJECT TO THE APPROVAL OF THE ENGINEER.
- UNLESS OTHERWISE NOTED, ALL EXPOSED CONCRETE EDGES SHALL BE CHAMFERED 3/4" x 3/4".
- STRUCTURAL BACKFILL FOR ABUTMENT WALLS SHALL NOT BE PLACED UNTIL AFTER DECK CONCRETE IS PLACED AND SHORINGS FOR BRIDGE GIRDERS REMOVED.
- CLOSURE STRIP OF CONCRETE BETWEEN EXISTING BRIDGE AND NEW WIDENED AREA SHALL NOT BE PLACED UNTIL 120 DAYS AFTER LAST DECK CONCRETE HAS BEEN PLACED. EXISTING BRIDGE RAILING SECTION, EXCEPT AS MAY BE REQUIRED TO INSTALL GIRDER "G-1", SHALL NOT BE REMOVED UNTIL THIS PHASE.


GENERAL:

- ALL ITEMS NOTED INCIDENTAL WILL NOT BE PAID FOR SEPARATELY.
- STANDARD DETAIL DRAWINGS REFER TO ALL STRUCTURES IN GENERAL, EXCEPT FOR MODIFICATIONS AS MAY BE REQUIRED FOR SPECIAL CONDITIONS. FOR SUCH MODIFICATIONS, REFER TO THE CORRESPONDING DETAILED DRAWINGS.

FOUNDATION:

THESE FOUNDATION NOTES WERE BASED ON RECOMMENDATIONS CONTAINED IN A REPORT "FOUNDATION INVESTIGATION, KAUMUALII HIGHWAY, INTERSECTION IMPROVEMENTS AT KOLOA ROAD, LAWA, KAUAI, HAWAII" DATED JUNE 19, 1995 ALONG WITH A FAX MEMORANDUM REGARDING DRILLED SHAFT RECOMMENDATIONS DATED MARCH 12, 2002 BY ERNEST K. HIRATA & ASSOCIATES, INC.

- BRIDGE ABUTMENT NO.1 AND RETAINING WALLS:
  - FOOTINGS FOR BRIDGE ABUTMENT NO.1 AND RETAINING WALLS SHALL BEAR AT THE INDICATED ELEVATIONS ON THE UNDERLYING STIFF UNDISTURBED SILTY CLAY. FOOTINGS FOR SHORINGS DURING CONSTRUCTION SHALL ALSO BEAR ON STIFF UNDISTURBED SILTY CLAY.
  - DESIGN SOIL PARAMETERS:
    - ALLOWABLE SOIL BEARING PRESSURE = 4,000 PSF
    - COEFFICIENT OF FRICTION = 0.40
    - PASSIVE EARTH PRESSURE = 350 PCF
    - ACTIVE EARTH PRESSURE = 40 PCF (LEVEL BACKFILL)
- BRIDGE ABUTMENT NO.2:
  - 36-INCH DIAMETER DRILLED SHAFTS:
    - THE VERTICAL BEARING LOAD CAPACITY FOR THE 36-INCH DIAMETER DRILLED SHAFTS ARE FROM FRICTION BETWEEN THE SHAFT AND THE SURROUNDING SOIL. THE NET VERTICAL LOAD PARAMETER USED FOR DESIGN IS 390 KIPS WITH AN ESTIMATED SHAFT TIP ELEVATION OF +429.00'.
    - THE LATERAL LOAD CAPACITY FOR THE 36-INCH DIAMETER DRILLED SHAFTS (FIXED-HEAD CONDITION) USED FOR DESIGN IS 55 KIPS.
    - THE DRILLED SHAFTS ESTIMATED TIP ELEVATIONS SHOWN ON THE PLANS ARE BASED ON THE BORING DATA. THE ACTUAL TIP ELEVATIONS COULD CHANGE DUE TO VARYING SUBSURFACE CONDITIONS. SOILS ENGINEER OF RECORD SHALL BE PRESENT DURING THE DRILLING OPERATION TO DETERMINE THAT THE ACTUAL SUBSURFACE CONDITIONS ARE CONSISTENT WITH THE CONDITIONS ASSUMED FOR DESIGN. BASED ON THE RECOMMENDATIONS, THE TIP ELEVATIONS COULD CHANGE. THE CONTRACTOR SHALL MAKE PROVISIONS FOR EXTENSION OF THE REINFORCING STEEL CAGES FOR THE DRILLED SHAFTS TO ACCOUNT FOR VARIATIONS IN THE FINAL TIP ELEVATIONS.

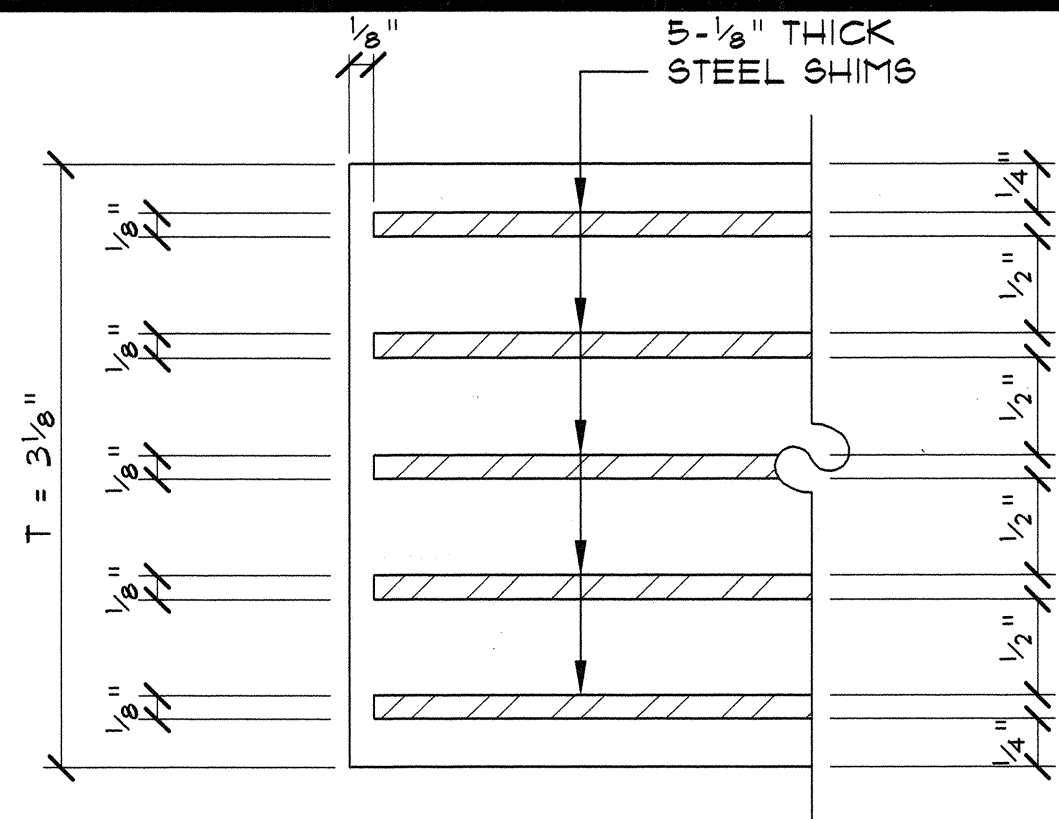

ELASTOMERIC BEARING PAD

A  
S-12 S-12 FULL SCALE

- THE CONTRACTOR SHALL EXERCISE CARE IN DRILLING THE SHAFT HOLES AND IN PLACING CONCRETE INTO THE HOLES. COBBLES AND BOULDERS MAY BE ENCOUNTERED DURING DRILLING OPERATIONS. TEMPORARY CASING MAY BE NEEDED TO REDUCE THE POTENTIAL FOR CAVING IN OF THE HOLES. THE USE OF PERMANENT CASING WILL NOT BE ALLOWED.
- DRILLING SHALL NOT BE CONDUCTED BY METHODS UTILIZING DRILLING FLUIDS.
- CONCRETE FOR DRILLED SHAFTS SHALL BE PLACED WITHIN 24 HOURS AFTER DRILLING TO REDUCE THE POTENTIAL FOR CAVING IN. DRILLED SHAFTS SHALL BE POURED IN ONE CONTINUOUS LIFT.
- IF WATER IS ENCOUNTERED IN THE DRILLED HOLES, PLACEMENT OF CONCRETE SHALL BE BY TREMIE METHODS. A MINIMUM OF 5 FEET OF CONCRETE HEAD SHALL BE MAINTAINED ABOVE THE BOTTOM OF THE TREMIE PIPE DURING PLACEMENT OF CONCRETE.

PRESTRESSED GIRDER NOTES

- CONCRETE FOR PRESTRESSED CONCRETE GIRDERS SHALL BE 6,000 PSI MINIMUM.
- MINIMUM CONCRETE STRENGTH AT INITIAL PRESTRESS TRANSFER OR RELEASE OF STRANDS SHALL BE 5,500 PSI.
- PRESTRESSING STRANDS SHALL BE 7-WIRE 1/2 INCH DIAMETER LOW-RELAXATION STEEL STRANDS (AREA = 0.153 SQUARE INCH) WITH AN ULTIMATE STRENGTH OF 270 KSI. FOR PROPERTIES, SEE STATE STANDARD SPECIFICATIONS.
- NON-PRESTRESSED REINFORCING STEEL SHALL CONFORM TO ASTM A615, GRADE 60 UNLESS OTHERWISE NOTED ON PLANS. FOR PROPERTIES, SEE STATE STANDARD SPECIFICATIONS.
- STRAND PATTERN SHALL BE SYMMETRICAL ABOUT THE LONGITUDINAL CENTERLINE OF THE GIRDERS.
- STRAND RELEASE SEQUENCE SHALL NOT INDUCE ANY LATERAL DEFLECTION OF THE GIRDER.
- THE CONTRACTOR SHALL SUBMIT HIS PROPOSED STRAND PATTERN AND RELEASING SEQUENCE TO THE ENGINEER FOR APPROVAL.
- DURING CURING, CARE SHALL BE TAKEN TO AVOID ANY LATERAL DEFLECTION OF THE GIRDER DUE TO IMPROPER ORIENTATION.
- LIFTING DEVICES SHALL BE PLACED AS CLOSE AS POSSIBLE TO THE CENTER LINE BEARING OF THE GIRDERS. DETAILS AND LOCATIONS OF LIFTING DEVICES SHALL BE SUBMITTED TO THE ENGINEER FOR APPROVAL. SUCH APPROVAL DOES NOT RELIEVE THE CONTRACTOR OF HIS RESPONSIBILITIES IF THE GIRDER IS DAMAGED DUE TO FAILURE OF THE LIFTING DEVICES.
- SEE FRAMING PLANS AND GIRDER DETAILS FOR LOCATION OF DIAPHRAGMS, BEARINGS, TYPE, AND CENTERLINE BEARING TO CENTERLINE BEARING LENGTH OF GIRDERS (L). LENGTH OF GIRDERS DO NOT INCLUDE EFFECT OF ELASTIC SHORTENING.
- THE CONTRACTOR SHALL INCORPORATE ALL HOLES, INSERTS AND OTHER EMBEDDED ITEMS REQUIRED IN GIRDERS DURING FABRICATION OF THE GIRDERS.
- GIRDERS SHALL BE SHORED AS SHOWN ON GIRDER SHORING DIAGRAM DURING PLACING OF CONCRETE FOR DECK, DIAPHRAGMS AND BEAMS. CONTRACTOR SHALL PROTECT SHORING FROM POSSIBILITY OF HEAVY STREAM FLOWS. SHORING SHALL NOT BE REMOVED UNTIL DECK SLAB HAS ATTAINED ITS 28-DAY STRENGTH.


3/18/02	Revise Bridge General Notes
1/30/02	Revise Bearing Pad
Date	Revision

STATE OF HAWAII  
DEPARTMENT OF TRANSPORTATION  
HIGHWAYS DIVISION

BRIDGE GENERAL NOTES  
AND TYPICAL DETAILS


KAUMUALII HIGHWAY INTERSECTION  
IMPROVEMENTS AT KOLOA ROAD  
PROJECT NO. STP-050-1(17)

SHEET No. S-12 OF 17 SHEETS

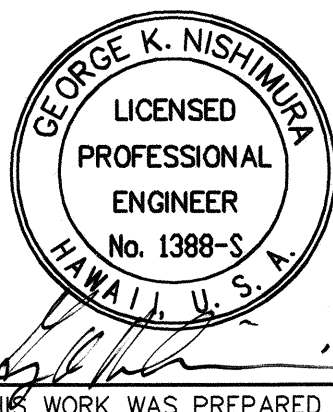


THIS WORK WAS PREPARED BY  
ME OR UNDER MY SUPERVISION.


FED. ROAD DIST. NO.	STATE	FED. AID PROJ. NO.	FISCAL YEAR	SHEET NO.	TOTAL SHEETS
HAWAII	HAW.	STP-050-1(17)	2000	55	72

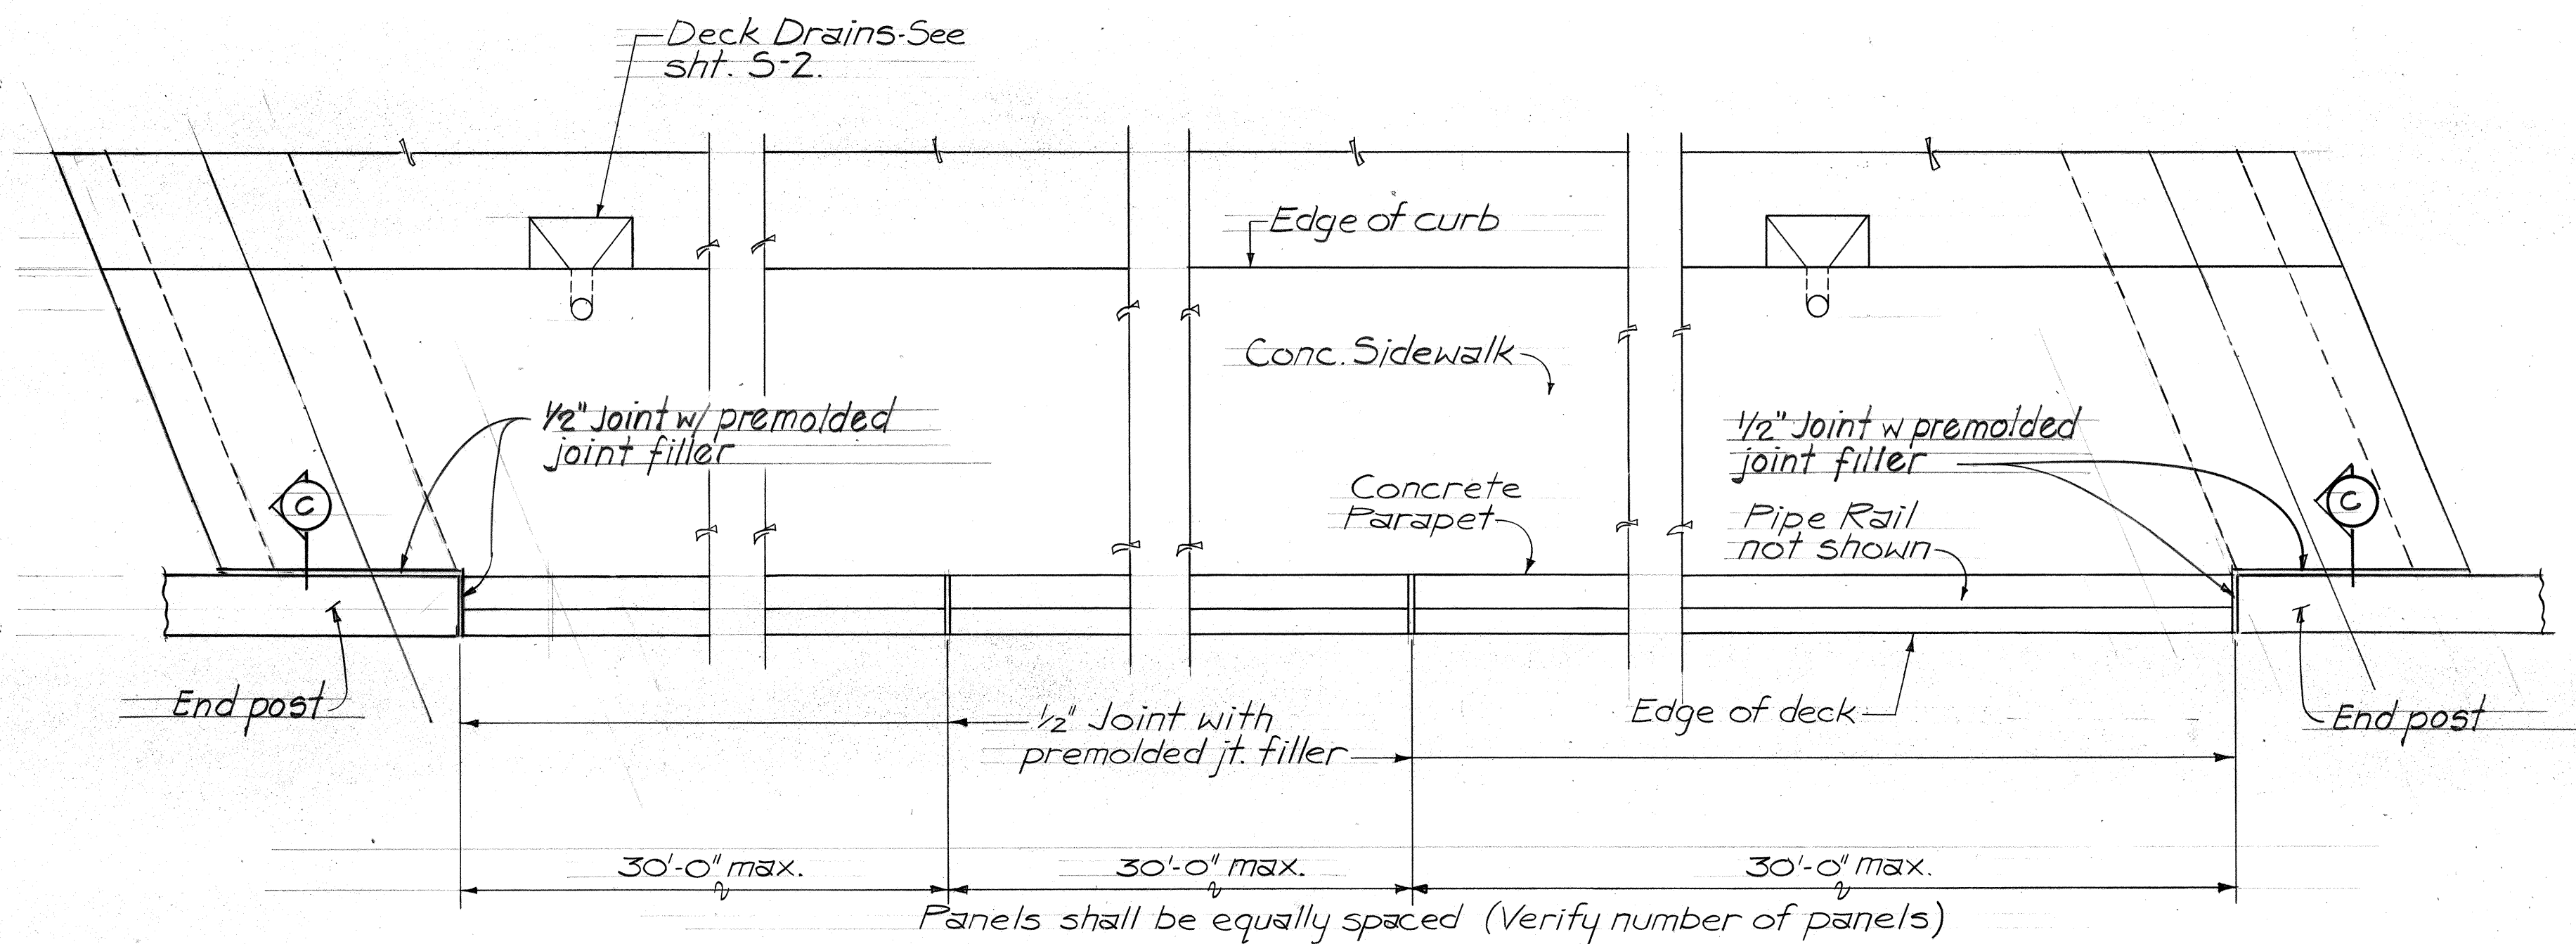

**PARTIAL CONCRETE PARAPET PLAN**  
Not to Scale

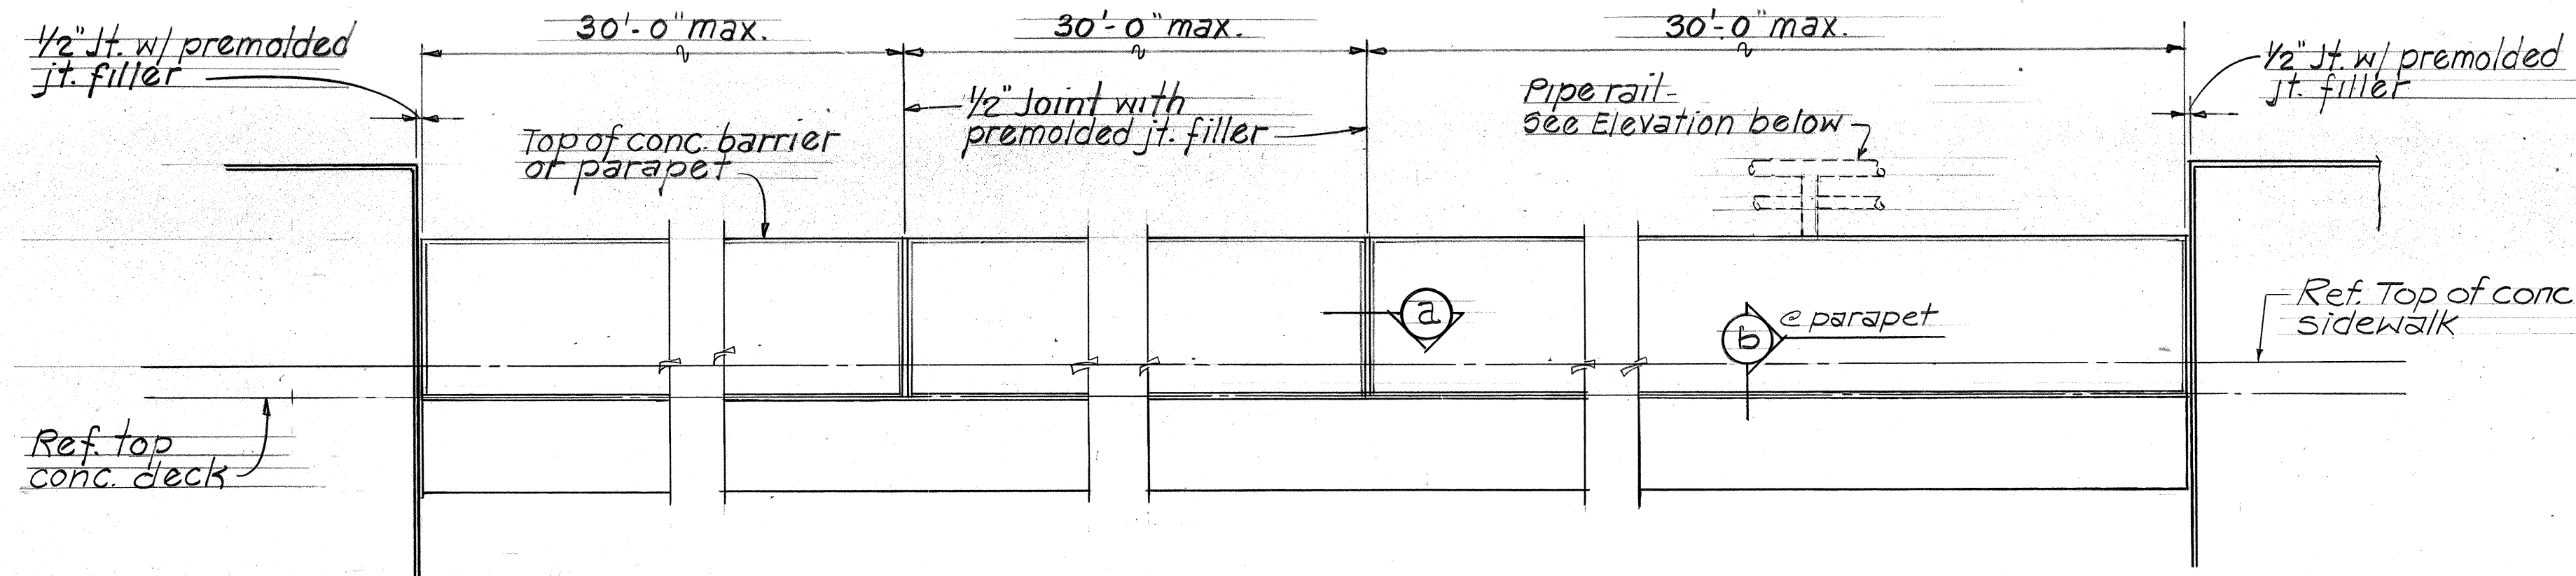


**PARTIAL CONCRETE PARAPET ELEVATION**  
Not to Scale

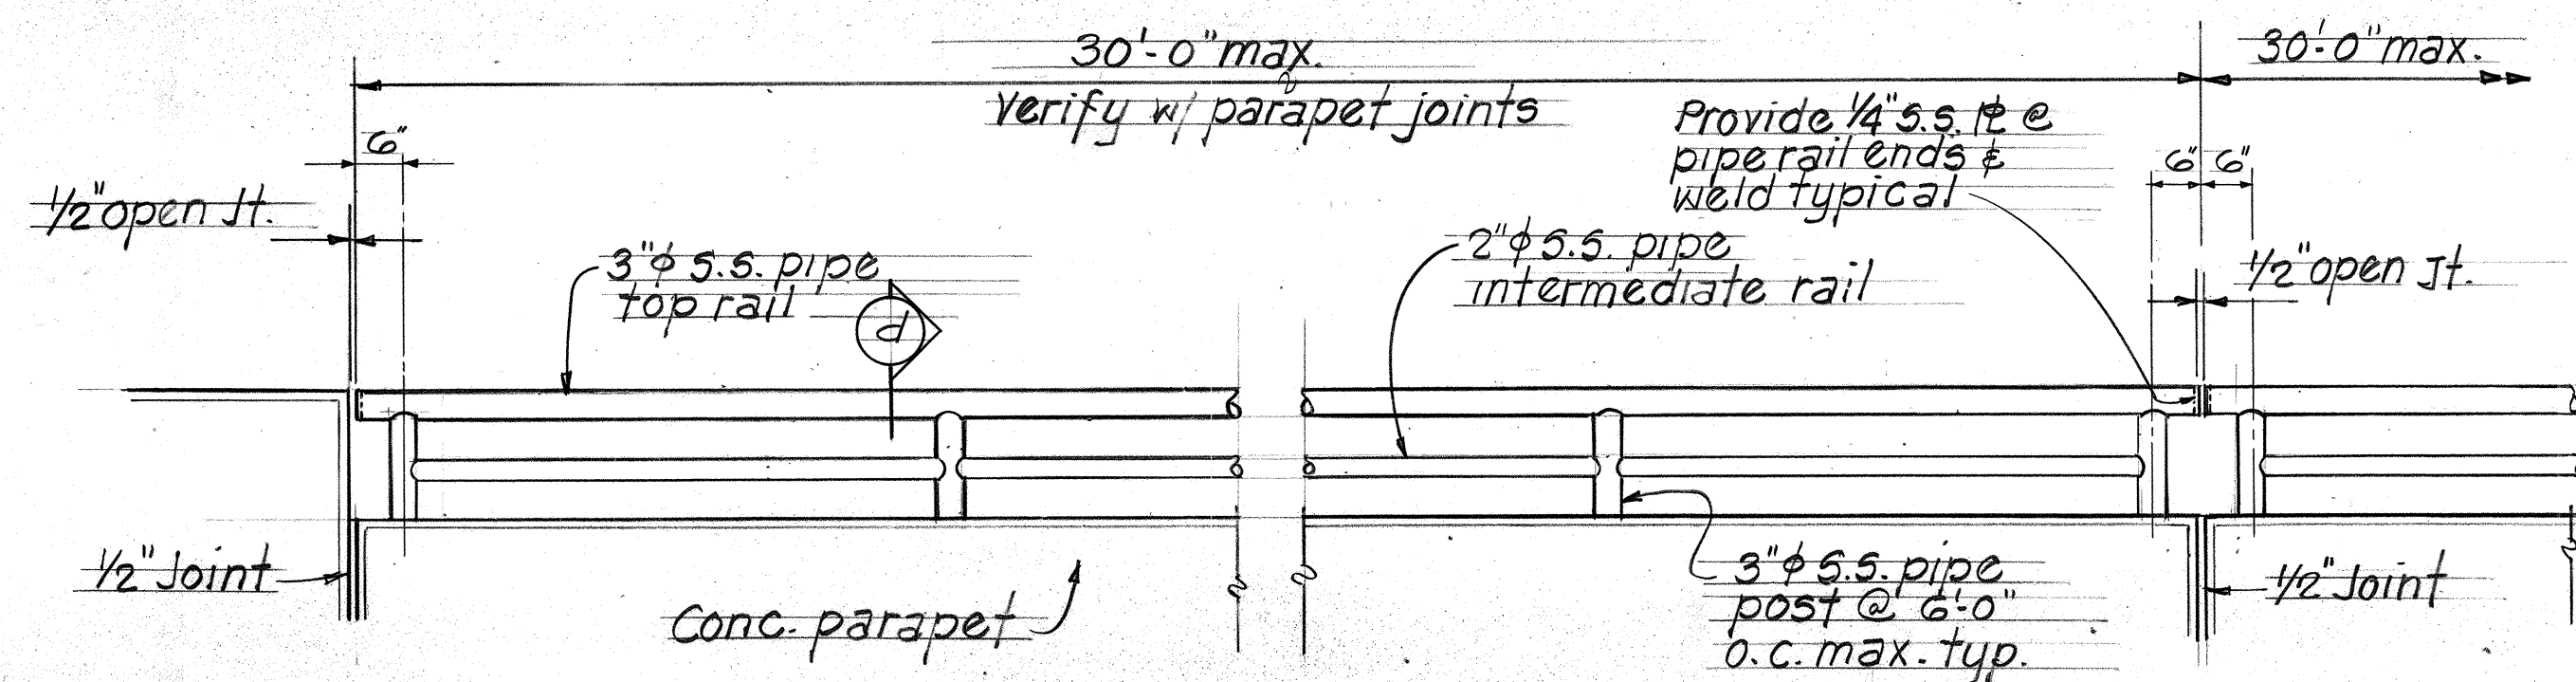


**PARTIAL PIPE RAIL ELEVATION**  
Scale: 1/2"=1'-0"


- NOTE:**
1. All stainless steel pipe, plates & rods shall conform to AISI Type 316.
  2. Grind all exposed welded joint on pipe rail smooth.

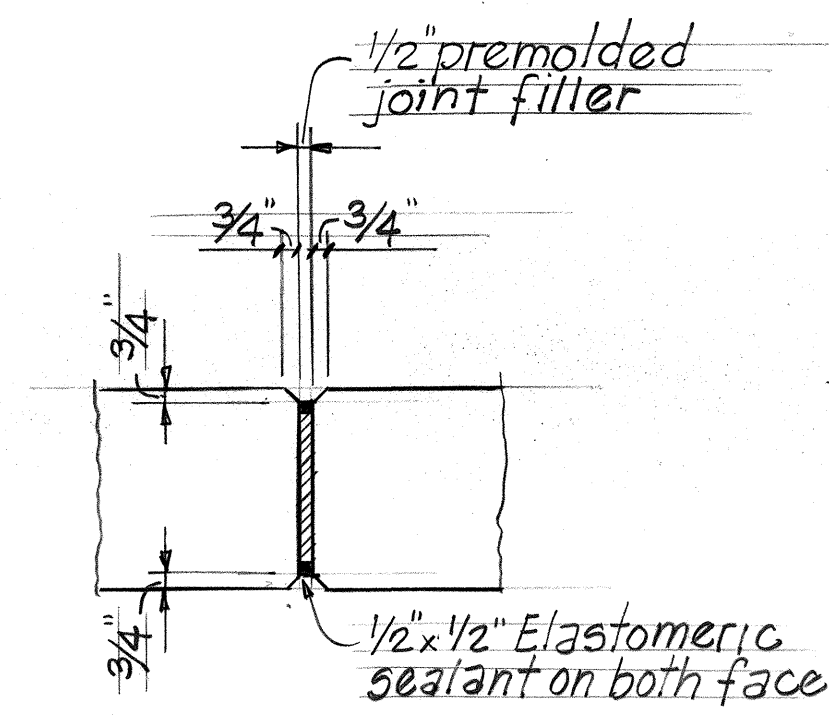


**SECTION (a)**  
Sc: 1 1/2"=1'-0"

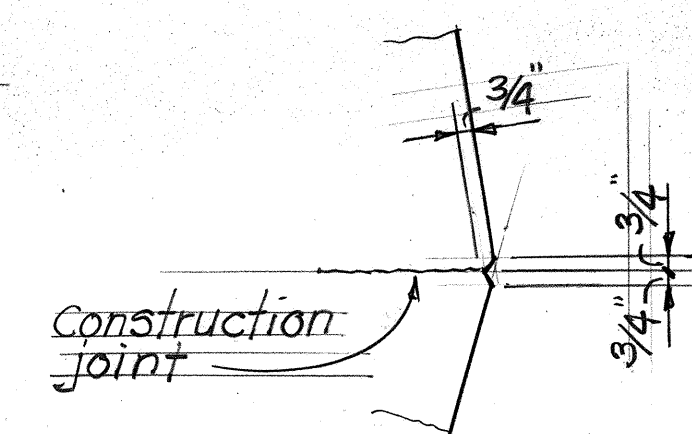


**SECTION (b)**  
Sc: 1 1/2"=1'-0"

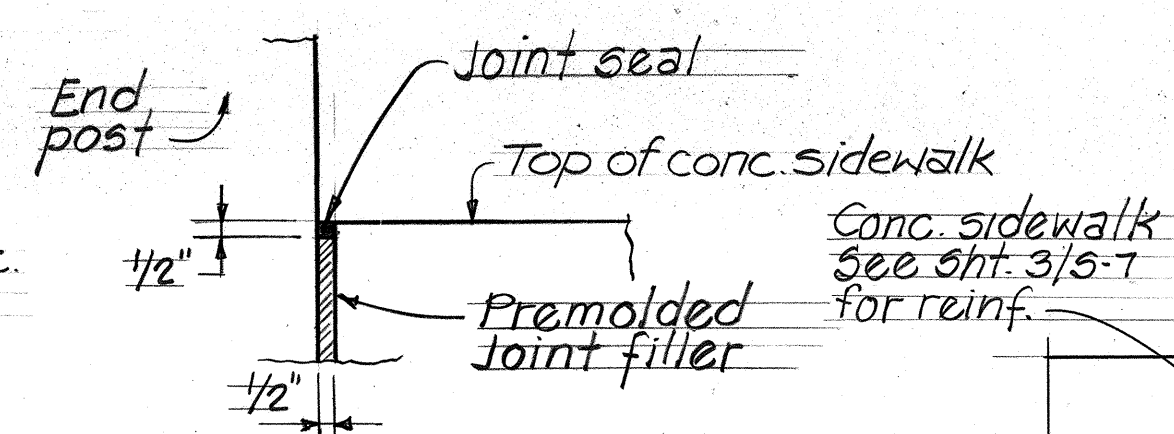


**SECTION (c)**  
Sc: 3\"/>

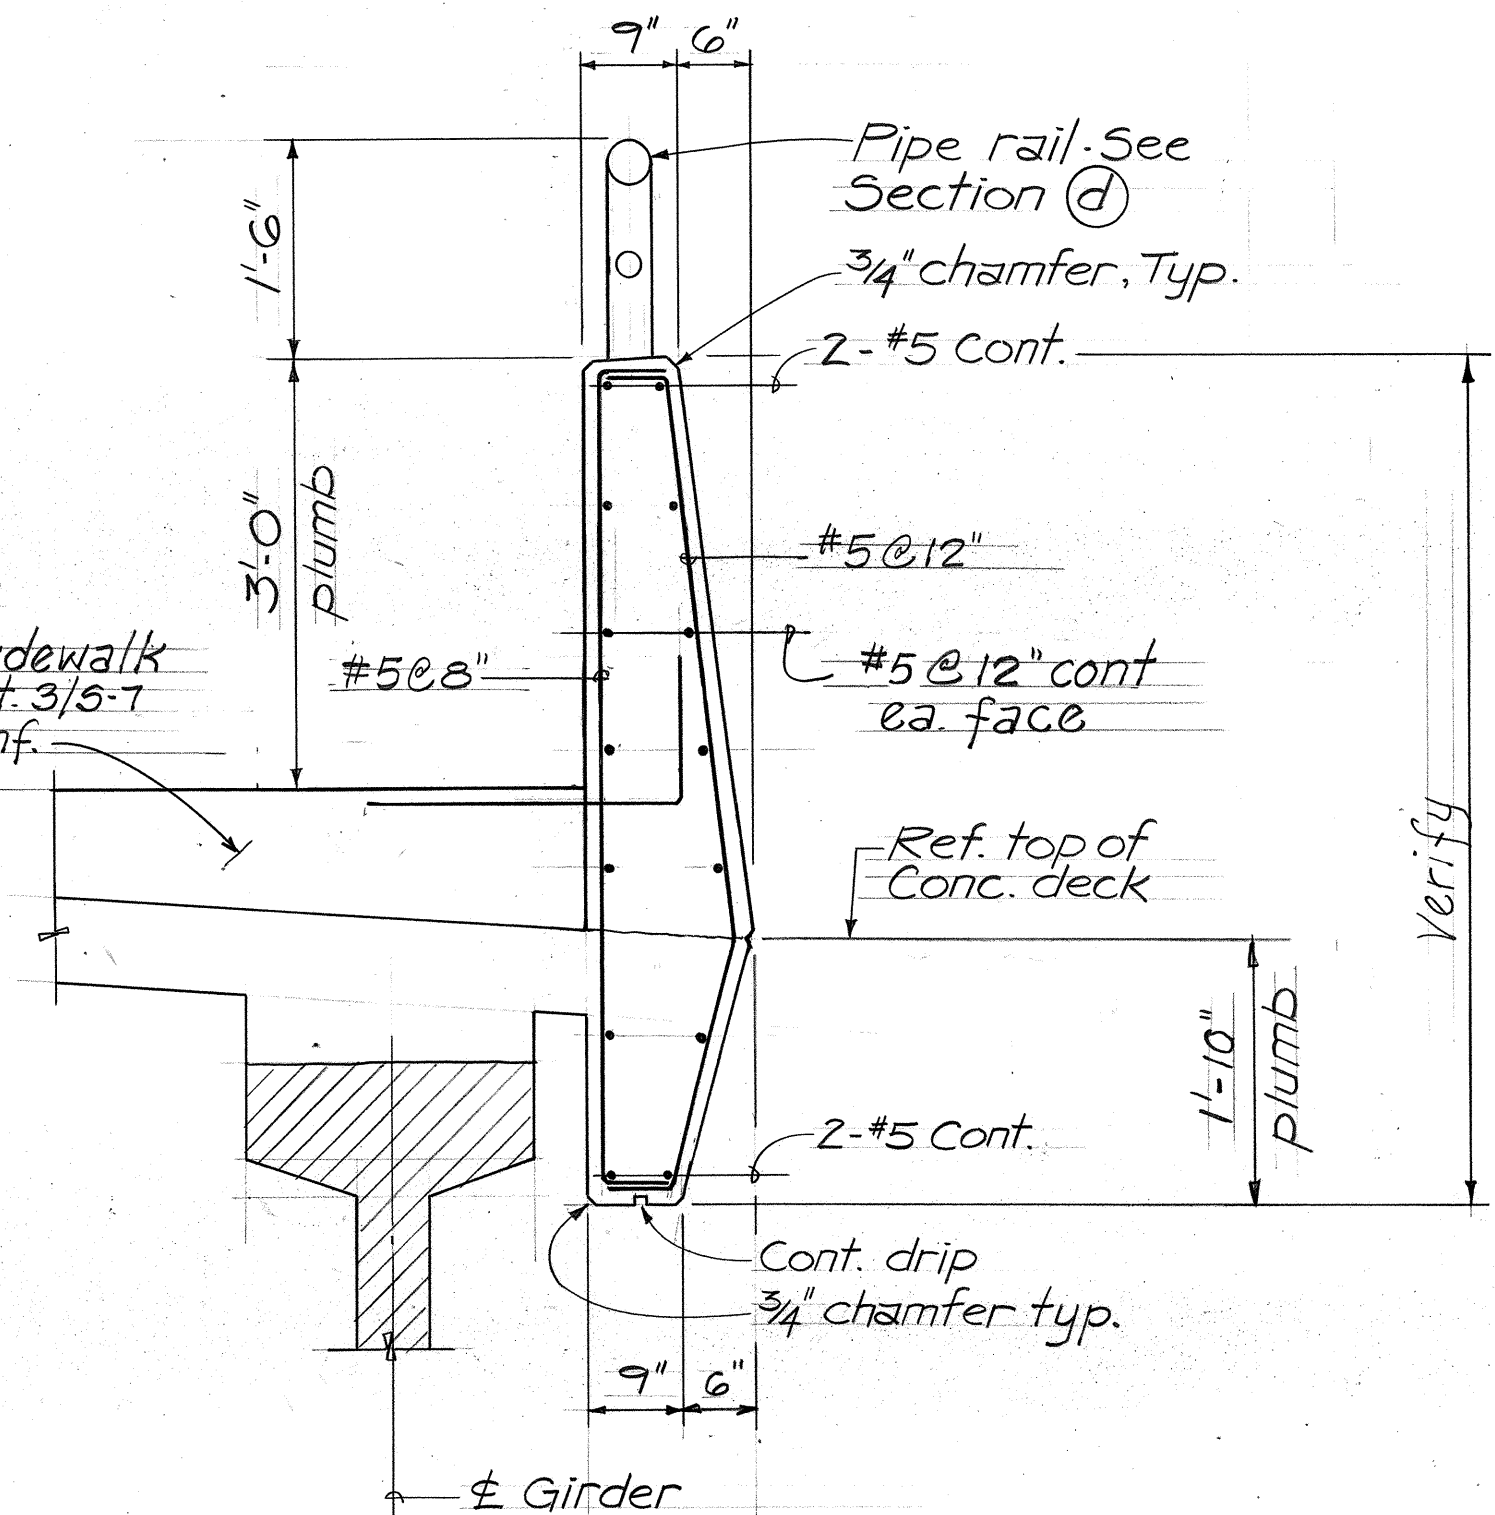

**TYP. CONC. PARAPET SECTION**  
Scale: 3/4"=1'-0"

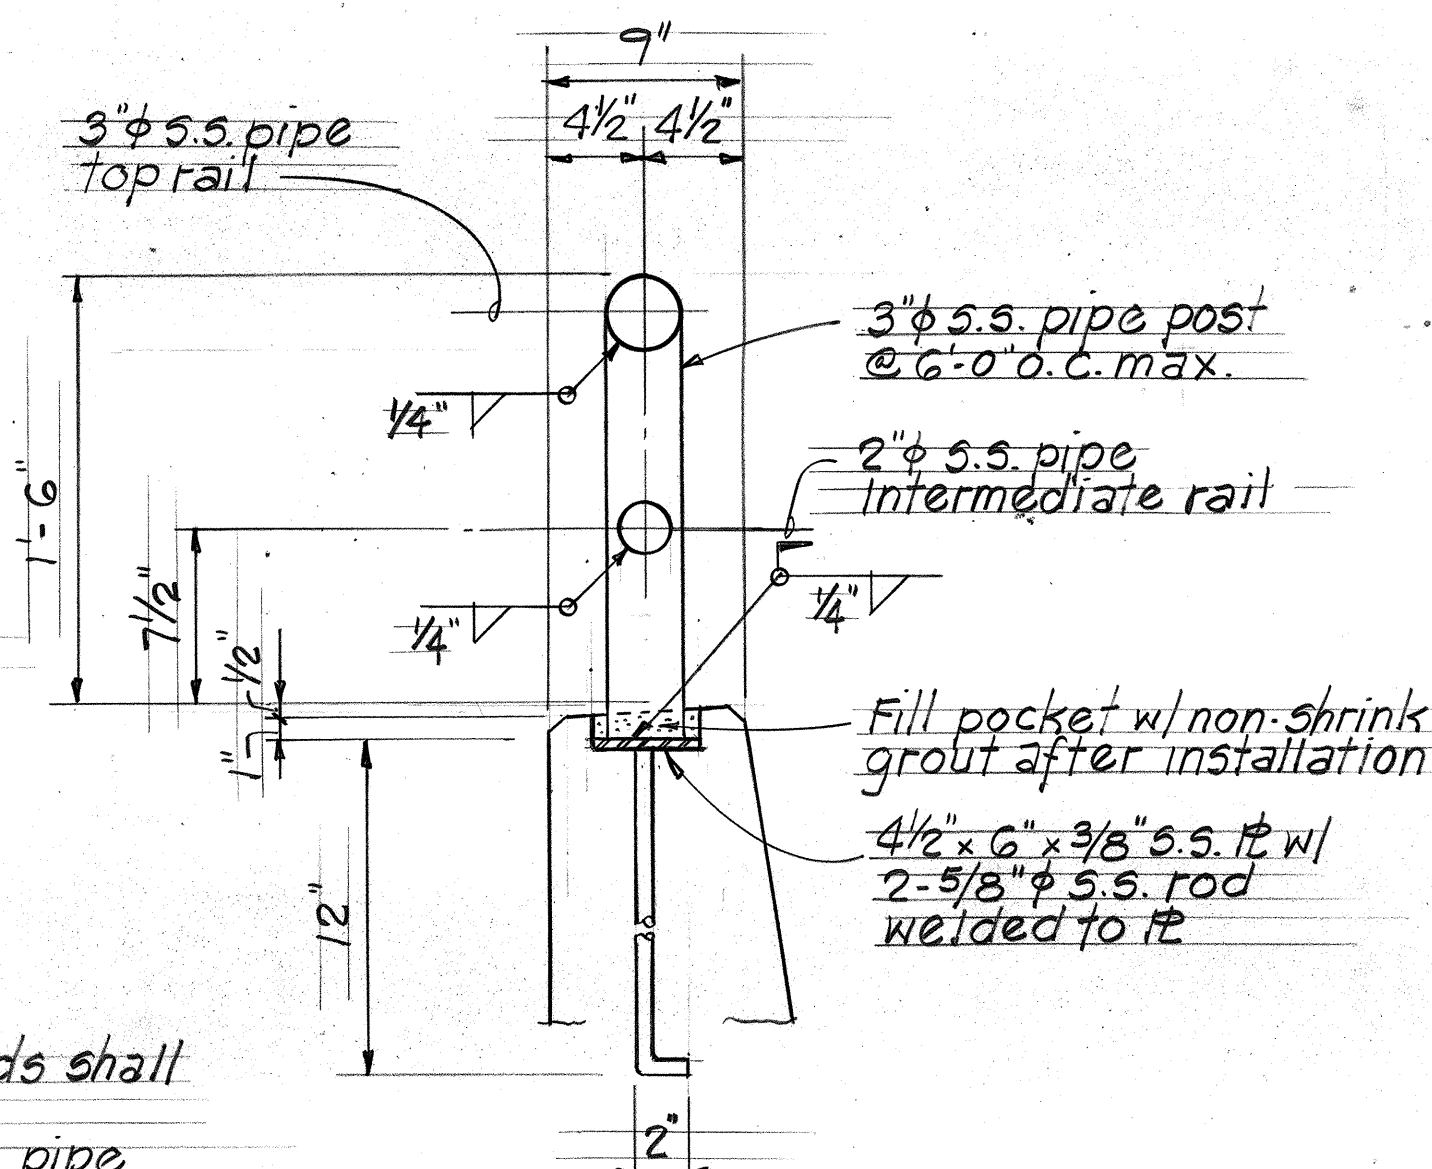

**SECTION (d)**  
Sc: 1 1/2"=1'-0"


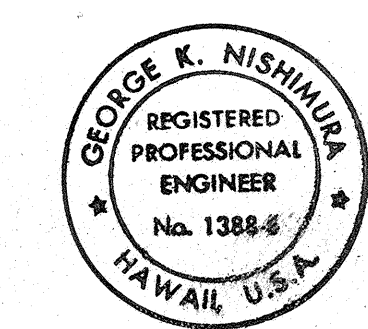


THIS WORK WAS PREPARED BY  
ME OR UNDER MY SUPERVISION.  
*G.K. Nishimura*


1/30/02	Revise dimension
Date	Revision
STATE OF HAWAII DEPARTMENT OF TRANSPORTATION HIGHWAYS DIVISION <b>CONCRETE PARAPET AND            PIPE RAIL DETAILS</b> KAUMUALI HIGHWAY INTERSECTION IMPROVEMENTS AT KOLOA ROAD FEDERAL AID PROJ. NO. STP-050-1(17) SCALE: AS NOTED DATE: OCT. 8, 1999 <b>SHEET No. 5-13 OF 17 SHEETS</b>	

SURVEY PLOTTED BY	DATE
DRAWN BY	
CHECKED BY	
NOTE BOOK	
NO.	


FED. ROAD DIST. NO.	STATE	FED. AID PROJ. NO.	FISCAL YEAR	SHEET NO.	TOTAL SHEETS
HAWAII	HAW.	STP-050-1(17)	2000	56	72

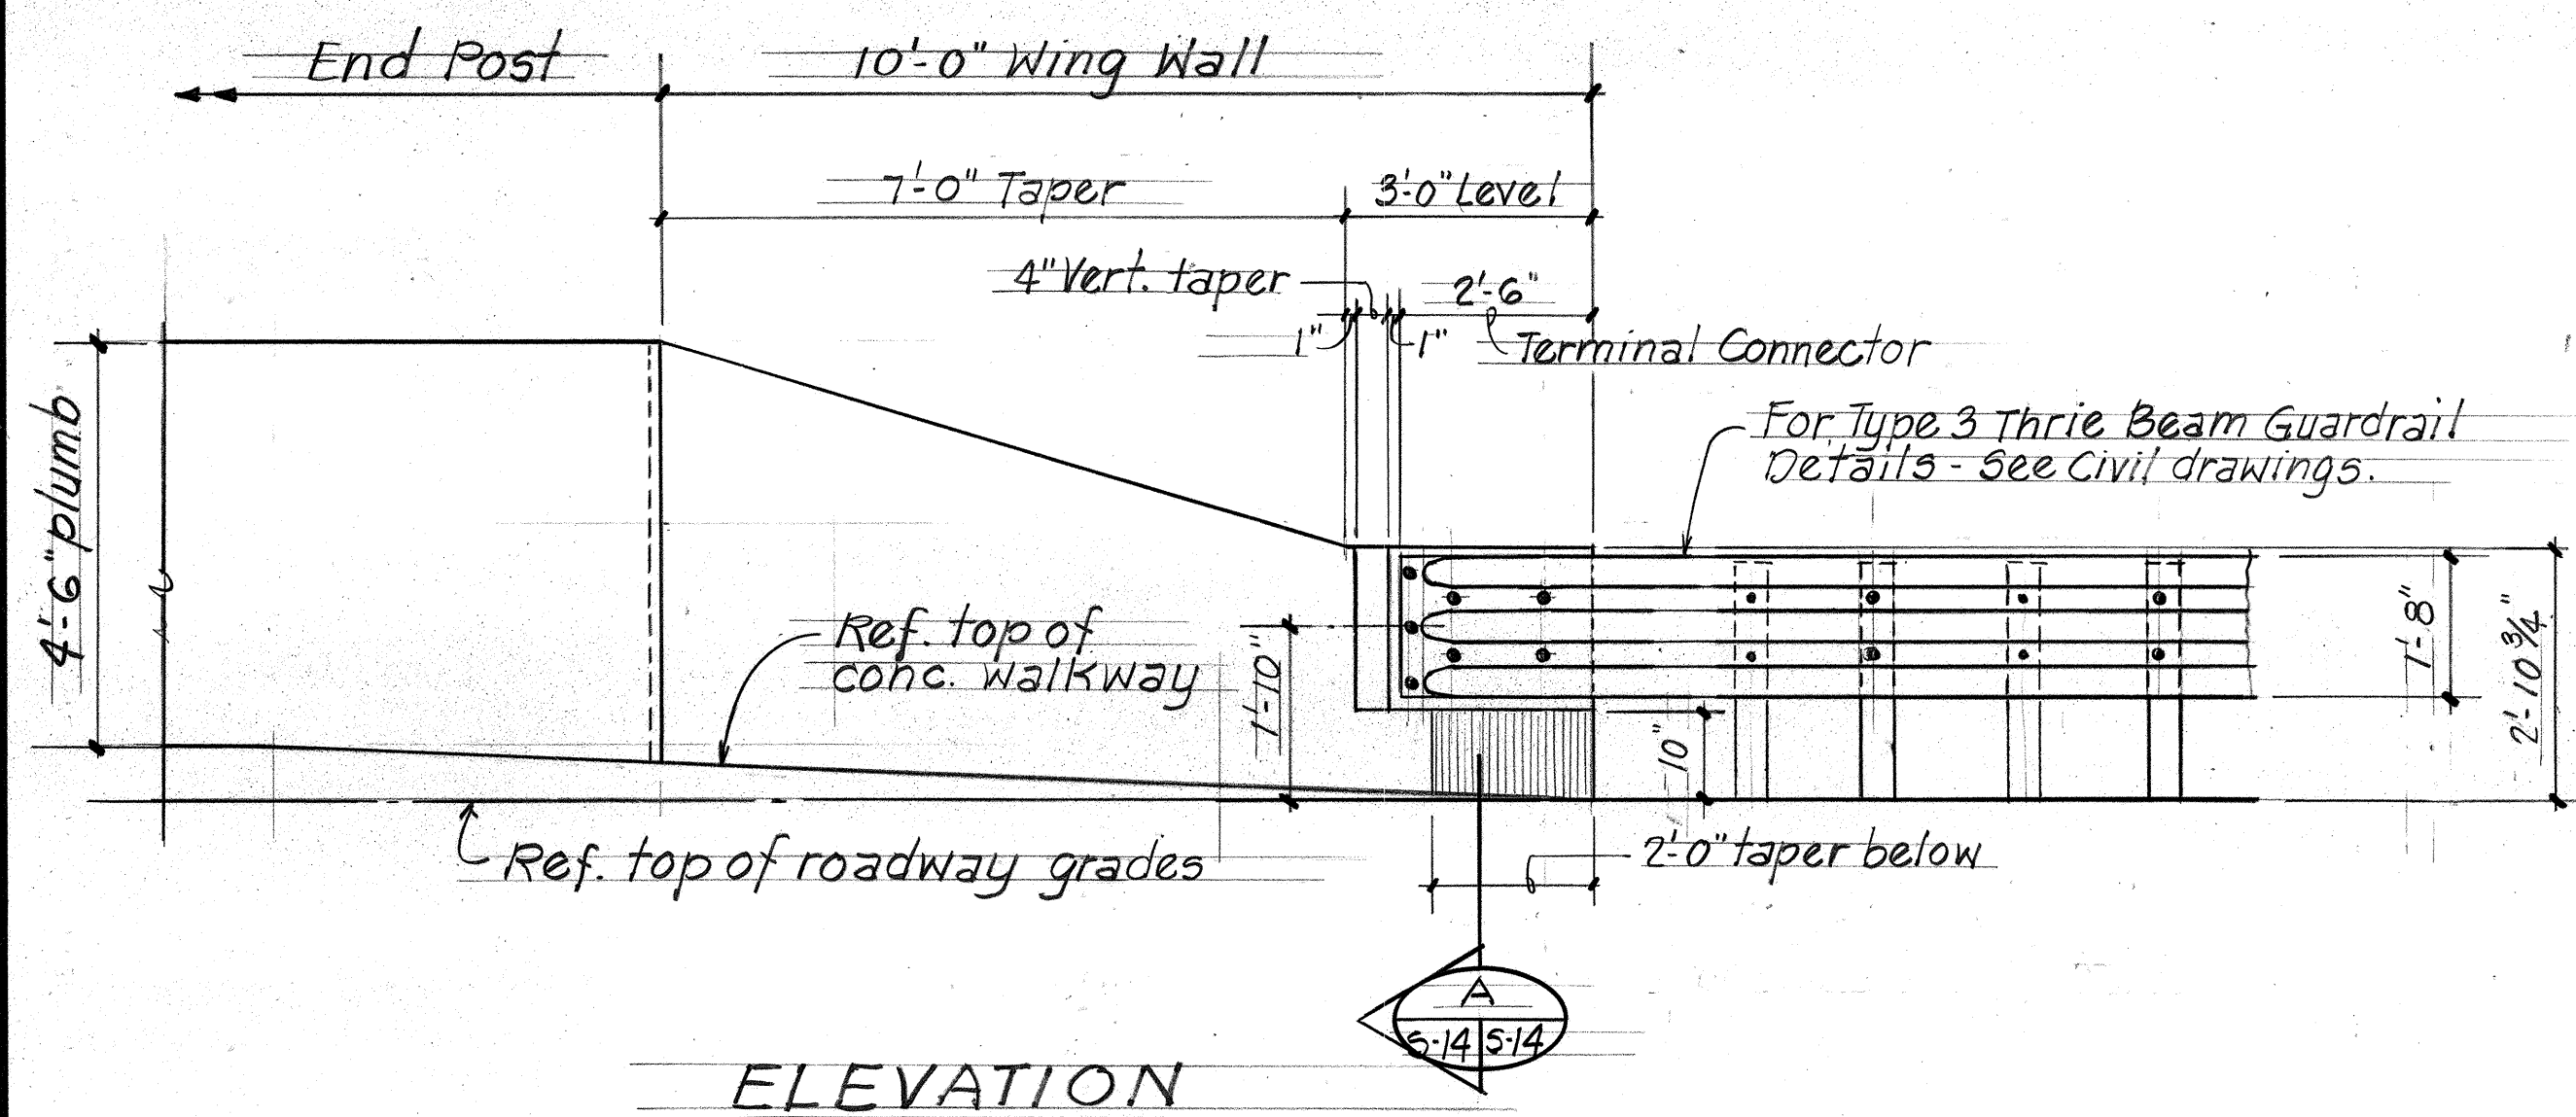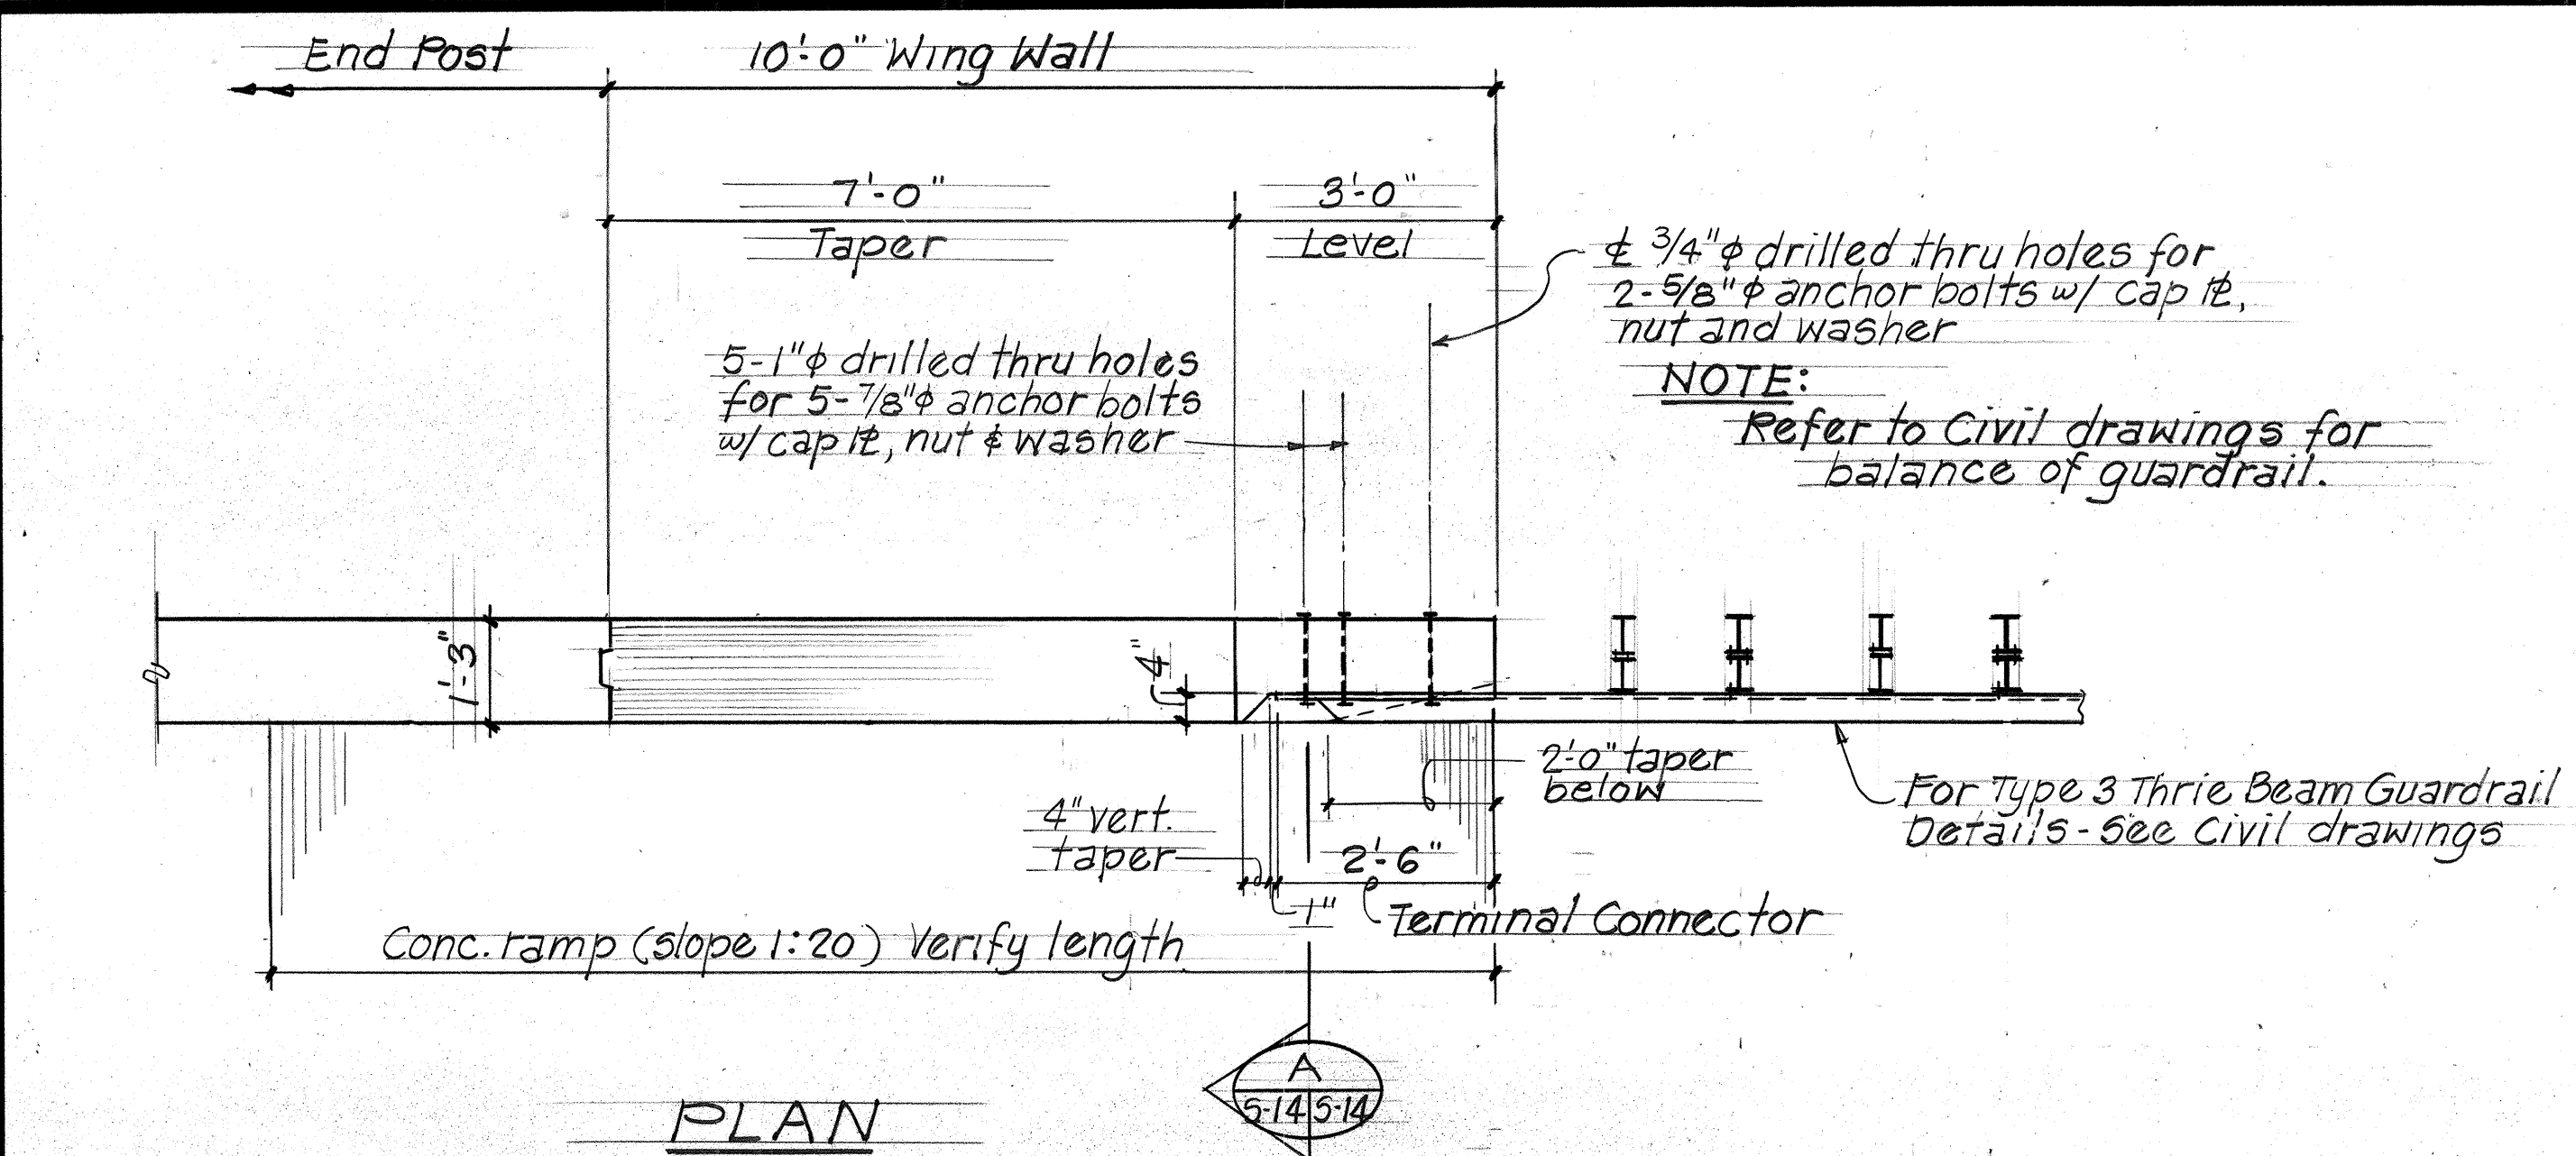

TYPICAL GUARDRAIL TO WING WALL CONNECTION DETAIL  
Scale:  $\frac{1}{2}" = 1'-0"$

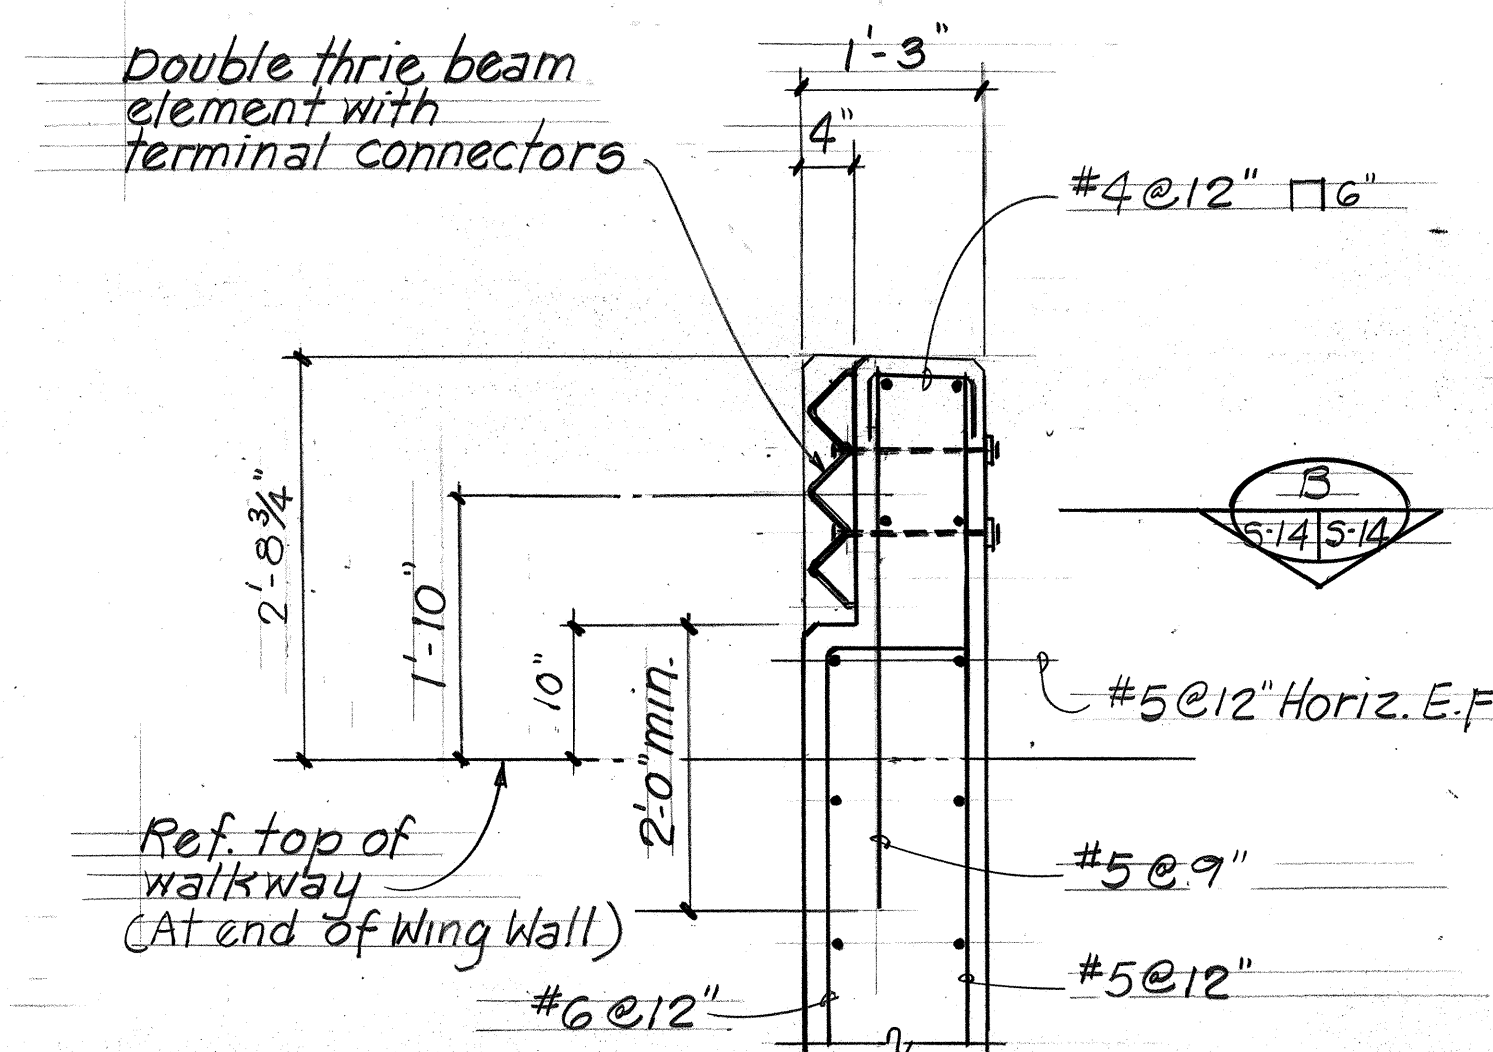


SECTION  
Scale:  $\frac{3}{4}" = 1'-0"$

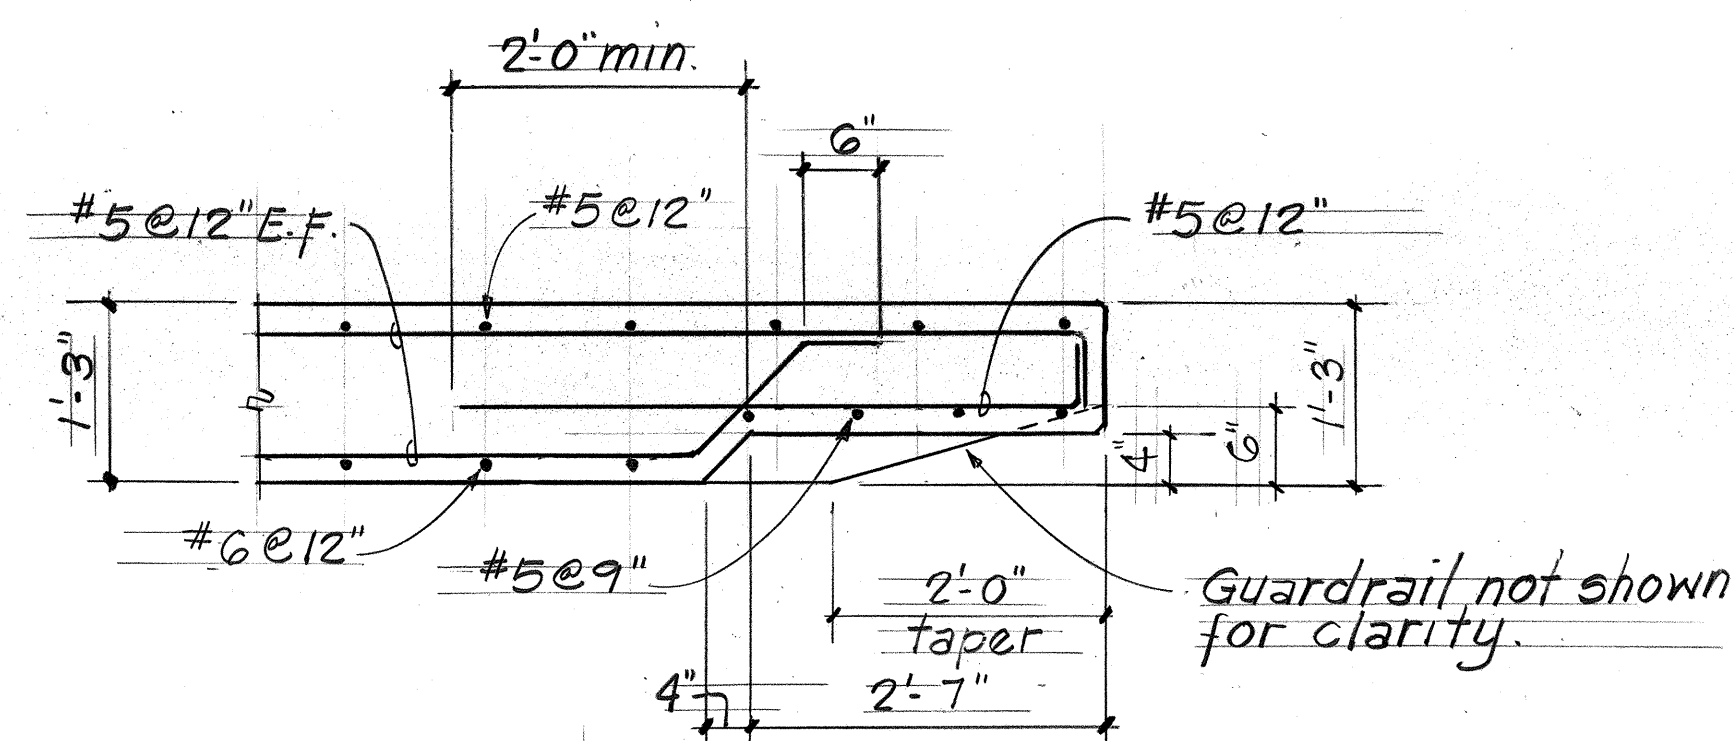

B SECTION  
5.14 | 5.14  
Scale:  $\frac{3}{4}" = 1'-0"$

ORIGINAL PLAN	SURVEY PLOTTED BY _____ DATE _____
NOTE BOOK	DRAWN BY _____ *
	TRACED BY _____ *
	DESIGNED BY _____ *
	QUANTITIES BY _____ *
No. _____	CHECKED BY _____

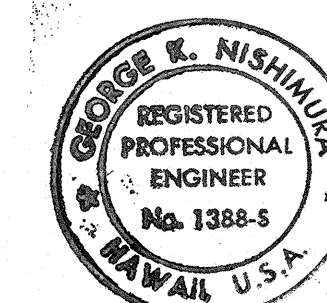

THIS WORK WAS PREPARED BY  
ME OR UNDER MY SUPERVISION.  
*L. K. [Signature]*

1/30/02	<i>Revise dimensions</i>
Date	<i>Revision</i>

STATE OF HAWAII  
**DEPARTMENT OF TRANSPORTATION**  
 HIGHWAYS DIVISION

**TYPICAL GUARDRAIL TO WING**  
**WALL CONNECTION DETAIL**

KAUIMUALAI HIGHWAY INTERSECTION  
 IMPROVEMENTS AT KOLOA ROAD


FEDERAL AID PROJ. NO. STP-050-1(17)

SCALE: AS NOTED                      DATE: OCT. 8, 1999


**SHEET NO. 5-14 OF 17 SHEETS**



FED. ROAD DIST. NO.	STATE	FED. AID PROJ. NO.	FISCAL YEAR	SHEET NO.	TOTAL SHEETS
HAWAII	HAW.	STP-050-1(17)	2000	58	72

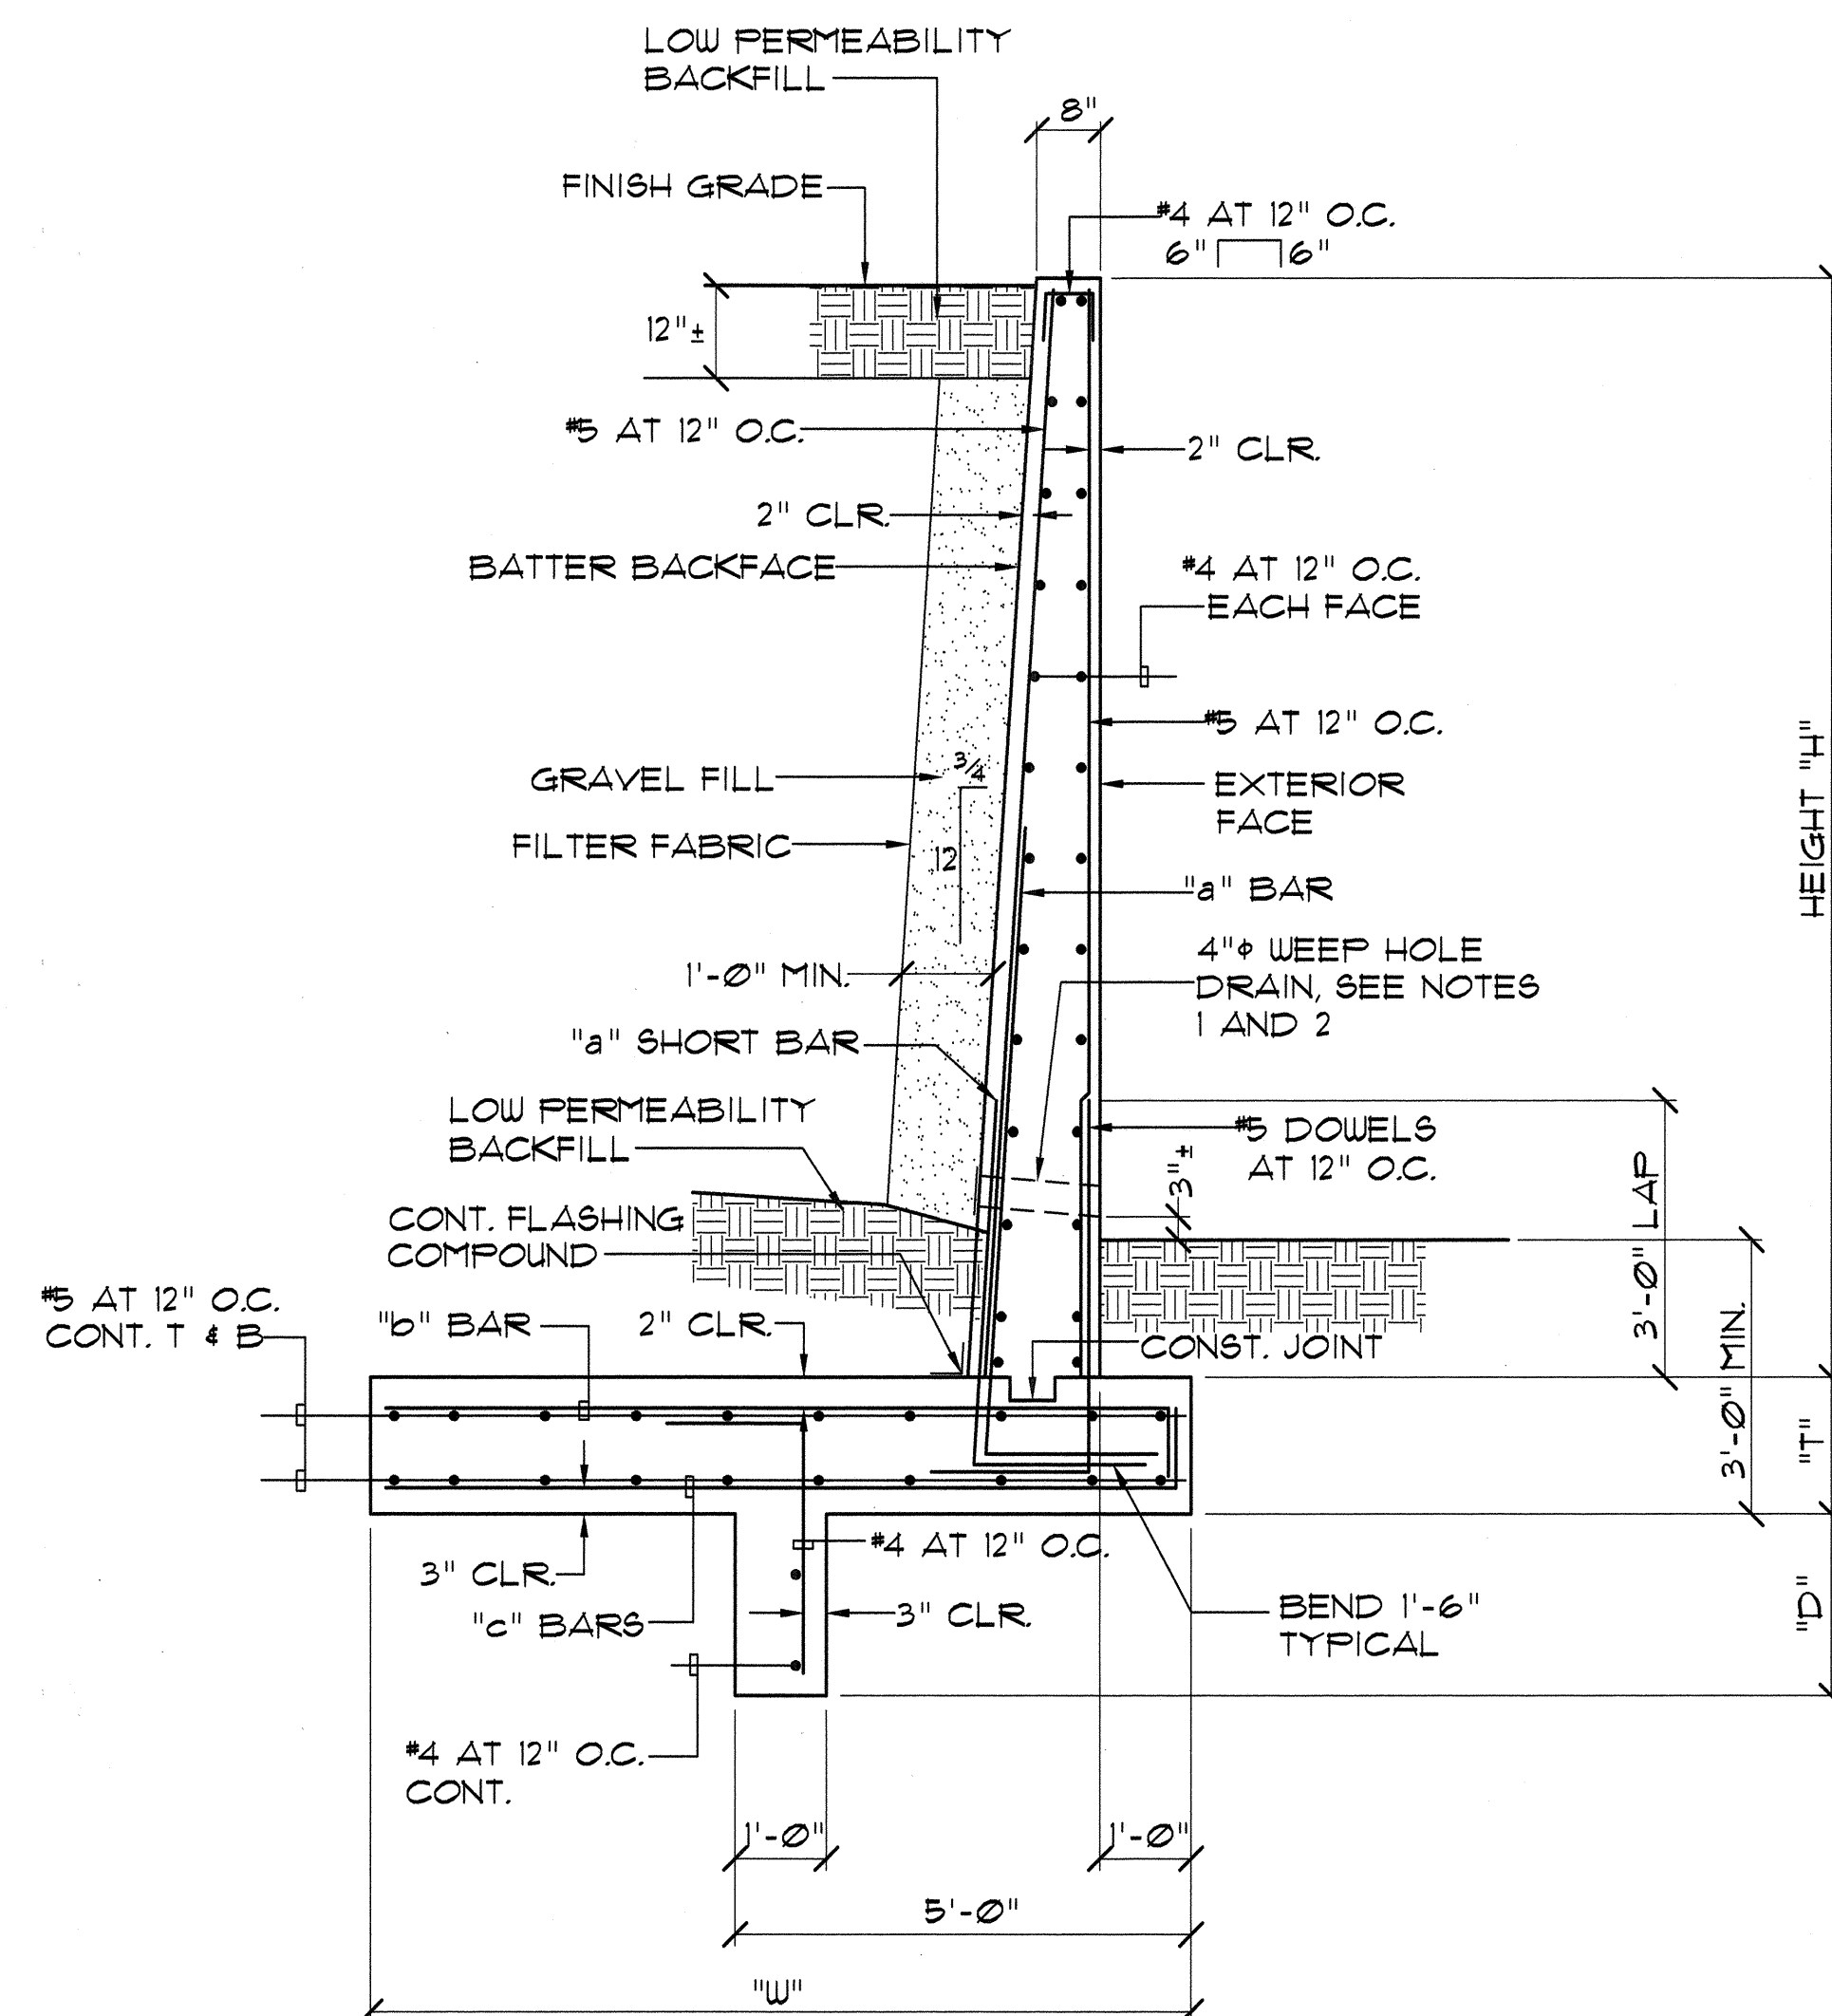

- NOTES:**
1. EXPOSED WALL DRAINS SHALL BE LOCATED 3"± ABOVE FINISH GRADE OR A.C. PAVEMENT.
  2. PROVIDE 6" SQUARE FILTER FABRIC ANCHORED FIRMLY TO BACKFACE OF WEEP HOLE DRAIN.
  3. ANY DAMAGES FOR ENCROACHMENT TO THE ABUTTING PROPERTY SHALL BE CORRECTED BY THE CONTRACTOR TO THE SATISFACTION OF THE ABUTTING OWNER.

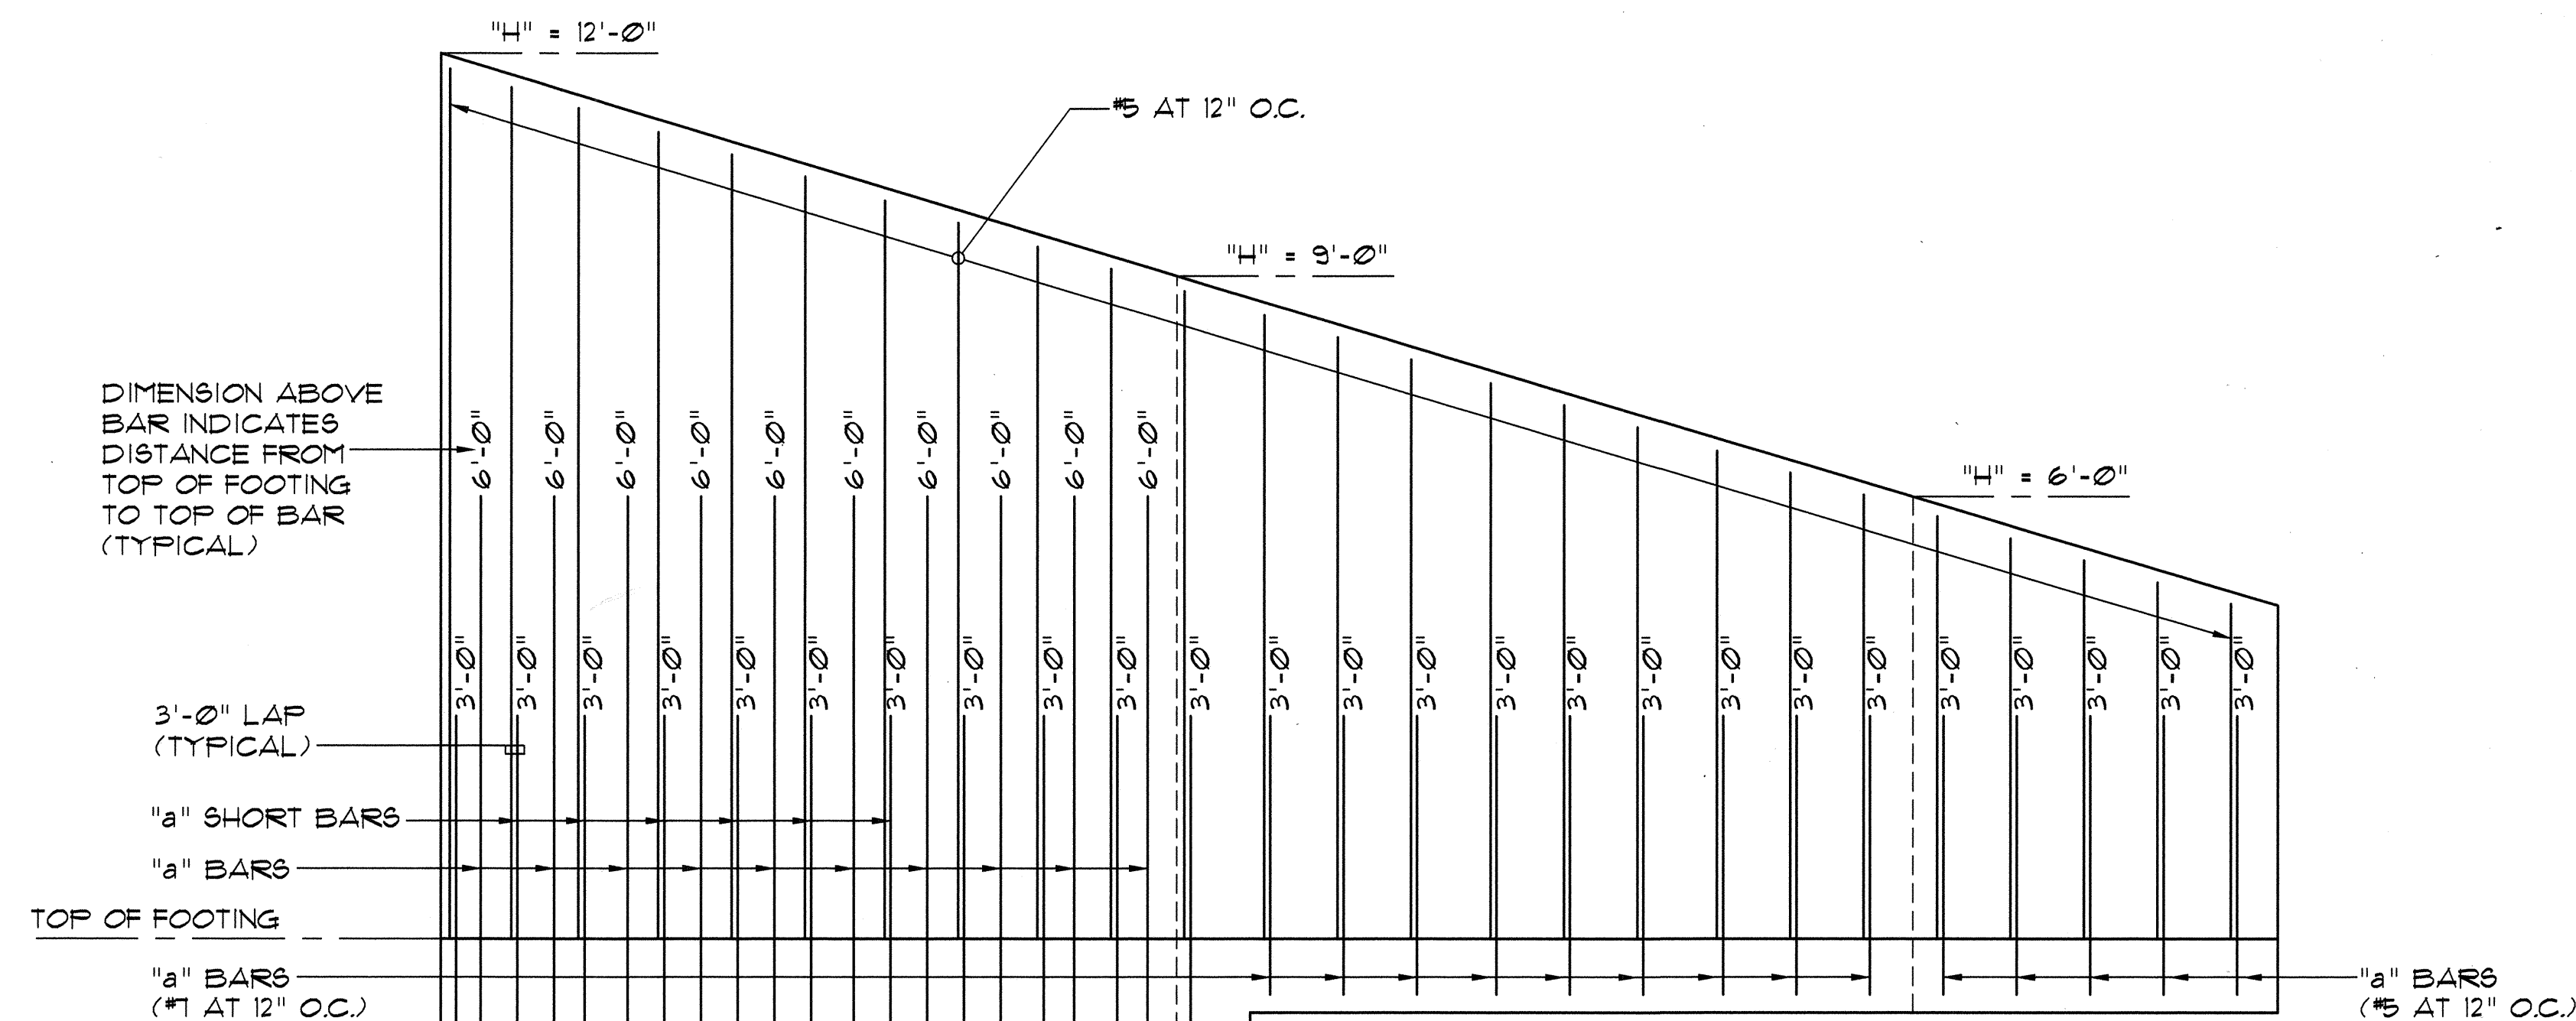


**TYPICAL RETAINING WALL NO. 2 ELEVATION**  
NOT TO SCALE

### RETAINING WALL NO. 2 TABLE

[illegible]

7/7/01	REVISE RETAINING WALL No.2 TABLE "b" BARS
DATE	REVISION

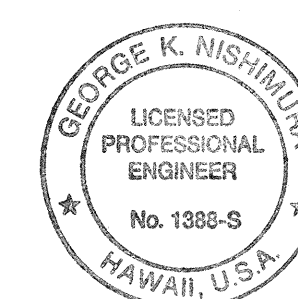

THIS WORK WAS PREPARED BY  
ME OR UNDER MY SUPERVISION  
*[Signature]*

STATE OF HAWAII  
DEPARTMENT OF TRANSPORTATION  
HIGHWAYS DIVISION

## RETAINING WALL DETAILS

KAUMUALII HIGHWAY INTERSECTION  
IMPROVEMENTS AT KOLOA ROAD  
FEDERAL-AID PROJECT NO. STP-050-1(17)

SCALE: AS NOTED                      DATE: OCT. 8, 1999

**SHEET No. 8-16 OF 17 SHEETS**

ORIGINAL PLAN	SURVEY PLOTTED BY _____ DATE _____
NOTE BOOK	DRAWN BY _____
	DESIGNED BY _____
	QUANTITIES BY _____
	CHECKED BY _____
No. _____	

