




FED. ROAD DIST NO.	STATE	FED. AID PROJ. NO.	FISCAL YEAR	SHEET NO.	TOTAL SHEETS
HAWAII	HAW.	STP-050-1(17)	2000	12	72

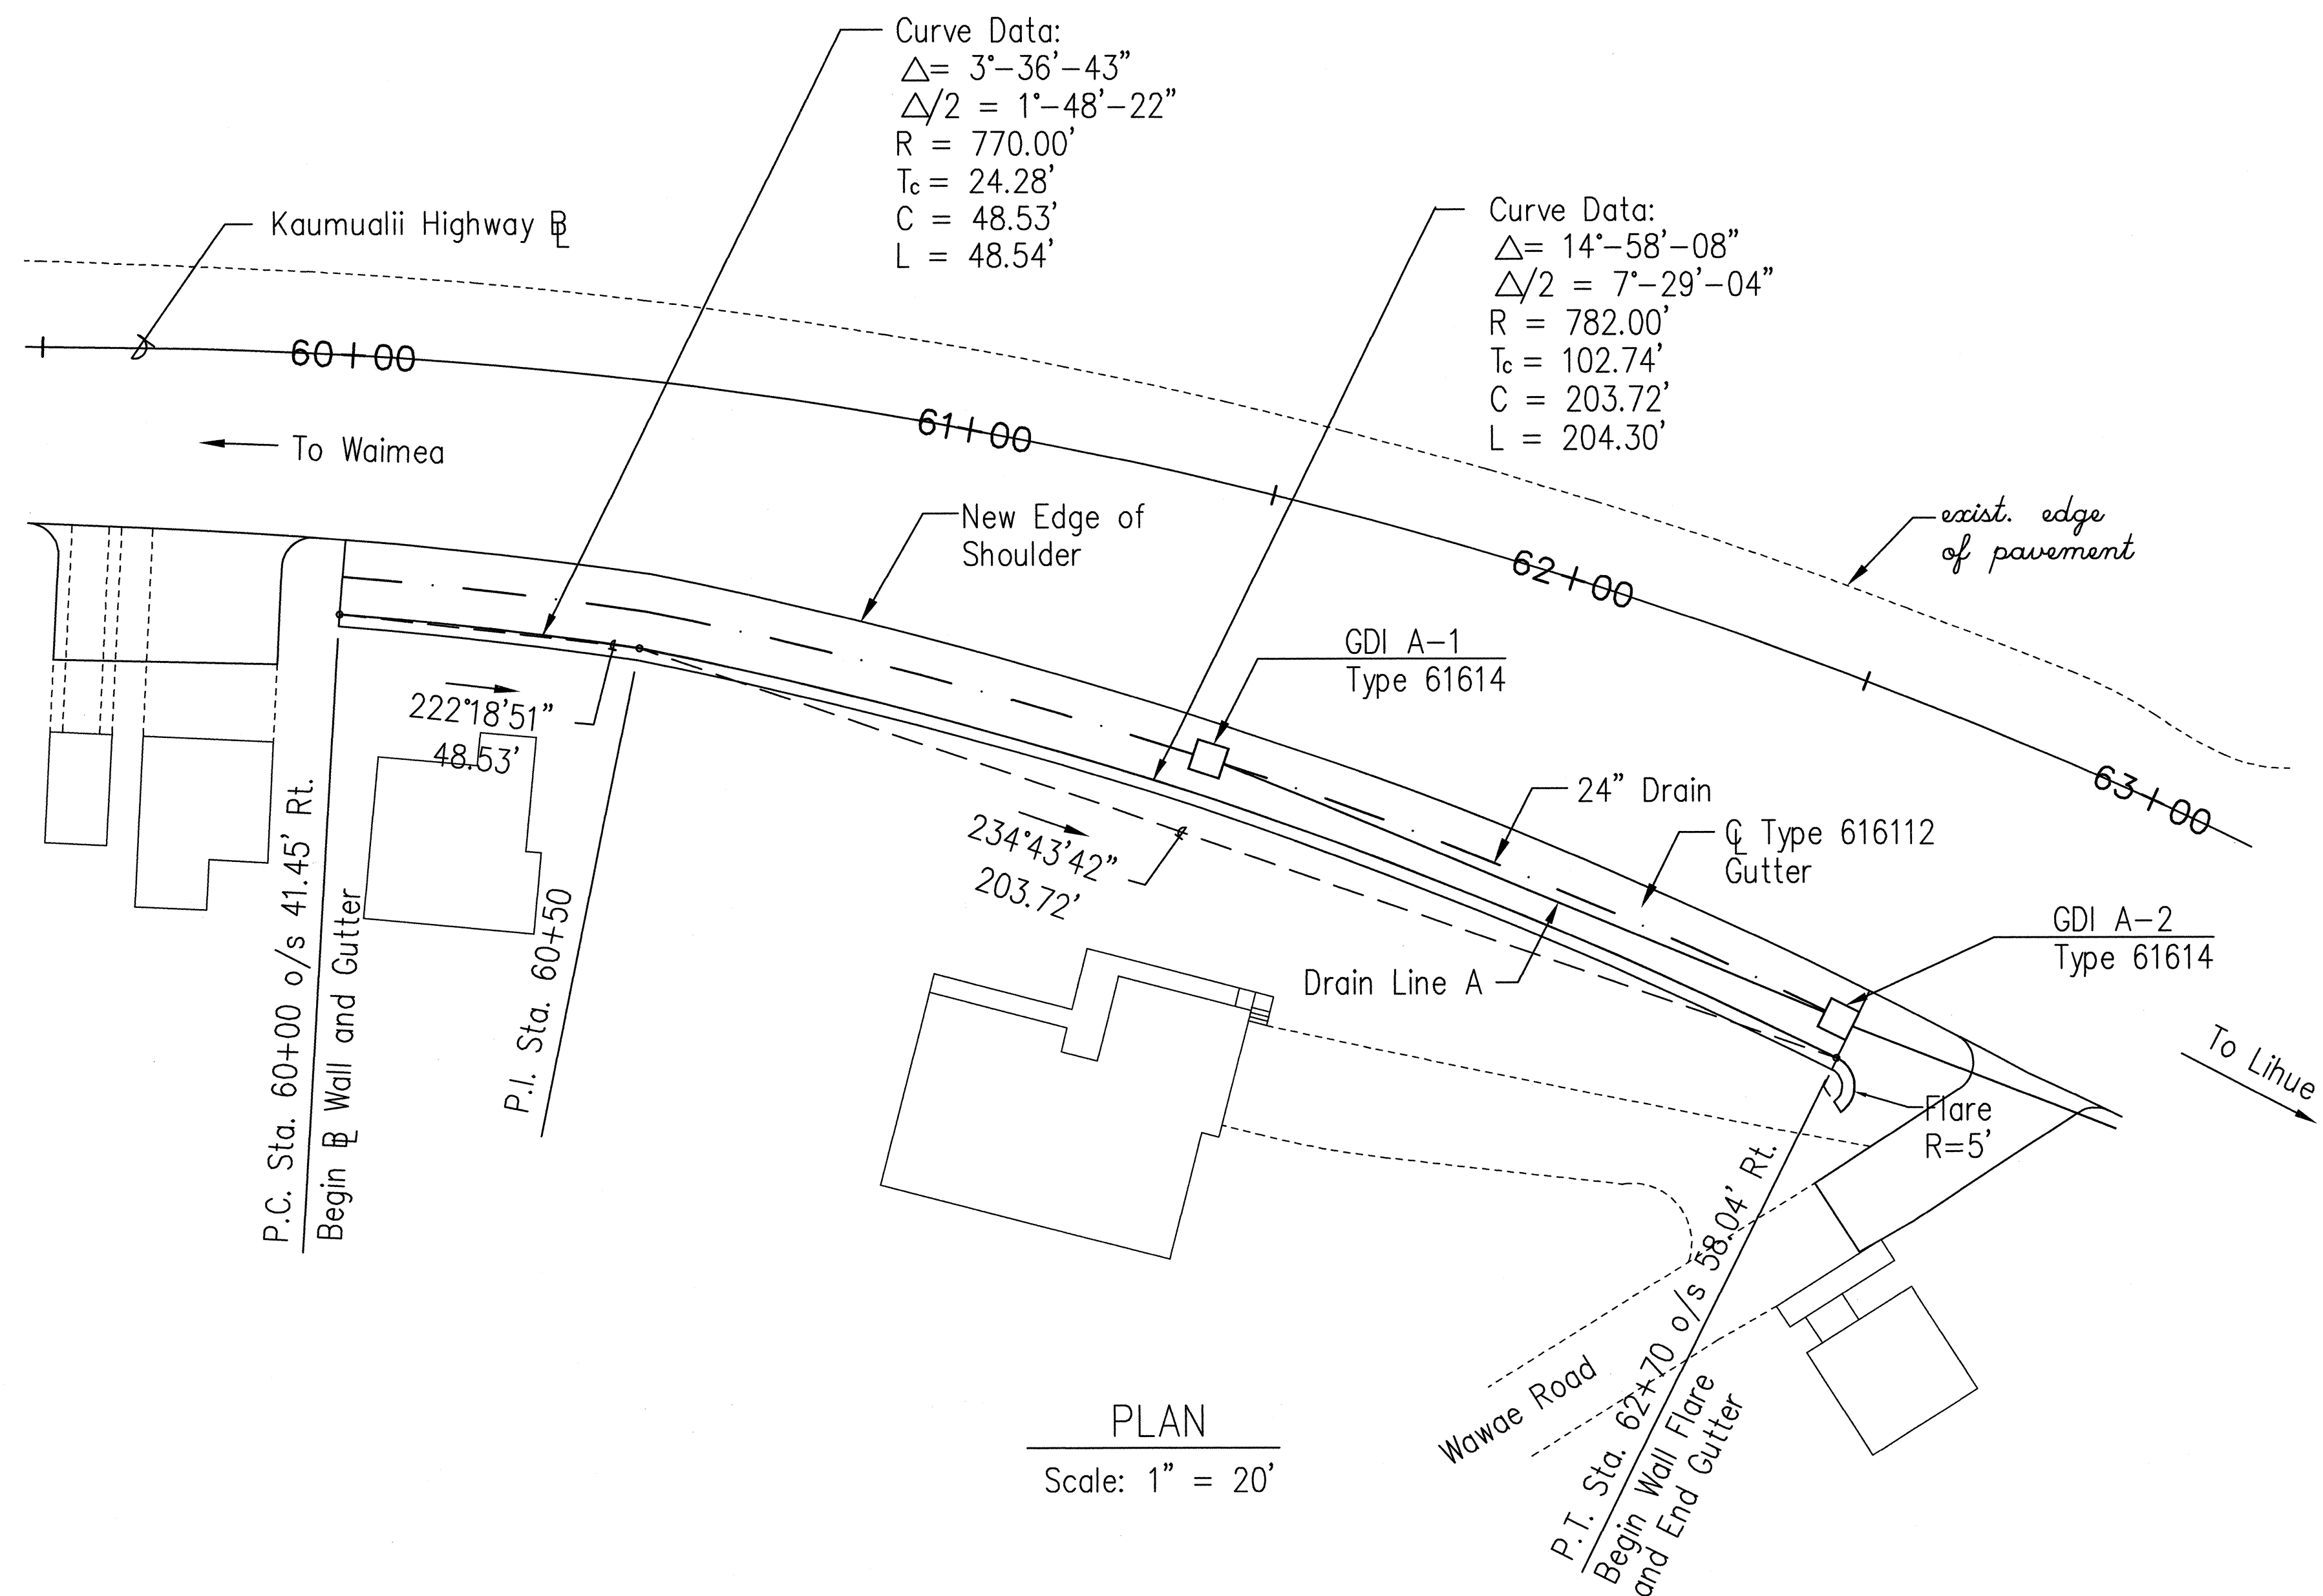

PLAN
Scale: 1" = 20'

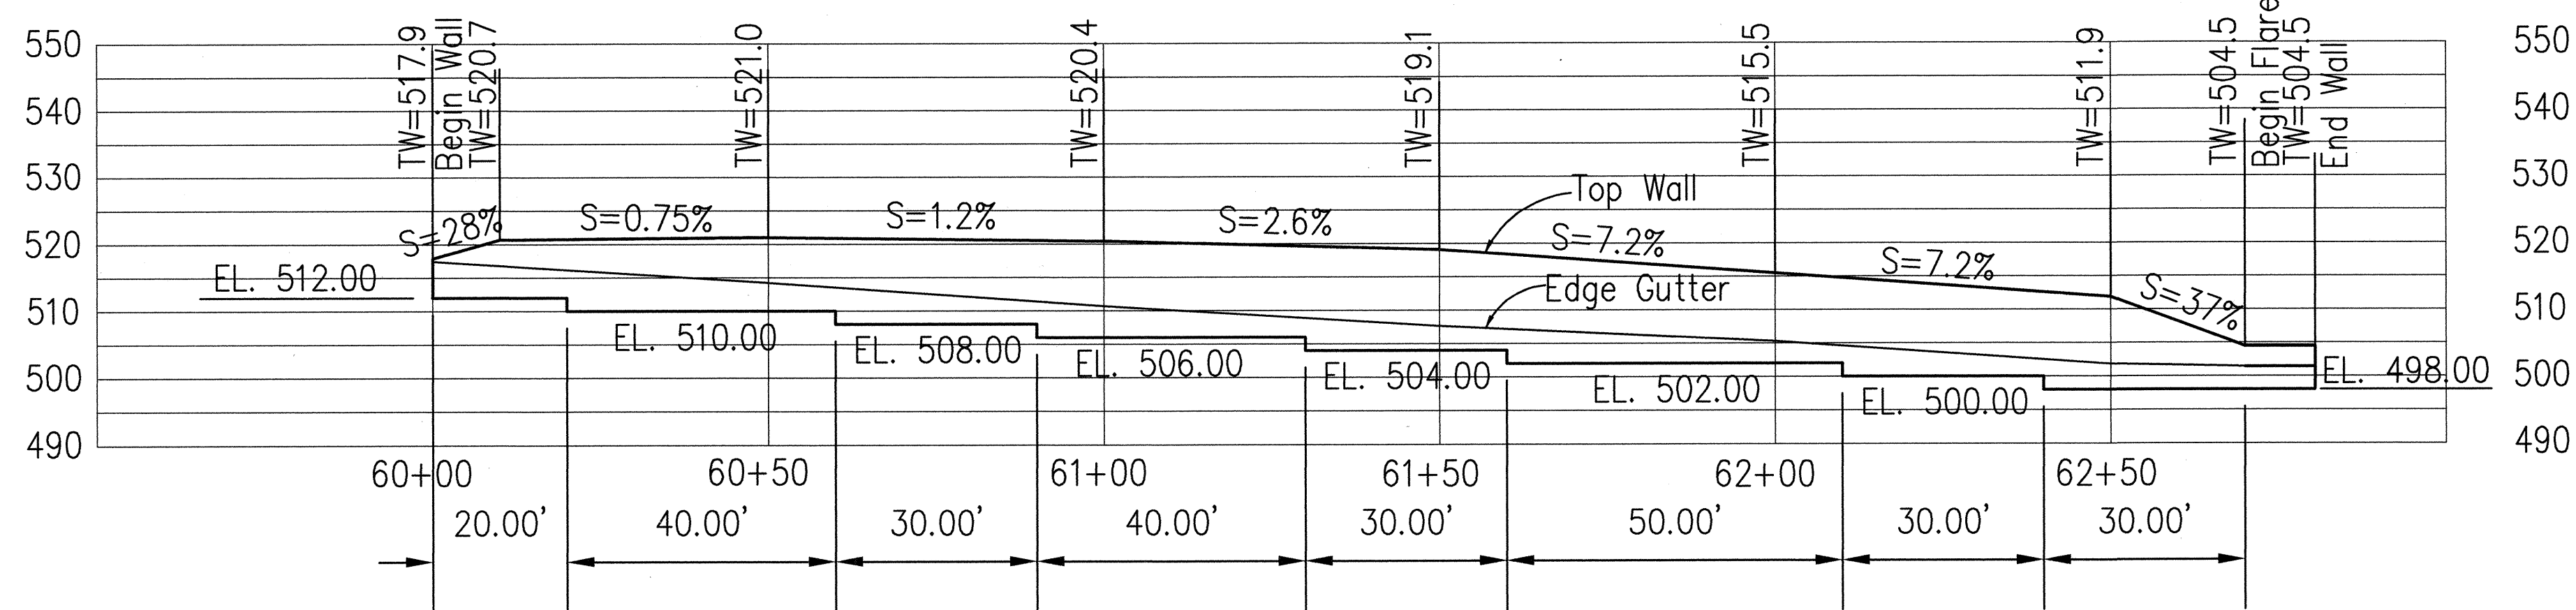

ELEVATION
RETAINING WALL NO. 1
 SCALE: 1" = 20'
 A
 C-6 C-10

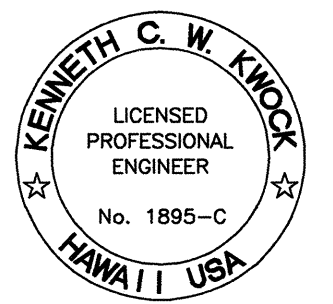

THIS WORK WAS PREPARED BY ME OR UNDER MY SUPERVISION

Kenneth C. W. Knox

9/25/01	ADD RETAINING WALL NO.1 STEP FOOTING ELEVATIONS
DATE	REVISION
STATE OF HAWAII DEPARTMENT OF TRANSPORTATION HIGHWAYS DIVISION RETAINING WALL NO. 1 KAUMUALII HIGHWAY INTERSECTION IMPROVEMENTS AT KOLOA ROAD FED. AID PROJ. No. STP-050-1(17) DATE: 10/8/99	
SHEET No. C-10 OF 38 SHEETS	