
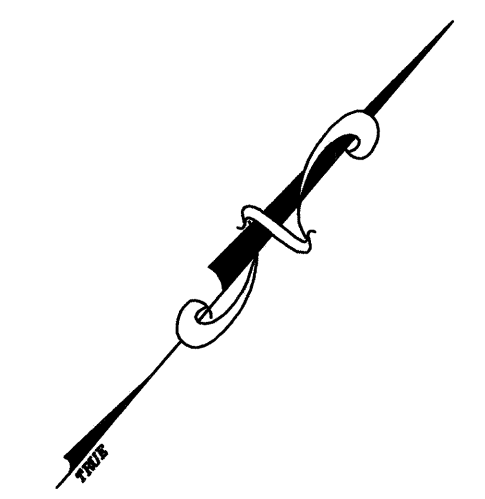


FED. ROAD DIST. NO.	STATE	FED. AID PROJ. NO.	FISCAL YEAR	SHEET NO.	TOTAL SHEETS
HAWAII	HAW.	STP-050-1(17)	2000	18	72


HIGHWAY


KAUMUALII

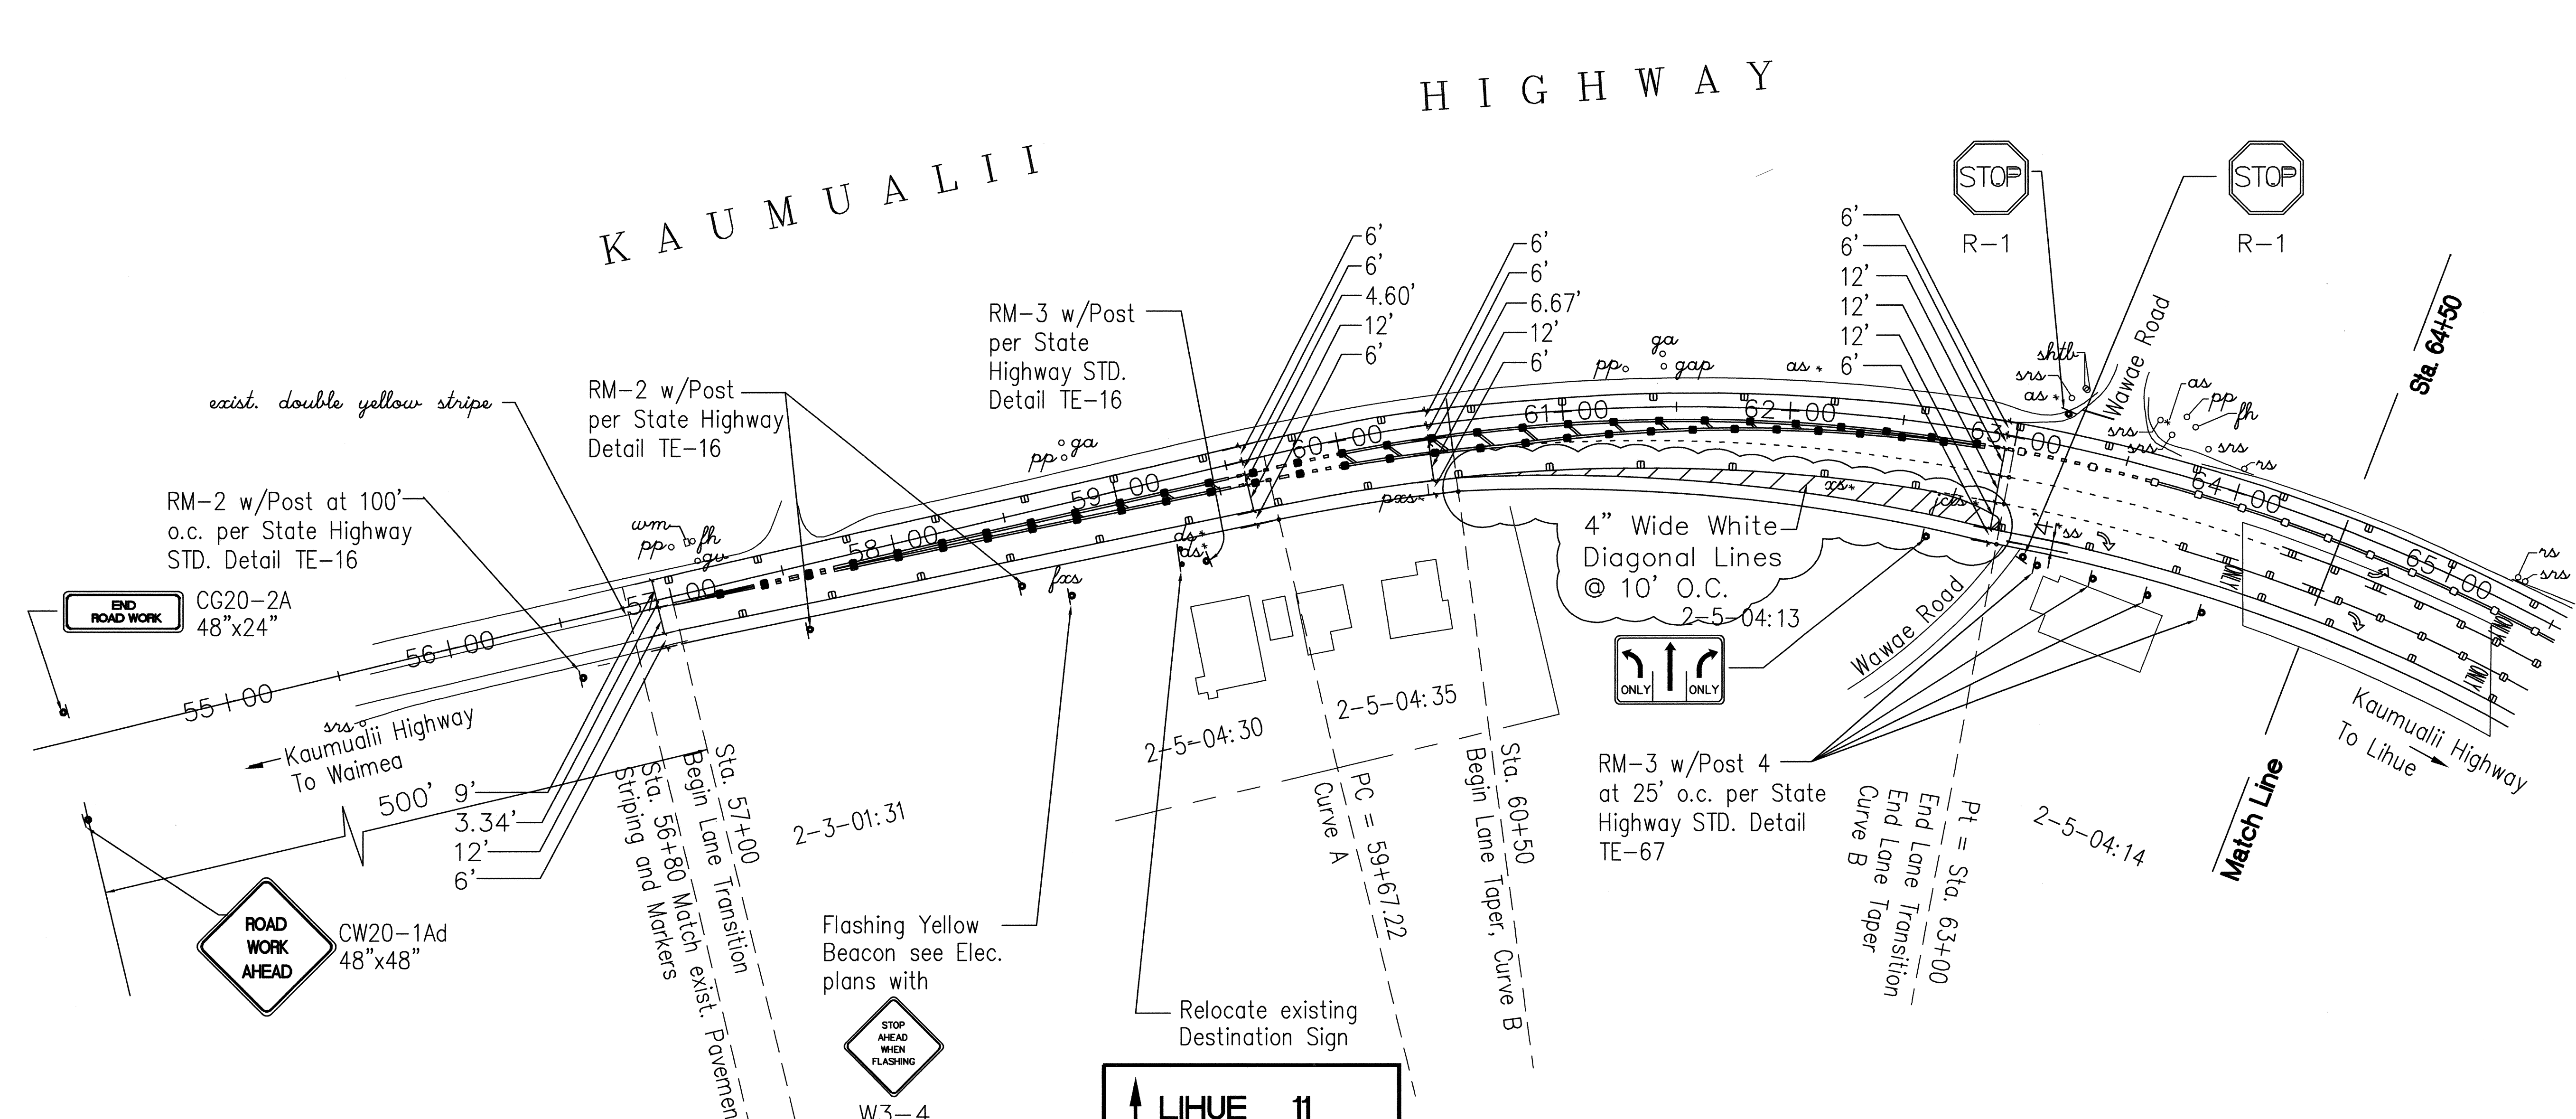

LEGEND:

- as arrow sign
- ds direction sign
- fh fire hydrant
- fas flashing x-ing sign
- ga guy anchor
- gap guy anchor pole
- gv gate valve
- jcts junction sign
- ms mile sign
- pas pedestrian x-ing sign
- pp power pole
- rs reflector
- shth small hawaiian telephone
- srs small reflector
- ss stop sign
- xx x-ing sign
- wm water meter

Flashing Yellow Beacon see Elec. plans with

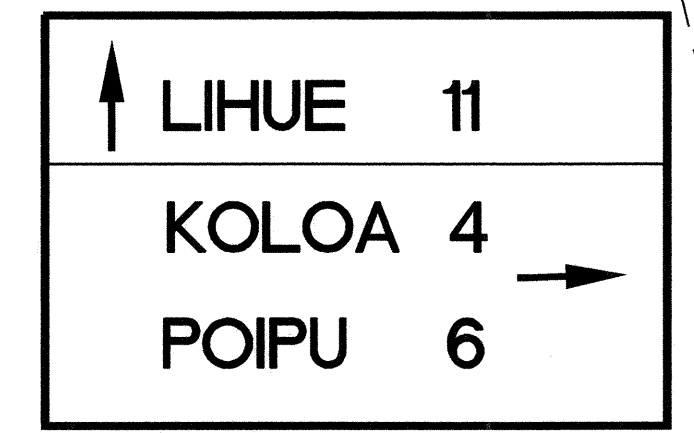 W3-4



Install New Posts Per State Highway STD. Det. TE-24.

SIGNING AND STRIPING PLAN


SCALE: 1" = 40'



THIS WORK WAS PREPARED BY ME OR UNDER MY SUPERVISION
Kenneth C. W. Knock

4/29/03	REVISED STRIPING AT WAWAE ROAD
DATE	REVISION
STATE OF HAWAII DEPARTMENT OF TRANSPORTATION HIGHWAYS DIVISION	
SIGNING AND STRIPING PLAN	
KAUMUALII HIGHWAY INTERSECTION IMPROVEMENTS AT KOLOA ROAD	
FED. AID PROJ. No. STP-050-1(17) DATE: 10/8/99	
SHEET No. C-11 OF 38 SHEETS	

FED. ROAD DIST. NO.	STATE	FED. AID PROJ. NO.	FISCAL YEAR	SHEET NO.	TOTAL SHEETS
HAWAII	HAW.	STP-050-1(17)	2000	14	72

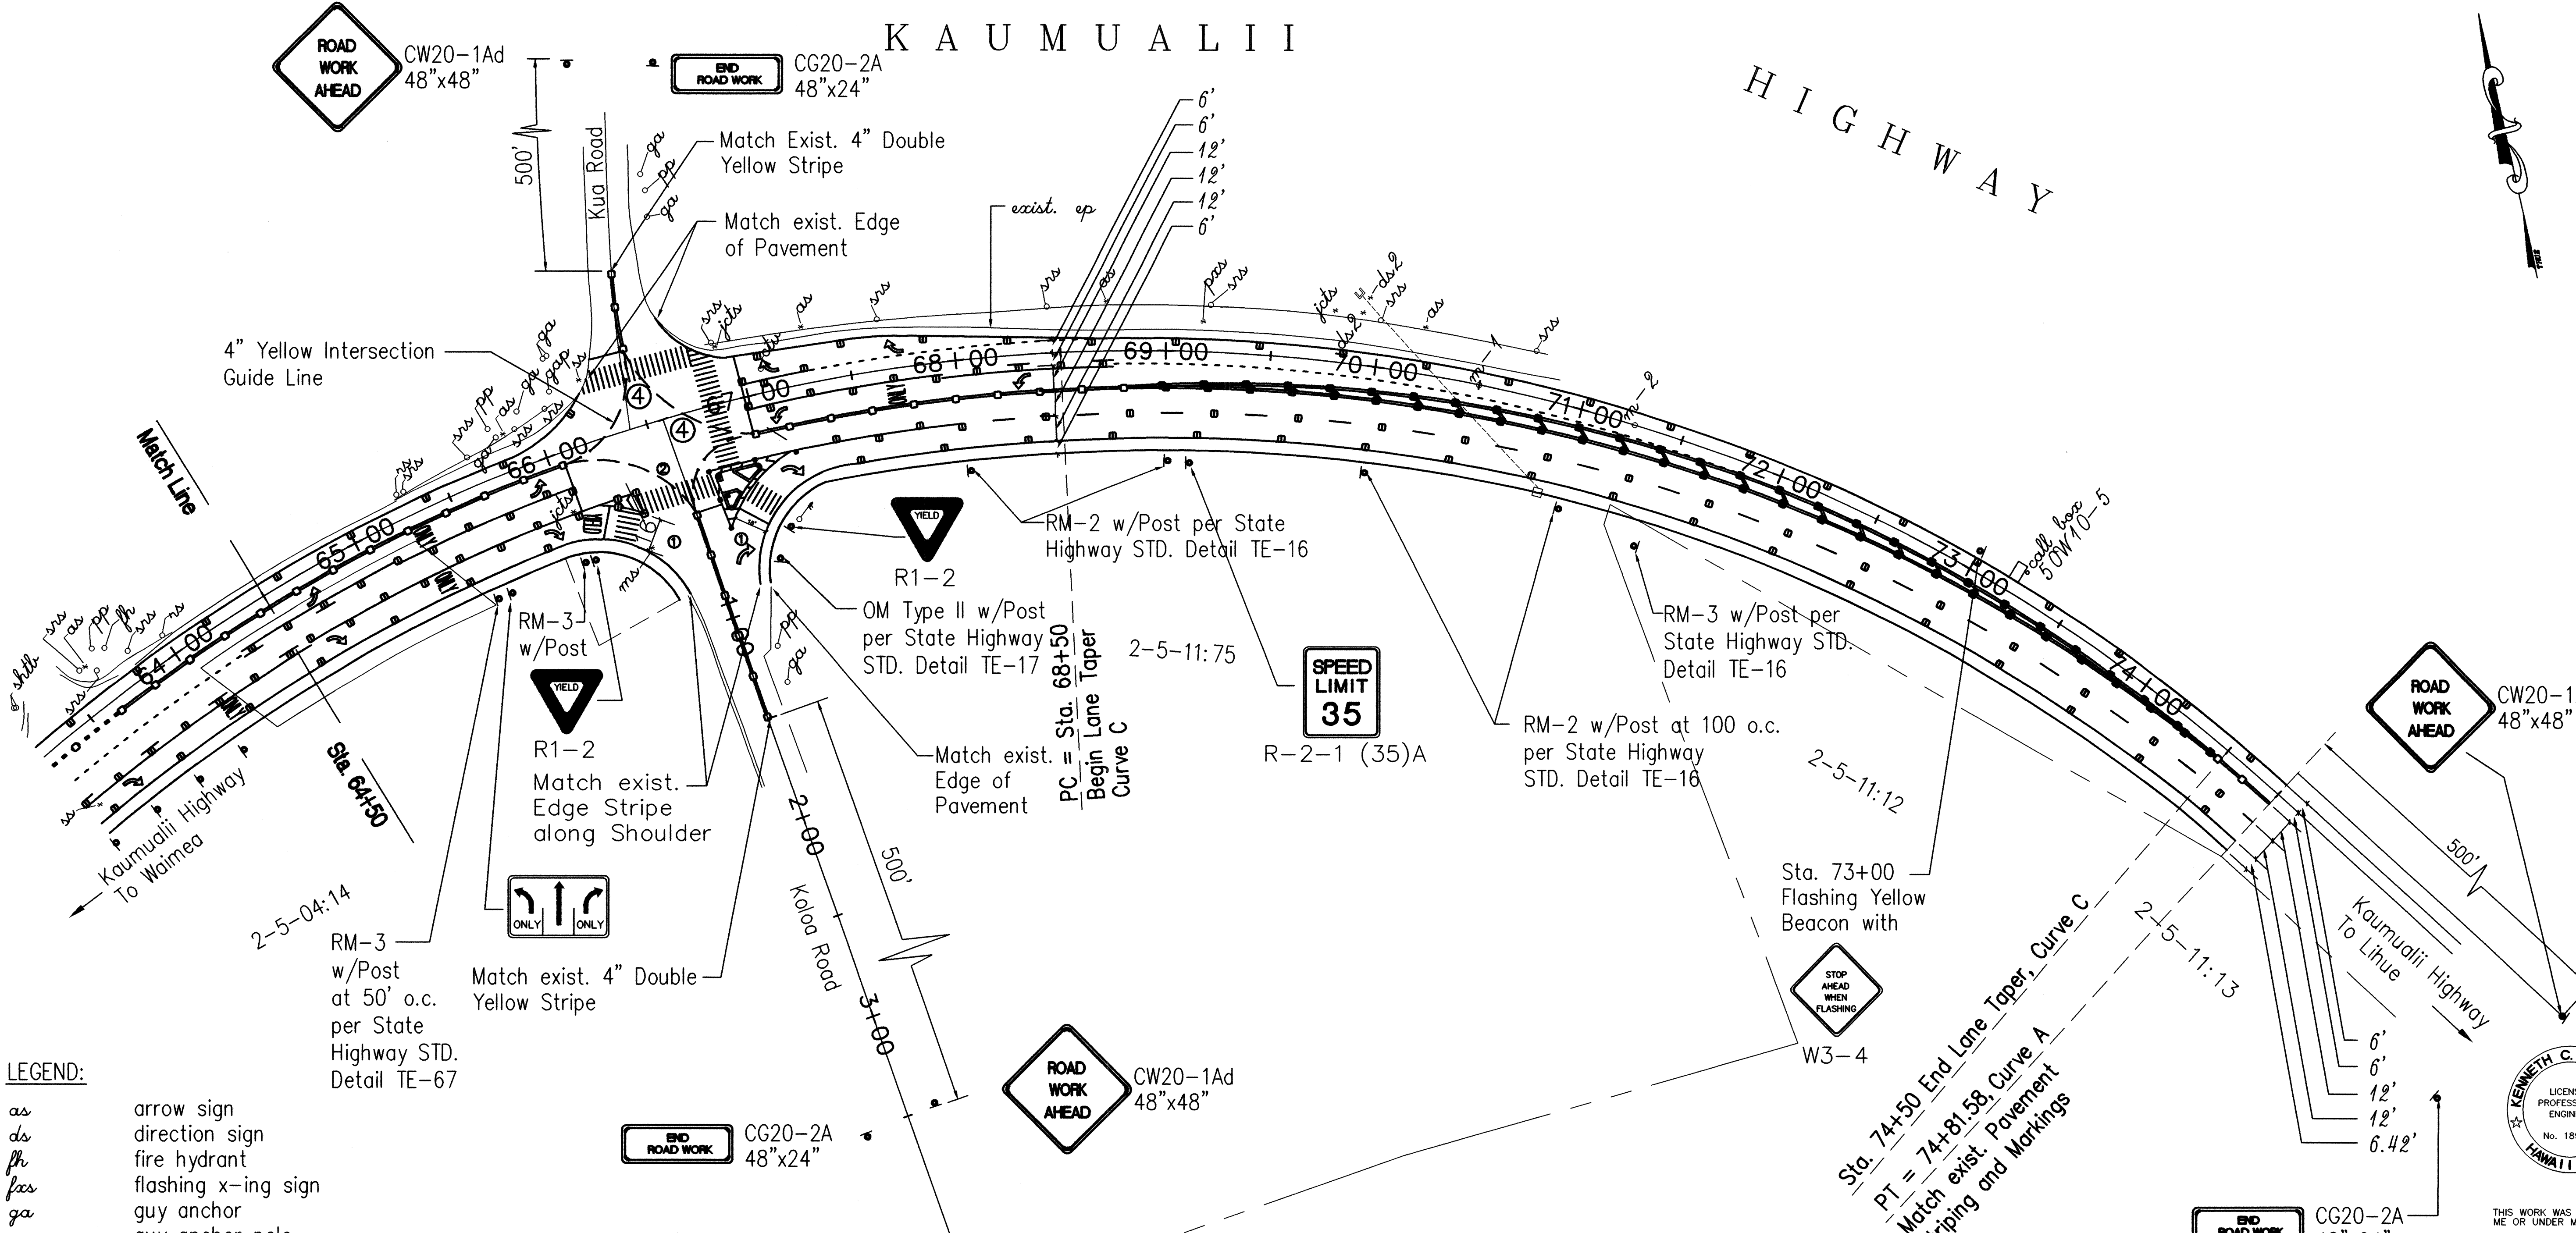

- LEGEND:**
- as arrow sign
 - ds direction sign
 - fh fire hydrant
 - fas flashing x-ing sign
 - ga guy anchor
 - gap guy anchor pole
 - gv gate valve
 - jts junction sign
 - ms mile sign
 - pas pedestrian x-ing sign
 - pp power pole
 - rs reflector
 - shll small hawaii telephone
 - srs small reflector
 - ss stop sign
 - xs x-ing sign
 - wm water meter


SIGNING AND STRIPING PLAN
SCALE: 1" = 40'

APPROVED:

[Signature] COUNTY ENGINEER
 DEPARTMENT OF PUBLIC WORKS
 COUNTY OF KAUAI (For work within County R/W)

4/28/00
DATE

7/01/03	REVISE TRAFFIC ISLAND
DATE	REVISION
STATE OF HAWAII DEPARTMENT OF TRANSPORTATION HIGHWAYS DIVISION	
SIGNING AND STRIPING PLAN	
KAUMUALII HIGHWAY INTERSECTION IMPROVEMENTS AT KOLOA ROAD	
FED. AID PROJ. No. STP-050-1(17) DATE: 10/8/99	
SHEET No. C-12 OF 38 SHEETS	

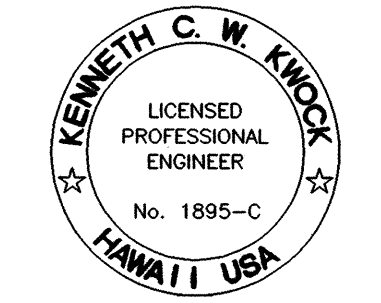

THIS WORK WAS PREPARED BY ME OR UNDER MY SUPERVISION
[Signature]