INDEX TO DRAWINGS	
SHEET NO.	DESCRIPTION
1	TITLE SHEET
2	STANDARD PLANS SUMMARY
3	GENERAL NOTES AND LEGEND
4–5	WATER POLLUTION AND EROSION CONTROL NOTES
6	TYPICAL SECTIONS
7	ROADWAY PLANS
8–9	DRAINAGE PLAN
10–12	DRAINAGE DETAILS
13	FLEAT-350 FLARED ENERGY ABSORBING TERMINAL
14	STRONG POST W-BEAM GUARDRAIL
15	GUARDRAIL DETAILS & NOTES
16	GUARDRAIL DETAILS

ugust, 2001 DATE

S d

ni & Associa DESIGNED

SCALE IN THOUSAND FEET

STATE OF HAWAII


DEPARTMENT OF TRANSPORTATION

HIGHWAYS DIVISION


HONOLULU, HAWAII

"AS-BUILT"

PLANS FOR

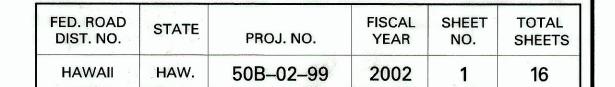



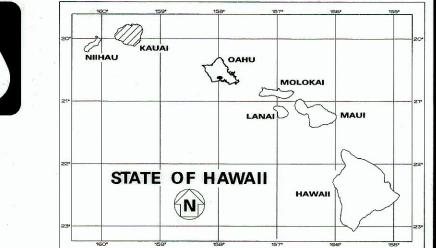

KAUMUALII HIGHWAY DRAINAGE IMPROVEMENTS


VICINITY OF M.P. 22.0


PROJECT NO. 50B-02-99

DISTRICT OF WAIMEA ISLAND OF KAUAI

GROSS LENGTH OF PROJECT.....0.2 MILES

NET LENGTH OF PROJECT.....0.2 MILES

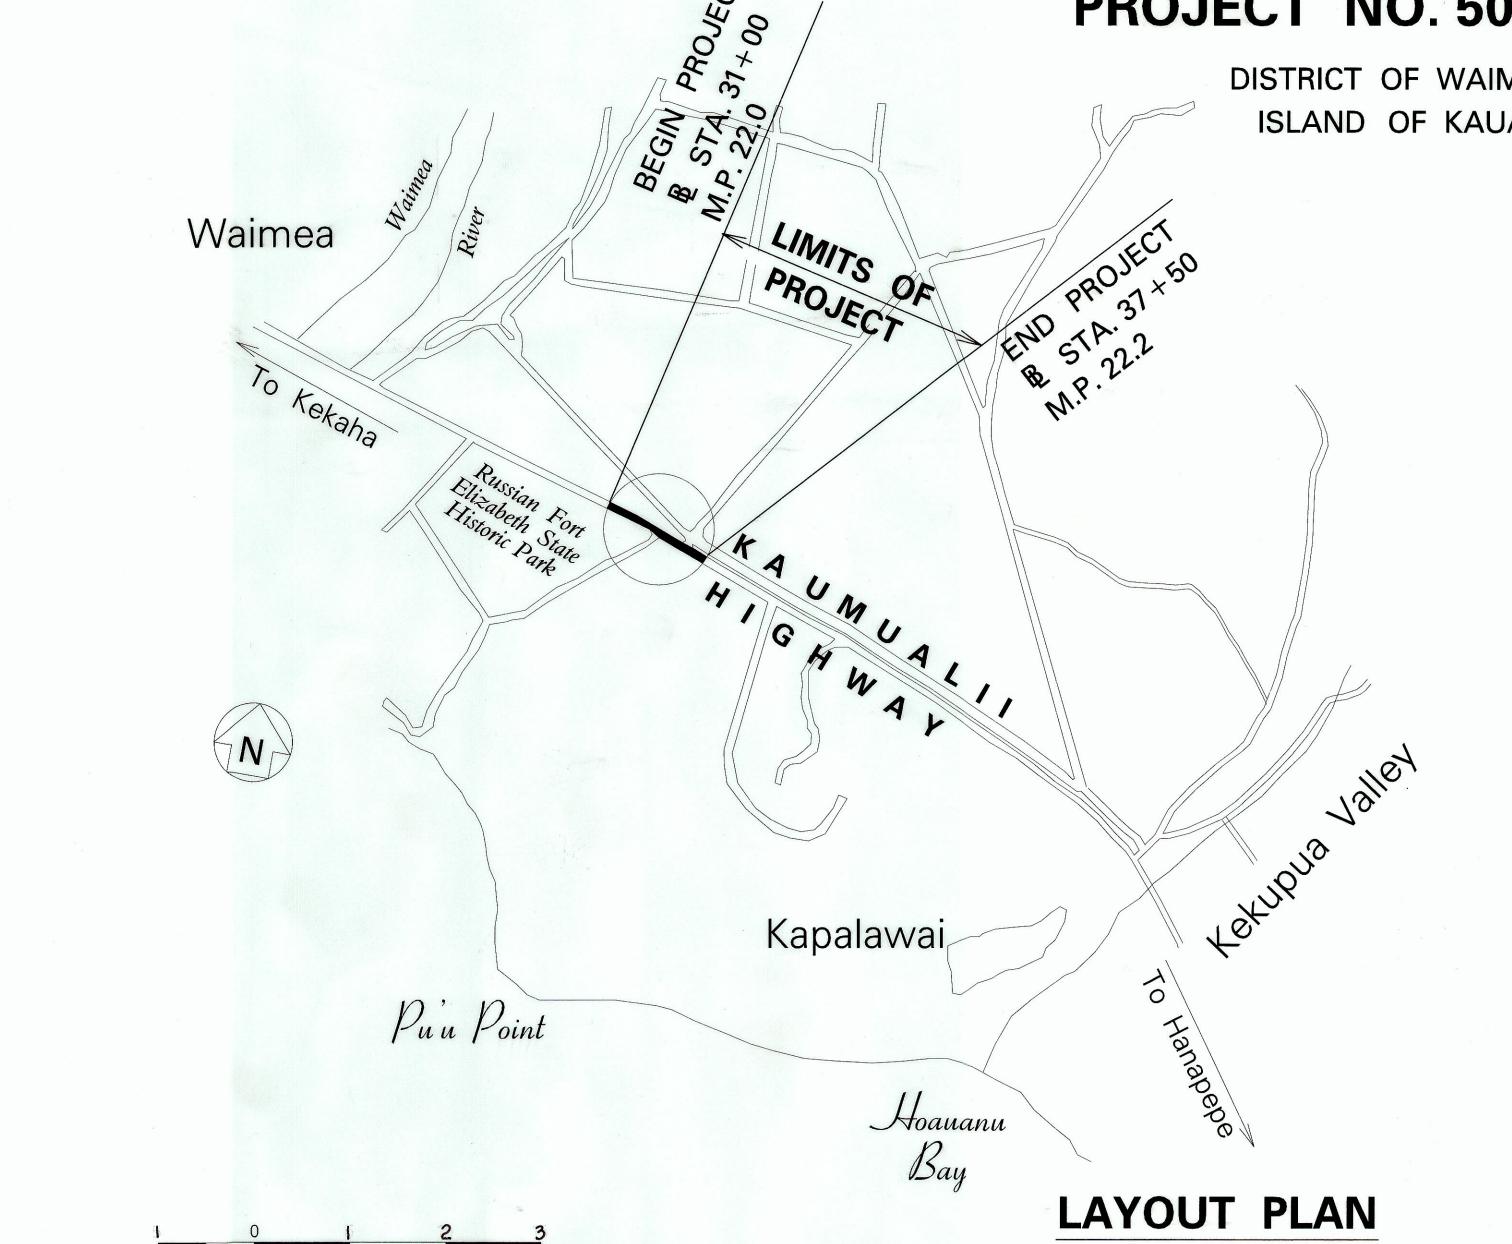

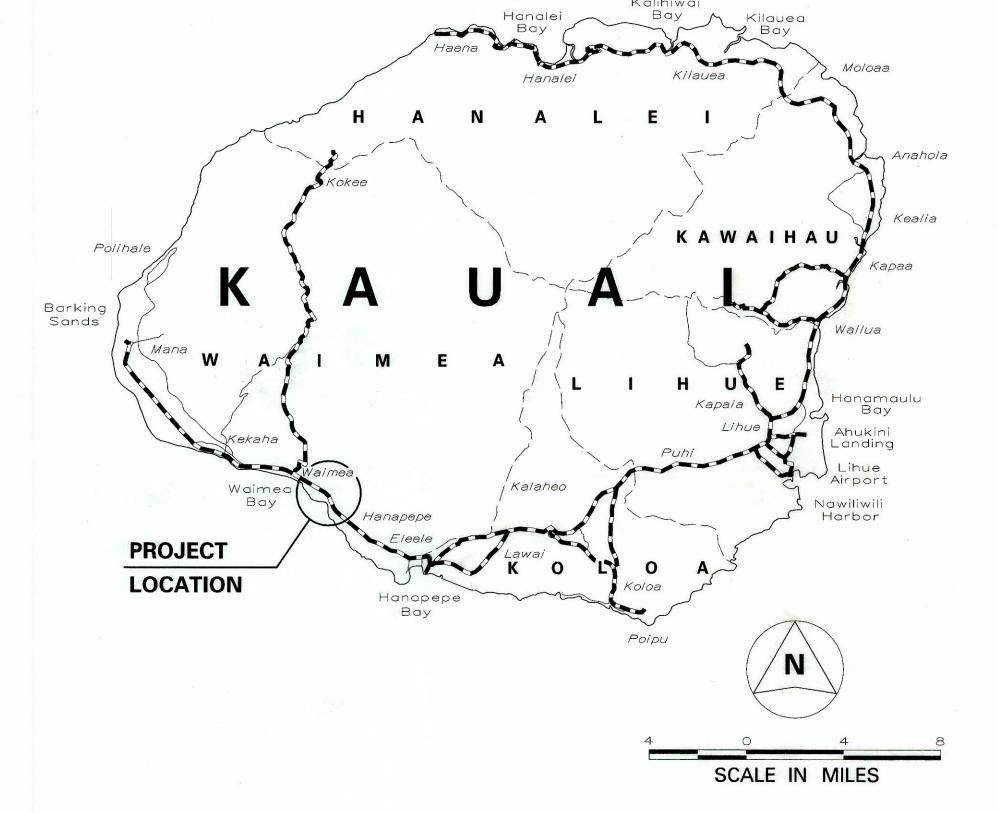

FEDERAL AID PROJECTS PREVIOUSLY CONSTRUCTED OR UNDER CONSTRUCTION

MILE POST 22.0 TO MILE POST 22.2



DEPARTMENT OF TRANSPORTATION STATE OF HAWAII APPROVED:

KONDIR. OF TRANSPORTATION

4-18-02 DATE