




FED. ROAD DIST. NO.	STATE	PROJ. NO.	FISCAL YEAR	SHEET NO.	TOTAL SHEETS
HAWAII	HAW.	50B-02-99	2002	6	16

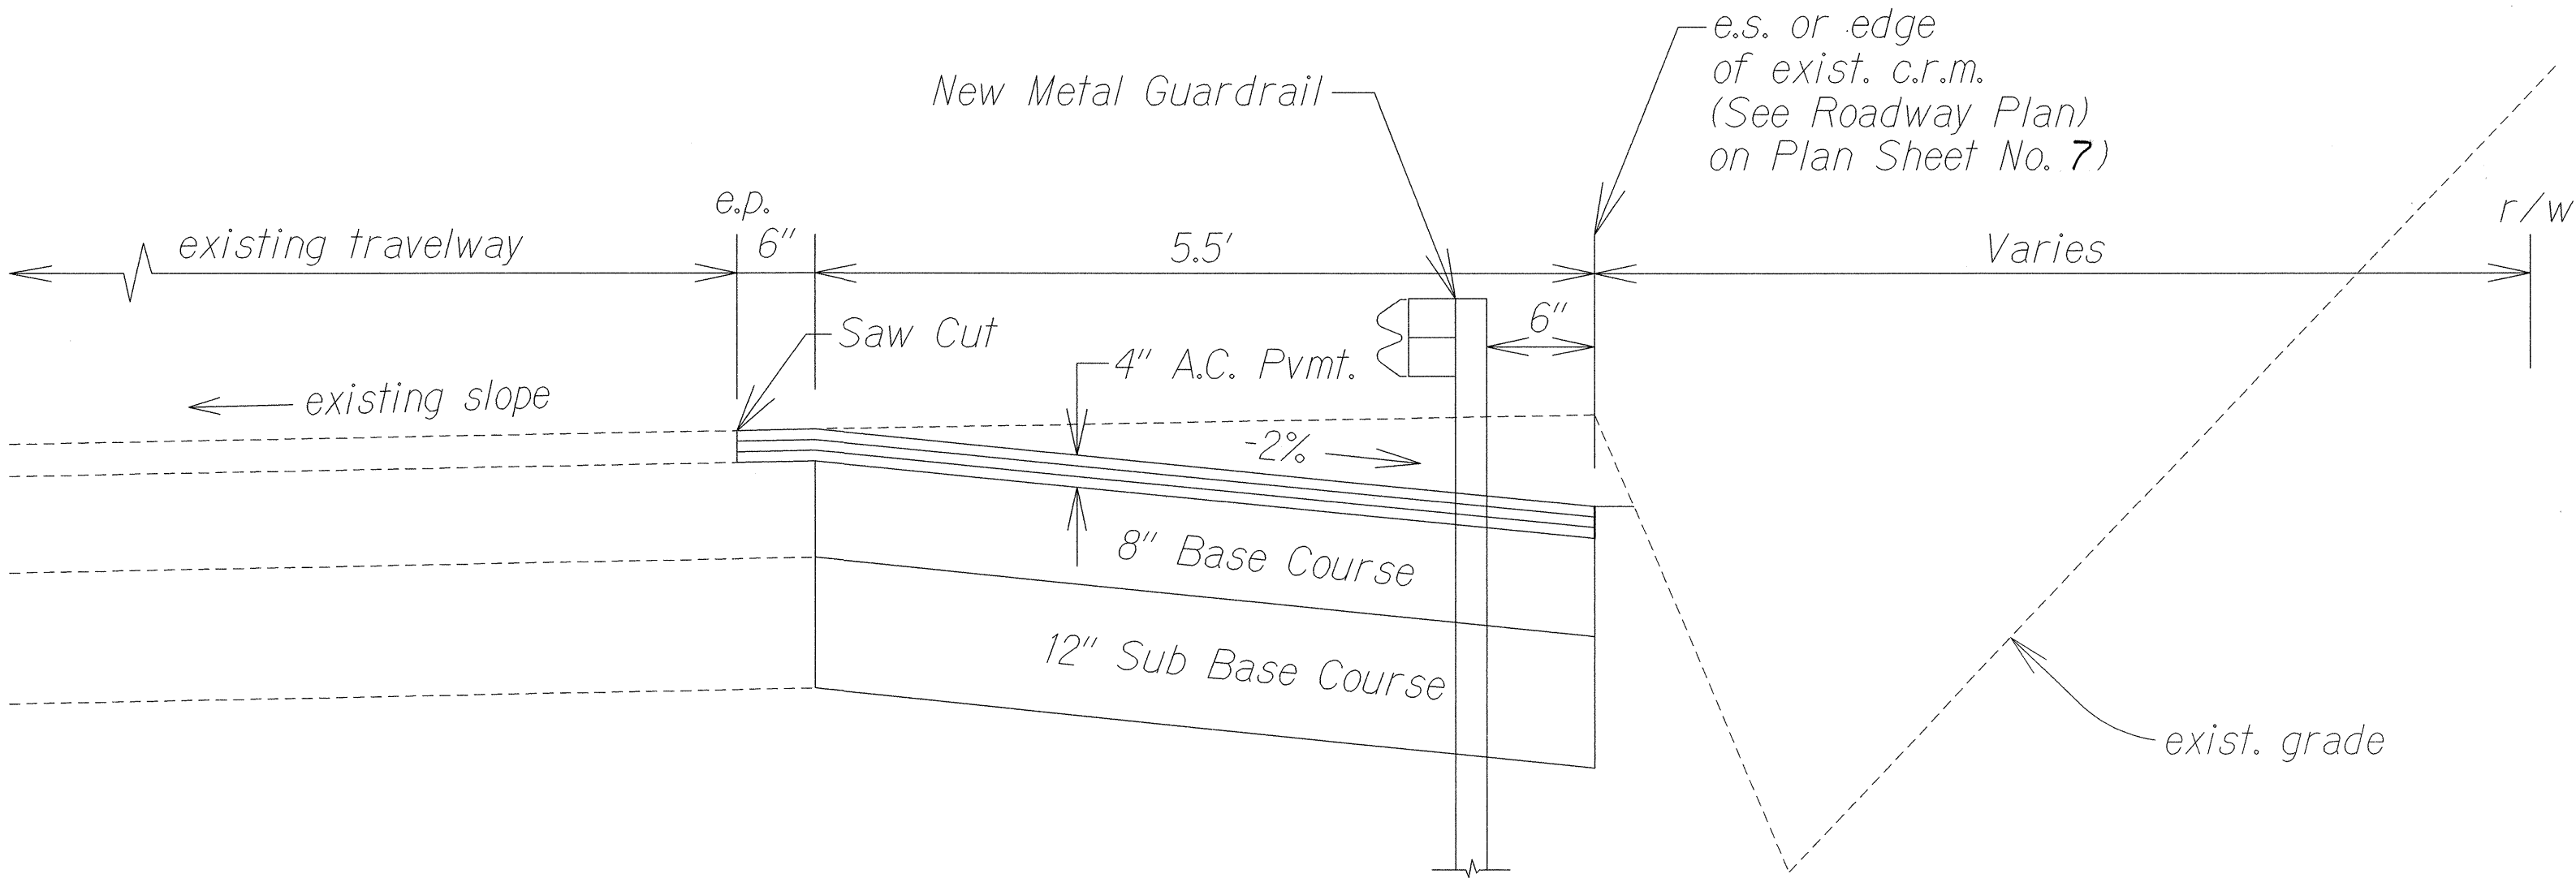


TYPICAL SECTION ADJACENT TO DRAINAGEWAY
 # STA. 35+61.5 TO # STA 36+05 # # STA. 36+55 TO # STA 37+79
Not to Scale

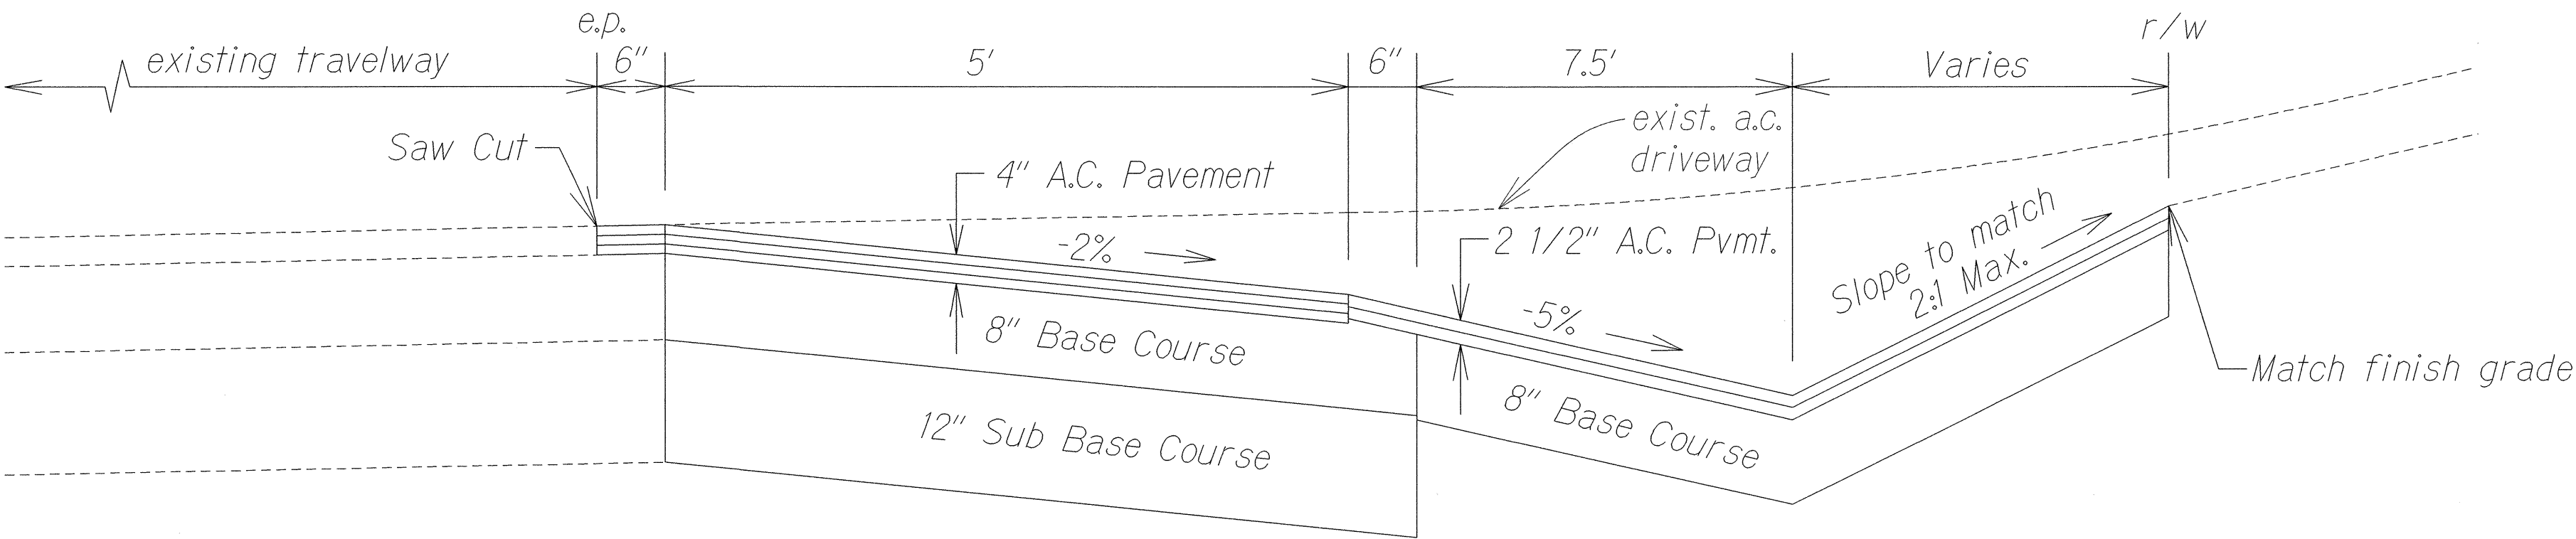


TYPICAL DRIVEWAY APPROACH SECTION
 # STA. 36+05 TO # STA 36+55 # # STA. 37+79 TO # STA 38+40
Not to Scale

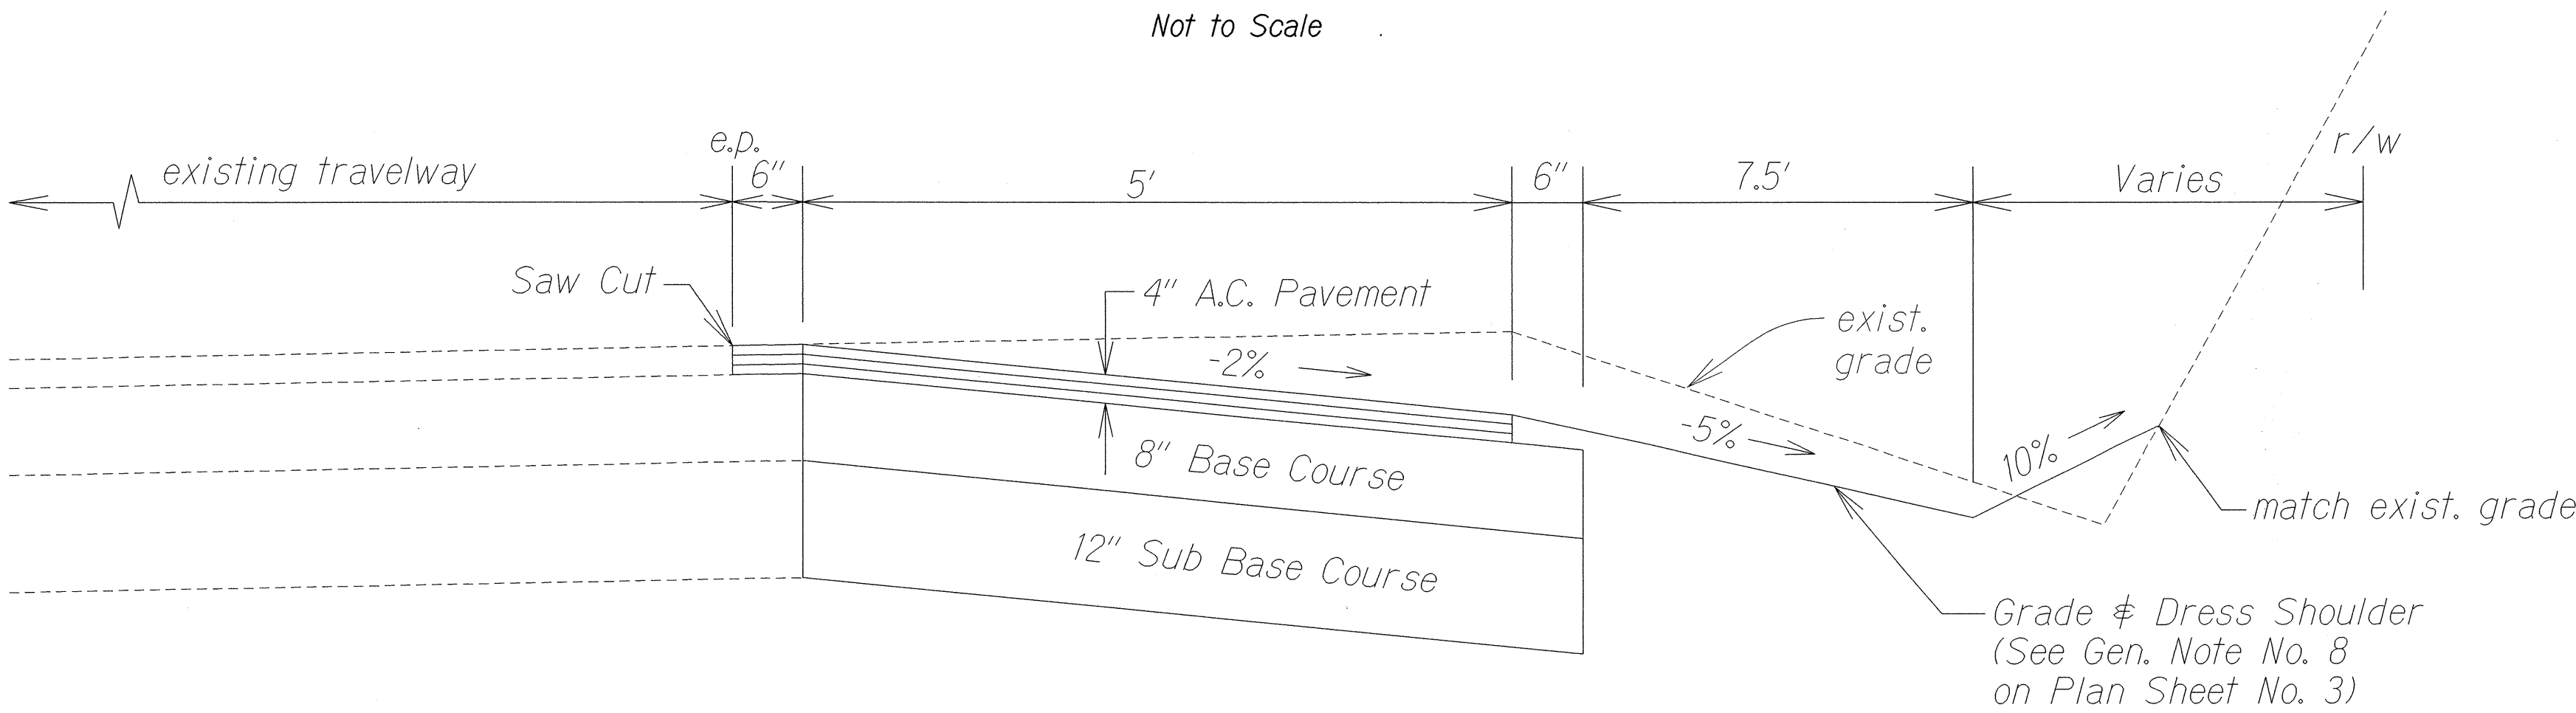


TYPICAL SECTION - # STA. 38+40 TO # STA. 38+83.5
Not to Scale

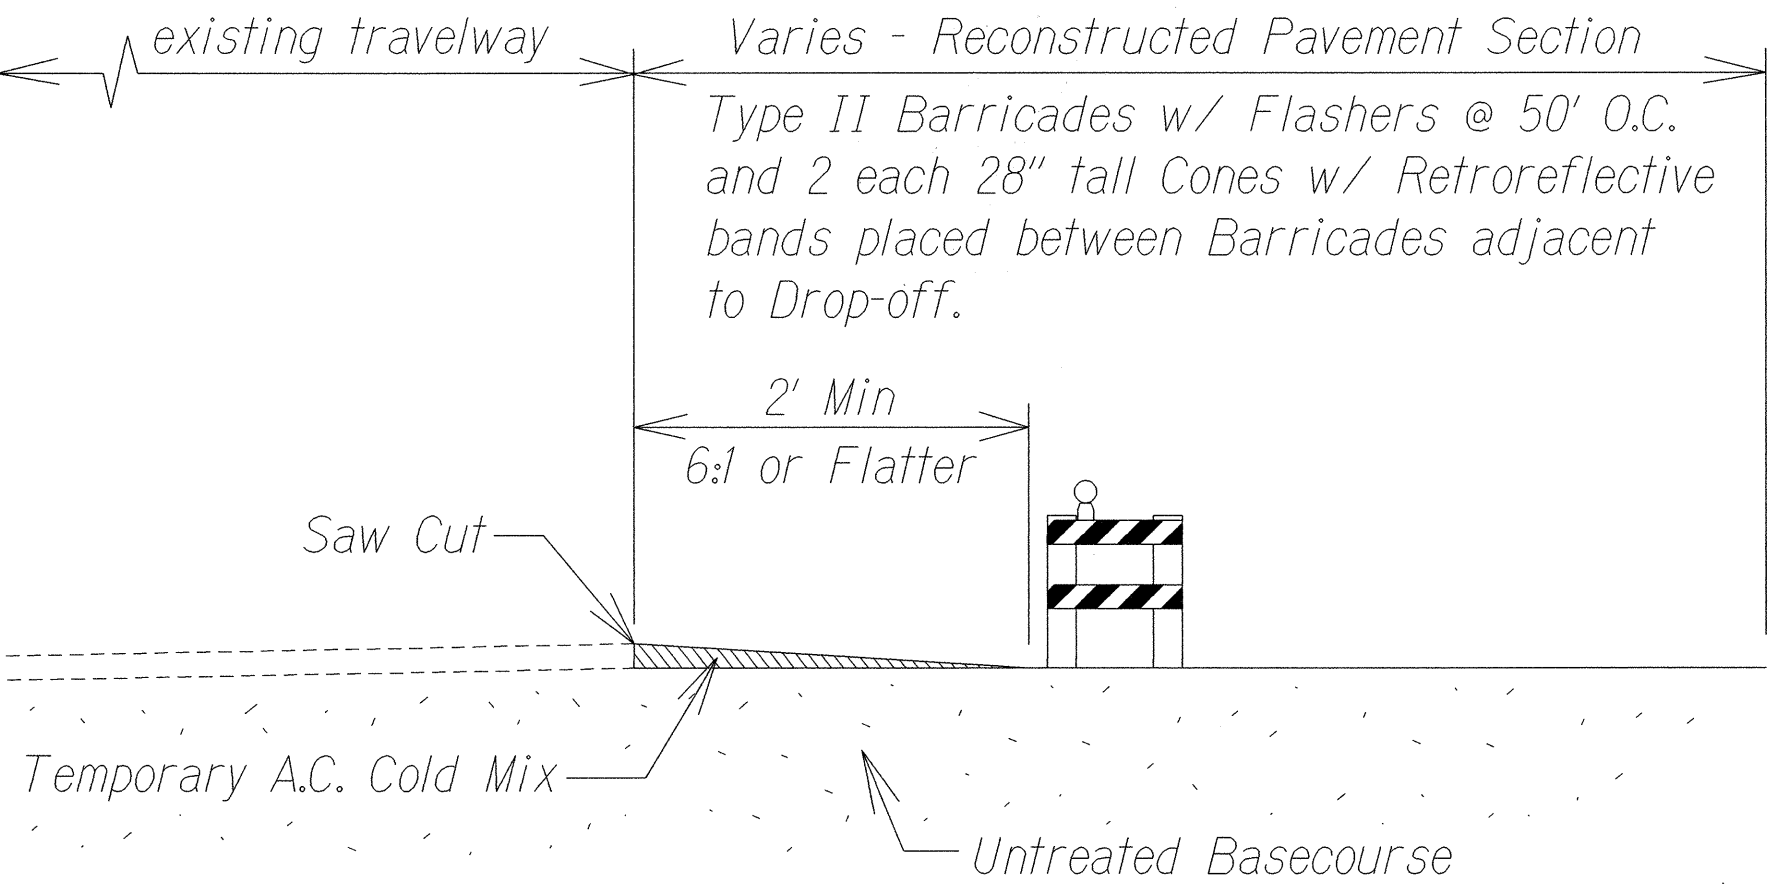

PAVEMENT DROP-OFF DETAIL
Not to Scale

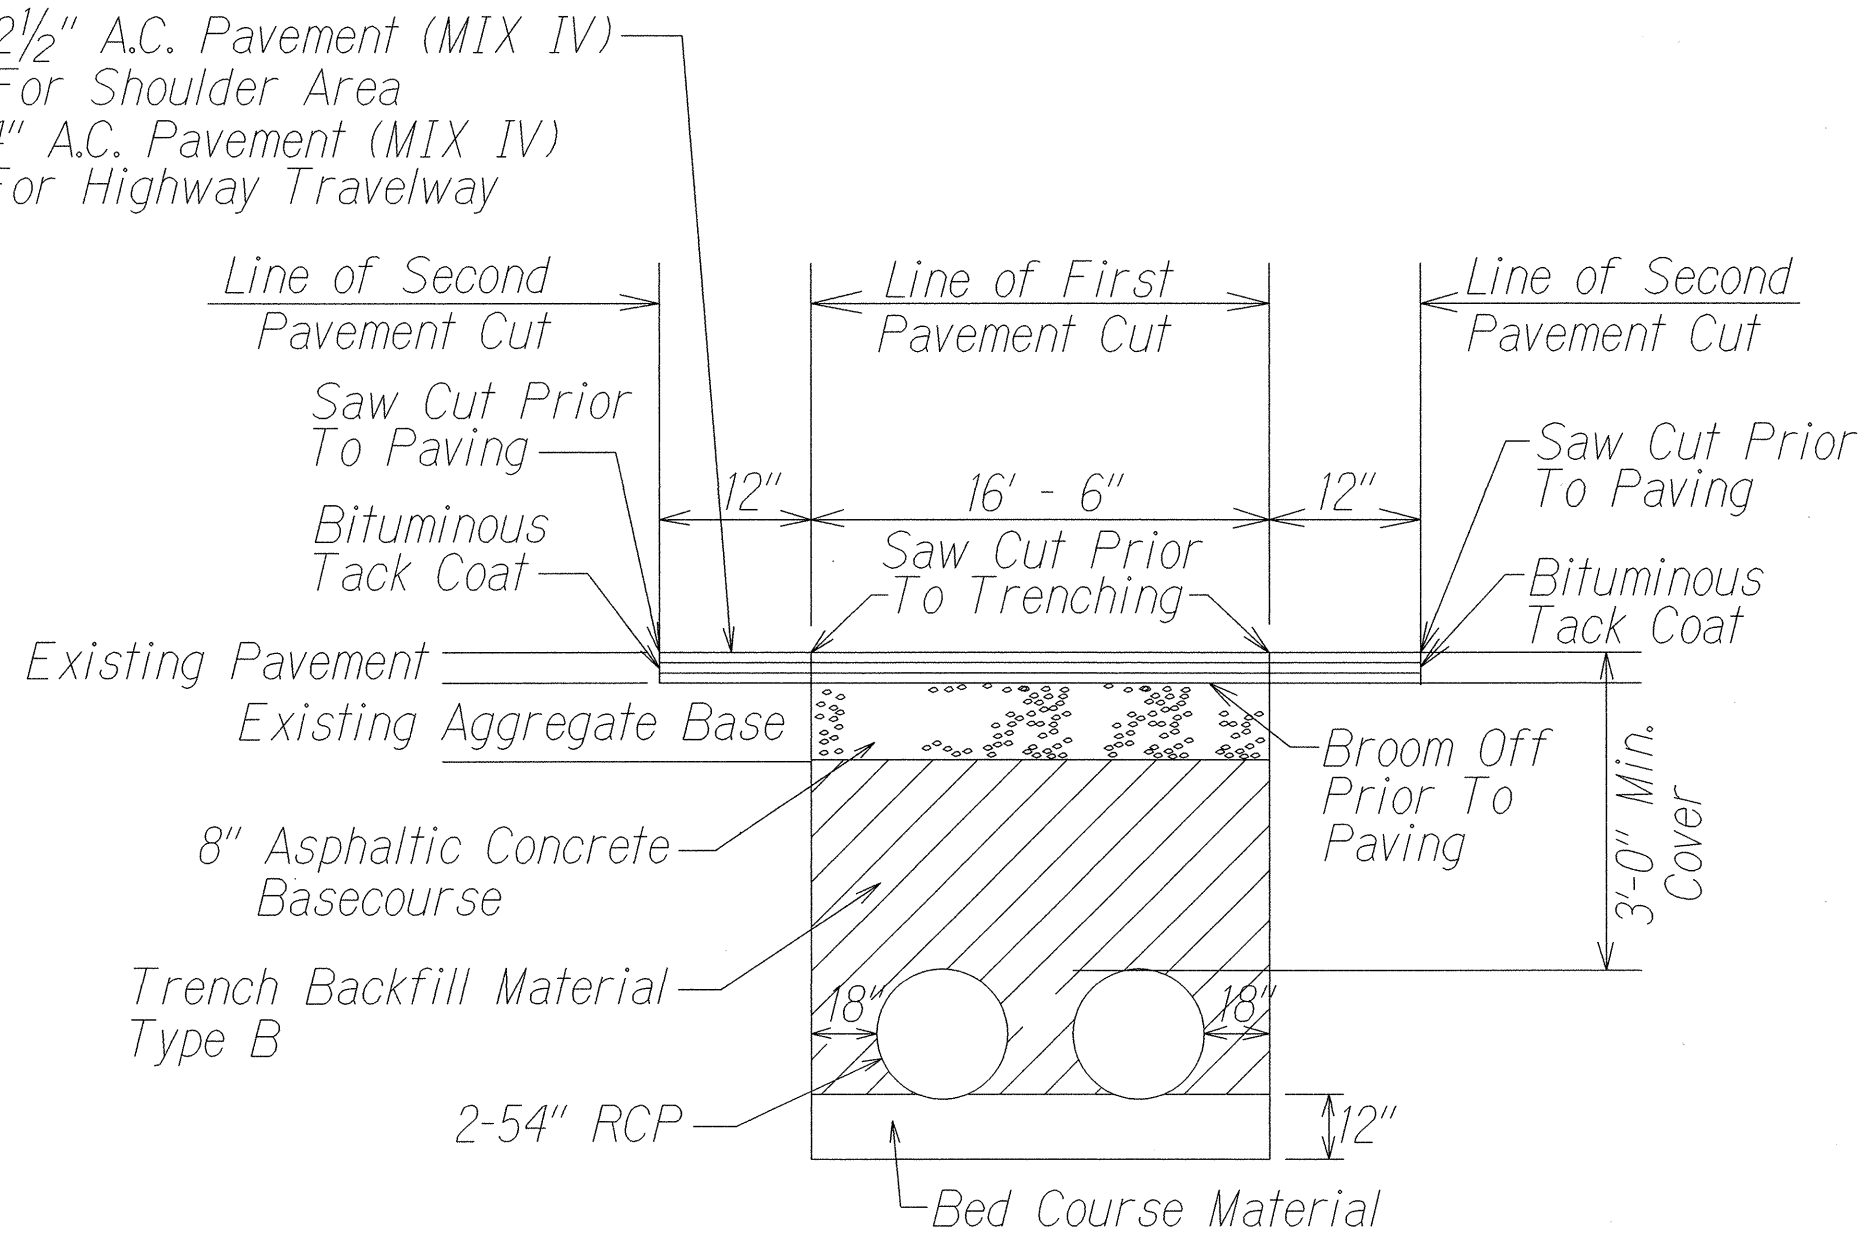

PAVEMENT RESTORATION DETAIL
FOR TWIN 54" DRAINLINE
INSTALLATION ON KAUMUALII HIGHWAY
Not to Scale

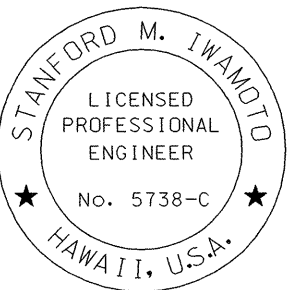

THIS WORK WAS PREPARED BY ME
 OR UNDER MY SUPERVISION
 Signature

STATE OF HAWAII
DEPARTMENT OF TRANSPORTATION
HIGHWAYS DIVISION

TYPICAL SECTIONS
KAUMUALII HIGHWAY,
DRAINAGE IMPROVEMENTS
Vicinity of M.P. 22.0
Project No. 50B-02-99
Scale: N.T.S. Date: August, 2001
SHEET No. 1 OF 1 SHEETS

SURVEY PLOTTED BY	DATE
DRAWN BY	
TRACED BY	
QUANTITIES BY	
CHECKED BY	
ORIGINAL PLAN	
NOTE BOOK	
N _o	

ikmukts01.dgn