

DATE	
SURVEY PLOTTED BY	
DRAWN BY	
DESIGNED BY	
CHECKED BY	
ORIGINAL PLAN	
NOTE BOOK	
NO.	


LEGEND

- Existing improvements at the project site are indicated with inclined lettering.
- New improvements, utility lines, work, etc. for this project are indicated with vertical lettering.

- Concrete
- Existing Underground Telephone Line
- Existing Telephone Pole
- Existing Telephone Manhole
- Existing Telephone Box
- Existing 12" Water Line
- New 12" Water Line
- Existing Water Manhole
- Existing Water Valve Box
- Existing Water Meter
- Existing Fire Hydrant
- Existing 12" Sewer Line
- Existing Sewer Manhole

- Existing 24" Drain Line
- New 24" Drain Line
- Existing Storm Drain Manhole
- Existing Drop Inlet
- Existing Catch Basin
- New Underdrain Pipe
- New Underdrain Pipe Cleanout
- Existing Traffic Sign
- New Traffic Sign
- Existing Guard Rail
- New Guard Rail
- New Street Monument
- Existing Right-of-Way
- New Right-of-Way
- New Finish Grade or Elevation

FED. ROAD DIST. NO.	STATE	PROJ. NO.	FISCAL YEAR	SHEET NO.	TOTAL SHEETS
HAWAII	HAW.	50E-01-98	1998	ADD. 10	79

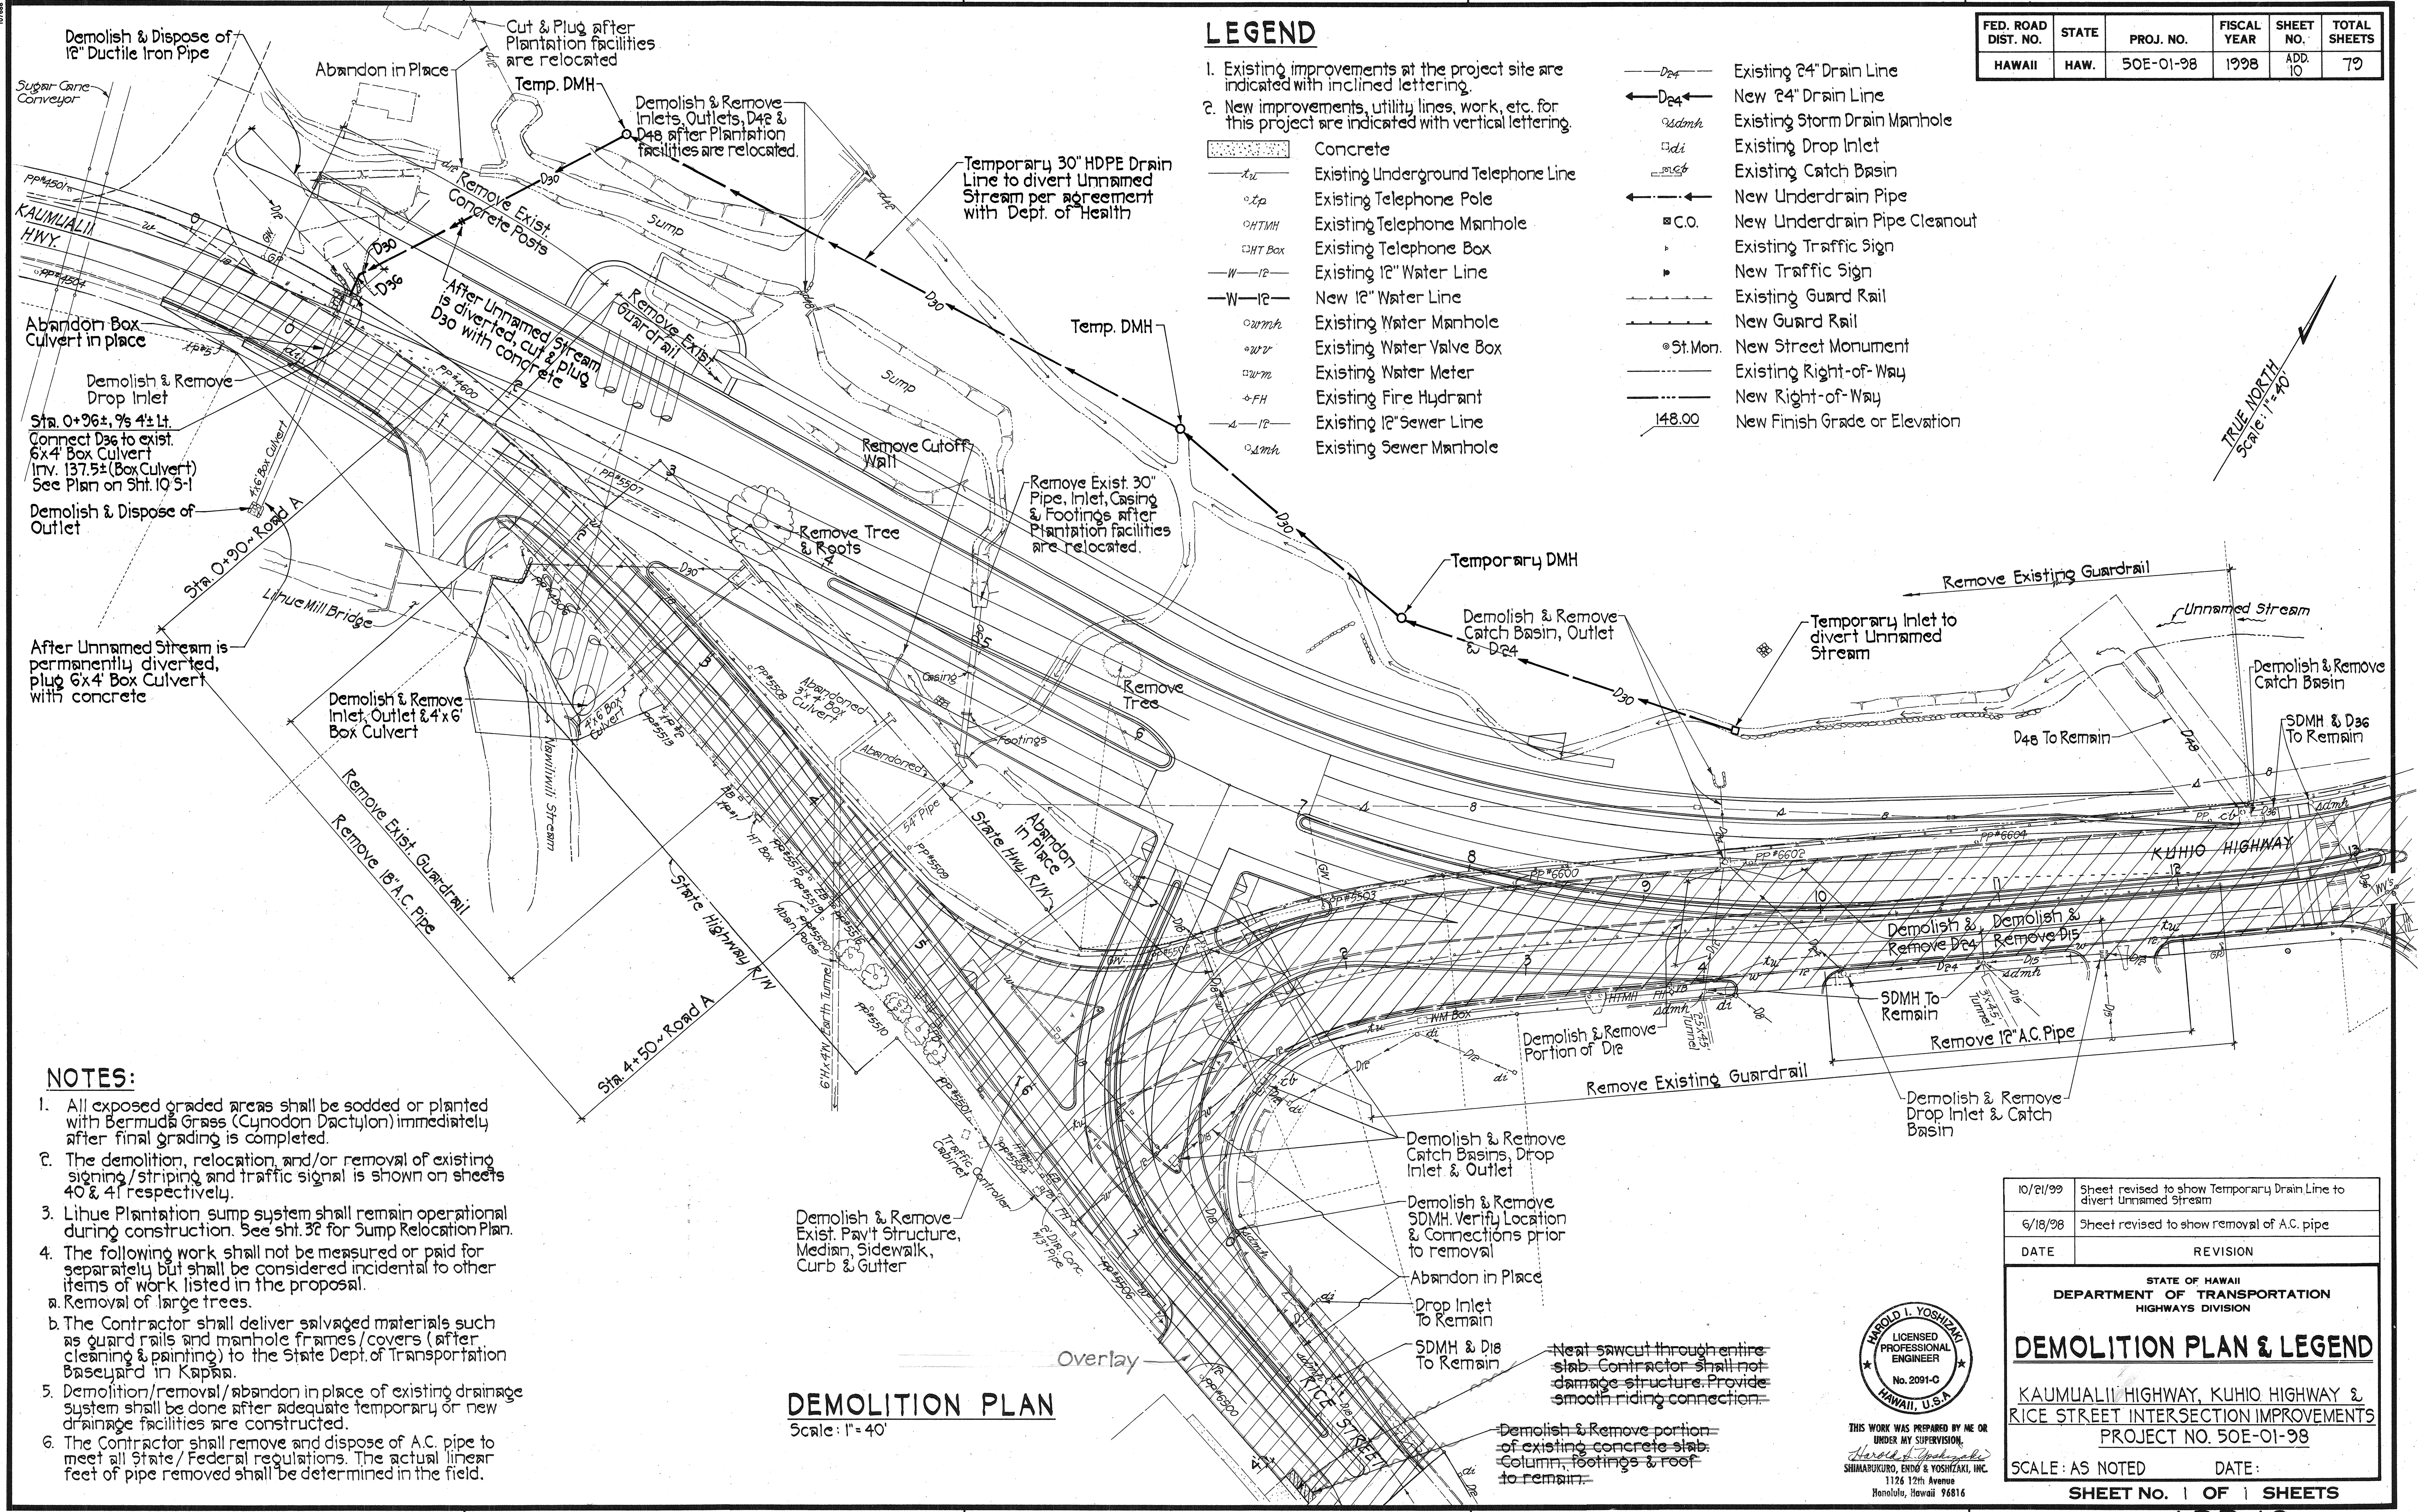


NOTES:

- All exposed graded areas shall be sodded or planted with Bermuda Grass (Cynodon Dactylon) immediately after final grading is completed.
- The demolition, relocation, and/or removal of existing signing/stripping and traffic signal is shown on sheets 40 & 41 respectively.
- Lihue Plantation sump system shall remain operational during construction. See Sht. 32 for Sump Relocation Plan.
- The following work shall not be measured or paid for separately but shall be considered incidental to other items of work listed in the proposal.
 - Removal of large trees.
 - The Contractor shall deliver salvaged materials such as guard rails and manhole frames/covers (after cleaning & painting) to the State Dept. of Transportation Baseyard in Kapahua.
- Demolition/removal/abandon in place of existing drainage system shall be done after adequate temporary or new drainage facilities are constructed.
- The Contractor shall remove and dispose of A.C. pipe to meet all State/Federal regulations. The actual linear feet of pipe removed shall be determined in the field.

DEMOLITION PLAN

Scale: 1"=40'

10/21/99	Sheet revised to show Temporary Drain Line to divert Unnamed Stream
6/18/98	Sheet revised to show removal of A.C. pipe
DATE	REVISION

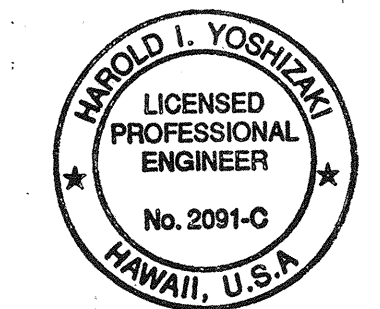

THIS WORK WAS PREPARED BY ME OR UNDER MY SUPERVISION.
 HAROLD I. YOSHIZAKI
 SHIMABUKURO, ENDO & YOSHIZAKI, INC.
 1126 12th Avenue
 Honolulu, Hawaii 96816

STATE OF HAWAII
 DEPARTMENT OF TRANSPORTATION
 HIGHWAYS DIVISION

DEMOLITION PLAN & LEGEND

KAUNUALII HIGHWAY, KUHIO HIGHWAY &
 RICE STREET INTERSECTION IMPROVEMENTS
 PROJECT NO. 50E-01-98

SCALE: AS NOTED DATE:

SHEET NO. 1 OF 1 SHEETS

"AS-BUILT"

ADD. 10