



FED. ROAD DIST. NO.	STATE	PROJ. NO.	FISCAL YEAR	SHEET NO.	TOTAL SHEETS
HAWAII	HAW.	50E-01-98	1998	ADD. 31	79

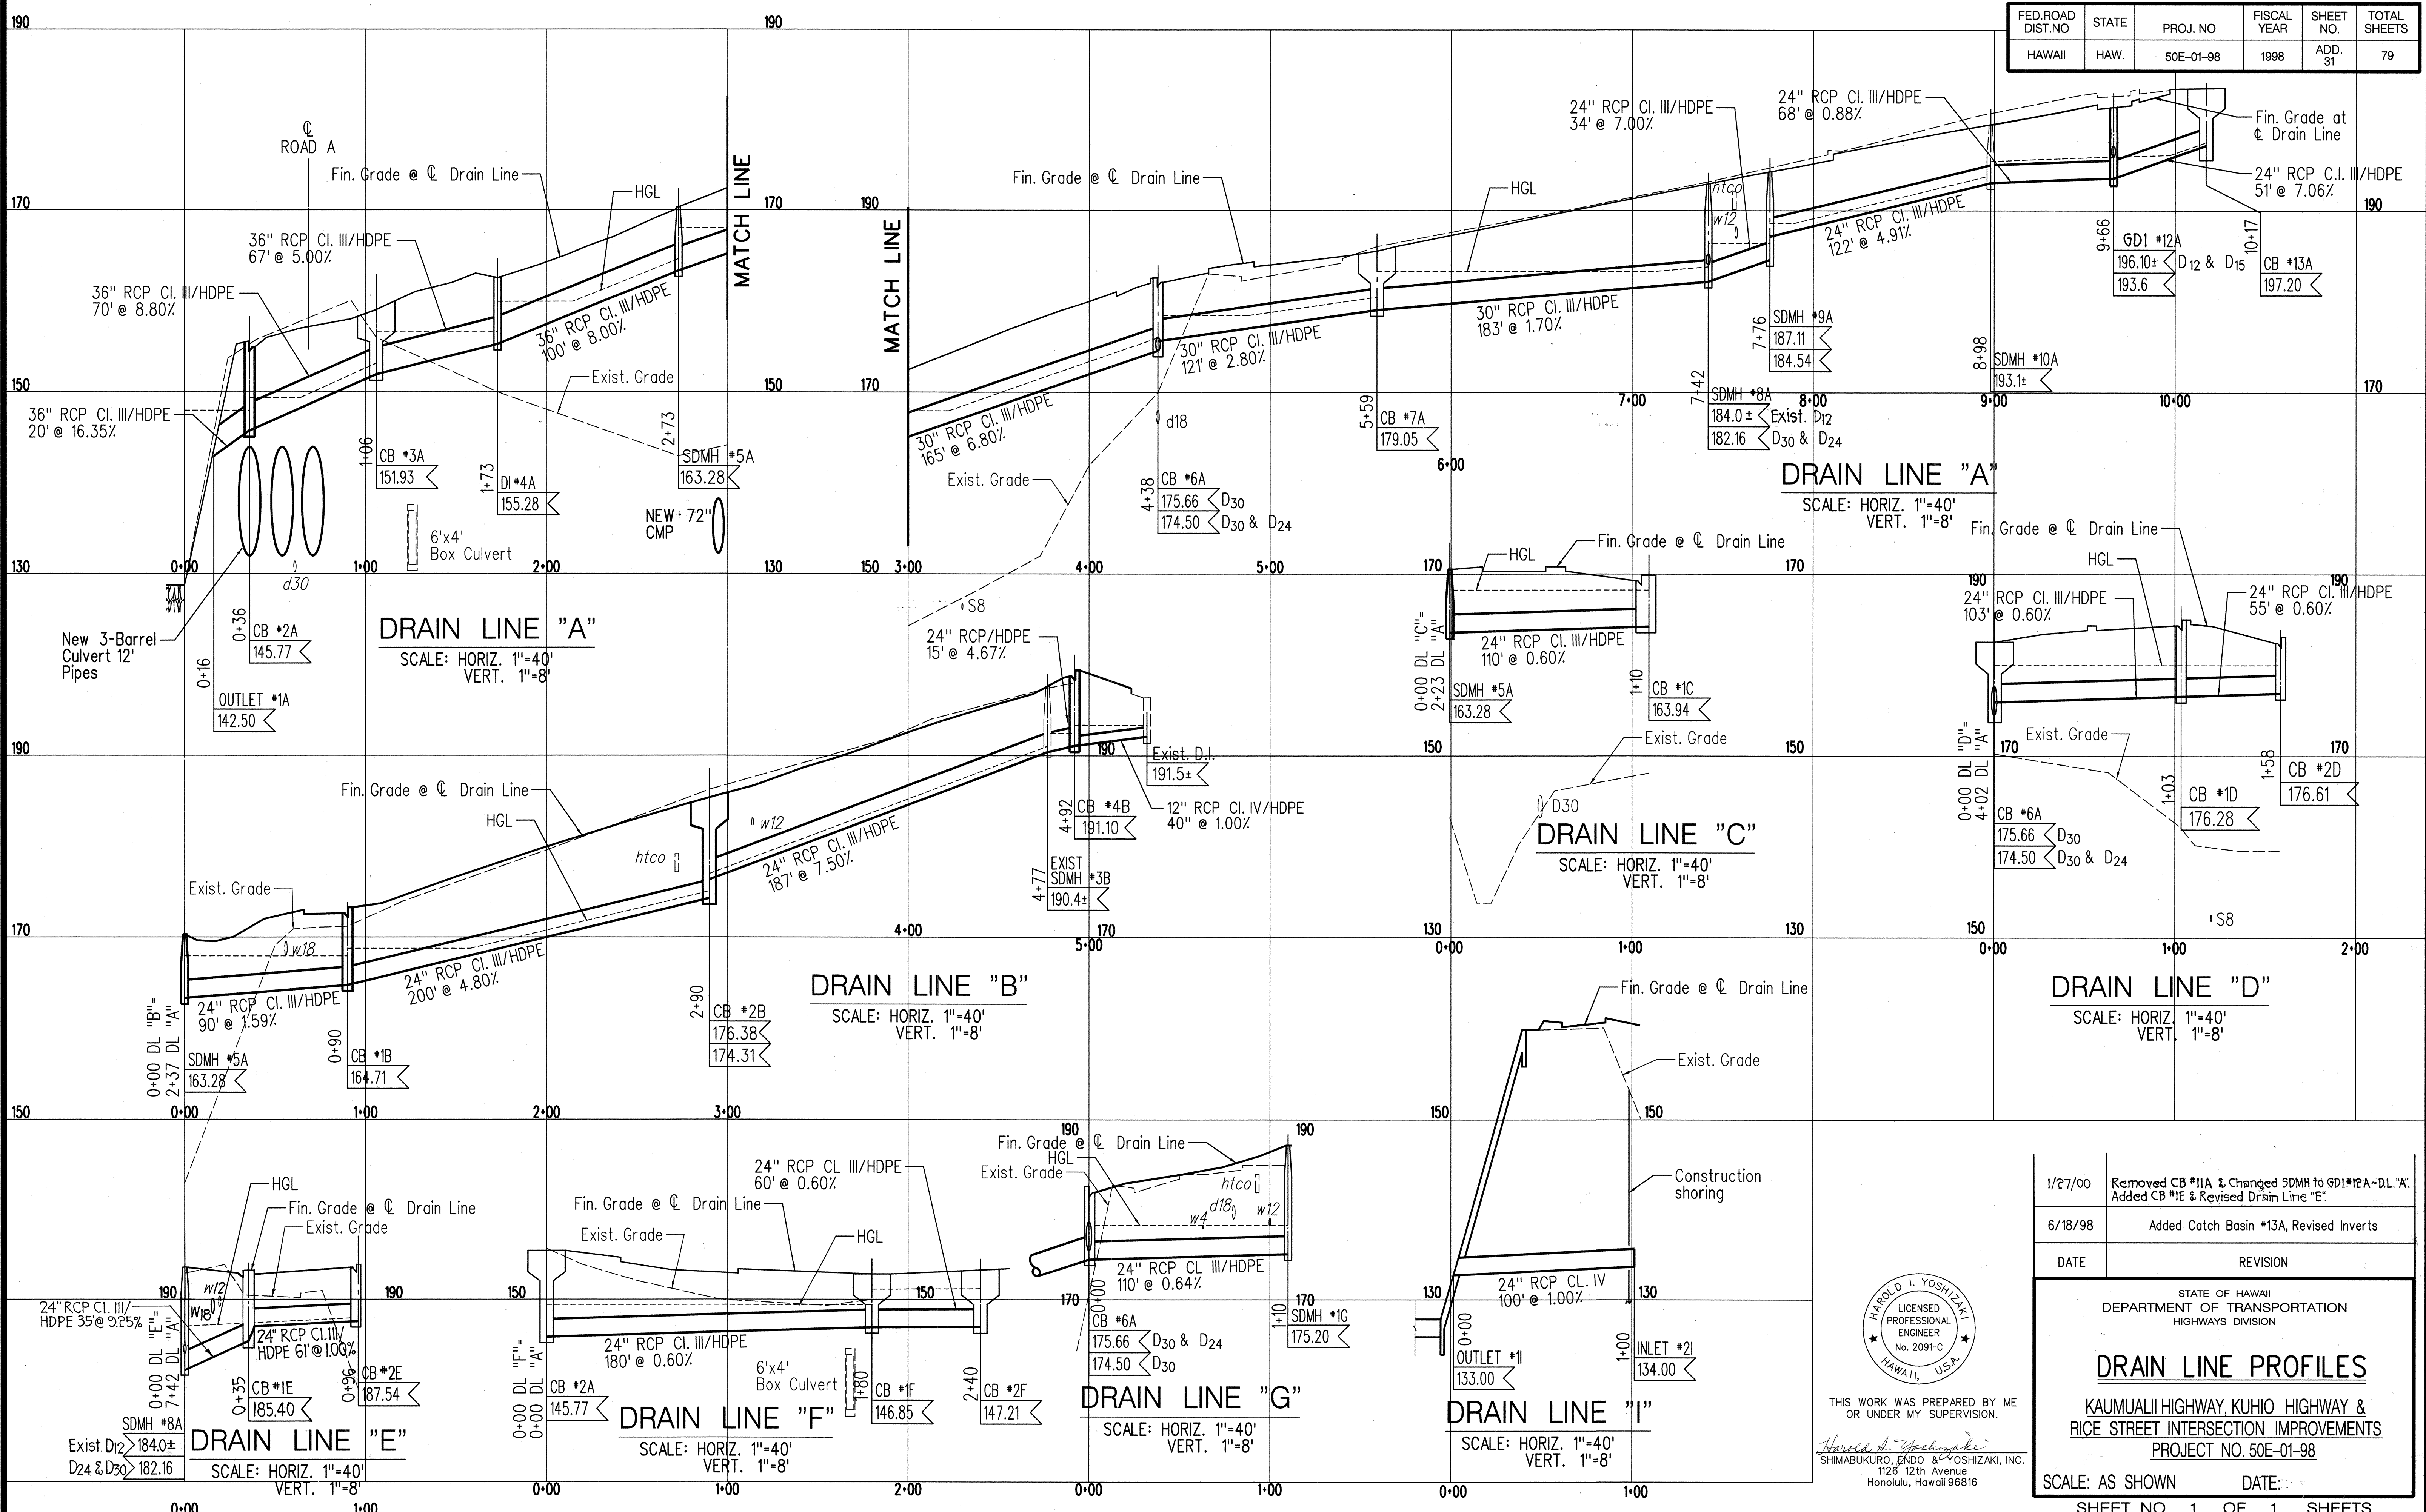

DATE	1/27/00
DESIGNED BY	TRACED BY
NOTED BY	CHECKED BY
ORIGINAL	NO.

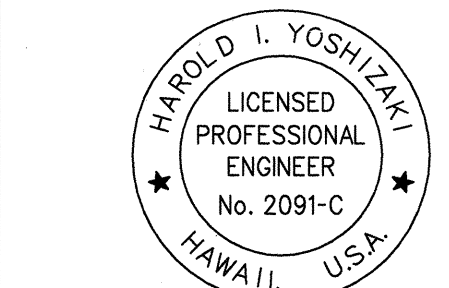

THIS WORK WAS PREPARED BY ME
OR UNDER MY SUPERVISION.
Harold I. Yoshizaki
SHIMABUKURO, ENDO & YOSHIKAWA, INC.
1126 12th Avenue
Honolulu, Hawaii 96816

1/27/00	Removed CB #11A & Changed SDMH to GD1 #12A-DL "A". Added CB #1E & Revised Drain Line "E".
6/18/98	Added Catch Basin #13A, Revised Inverts
DATE	REVISION
STATE OF HAWAII DEPARTMENT OF TRANSPORTATION HIGHWAYS DIVISION	
DRAIN LINE PROFILES	
KAUMUALII HIGHWAY, KUHIO HIGHWAY & RICE STREET INTERSECTION IMPROVEMENTS PROJECT NO. 50E-01-98	
SCALE: AS SHOWN	DATE: 1/27/00
SHEET NO. 1 OF 1 SHEETS	