

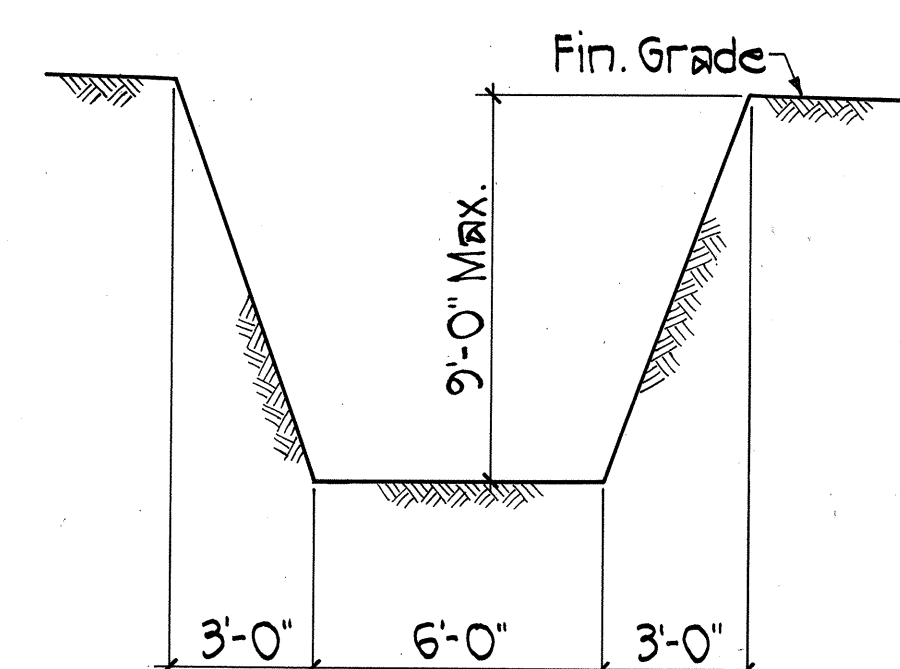
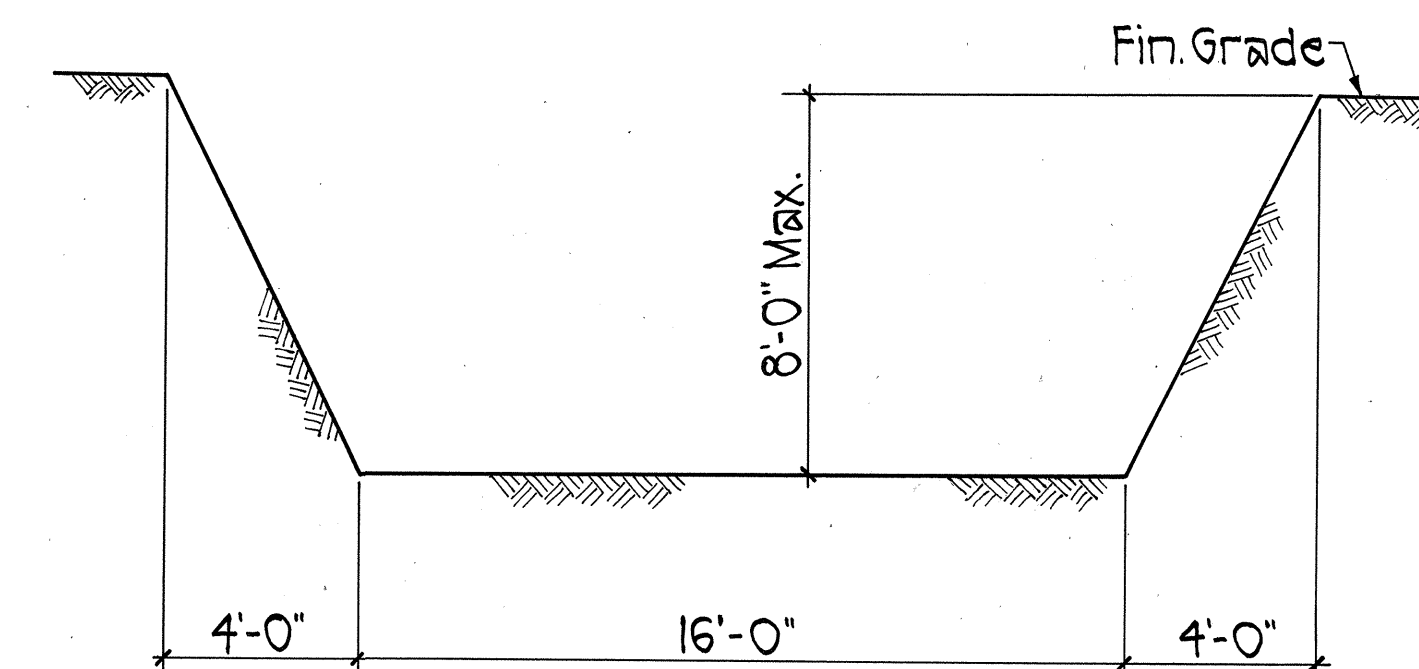
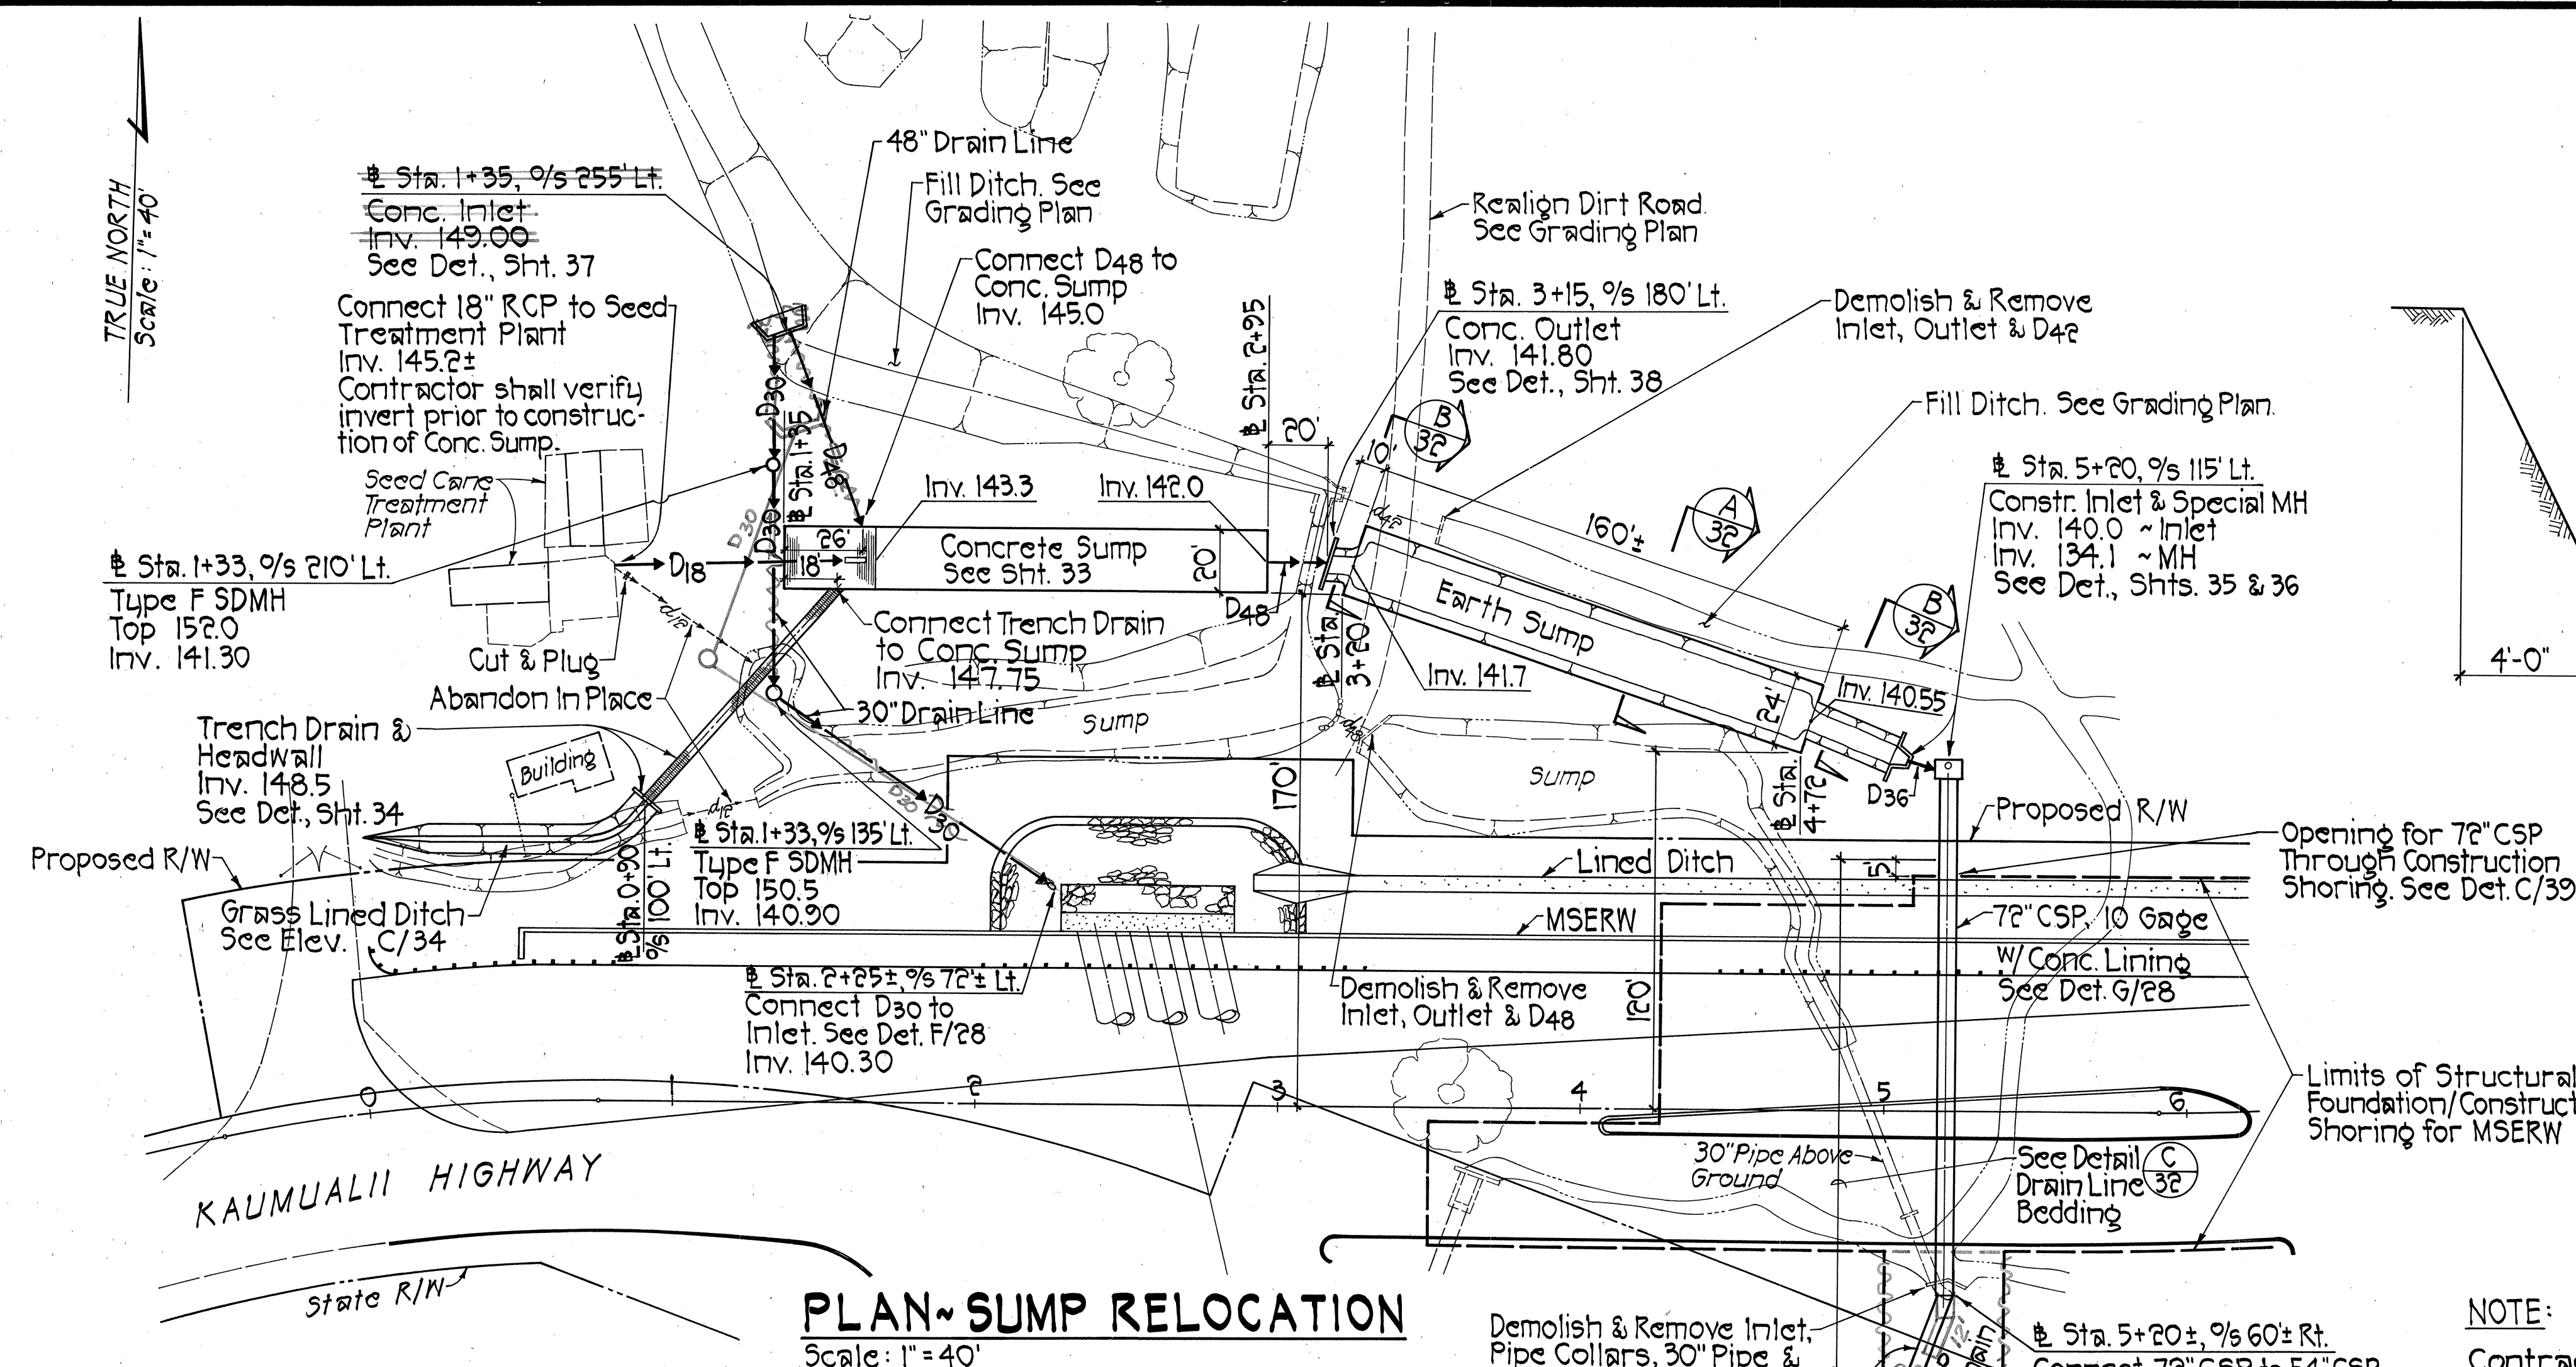


FED. ROAD DIST. NO.	STATE	PROJ. NO.	FISCAL YEAR	SHEET NO.	TOTAL SHEETS
HAWAII	HAW.	50E-01-98	1998	ADD. 32	79

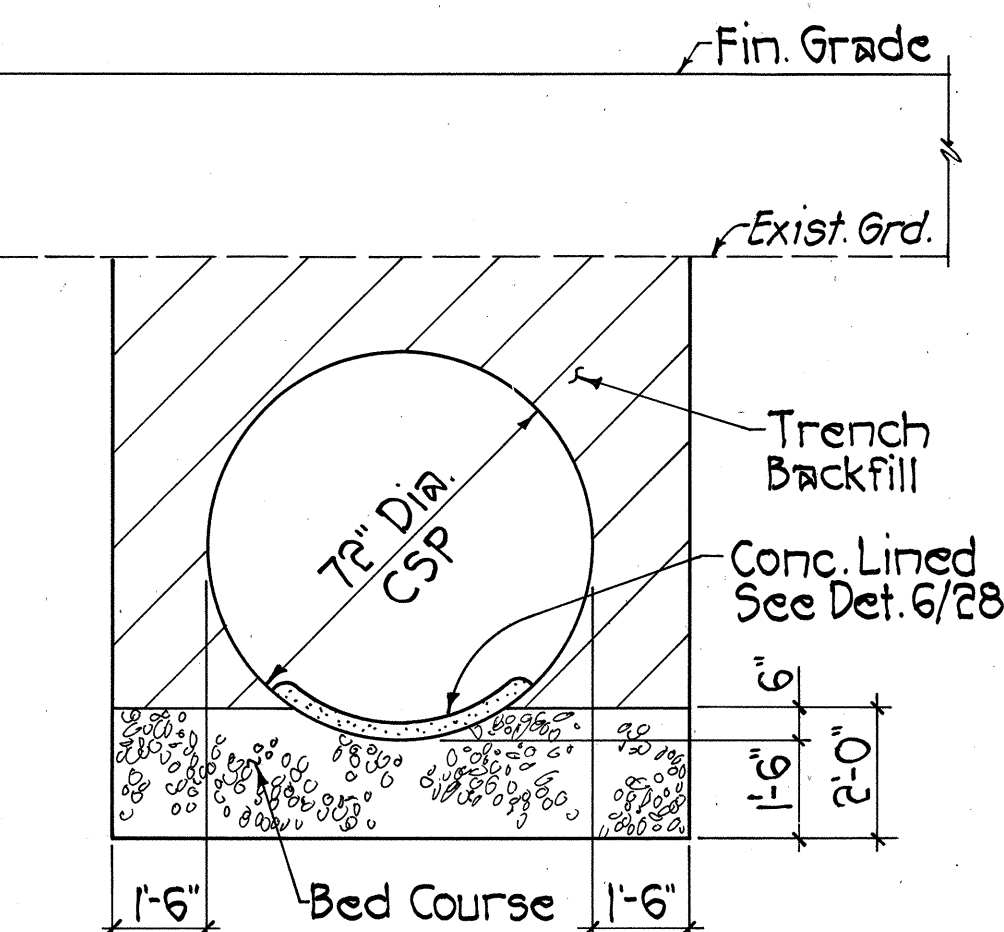

SUMP SECTION A
Scale: 1/4"=1'-0" 32

DITCH SECTION B
Scale: 1/4"=1'-0" 32





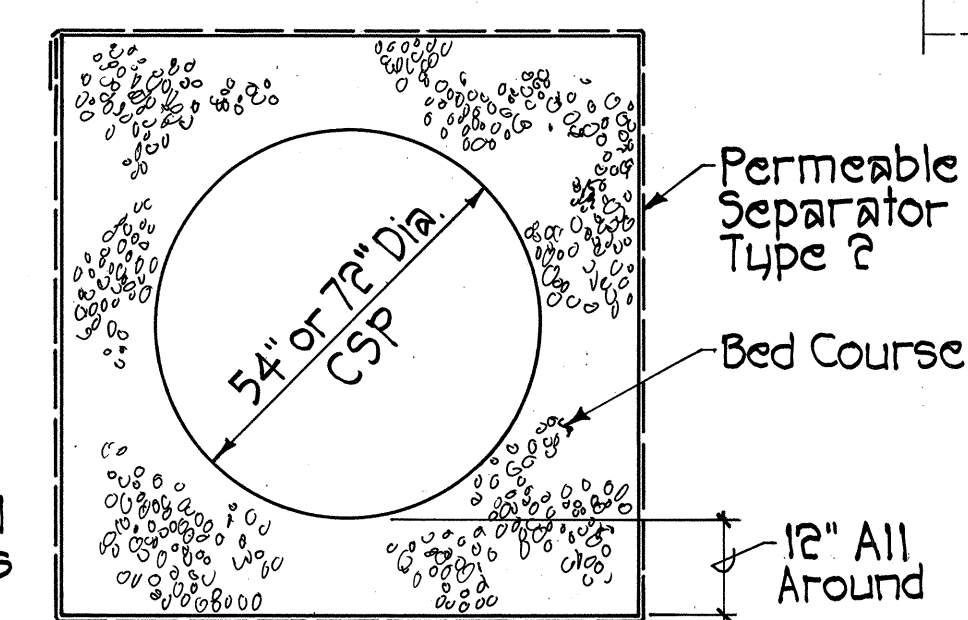


SECTION C
Not To Scale 32

SECTION D
Not To Scale 32

NOTE:
Contractor shall seal all pipe joints water tight with asphalt.

Demolish & Remove Inlet, Pipe Collars, 30" Pipe & Box connecting to 54" CSP
54" CSP, 10 Gauge Unlined
Opening for 54" CSP Through Construction Shoring. See Det. C/39
Connect 72" CSP to 54" CSP with Reinf. Concrete Collar Inv. 132.3±
See Detail, Sht. 39
Contractor shall verify size and location of existing 54" CSP

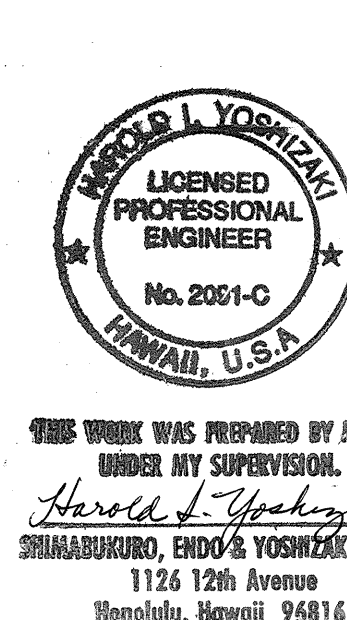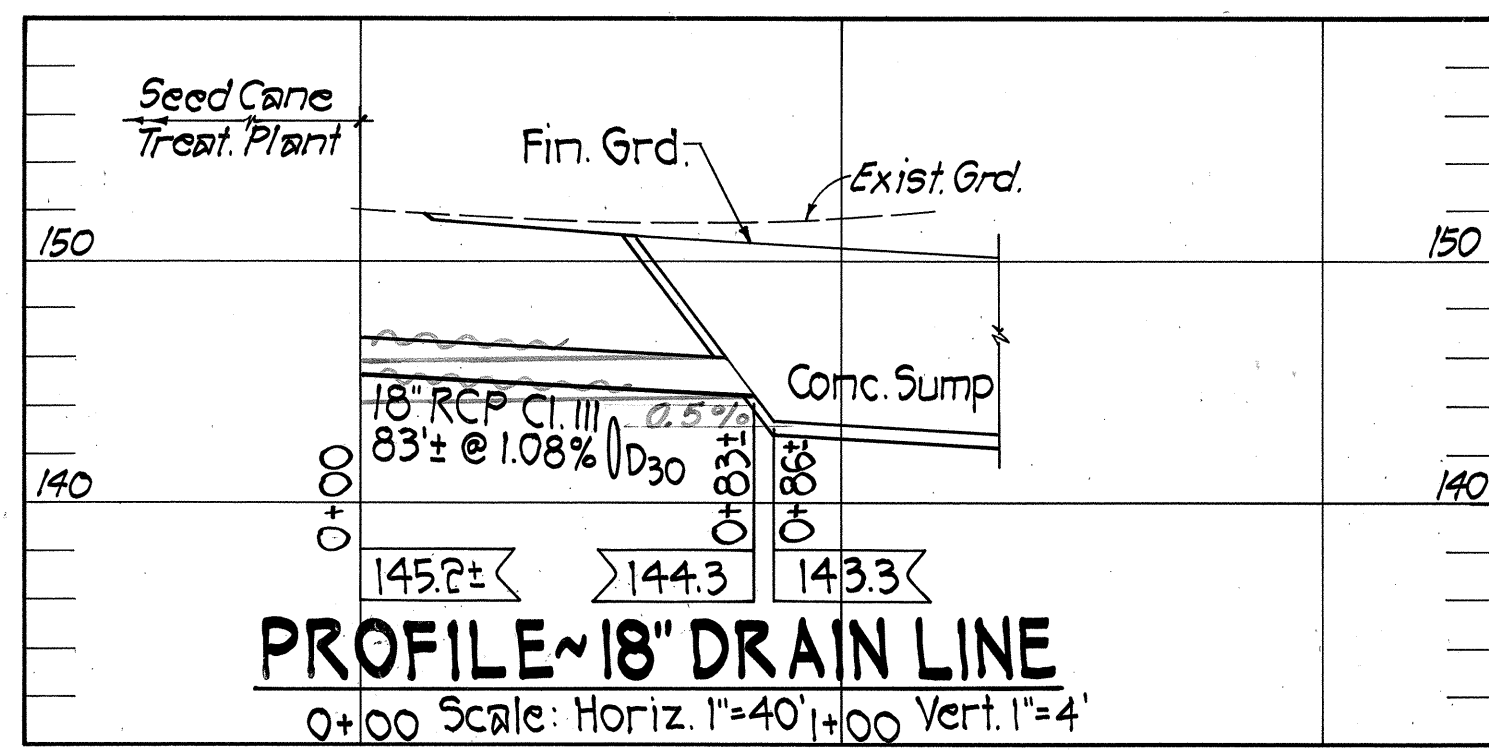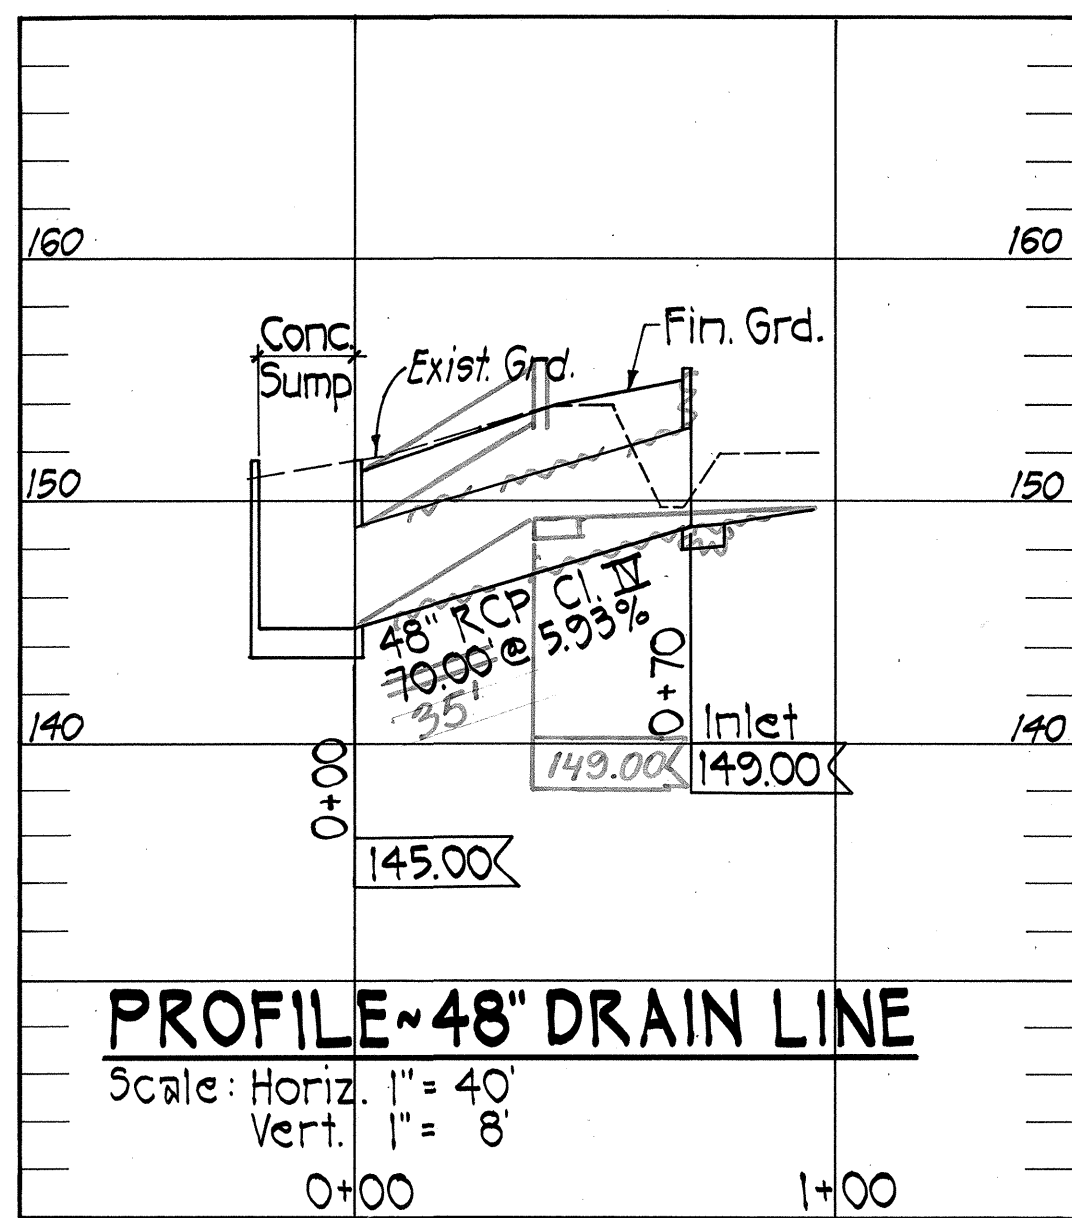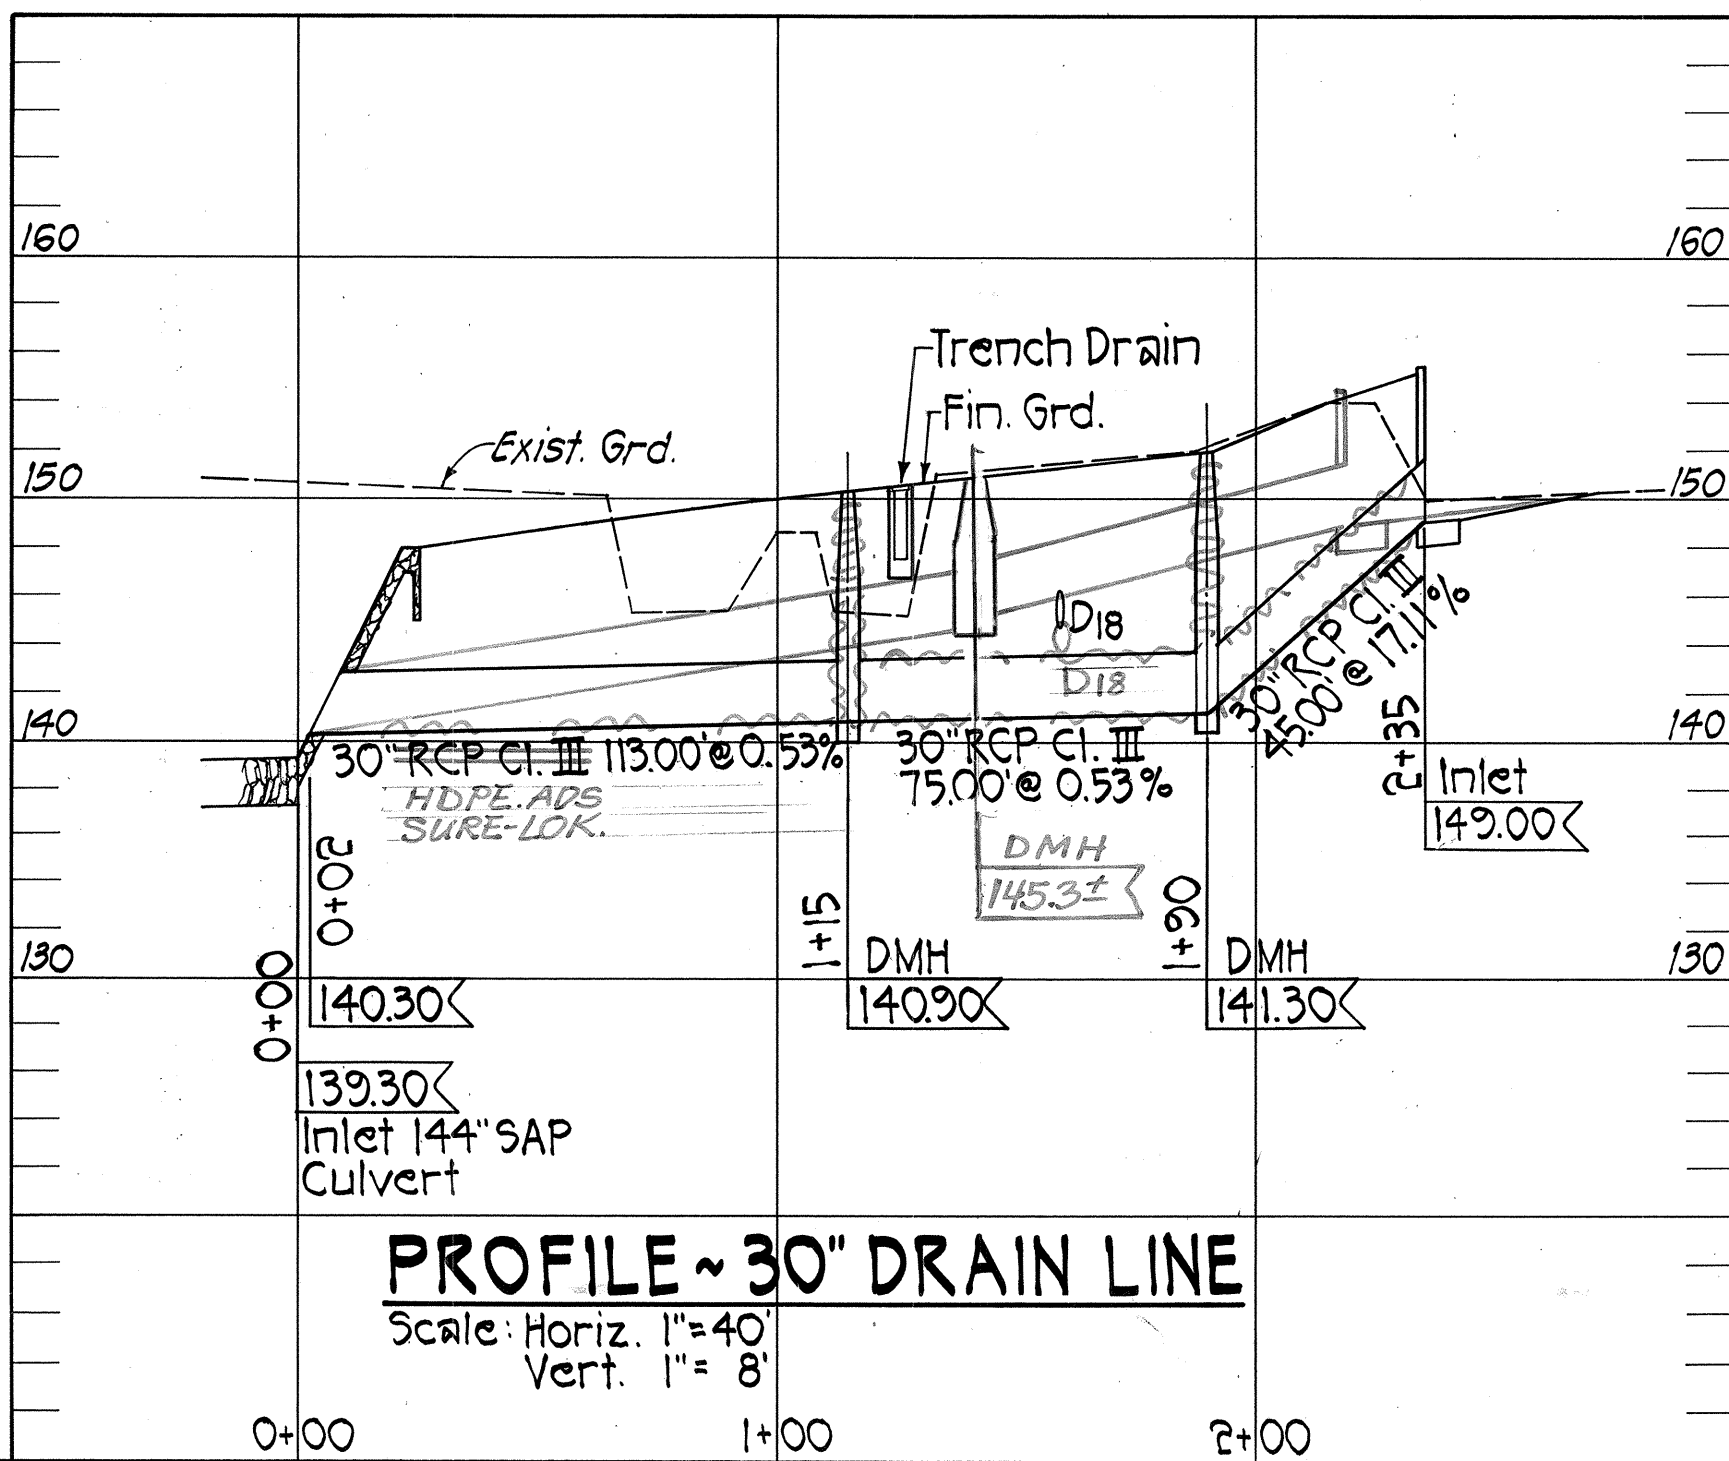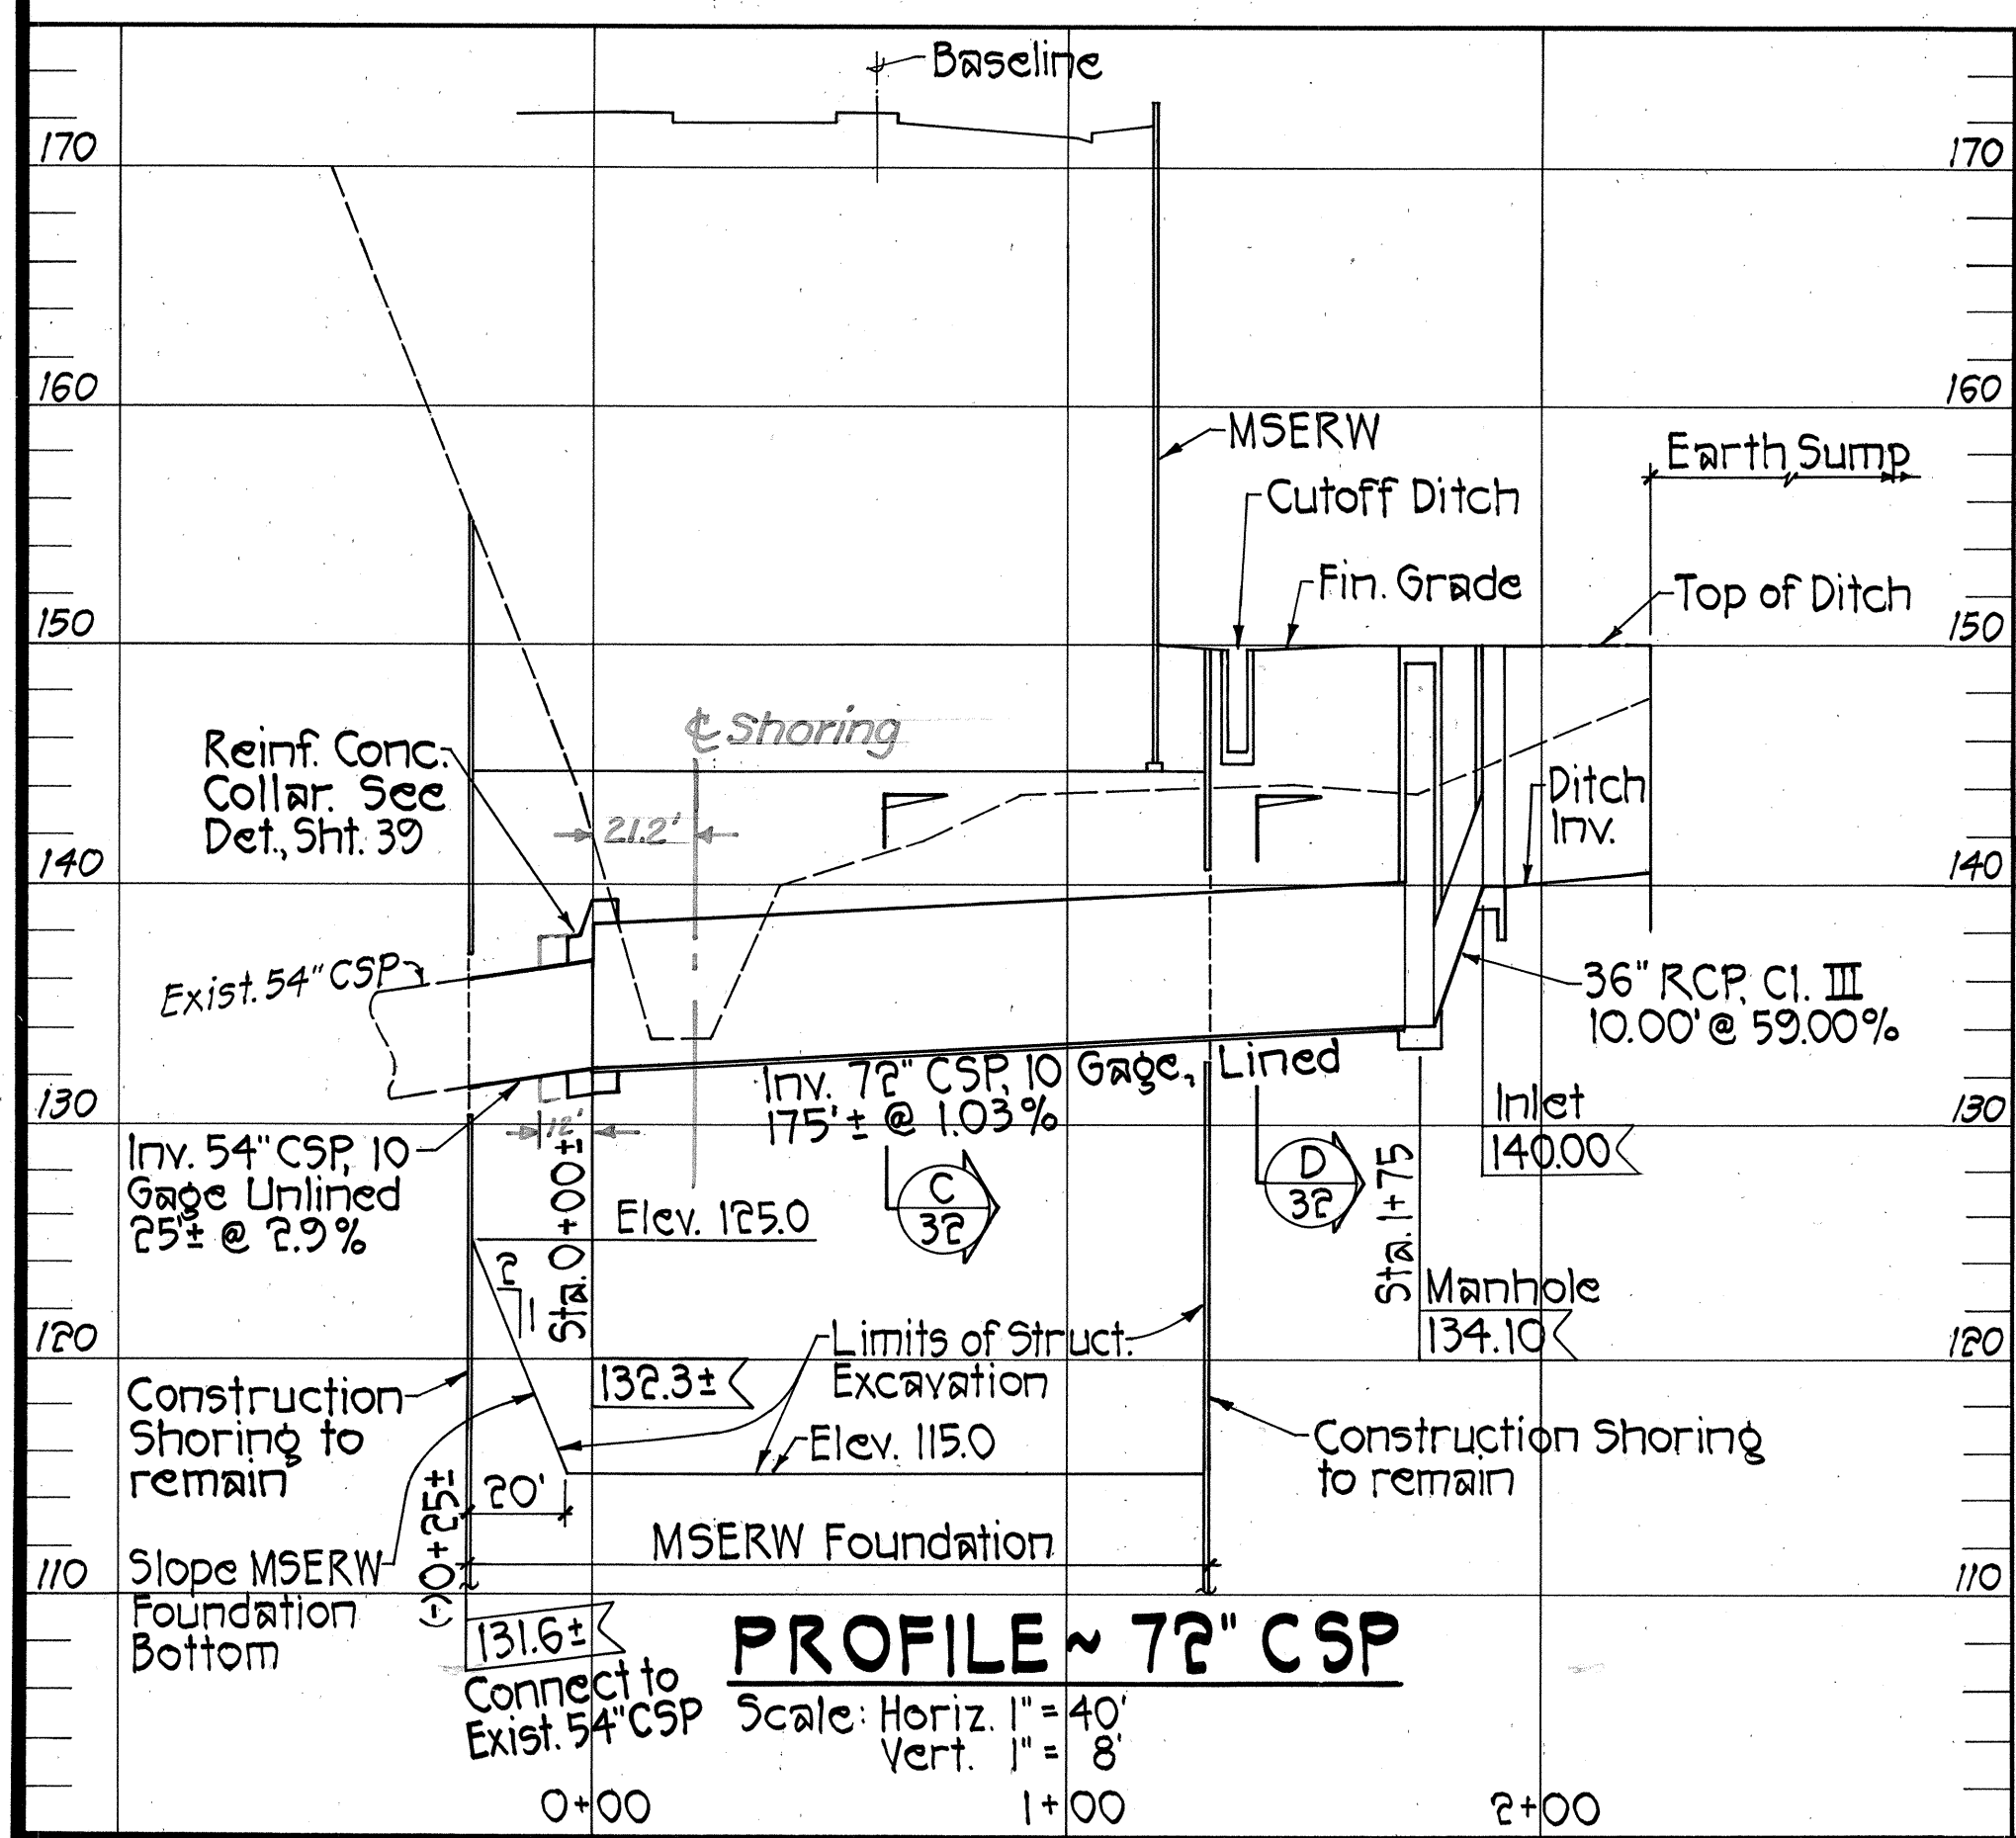

STATE OF HAWAII
DEPARTMENT OF TRANSPORTATION
HIGHWAYS DIVISION
**LIHUE PLANTATION
SUMP RELOCATION PLAN**
KAUMUALII HIGHWAY, KUHIO HIGHWAY &
RICE STREET INTERSECTION IMPROVEMENTS
PROJECT NO. 50E-01-98
SCALE: AS NOTED DATE:
SHEET NO. 1 OF 1 SHEETS

"AS-BUILT"

ADD. 32