


FED. ROAD DIST. NO.	STATE	PROJ. NO.	FISCAL YEAR	SHEET NO.	TOTAL SHEETS
HAWAII	HAW.	50E-01-98	1998	ADD 40	79

**NOTE:**  
1. Removal of existing signs also requires removal of post and footing (if required).

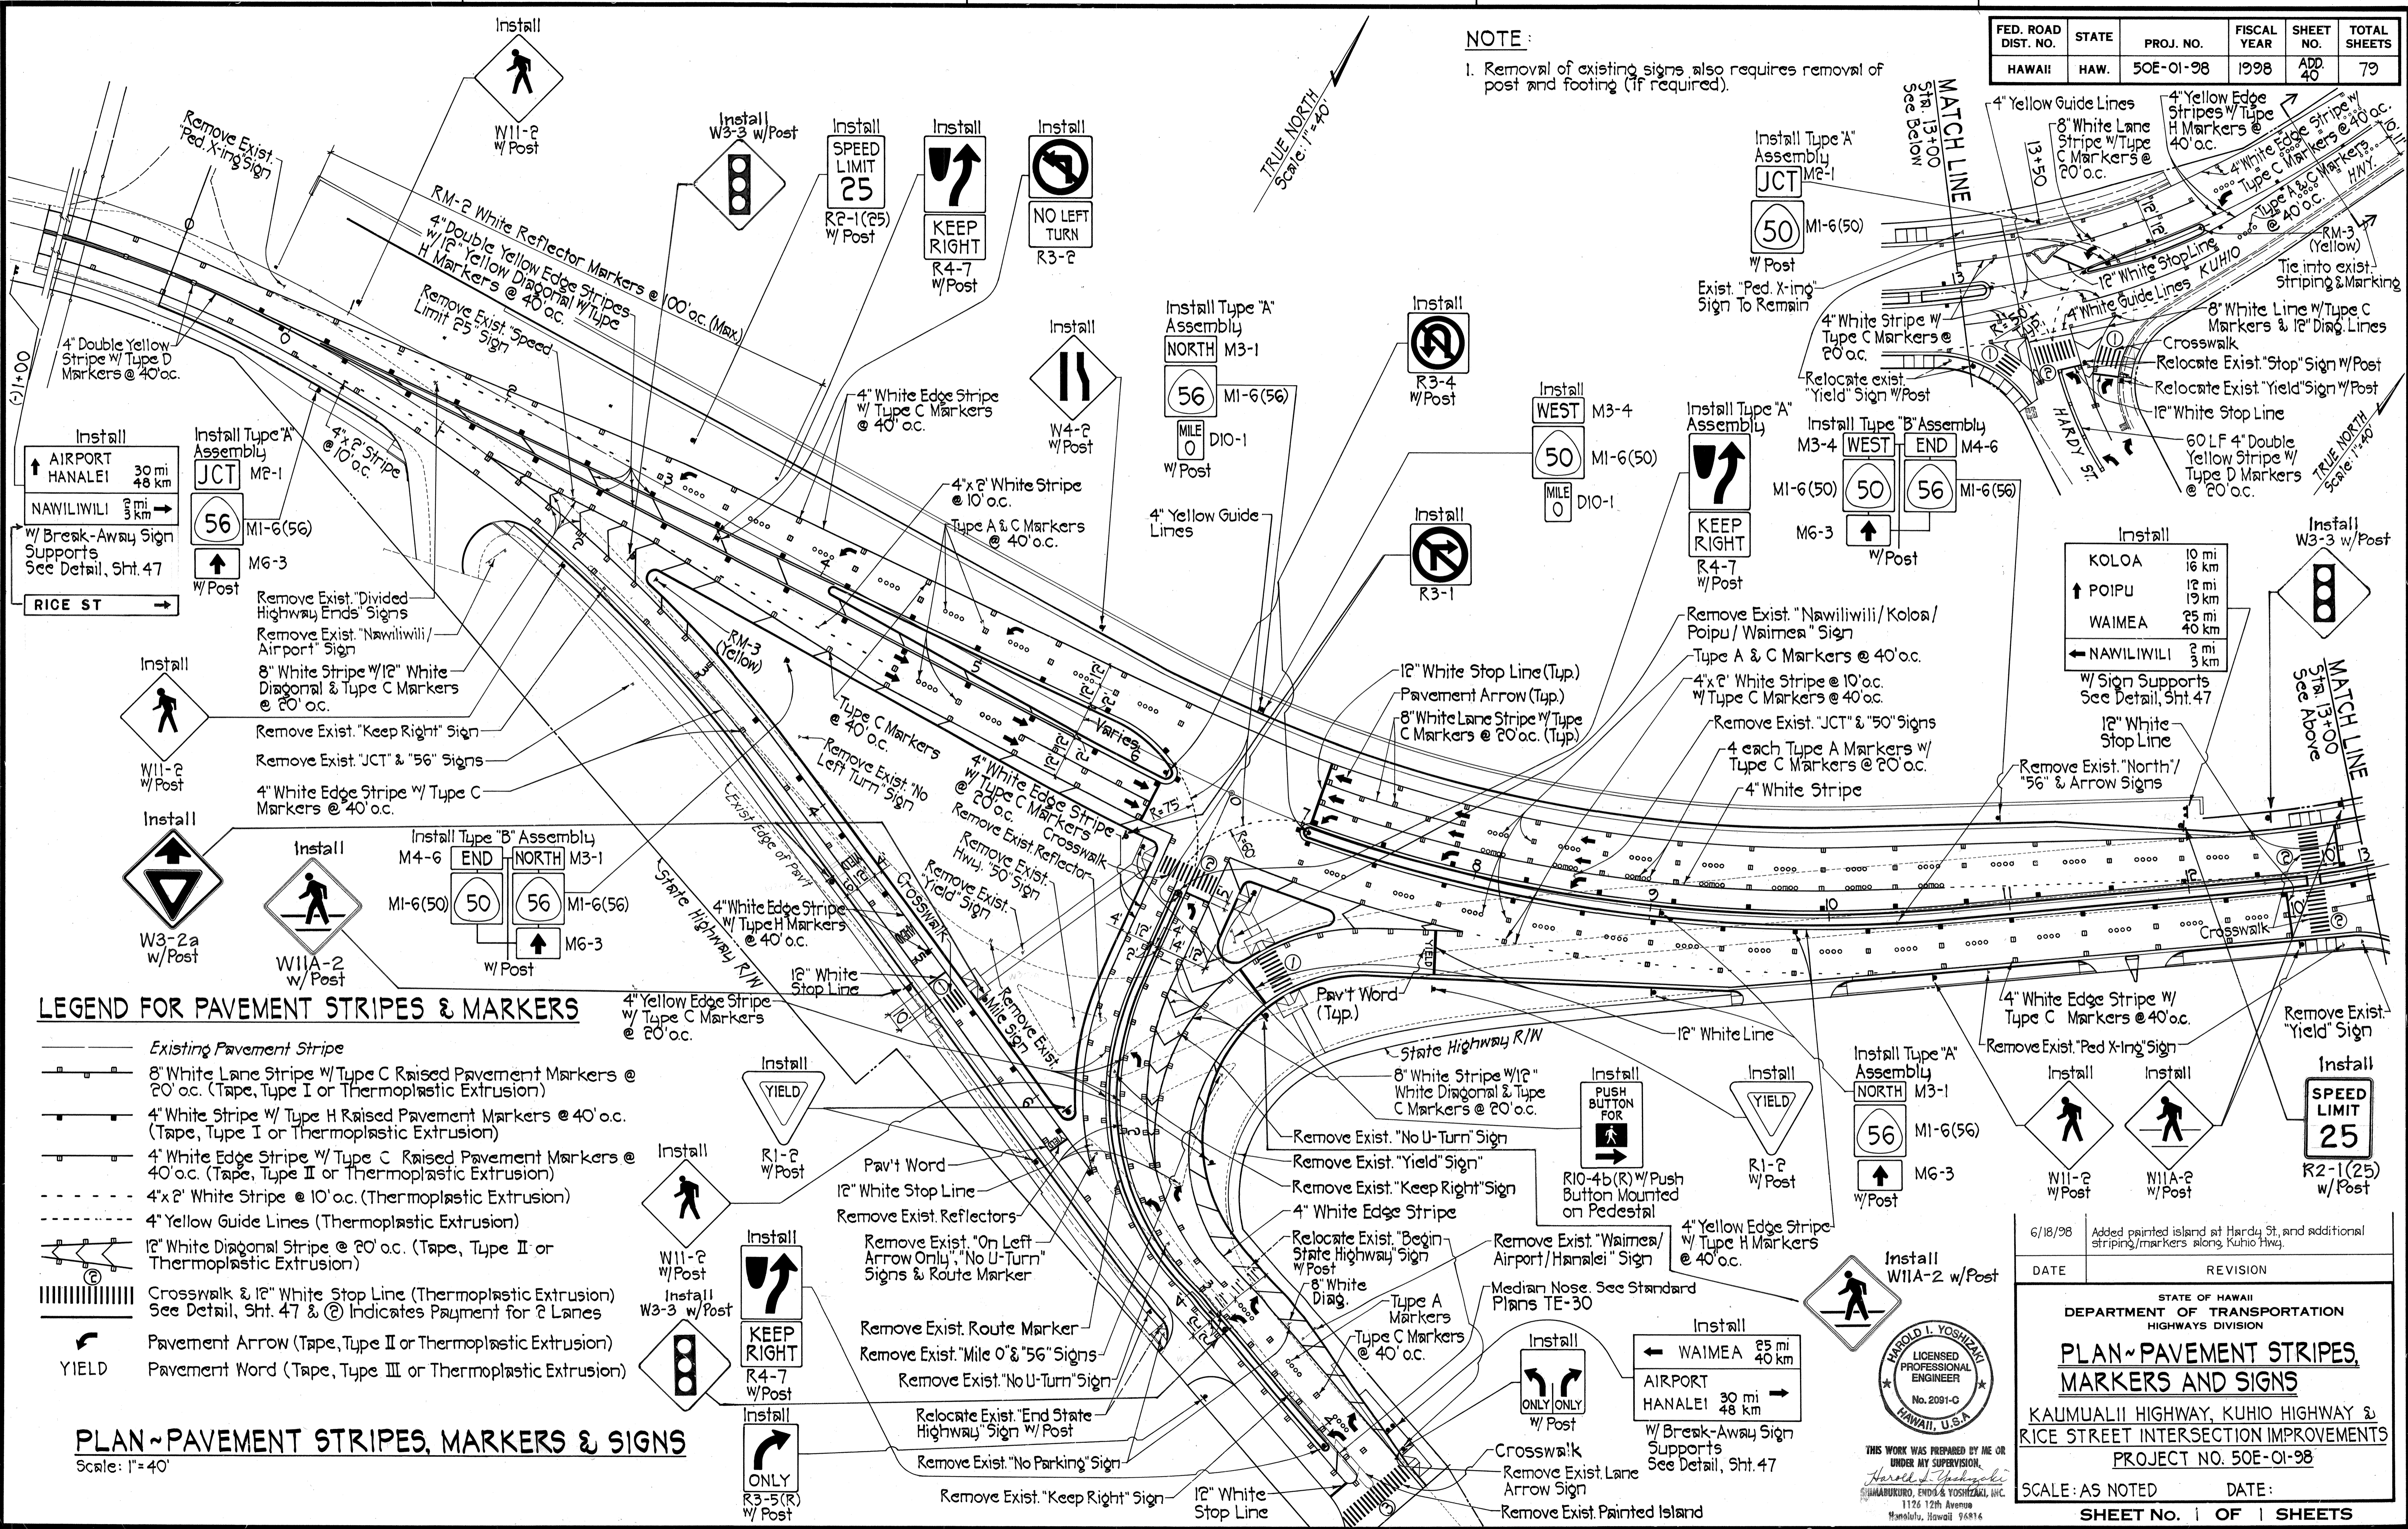

**LEGEND FOR PAVEMENT STRIPES & MARKERS**

- Existing Pavement Stripe
- 8" White Lane Stripe w/ Type C Raised Pavement Markers @ 20' o.c. (Tape, Type I or Thermoplastic Extrusion)
- 4" White Stripe w/ Type H Raised Pavement Markers @ 40' o.c. (Tape, Type I or Thermoplastic Extrusion)
- 4" White Edge Stripe w/ Type C Raised Pavement Markers @ 40' o.c. (Tape, Type II or Thermoplastic Extrusion)
- 4"x2" White Stripe @ 10' o.c. (Thermoplastic Extrusion)
- 4" Yellow Guide Lines (Thermoplastic Extrusion)
- 12" White Diagonal Stripe @ 20' o.c. (Tape, Type II or Thermoplastic Extrusion)
- Crosswalk & 12" White Stop Line (Thermoplastic Extrusion) See Detail, Sht. 47 & (C) Indicates Payment for 2 Lanes
- Pavement Arrow (Tape, Type II or Thermoplastic Extrusion)
- YIELD Pavement Word (Tape, Type III or Thermoplastic Extrusion)

**PLAN ~ PAVEMENT STRIPES, MARKERS & SIGNS**  
Scale: 1" = 40'


DATE	REVISION
6/18/98	Added painted island at Hardy St., and additional striping/markers along Kūhiō Hwy.

STATE OF HAWAII  
DEPARTMENT OF TRANSPORTATION  
HIGHWAYS DIVISION

**PLAN ~ PAVEMENT STRIPES, MARKERS AND SIGNS**

KALANIANAʻŌHALE HIGHWAY, KŪHIŌ HIGHWAY & RICE STREET INTERSECTION IMPROVEMENTS  
PROJECT NO. 50E-01-98

SCALE: AS NOTED DATE: \_\_\_\_\_  
SHEET NO. 1 OF 1 SHEETS

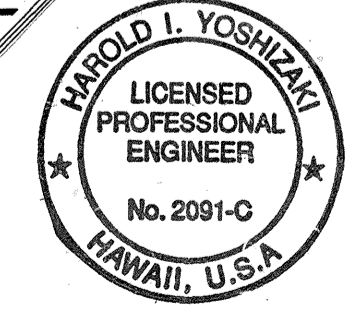

THIS WORK WAS PREPARED BY ME OR UNDER MY SUPERVISION  
Harold I. Yoshizaki  
SHIMABURU, ENDO & YOSHIKAWA, INC.  
1126 12th Avenue  
Honolulu, Hawaii 96814

DATE	_____
SURVEY PLOTTED BY	_____
DRAWN BY	_____
DESIGNED BY	_____
QUANTITIES BY	_____
CHECKED BY	_____
NOTE BOOK	_____
NO.	_____