



FED. ROAD DIST. NO.	STATE	PROJ. NO.	FISCAL YEAR	SHEET NO.	TOTAL SHEETS
HAWAII	HAW.	50E-01-98	1998	25	79

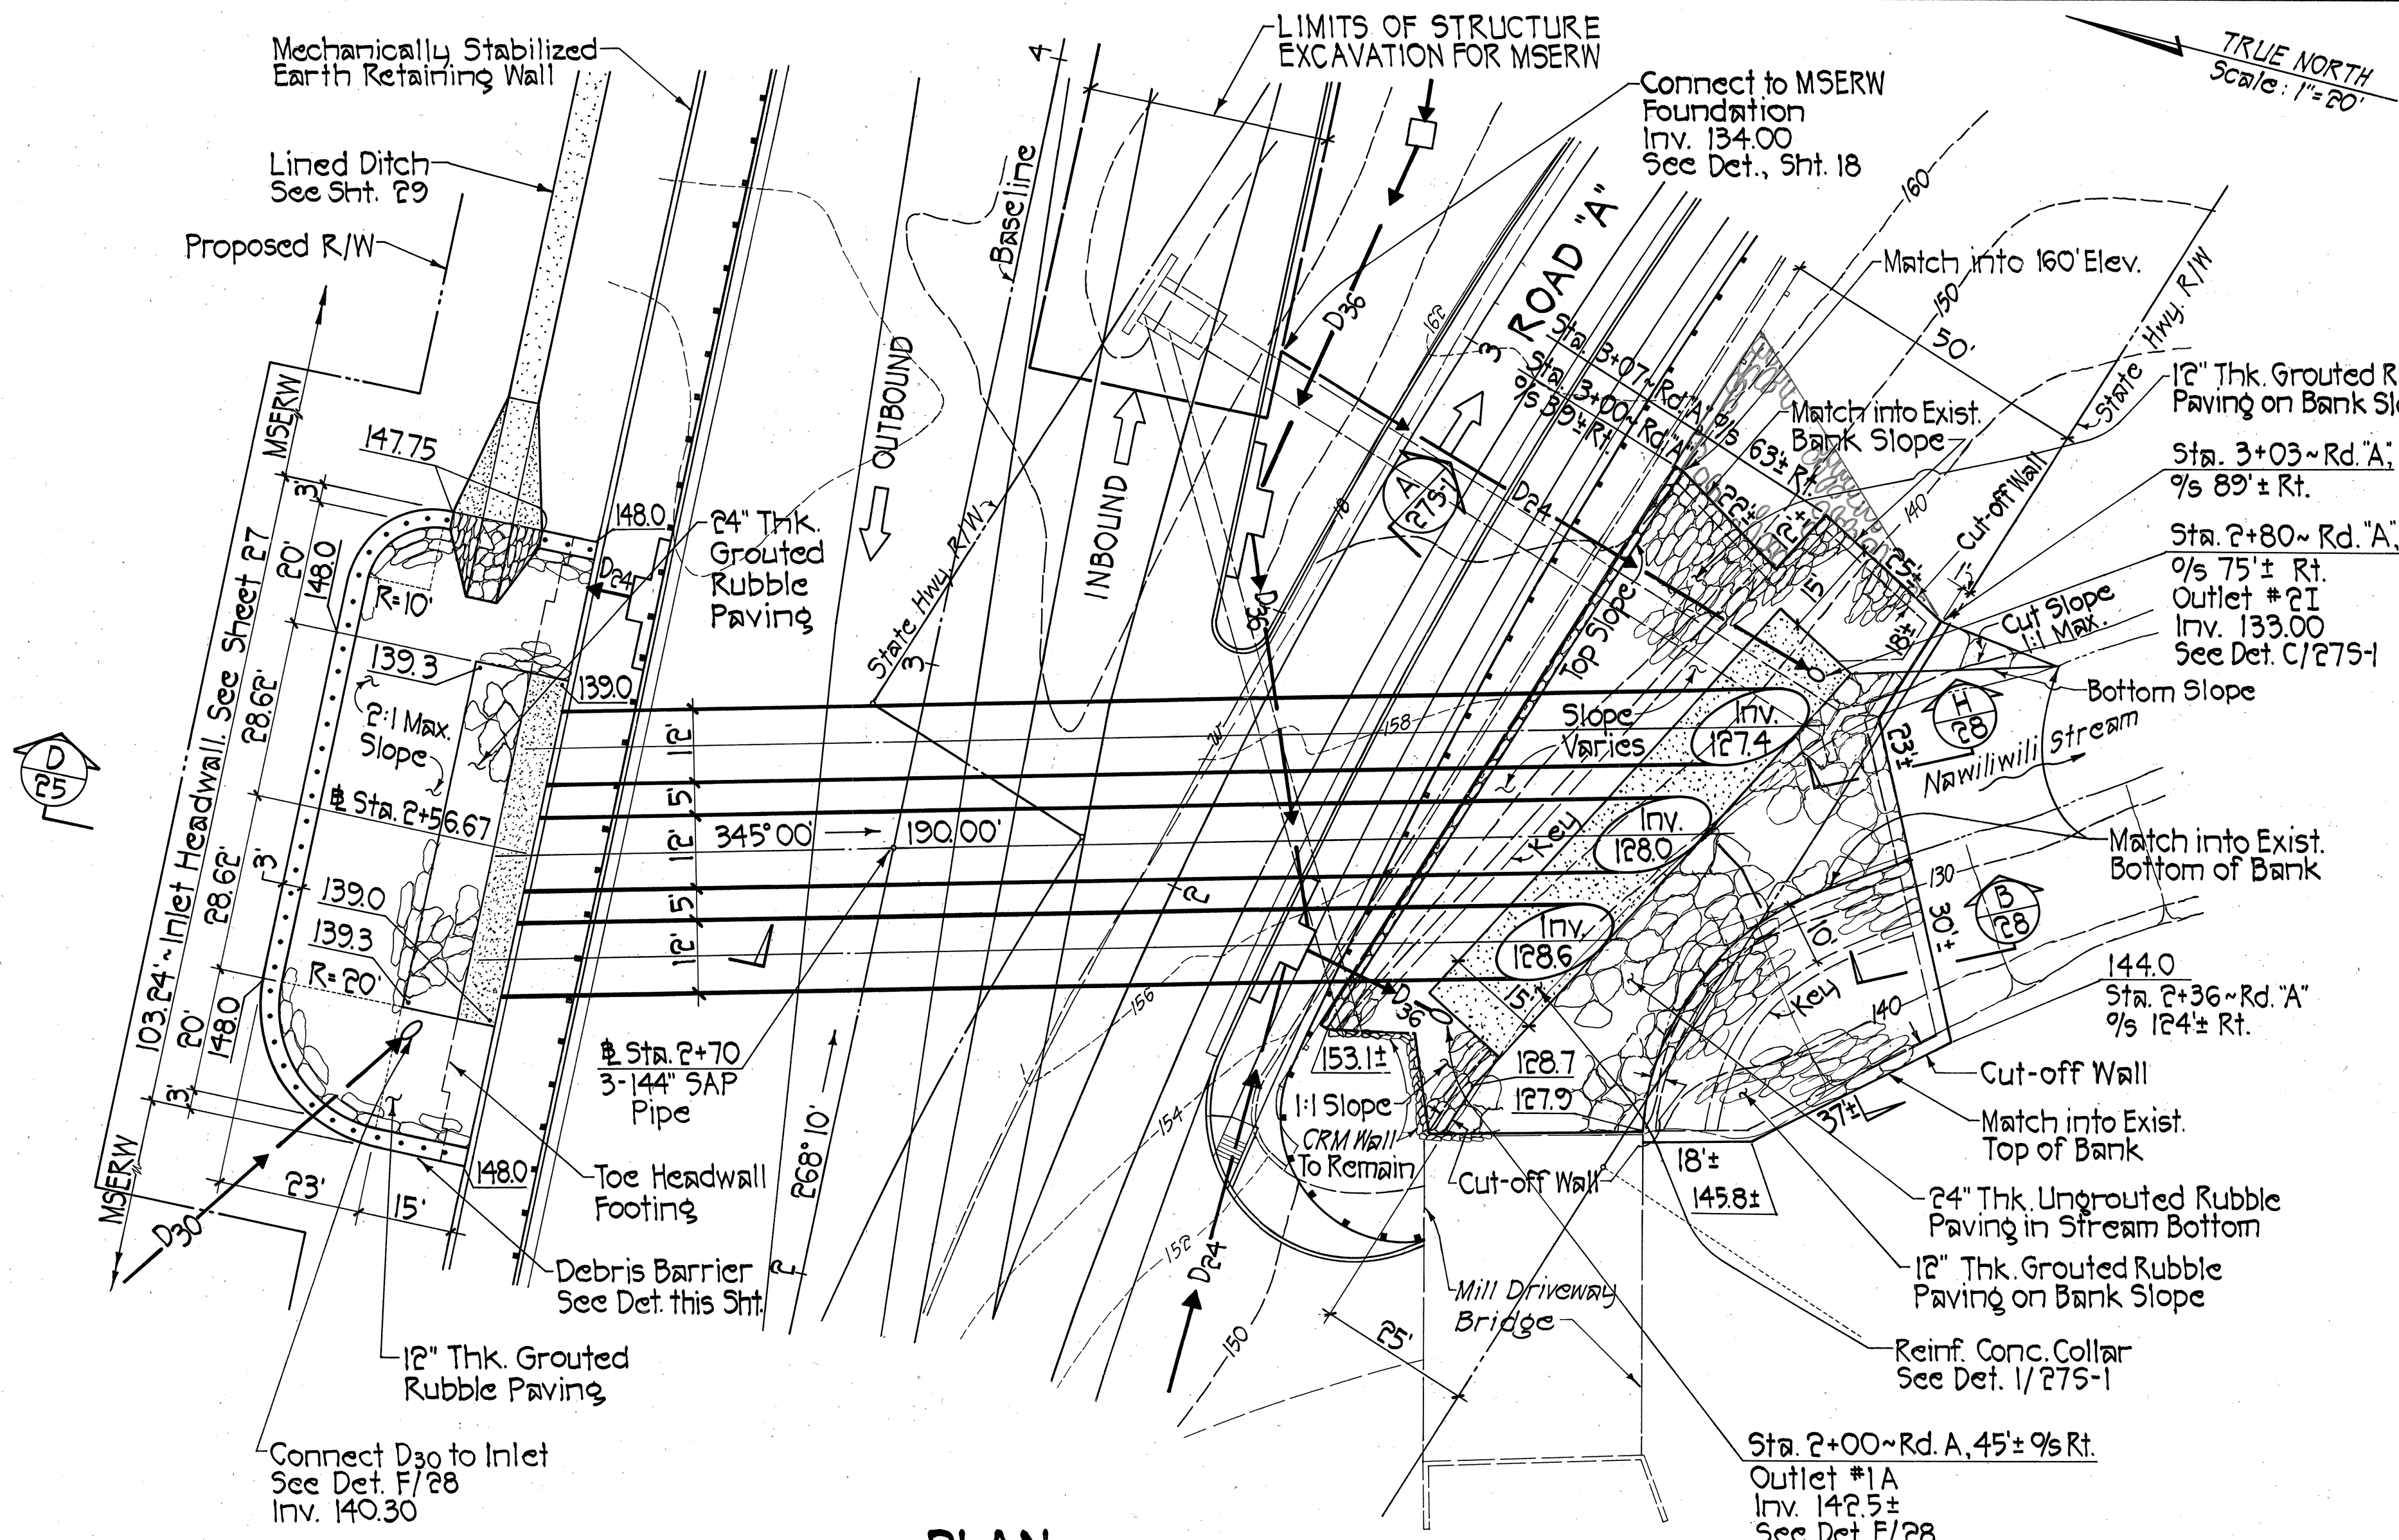


PLAN
Scale: 1"=20'

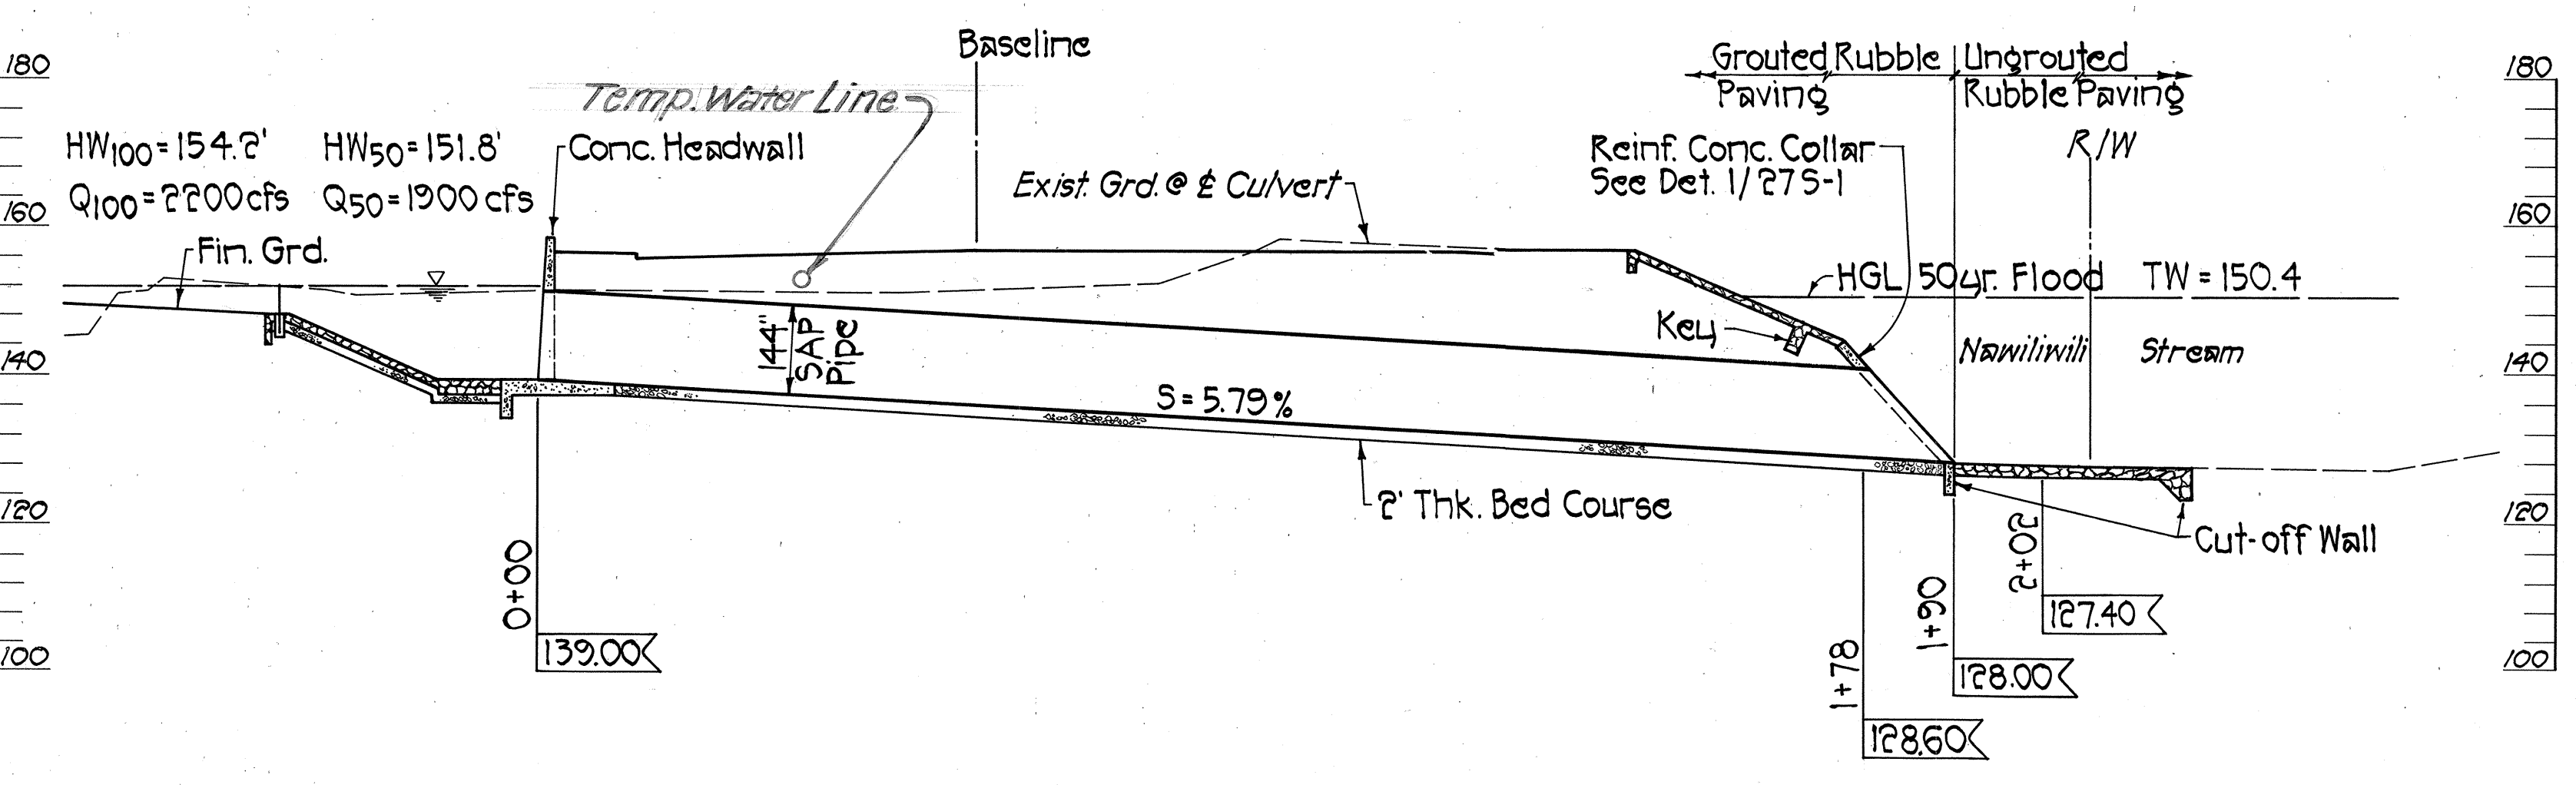


PROFILE~STA. 2+70
Scale: Horiz. 1"=20'
Vert. 1"=20'

THREE (3)-144" STRUCTURAL ALUMINUM PLATE PIPE

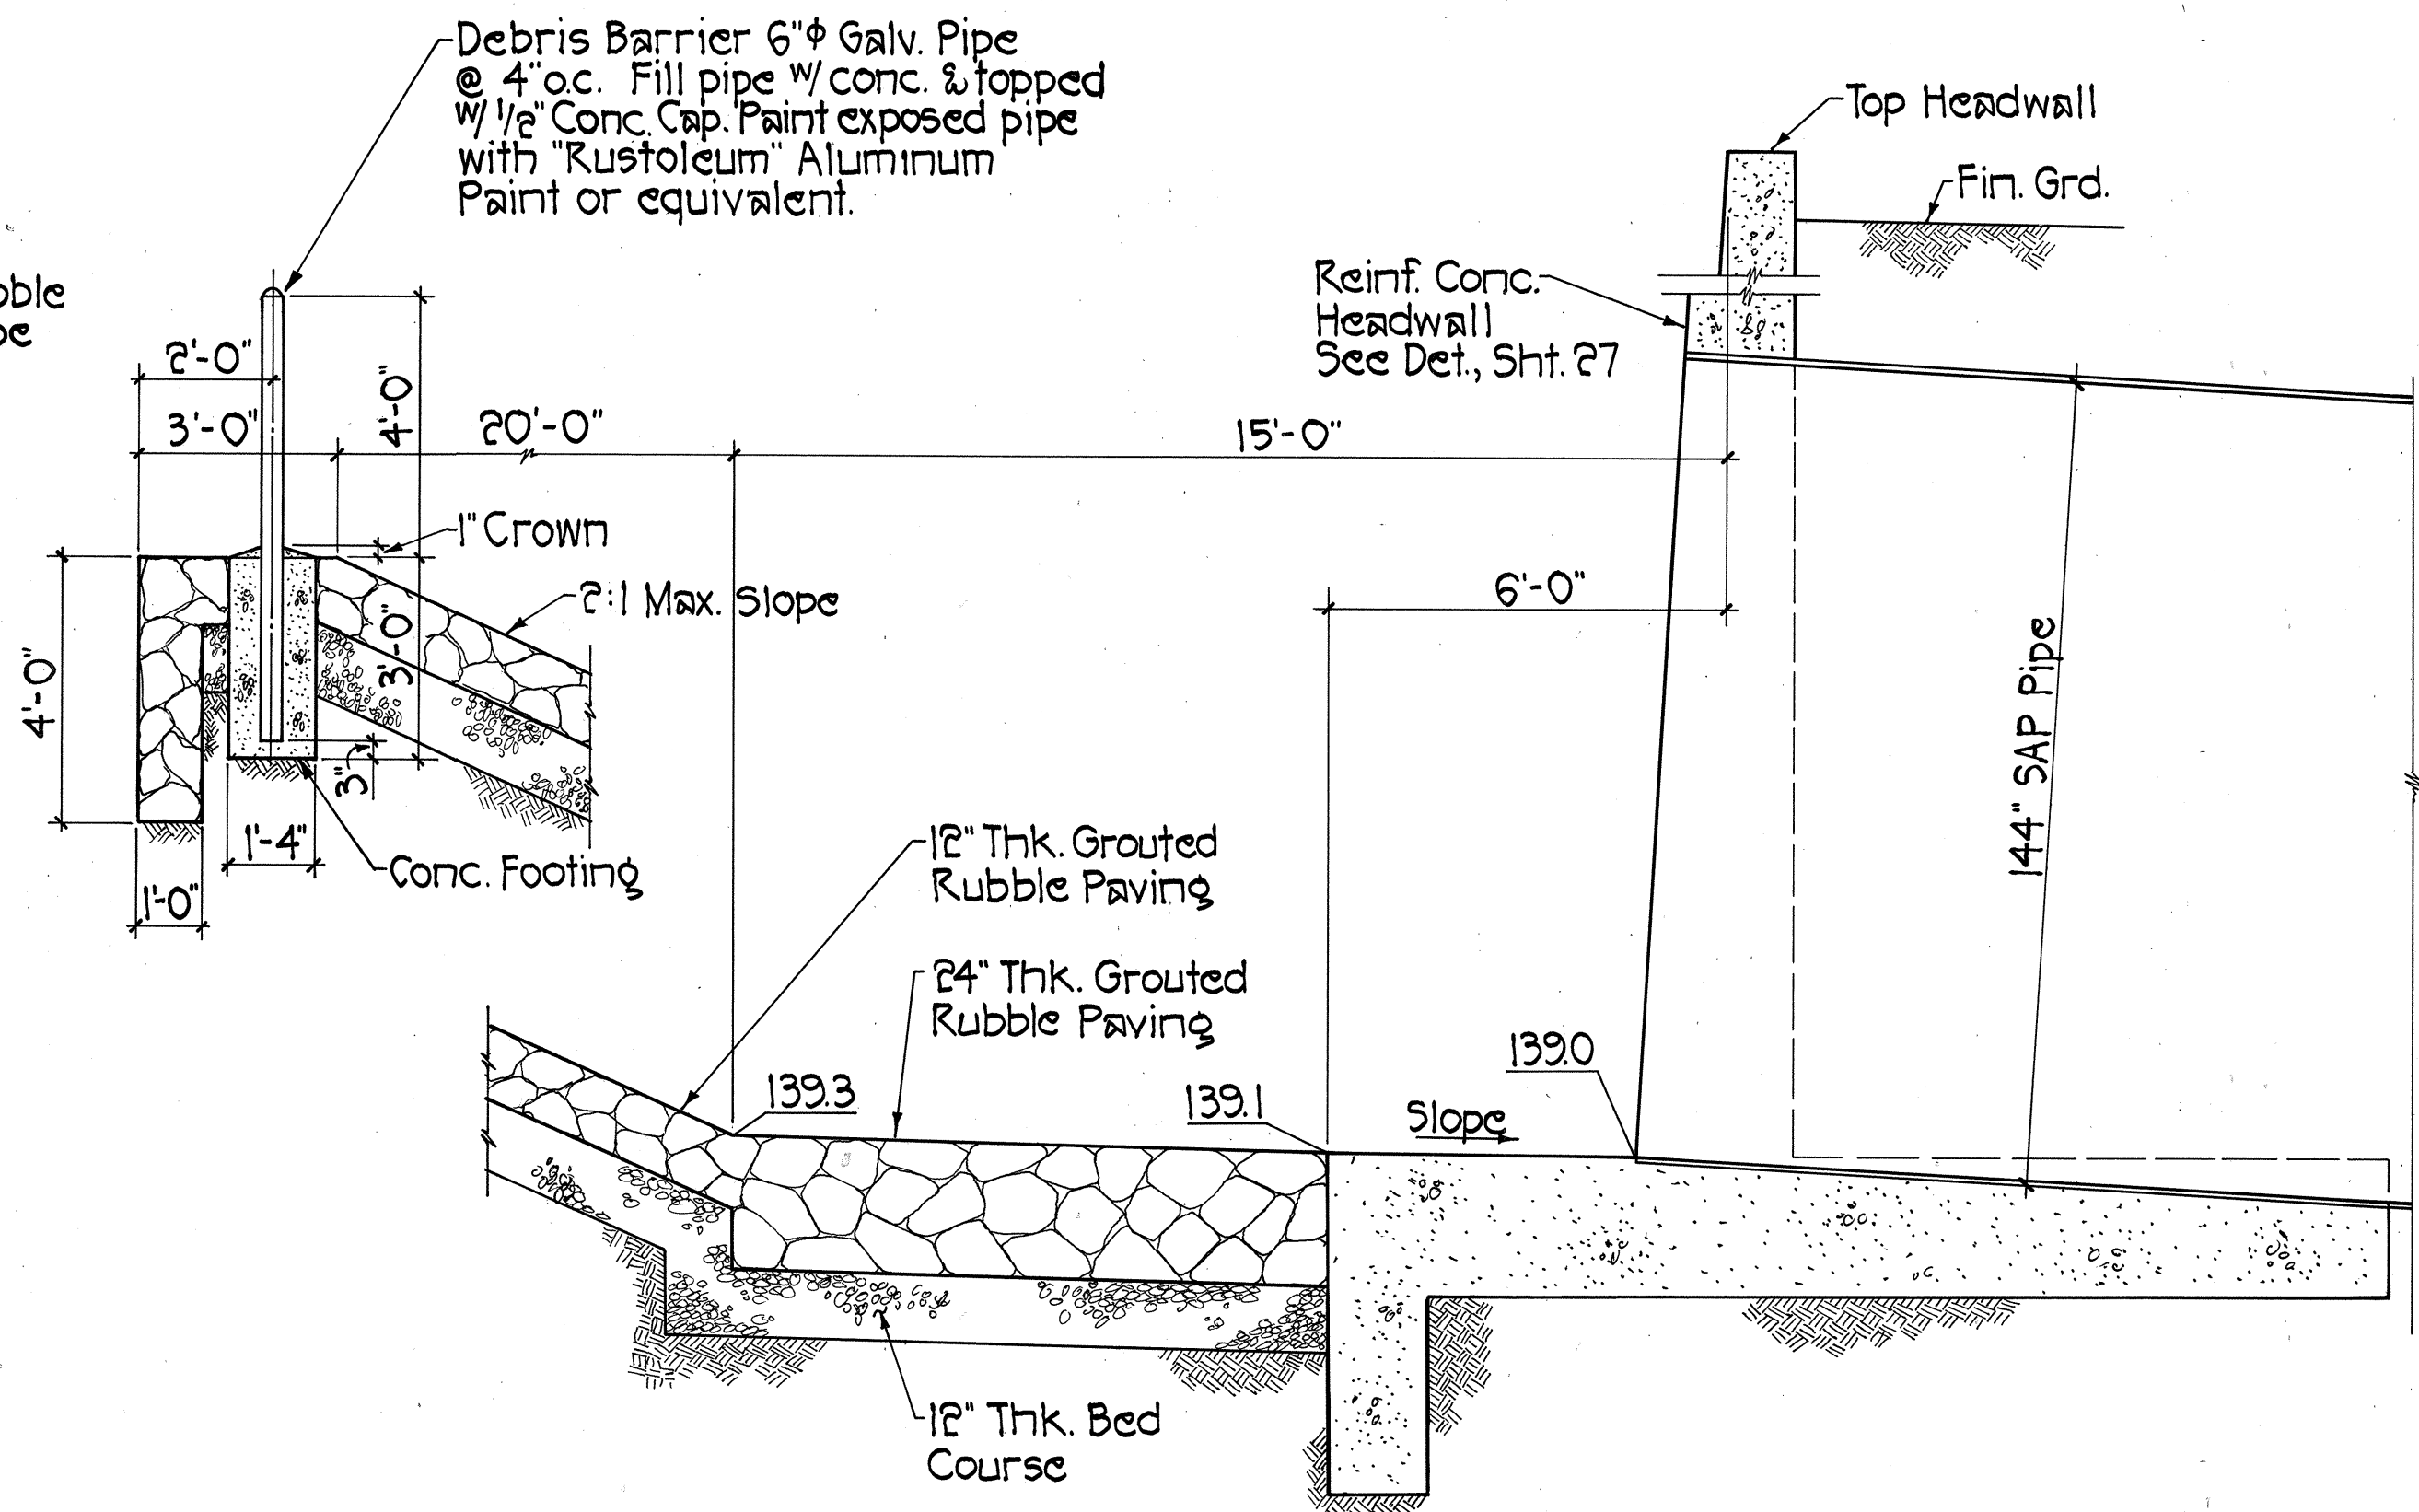


SECTION~INLET D
Scale: 3/8"=1'-0"

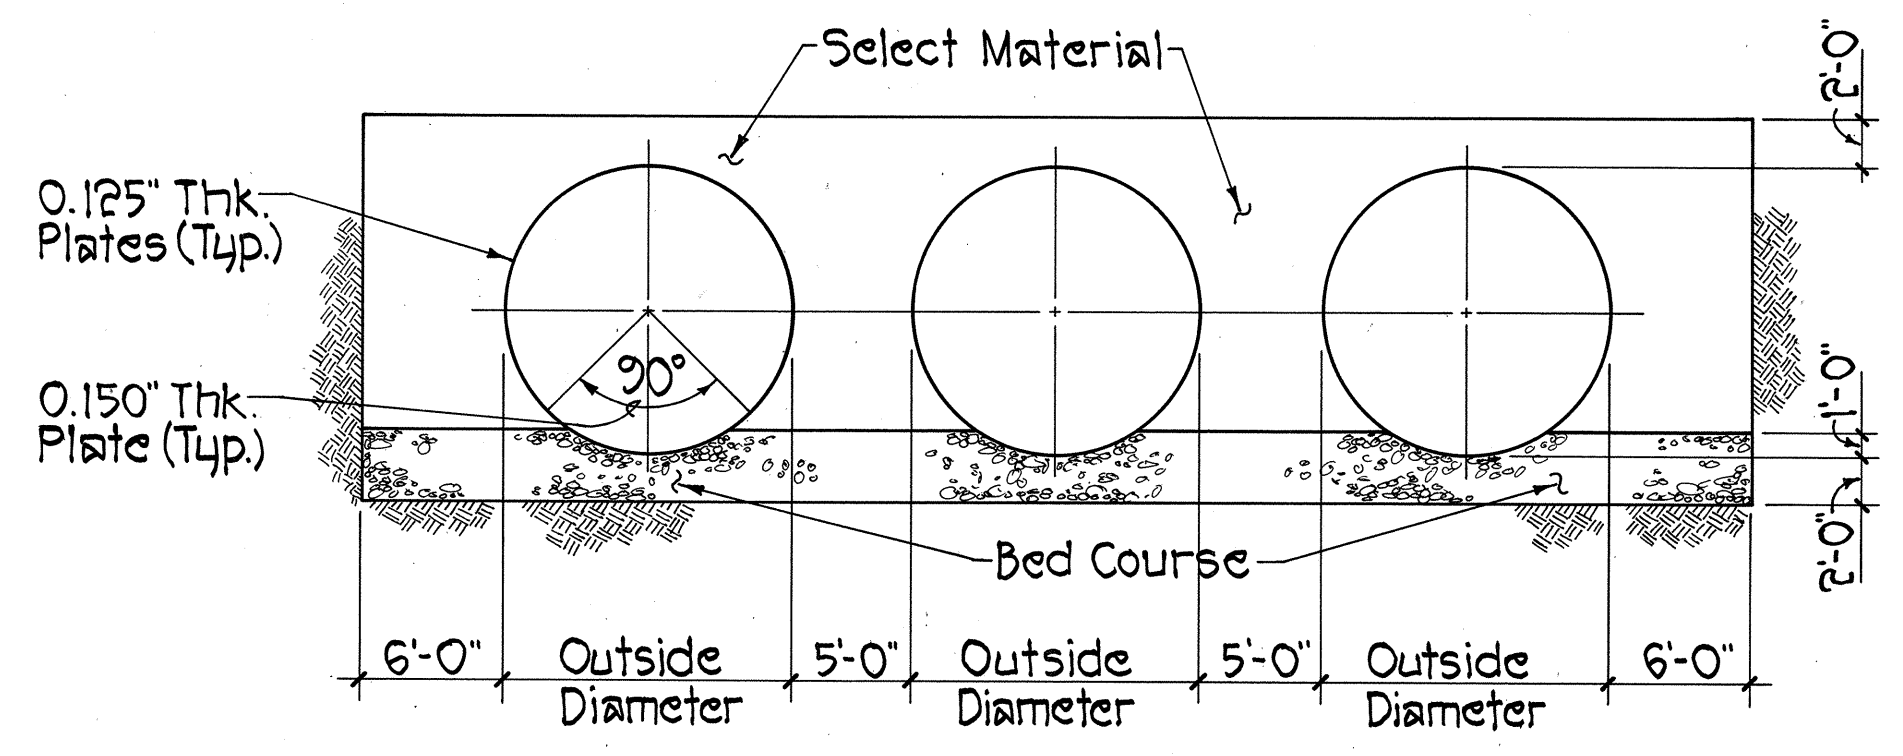

TYP. SECTION~THREE(3) 144" SAP PIPE
Scale: 1/8"=1'-0"

SURVEY PLOTTED BY	DATE
DRAWN BY	
DESIGNED BY	
CHECKED BY	
NO.	

10/12/98	Revised outlet for 3 barrel 144" SAP Culverts to add concrete collar around pipe.
DATE	REVISION

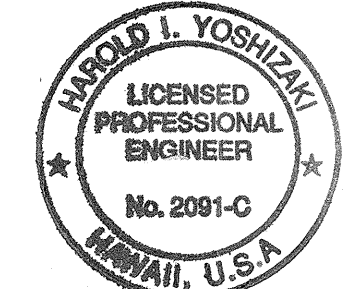

THIS WORK WAS PREPARED BY ME OR UNDER MY SUPERVISION.
Harold L. Yoshizaki
SHIMADZU ENGINEERING, INC.
1126 12th Avenue
Honolulu, Hawaii 96816

STATE OF HAWAII
DEPARTMENT OF TRANSPORTATION
HIGHWAYS DIVISION
3-144" STRUCTURAL ALUMINUM PLATE PIPE~STA. 2+70
KAUAI HALL HIGHWAY, KUHIO HIGHWAY & RICE STREET INTERSECTION IMPROVEMENTS
PROJECT NO. 50E-01-98
SCALE: AS NOTED DATE:
SHEET No. 1 OF 1 SHEETS

"AS-BUILT"