



DIST. NO.	STATE	PROJ. NO.	FISCAL YEAR	SHEET NO.	TOTAL SHEETS
HAWAII	HAW.	50D-01-98	1999	ADD.4	21

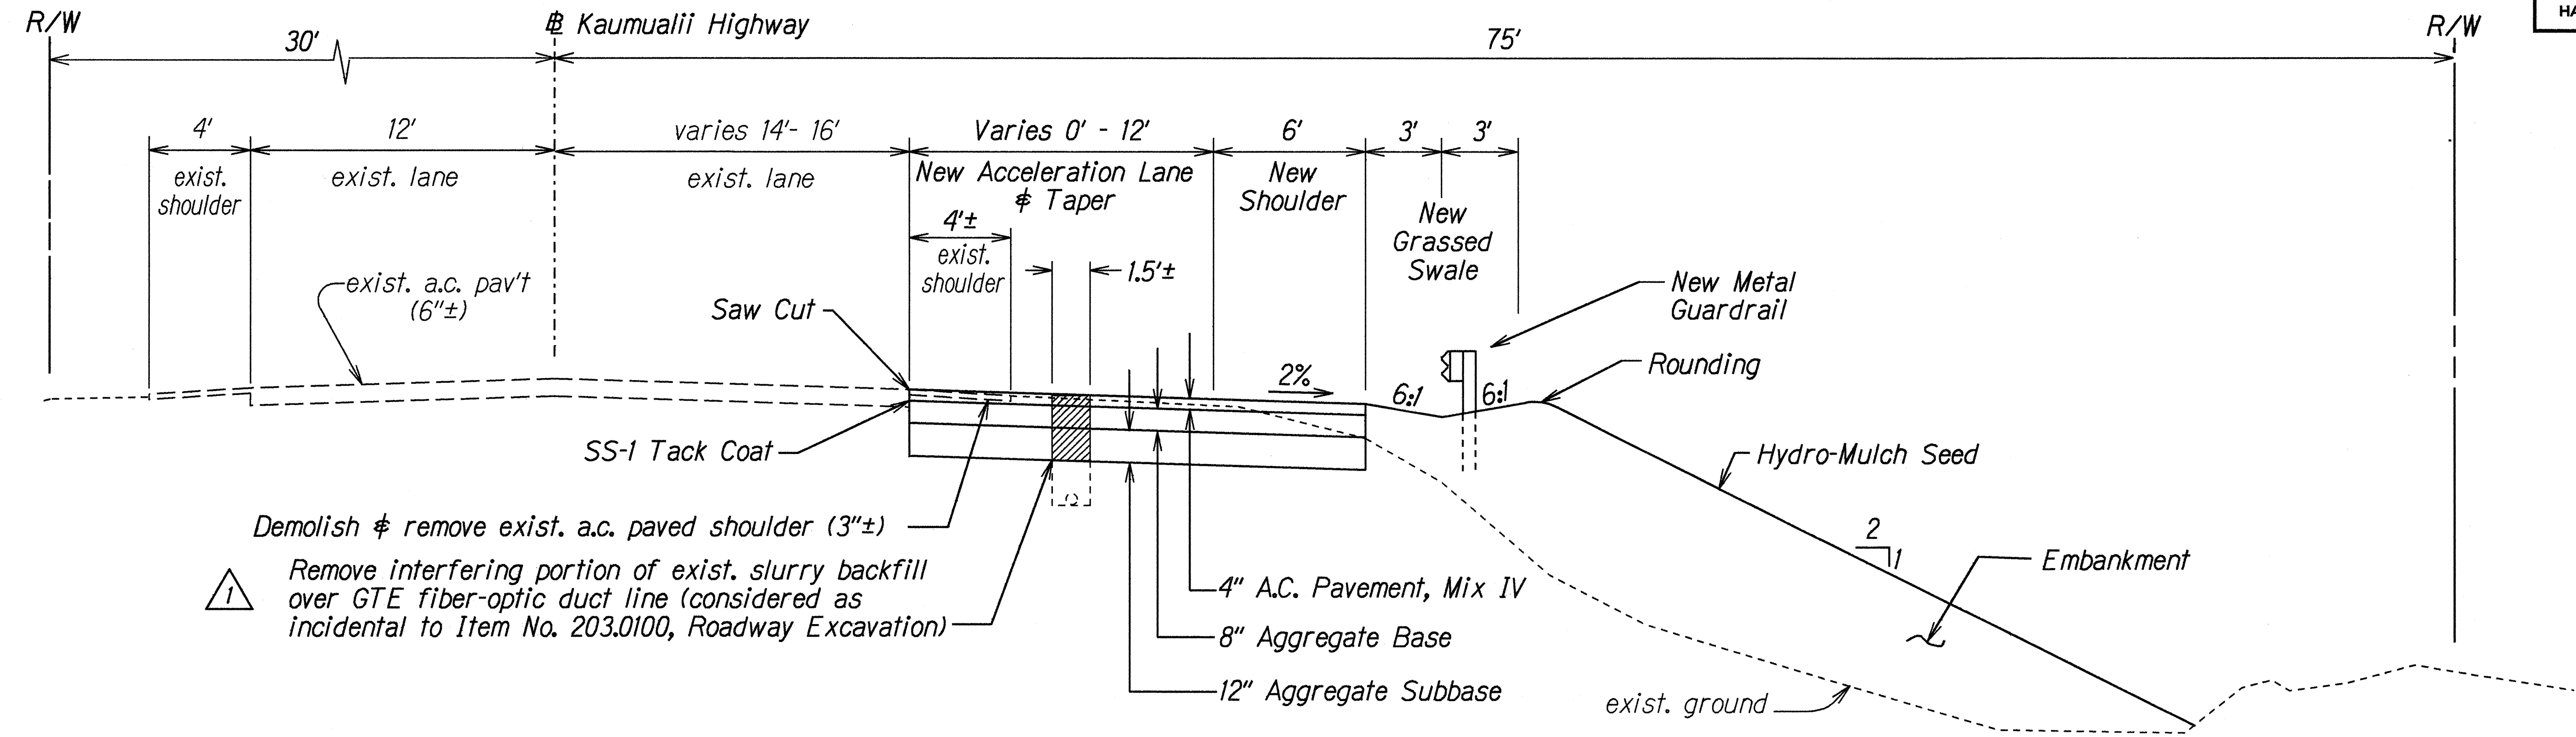

TYPICAL FILL SECTION
(# Sta. 275+00 To # Sta. 279+95)

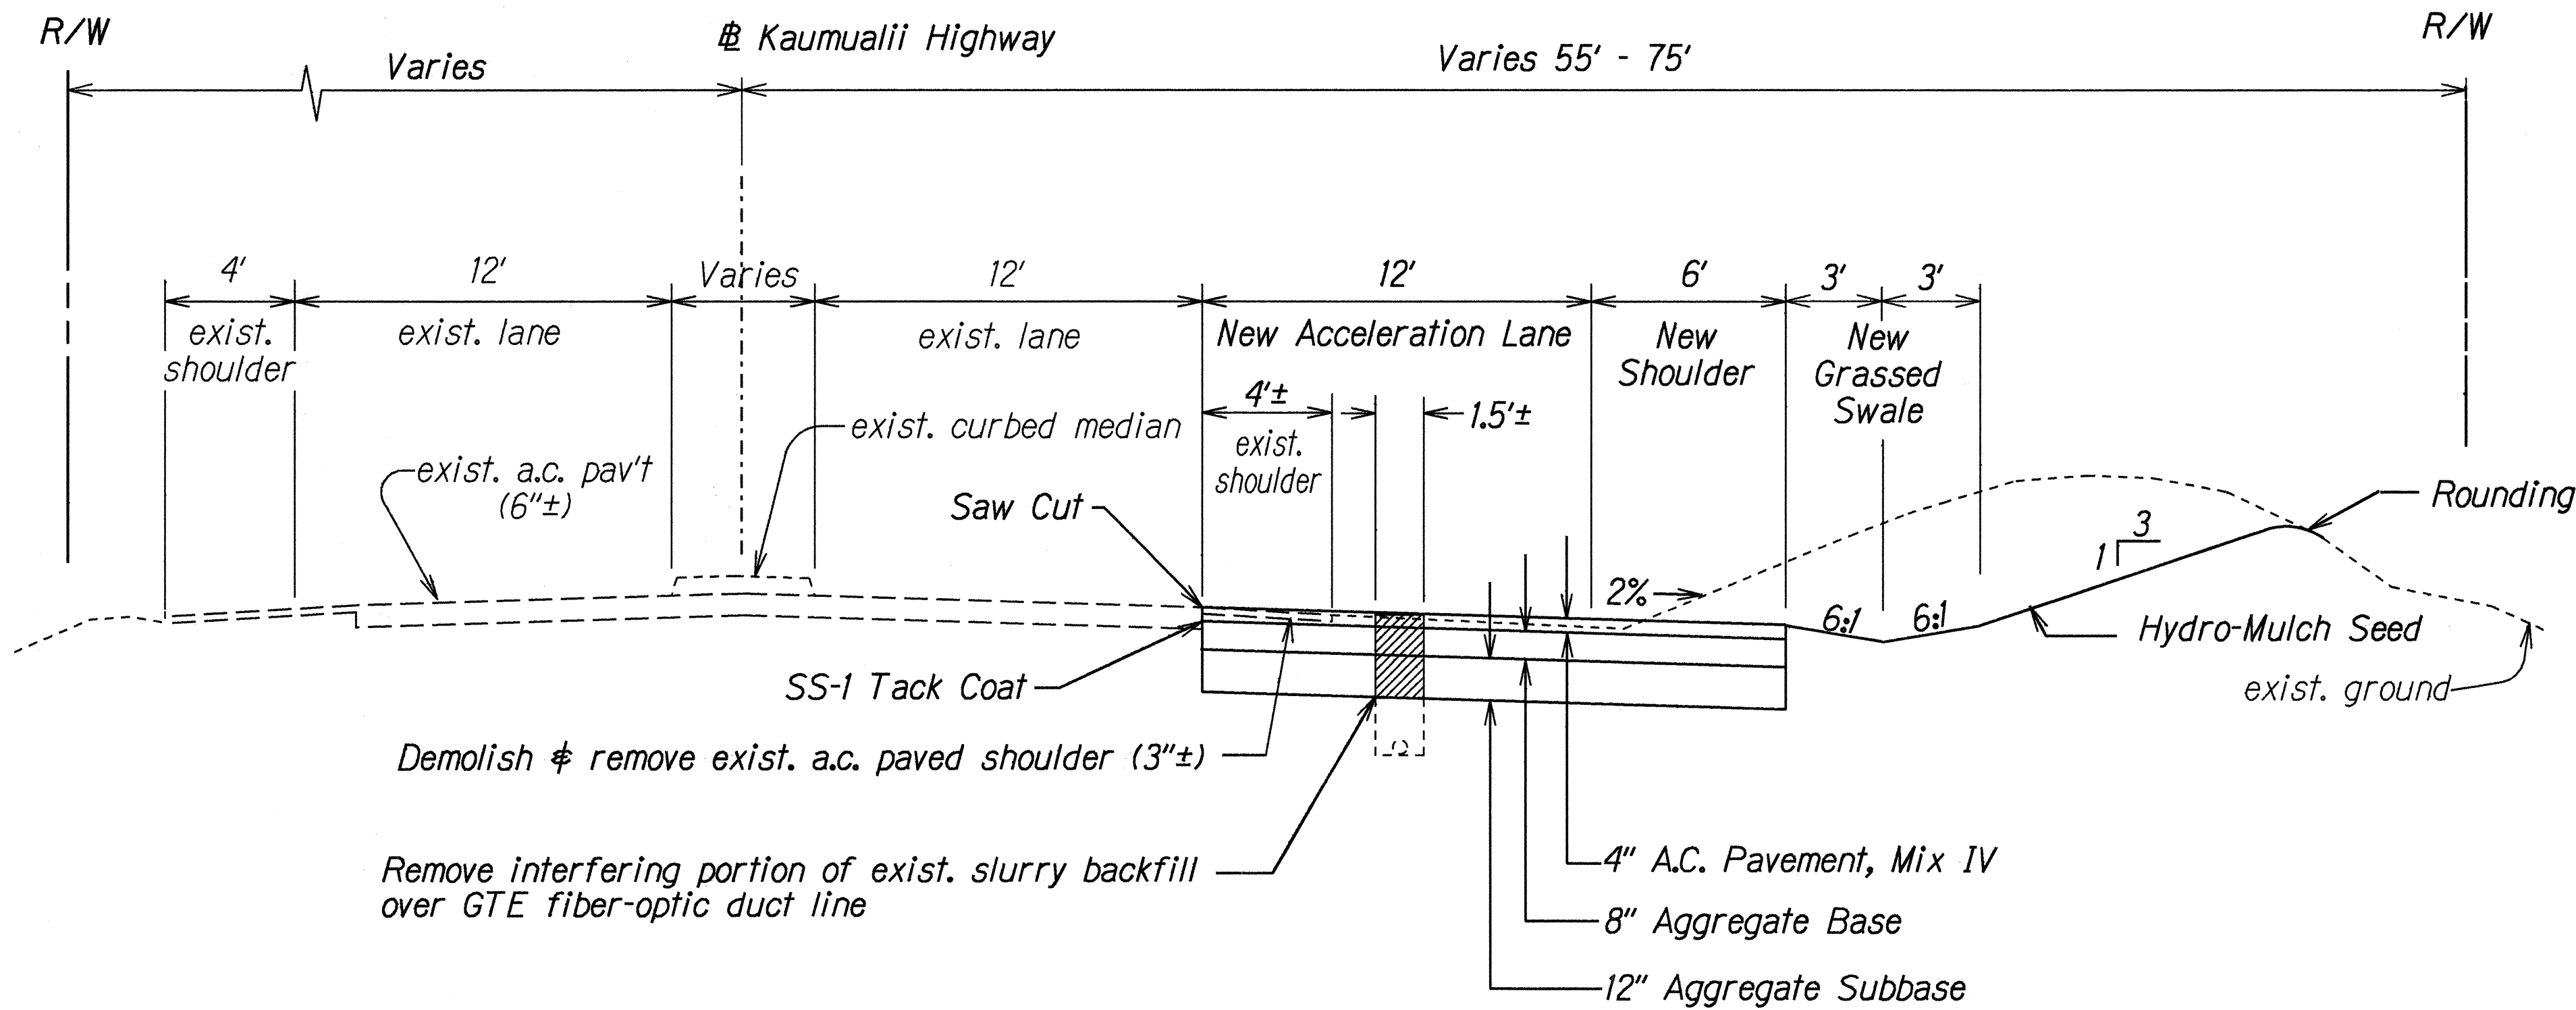


TYPICAL CUT SECTION
(# Sta. 268+42 To # Sta. 275+00)


SURVEY PLOTTED BY	DATE
DRAWN BY E. Reyes	4-1-99
TRACED BY E. Reyes	
CHECKED BY E. Reyes	
QUANTITIES BY	
CHECKED BY	
ORIGINAL PLAN	
NOTE BOOK	
Rel. Fred	
4/20/2001	

5-25-99	Revised description of slurry removal item.
DATE	REVISION
STATE OF HAWAII DEPARTMENT OF TRANSPORTATION HIGHWAYS DIVISION TYPICAL SECTIONS KAUMUALII HIGHWAY ACCELERATION LANE AT MALUHIA ROAD Project No. 50D-01-98 Scale: 1/4"=1' Date: April 1, 1999 SHEET No. 1 OF 2 SHEETS	

DIST. NO.	STATE	PROJ. NO.	FISCAL YEAR	SHEET NO.	TOTAL SHEETS
HAWAII	HAW.	50D-01-98	1999	ADD.5	21

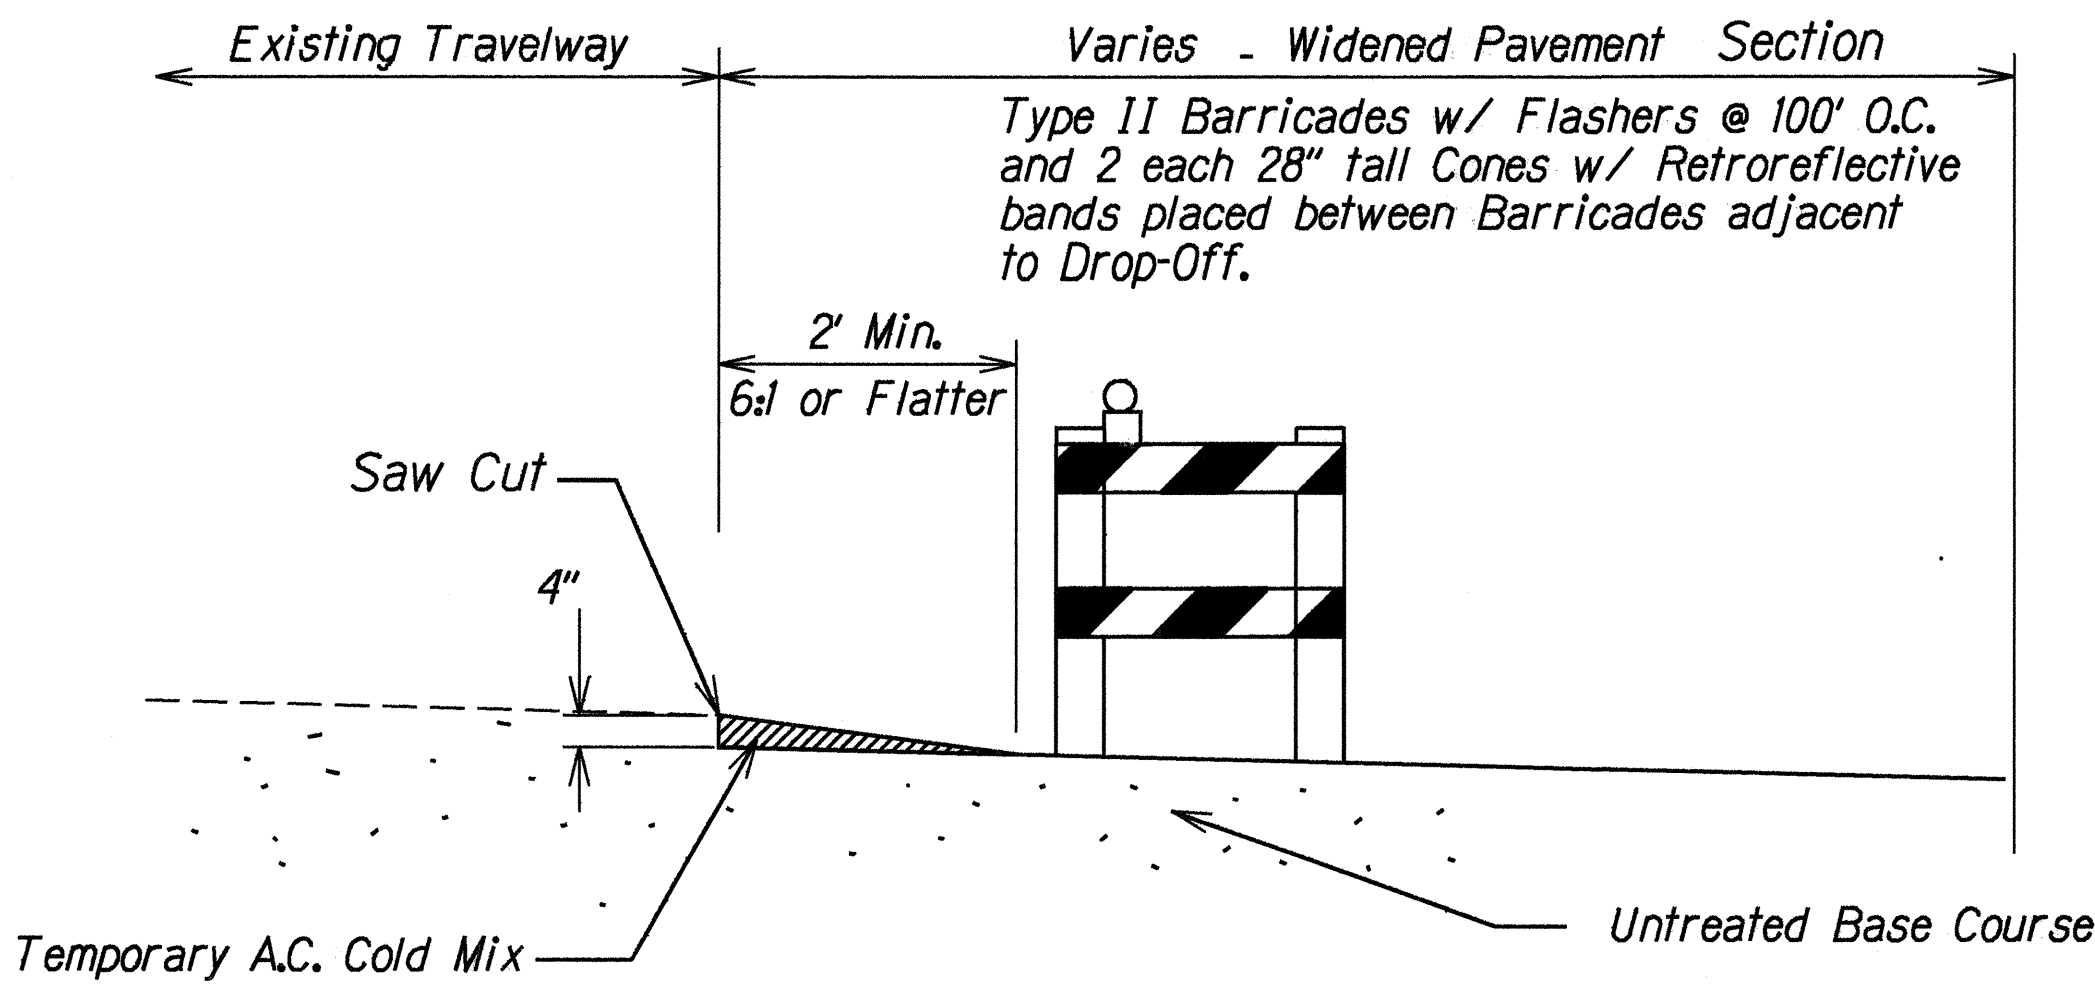

PAVEMENT DROP-OFF DETAIL
Not to Scale

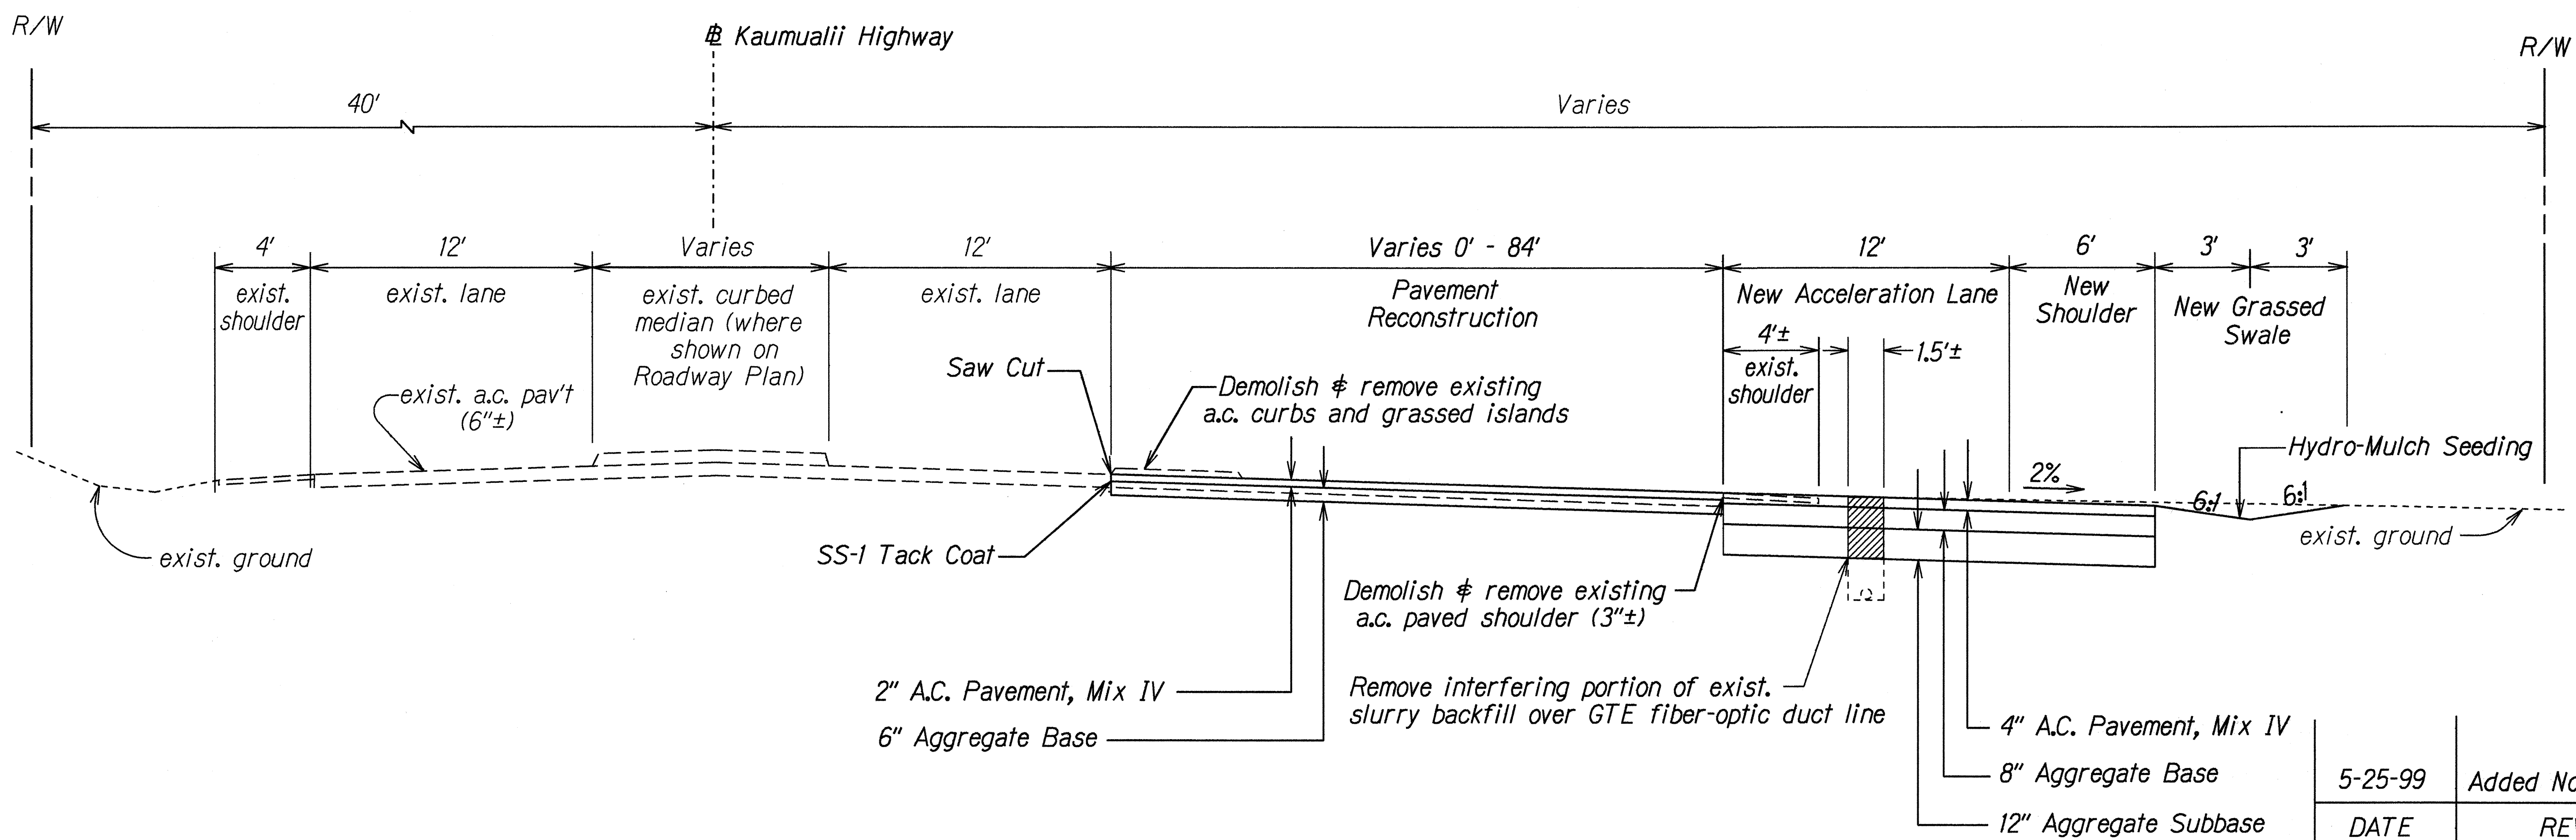

TYPICAL FILL SECTION
(Maluhia Sta. 2+06 To # Sta. 268+42)

NOTE:
Excavation for Pavement Reconstruction shall be measured and paid for as Item No. 203.0100, Roadway Excavation.

5-25-99	Added Note.
DATE	REVISION
STATE OF HAWAII DEPARTMENT OF TRANSPORTATION HIGHWAYS DIVISION TYPICAL SECTIONS KAUMUALII HIGHWAY ACCELERATION LANE AT MALUHIA ROAD Project No. 50D-01-98 Scale: 1/4" = 1' Date: April 1, 1999	
SHEET No. 2 OF 2 SHEETS	

SURVEY PLOTTED BY	DATE	4/99
DRAWN BY	F. Reyes	
CHECKED BY	F. Reyes	
NOTED BY	Noted	
QUANTITIES BY		
CHECKED BY		
ORIGINAL PLAN		