


FED. ROAD DIST. NO.	STATE	PROJ. NO.	FISCAL YEAR	SHEET NO.	TOTAL SHEETS
HAWAII	HAW.	STP-050-1(21)	1999	14	17

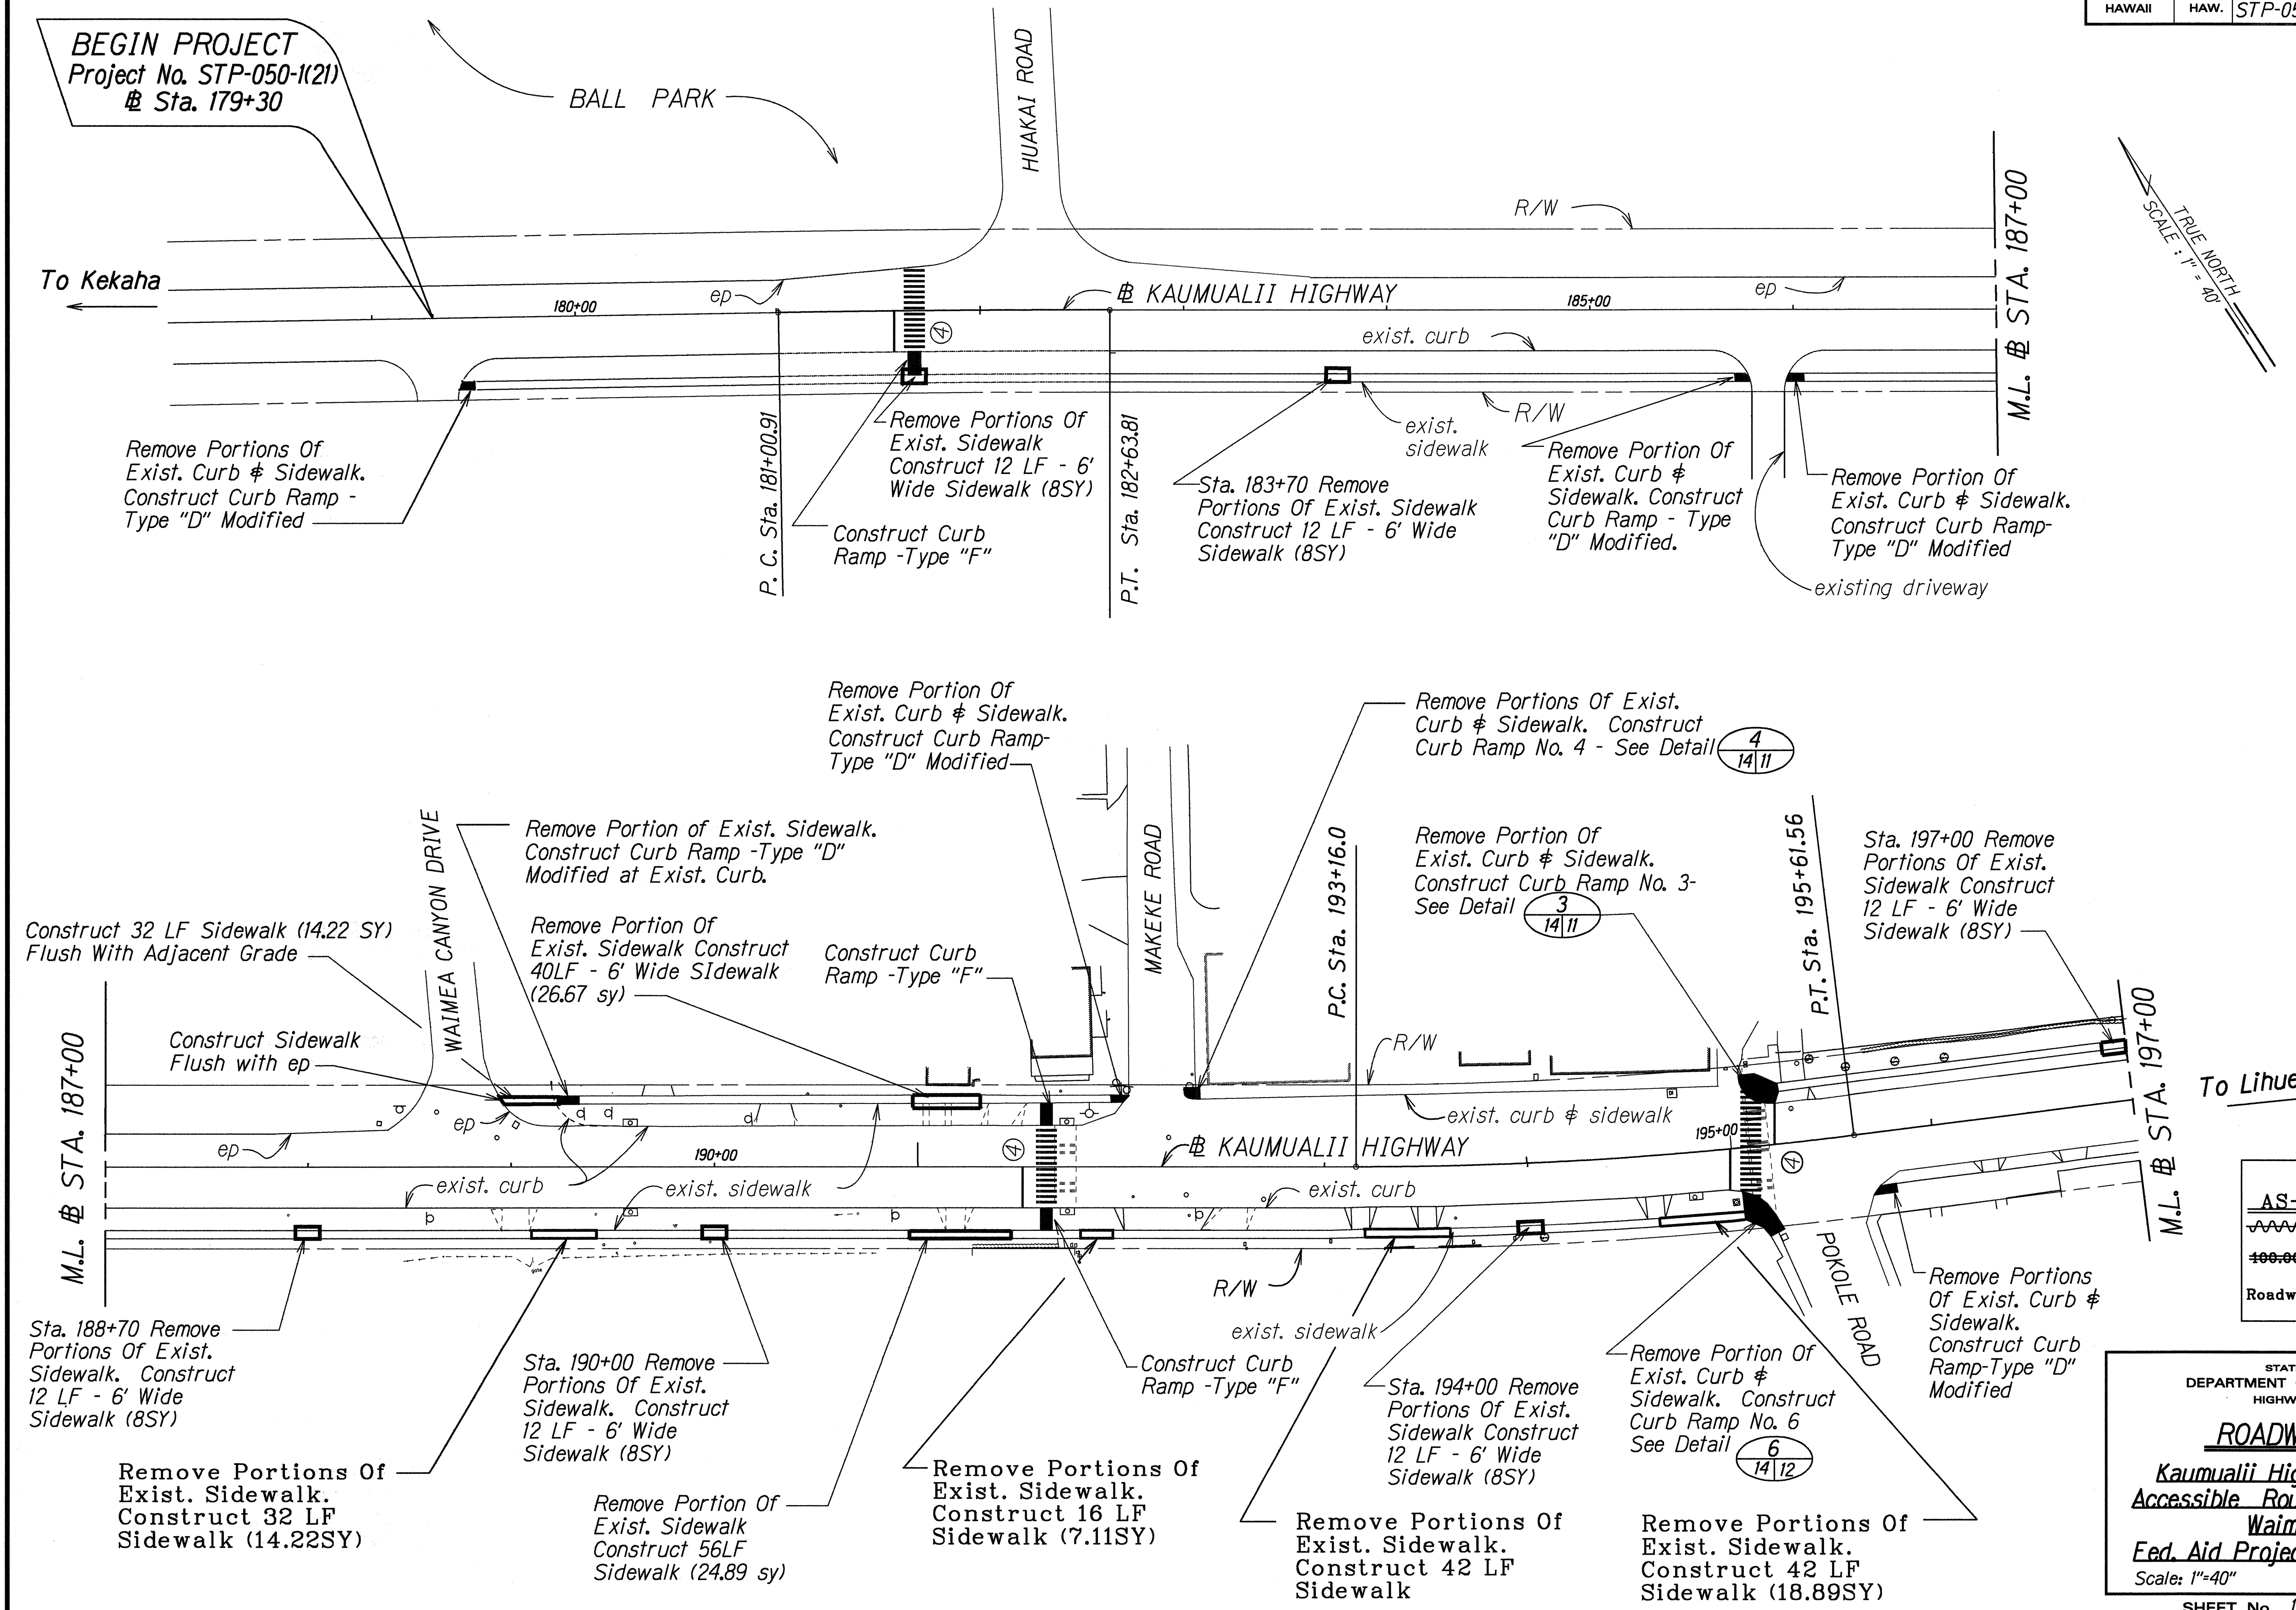

ORIGINAL PLAN	DATE: Tue Jun 2 1998
DRAWN BY: [Signature]	DESIGNED BY: [Signature]
CHECKED BY: [Signature]	NOTED BY: [Signature]


LEGEND FOR AS-BUILT POSTINGS	
	Squiggly line for as-built deletion
	Double line for as-built deletion
	Text for as-built posting

STATE OF HAWAII
DEPARTMENT OF TRANSPORTATION
HIGHWAYS DIVISION

ROADWAY PLAN
Kaumualii Highway Pedestrian Accessible Route Improvements, Waimea Town
Fed. Aid Project No. STP-050-1(21)
Scale: 1"=40" Date: June, 1998

SHEET No. 1 OF 2 SHEETS

FED. ROAD DIST. NO.	STATE	PROJ. NO.	FISCAL YEAR	SHEET NO.	TOTAL SHEETS
HAWAII	HAW.	STP-050-1(21)	1999	15	17

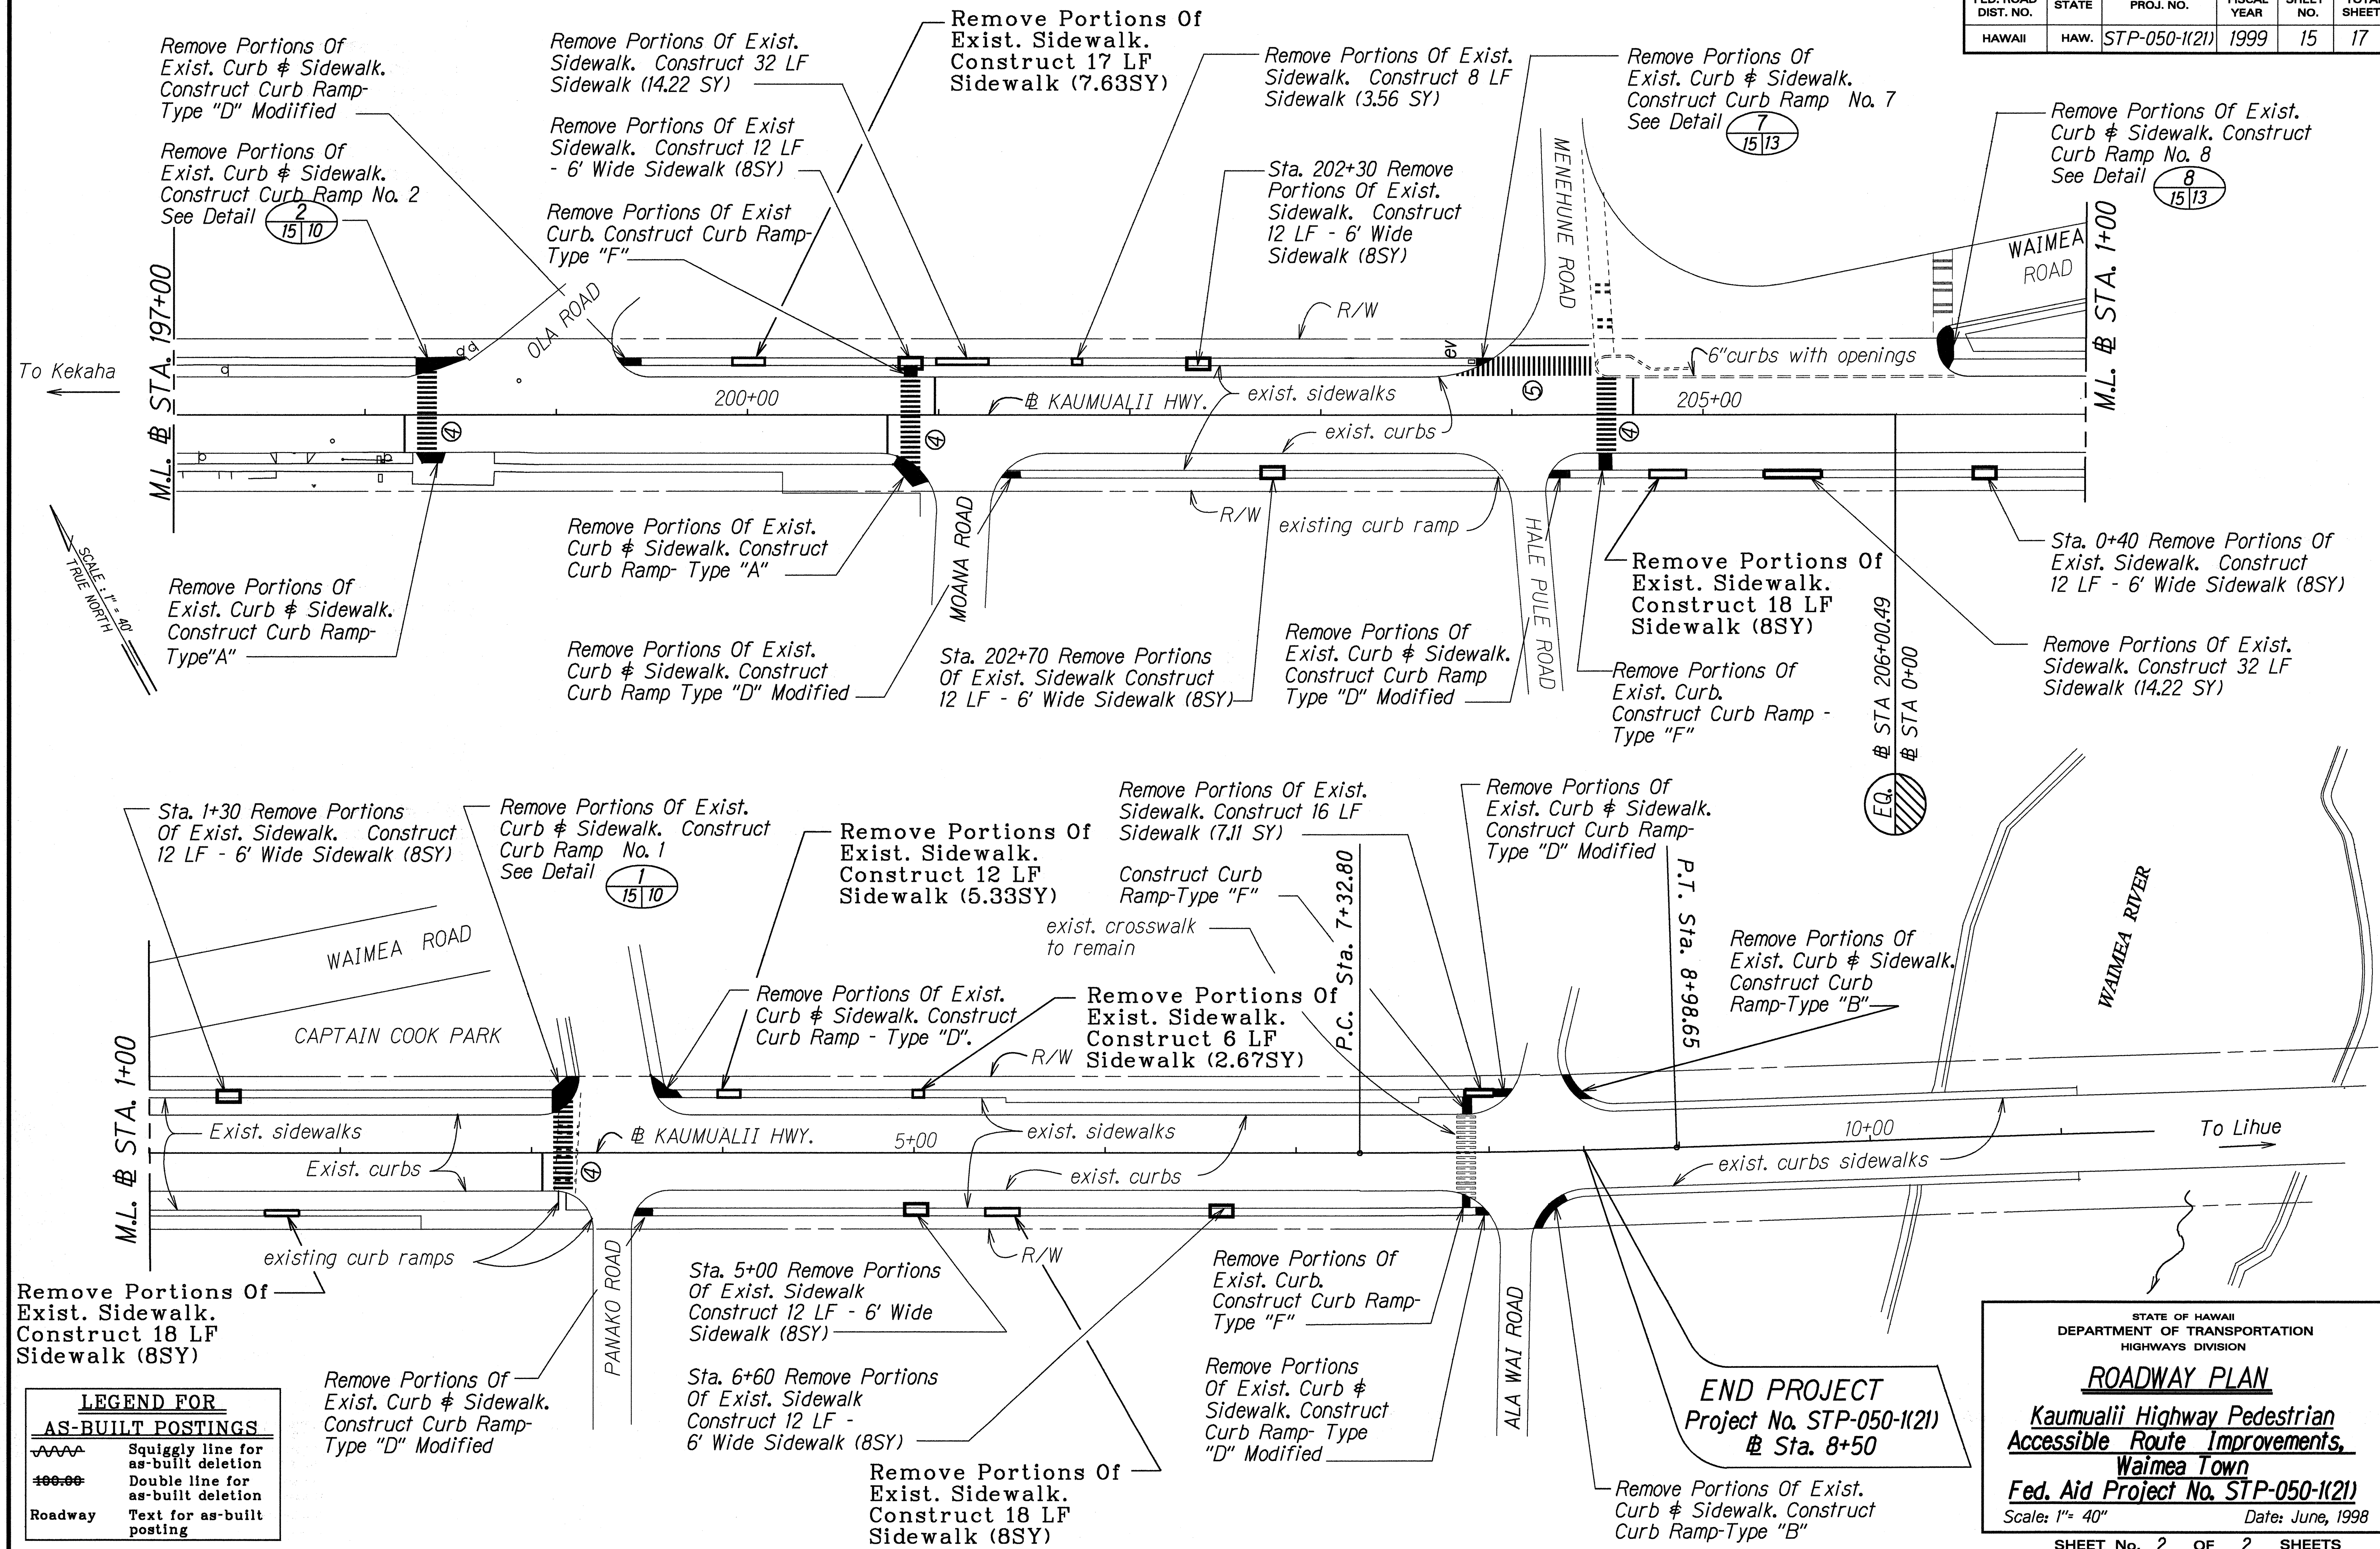

ORIGINAL	DATE	BY
FILED	1998	Mon Jun
NOTED		J. TUTU
CHECKED		J. TUTU
NO.		202

STATE OF HAWAII
DEPARTMENT OF TRANSPORTATION
HIGHWAYS DIVISION

ROADWAY PLAN
Kaumualii Highway Pedestrian
Accessible Route Improvements,
Waimea Town
Fed. Aid Project No. STP-050-1(21)
Scale: 1"= 40" Date: June, 1998

SHEET No. 2 OF 2 SHEETS